



E. & O.E. / FOR REFERENCE ONLY
SUBJECT TO CHANGES

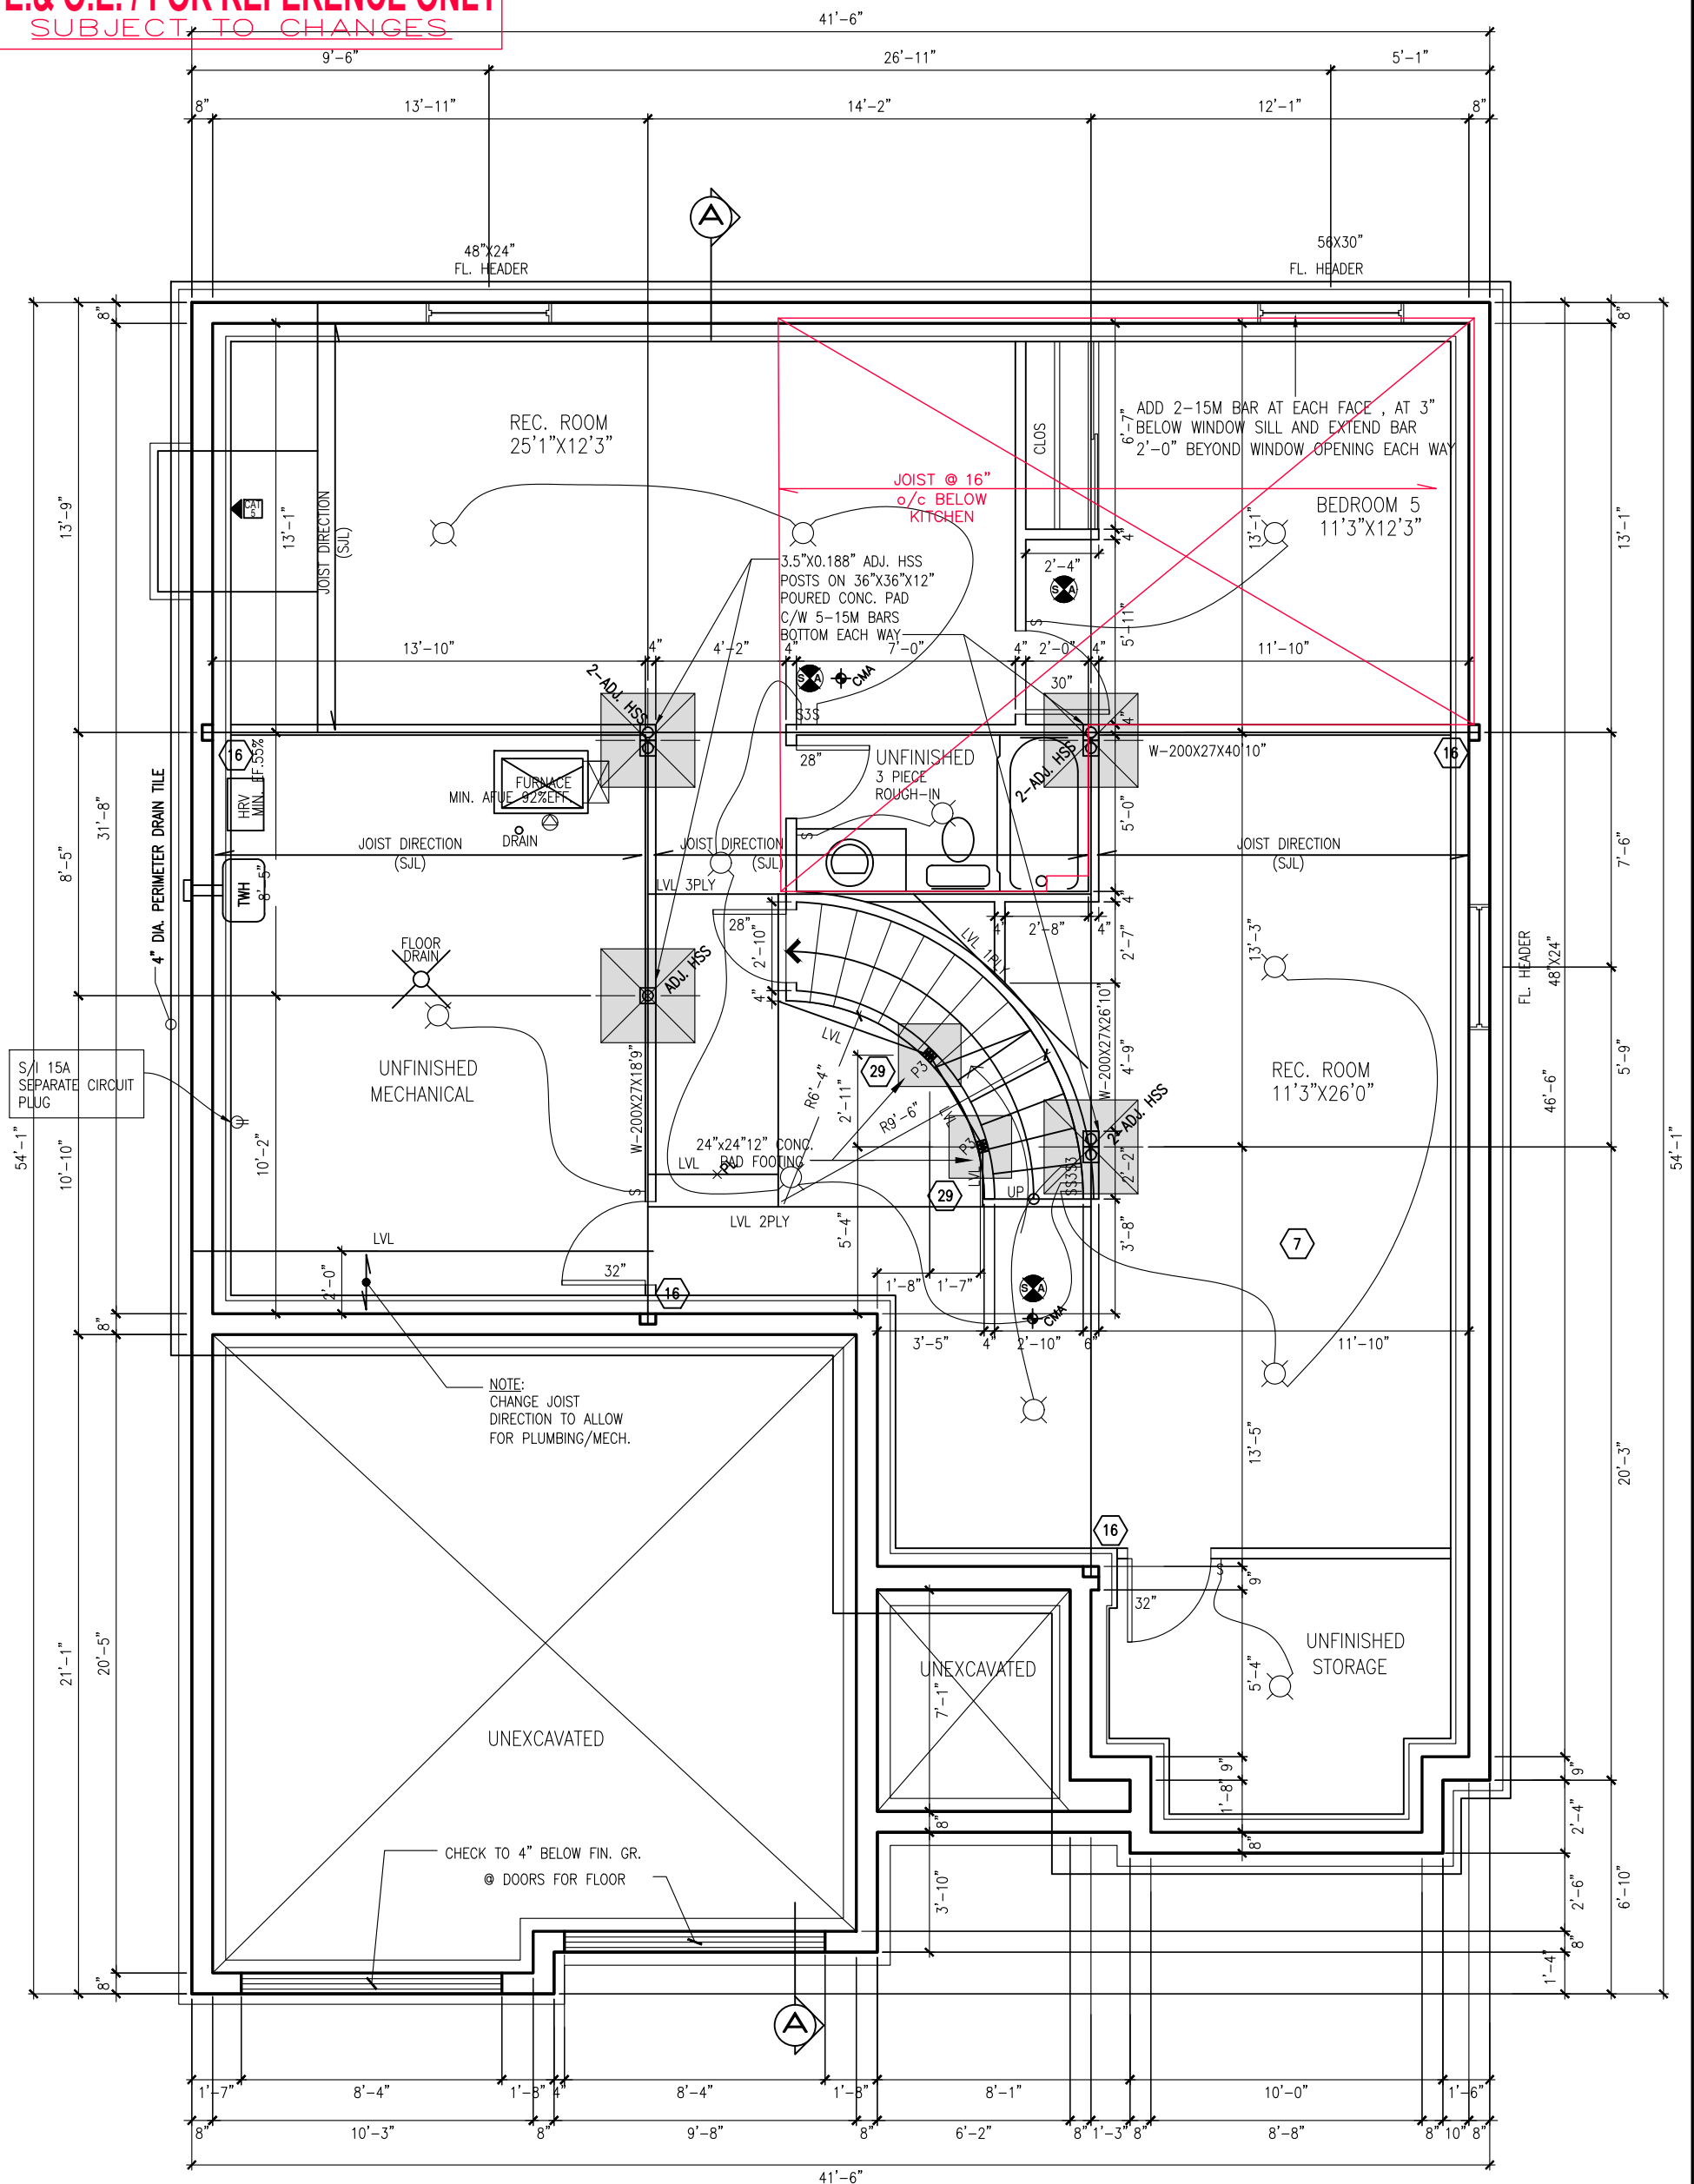

BASEMENT FLOOR PLAN ELEV. E

NOTE: PROVIDE 2-10M TOP AND BOTTOM BARS
ALL AROUND FOUNDATION WALLS
(UNLESS NOTED OTHERWISE)

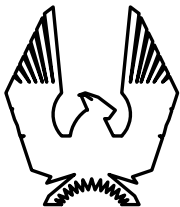

PHOENIX HOMES

CHESAPEAKE-2012-E

SITE: DIAMONDVIEW ESTATES

LOT NUMBER:

CIVIC ADDRESS:
1923 CESSNA PRIVATE

2-6

5	FINAL FOR SITE	19/11/21	GK
4	FINAL BLACKLINES	03/11/21	GK
3	BEP FOR SITE	01/09/21	CB
2	ENGINEERING REVIEW	20/07/21	CB
1	BEP BLACKLINES	08/06/21	CB
No.	Description	dd/mm/yy	By
REVISIONS			


file number: 508
drawn by: A. FRANCOEUR

date: OCT. 2003
scale: 3/16"=1'

DCL-195
sheet no:


2
9

E. & O.E. / FOR REFERENCE ONLY
SUBJECT TO CHANGES

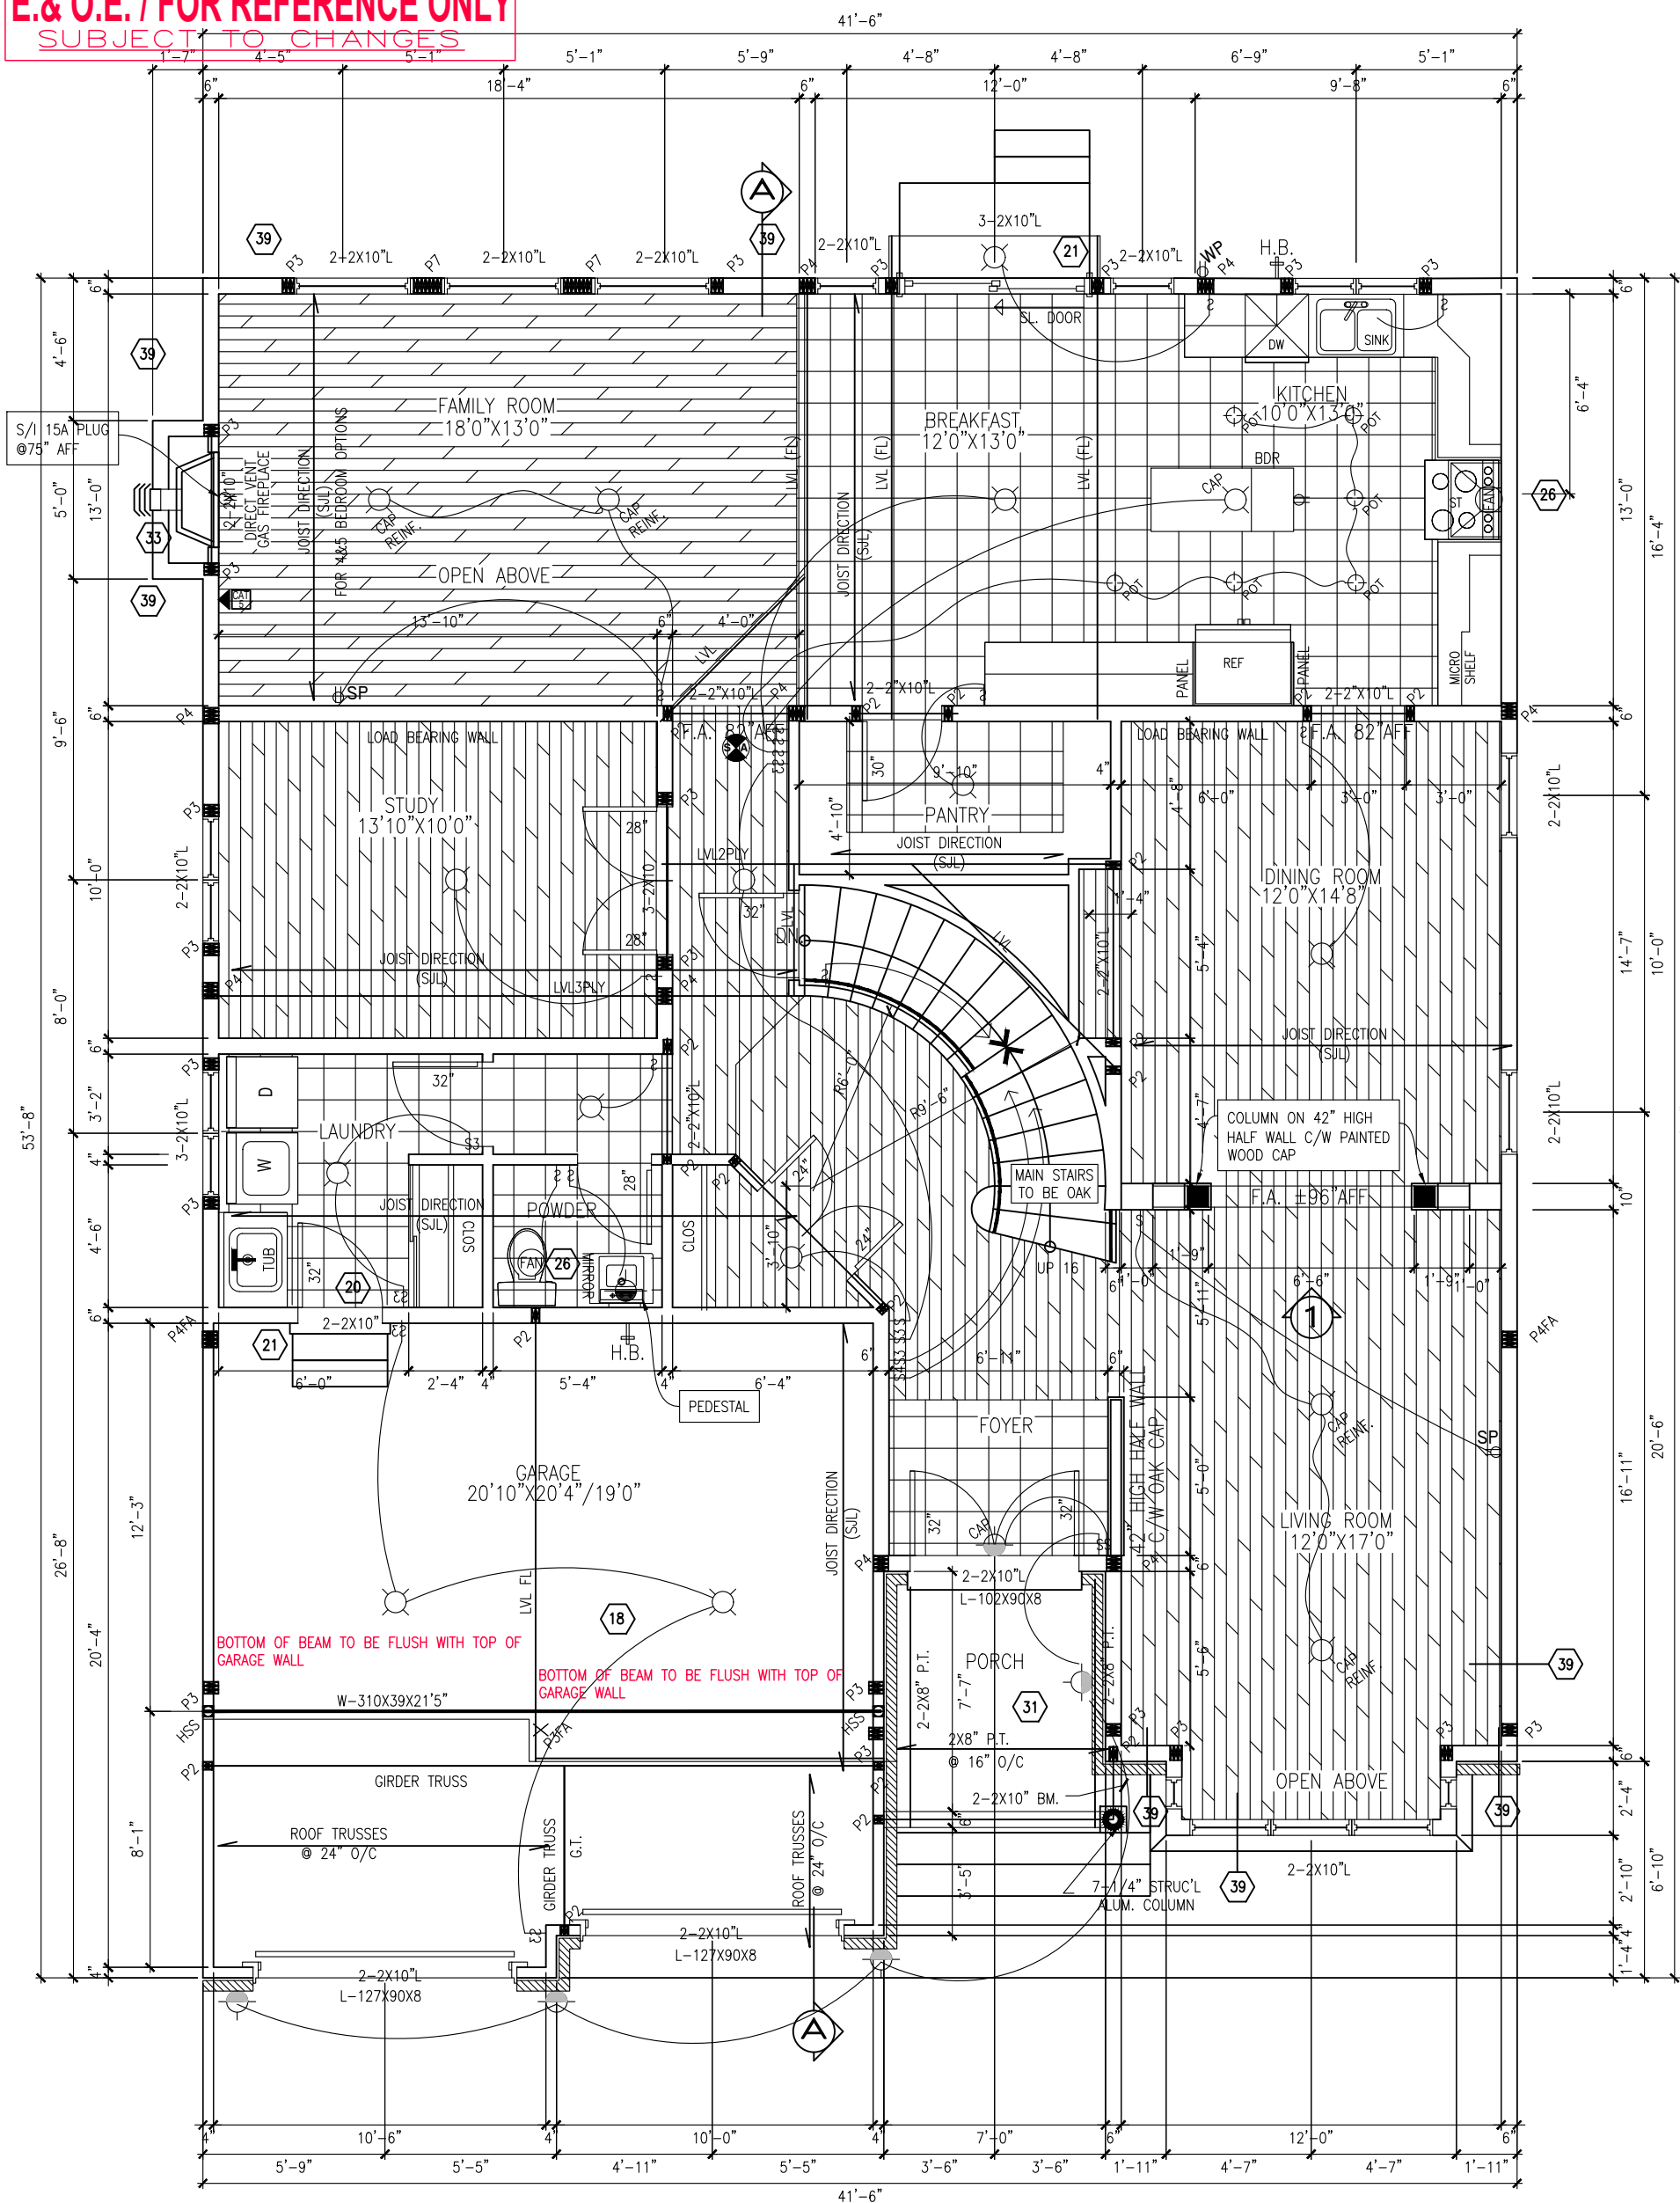

MAIN FLOOR PLAN ELEV. E - 1635 SF

****NOTE****
ALL WINDOW LINTELS TO BE 2-2X10
W/ P2 POSTS ON EACH SIDE U.N.O.

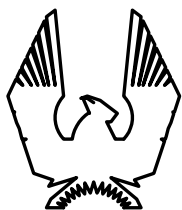

PHOENIX HOMES

CHESAPEAKE-2012-E

SITE: DIAMONDVIEW ESTATES

LOT NUMBER:

CIVIC ADDRESS:
1923 CESSNA PRIVATE

2-6

5	FINAL FOR SITE	19/11/21	GK
4	FINAL BLACKLINES	03/11/21	GK
3	BEP FOR SITE	01/09/21	CB
2	ENGINEERING REVIEW	20/07/21	CB
1	BEP BLACKLINES	08/06/21	CB
No.	Description	dd/mm/yy	By
REVISIONS			

file number: 508

drawn by: A. FRANCOEUR

date:	OCT. 2003
-------	-----------

scale: $3/16"=1'$


DCL-195

sheet no:

3


E. & O.E. / FOR REFERENCE ONLY
SUBJECT TO CHANGES

STUD WALL REINFORCEMENT FOR FUTURE GRAB
BARS IN MAIN BATHROOM
REINFORCEMENT OF STUD WALLS SHALL BE INSTALLED
ADJACENT TO WATER CLOSETS AND SHOWER OR BATHTUB IN
MAIN BATHROOM. REFER TO OBC. 9.5.2.3, 3.8.3.8.(1)(d) &
3.8.3.13.(1)(f). AND DETAILS PROVIDED

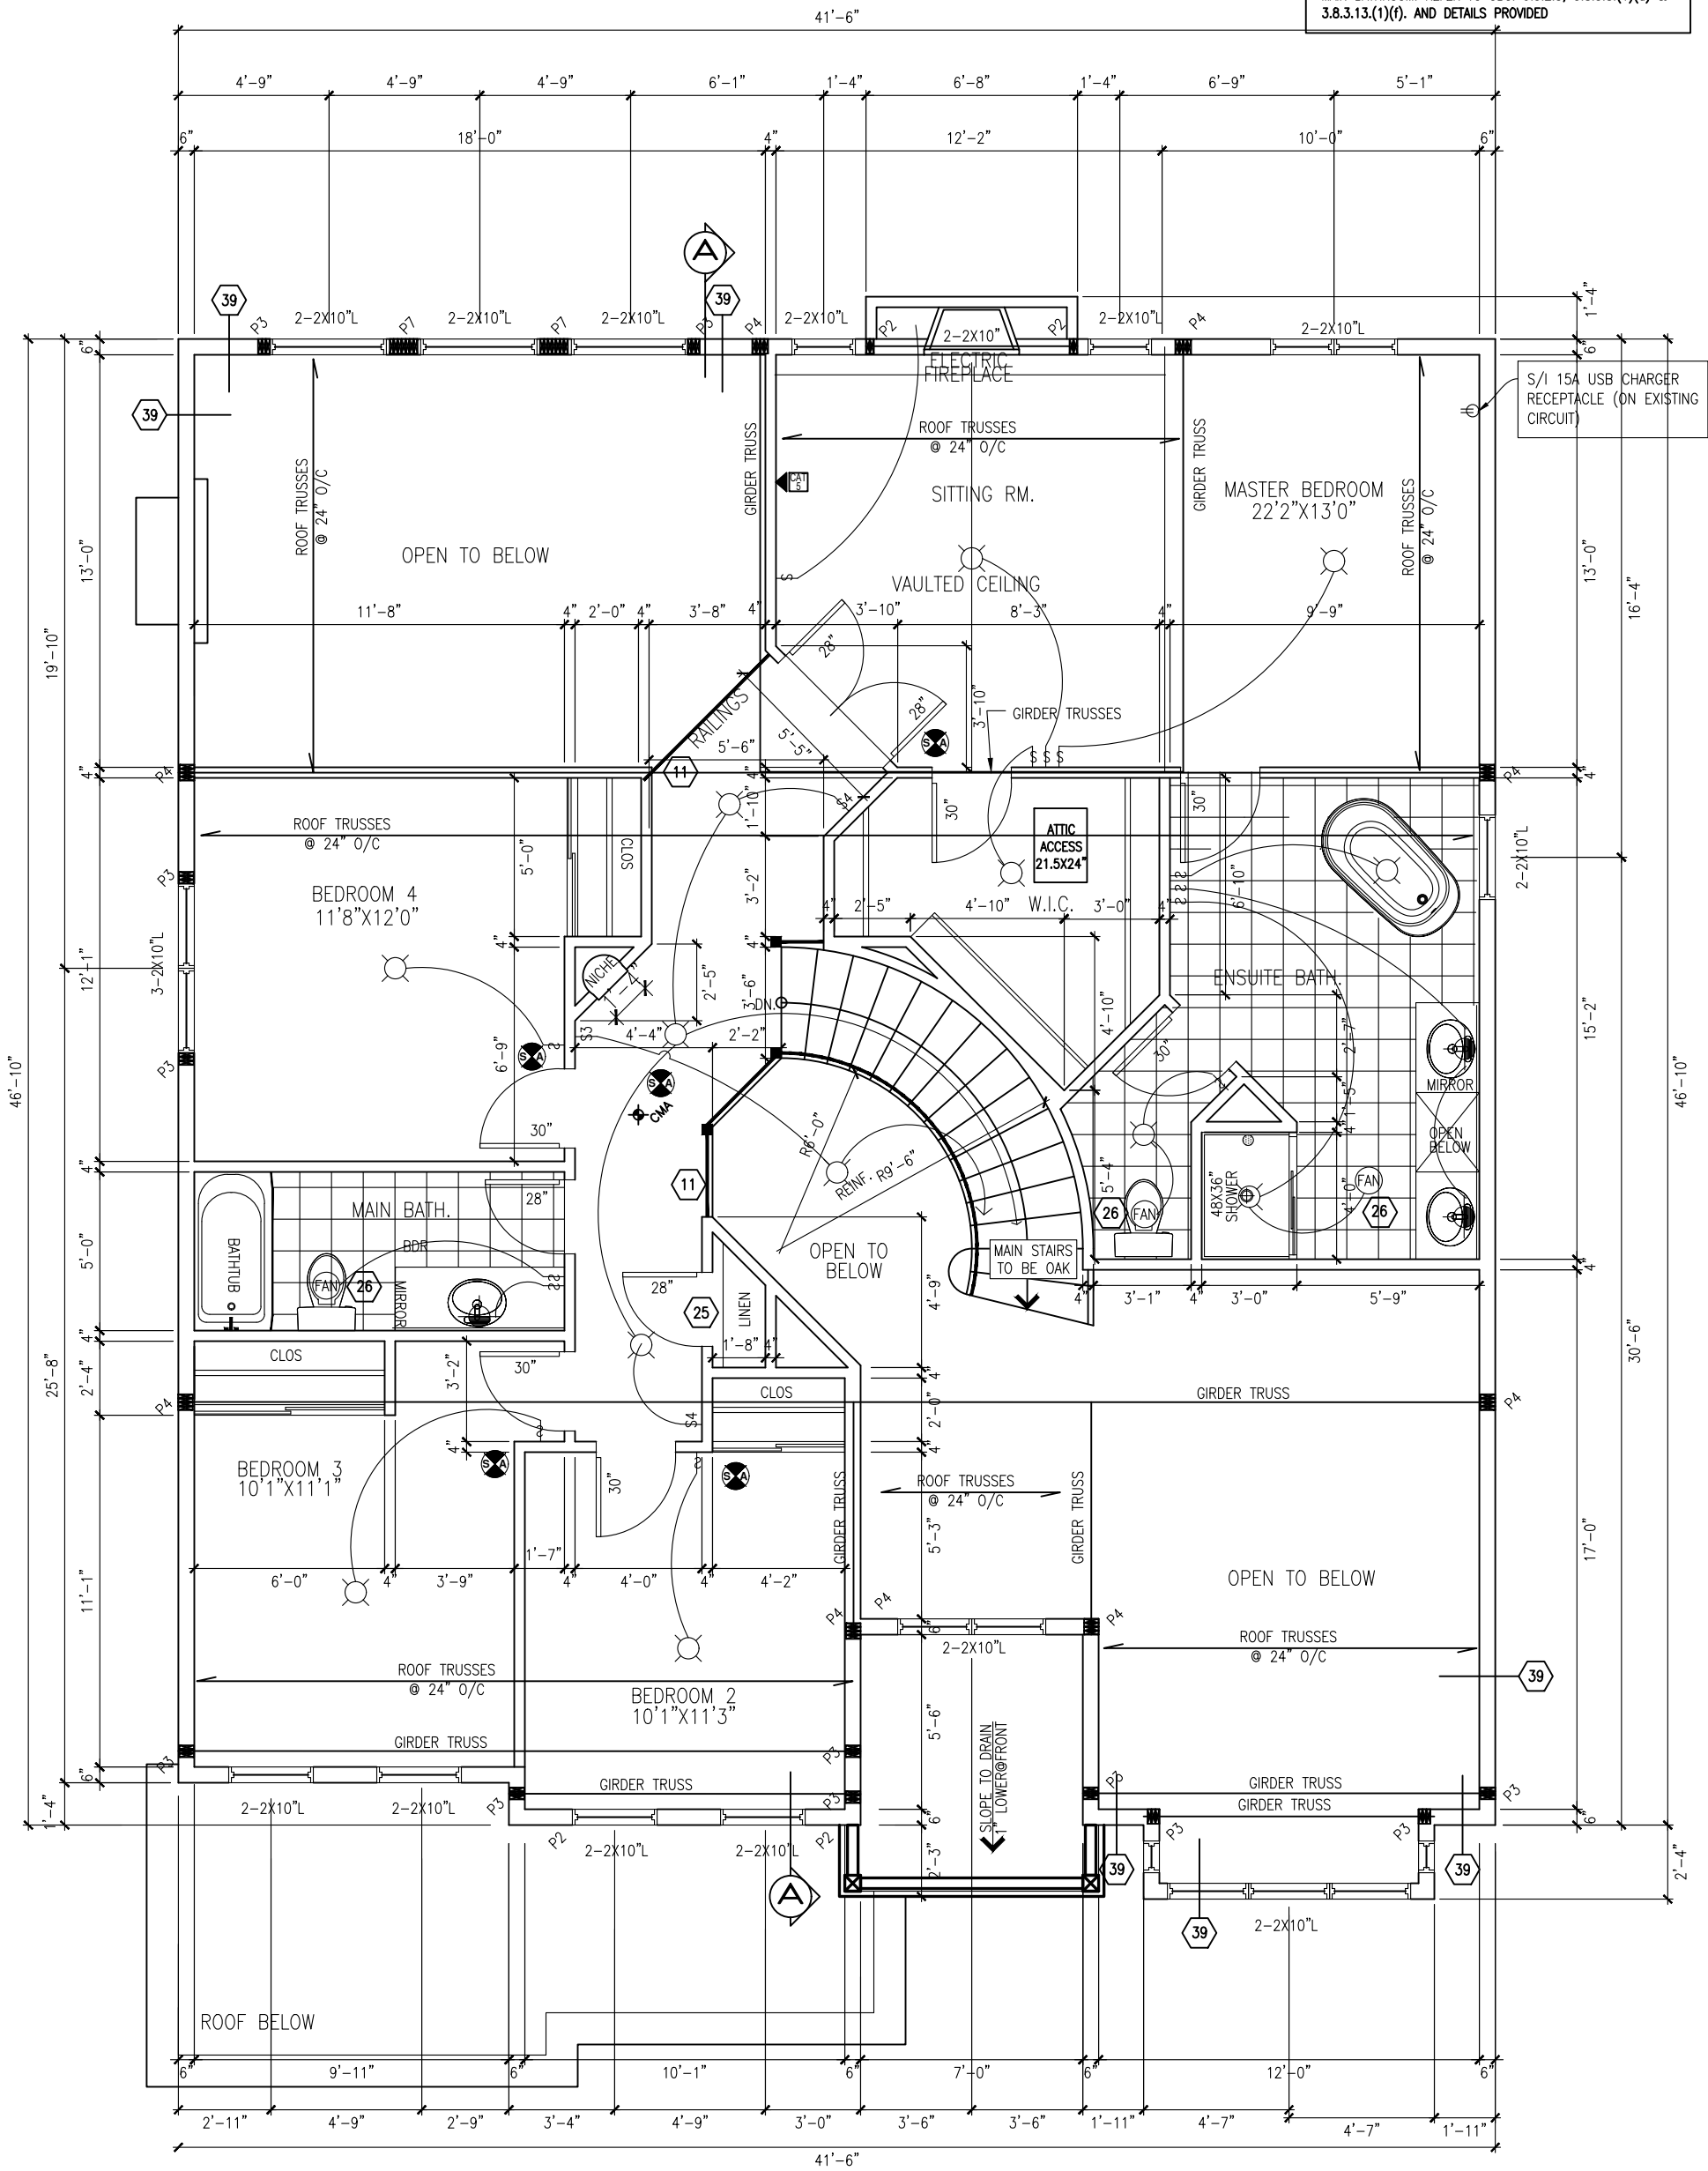

SECOND FLOOR PLAN ELEV. E

****NOTE****
ALL WINDOW LINTELS TO BE 2-2X10
W/ P2 POSTS ON EACH SIDE U.N.O.

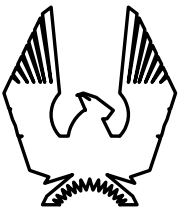

PHOENIX HOMES

CHESAPEAKE-2012-E

SITE: DIAMONDVIEW ESTATES

LOT NUMBER:

CIVIC ADDRESS:
1923 CESSNA PRIVATE

2-6


5	FINAL FOR SITE	19/11/21	GK	file number: 508
4	FINAL BLACKLINES	03/11/21	GK	drawn by: A. FRANCOEUR
3	BEP FOR SITE	01/09/21	CB	date: OCT. 2003
2	ENGINEERING REVIEW	20/07/21	CB	scale: 3/16"=1'
1	BEP BLACKLINES	08/06/21	CB	DCL-195
No.	Description	dd/mm/yy	By	sheet no:
REVISIONS				

4
9

E.& O.E. / FOR REFERENCE ONLY
SUBJECT TO CHANGES



FRONT ELEVATION 'E'

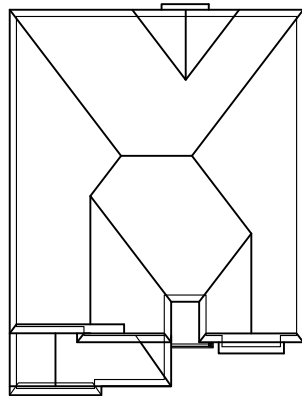


ROOF PLAN-E


file number:	508
drawn by:	A. FRANCOEUR
date:	OCT. 2003
scale:	3/16" = 1'
DCL-195	sheet no:
5	9

		OK	OK	OK	OK	By
5	FINAL FOR SITE	19/11/21				
4	FINAL BLACKLINES	03/11/21				
3	BEP FOR SITE	01/09/21				
2	ENGINEERING REVIEW	20/07/21				
1	BEP BLACKLINES	08/06/21				
No.	Description	dd/mm/yy				
REVISIONS						

CHESAPEAKE-2012-E
SITE: DIAMONDVIEW ESTATES
LOT NUMBER: 2-6
CIVIC ADDRESS: 1923 CESSNA PRIVATE

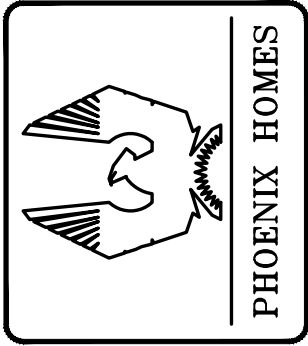

E.& O.E. / FOR REFERENCE ONLY
SUBJECT TO CHANGES

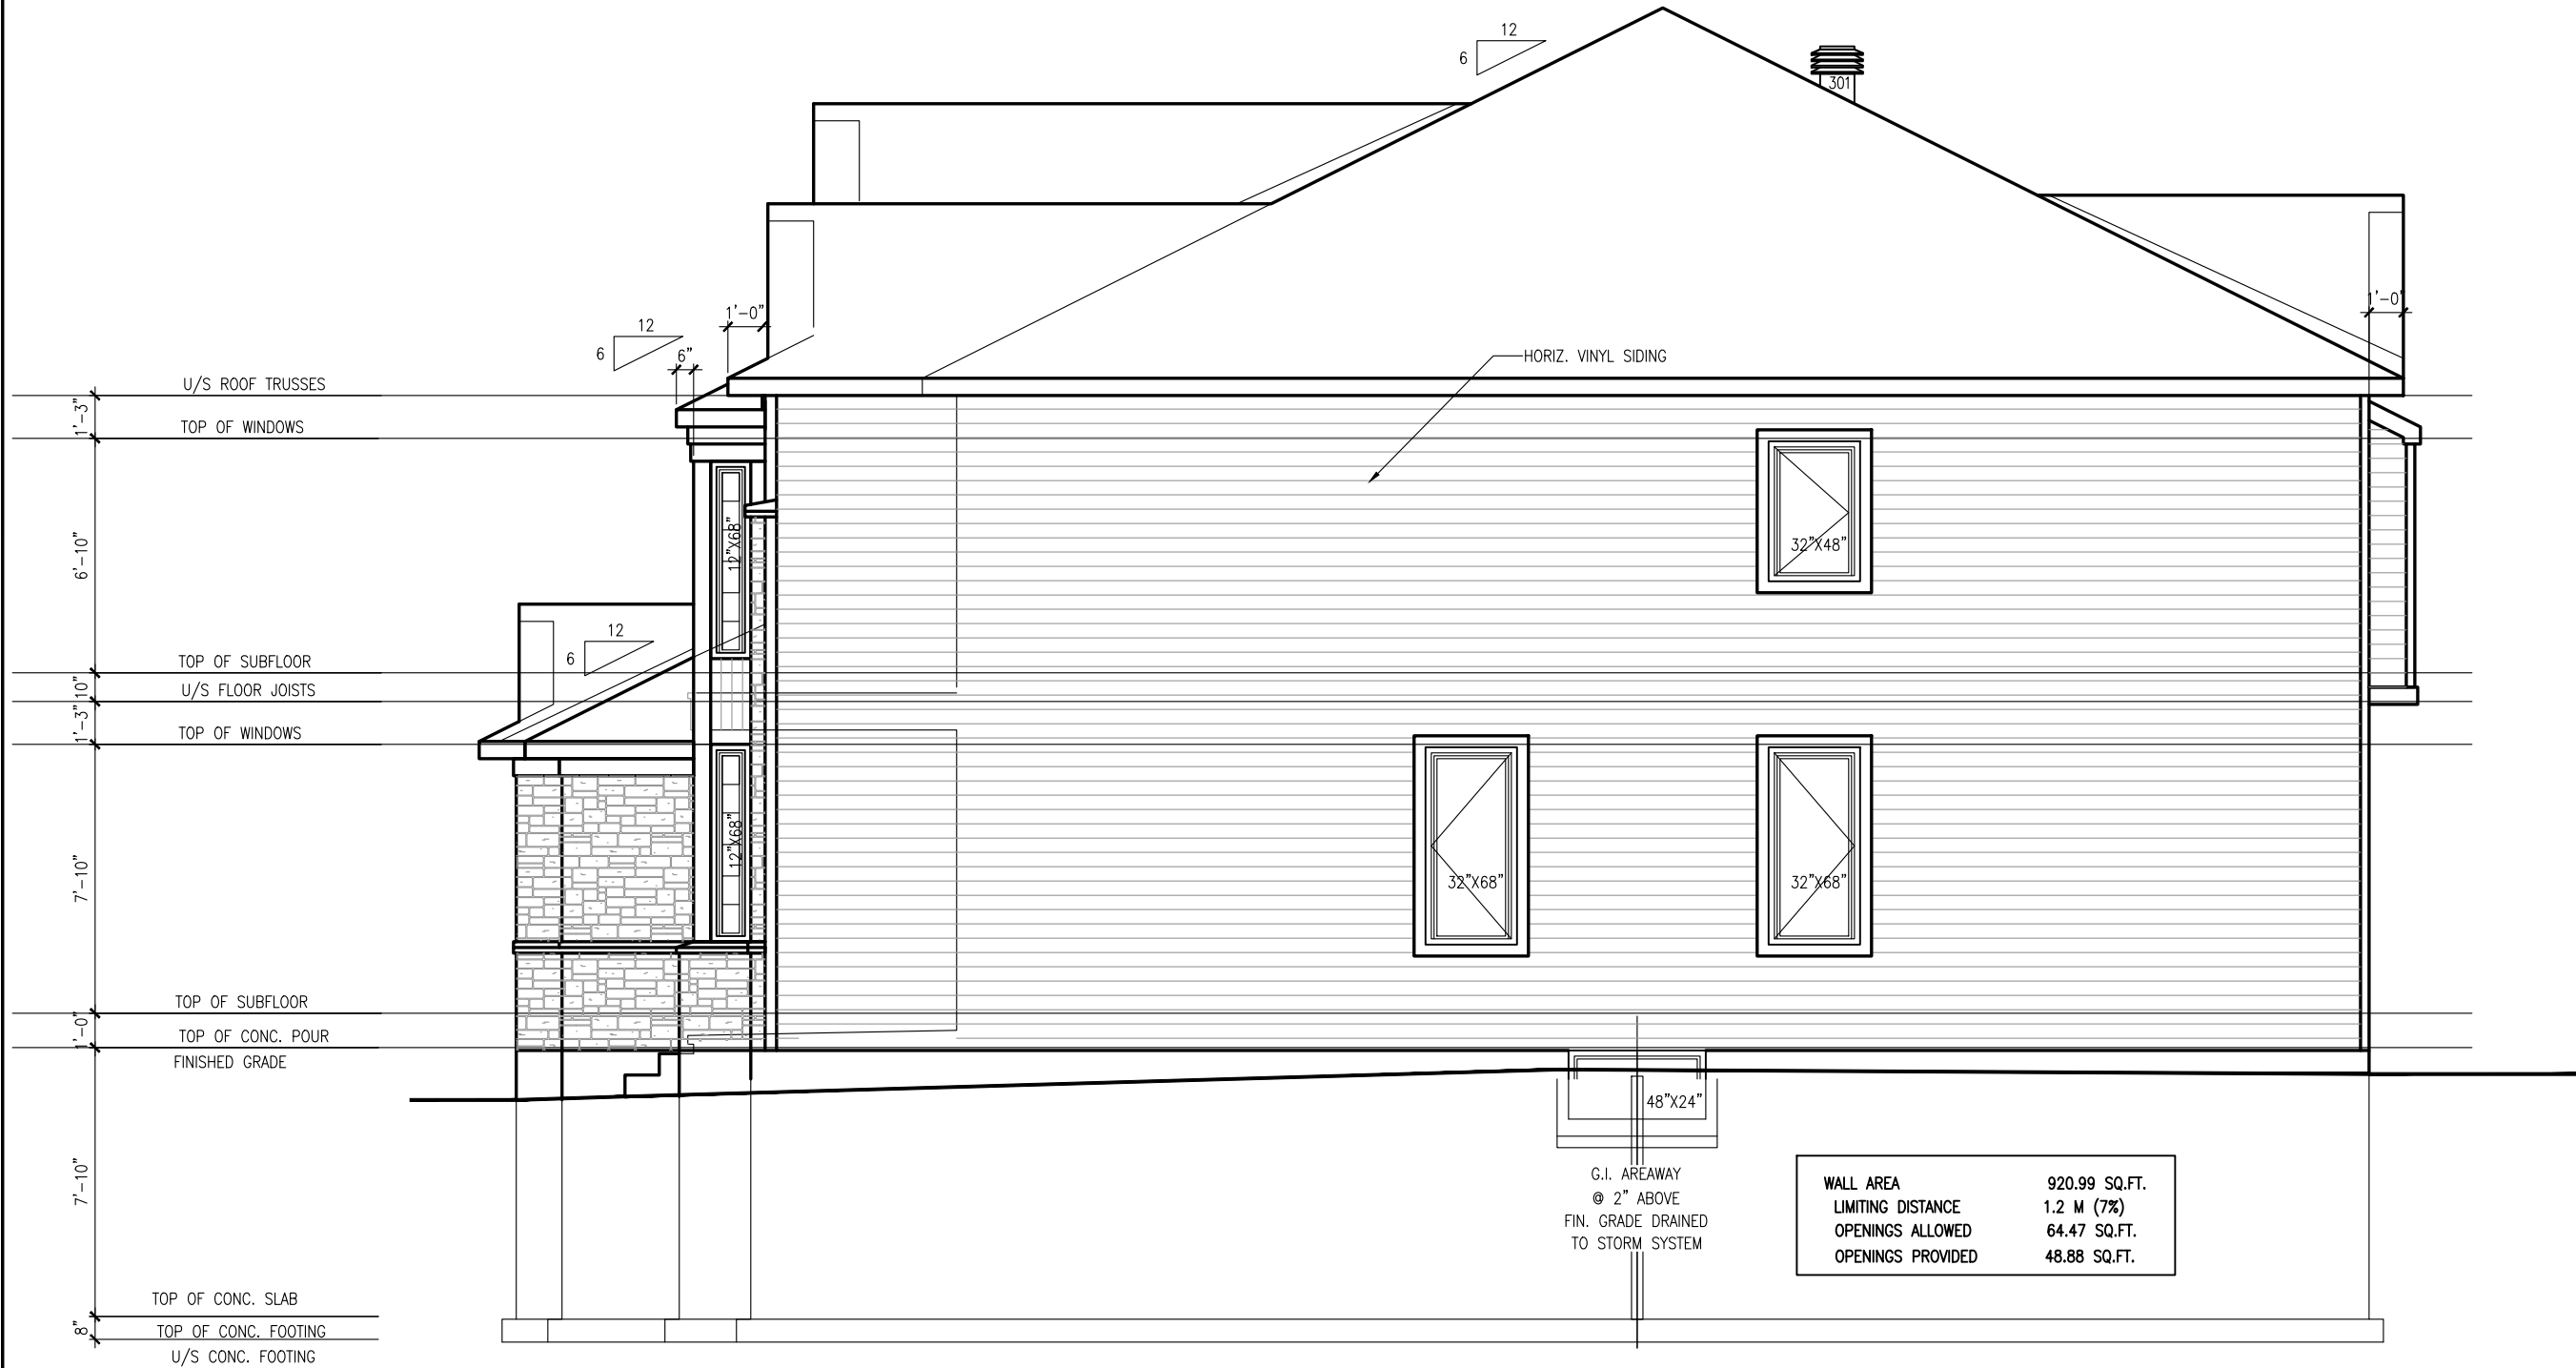


RIGHT SIDE ELEVATION 'E'


file number:	508
drawn by:	A. FRANCOEUR
date:	OCT. 2003
scale:	3/16" = 1'
DCL-195	
sheet no:	6/9

		19/11/21	OK
5	FINAL FOR SITE		
4	FINAL BLACKLINES	03/11/21	OK
3	BEP FOR SITE	01/09/21	CB
2	ENGINEERING REVIEW	20/07/21	CB
1	BEP BLACKLINES	08/06/21	CB
No.	Description	dd/mm/yy	By
REVISIONS			

CHESAPEAKE-2012-E
SITE: DIAMONDVIEW ESTATES
LOT NUMBER: 2-6
CVIC ADDRESS: 1923 CESSNA PRIVATE

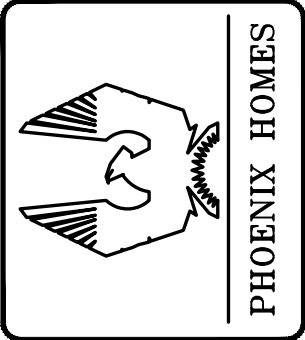

E. & O.E. / FOR REFERENCE ONLY
SUBJECT TO CHANGES

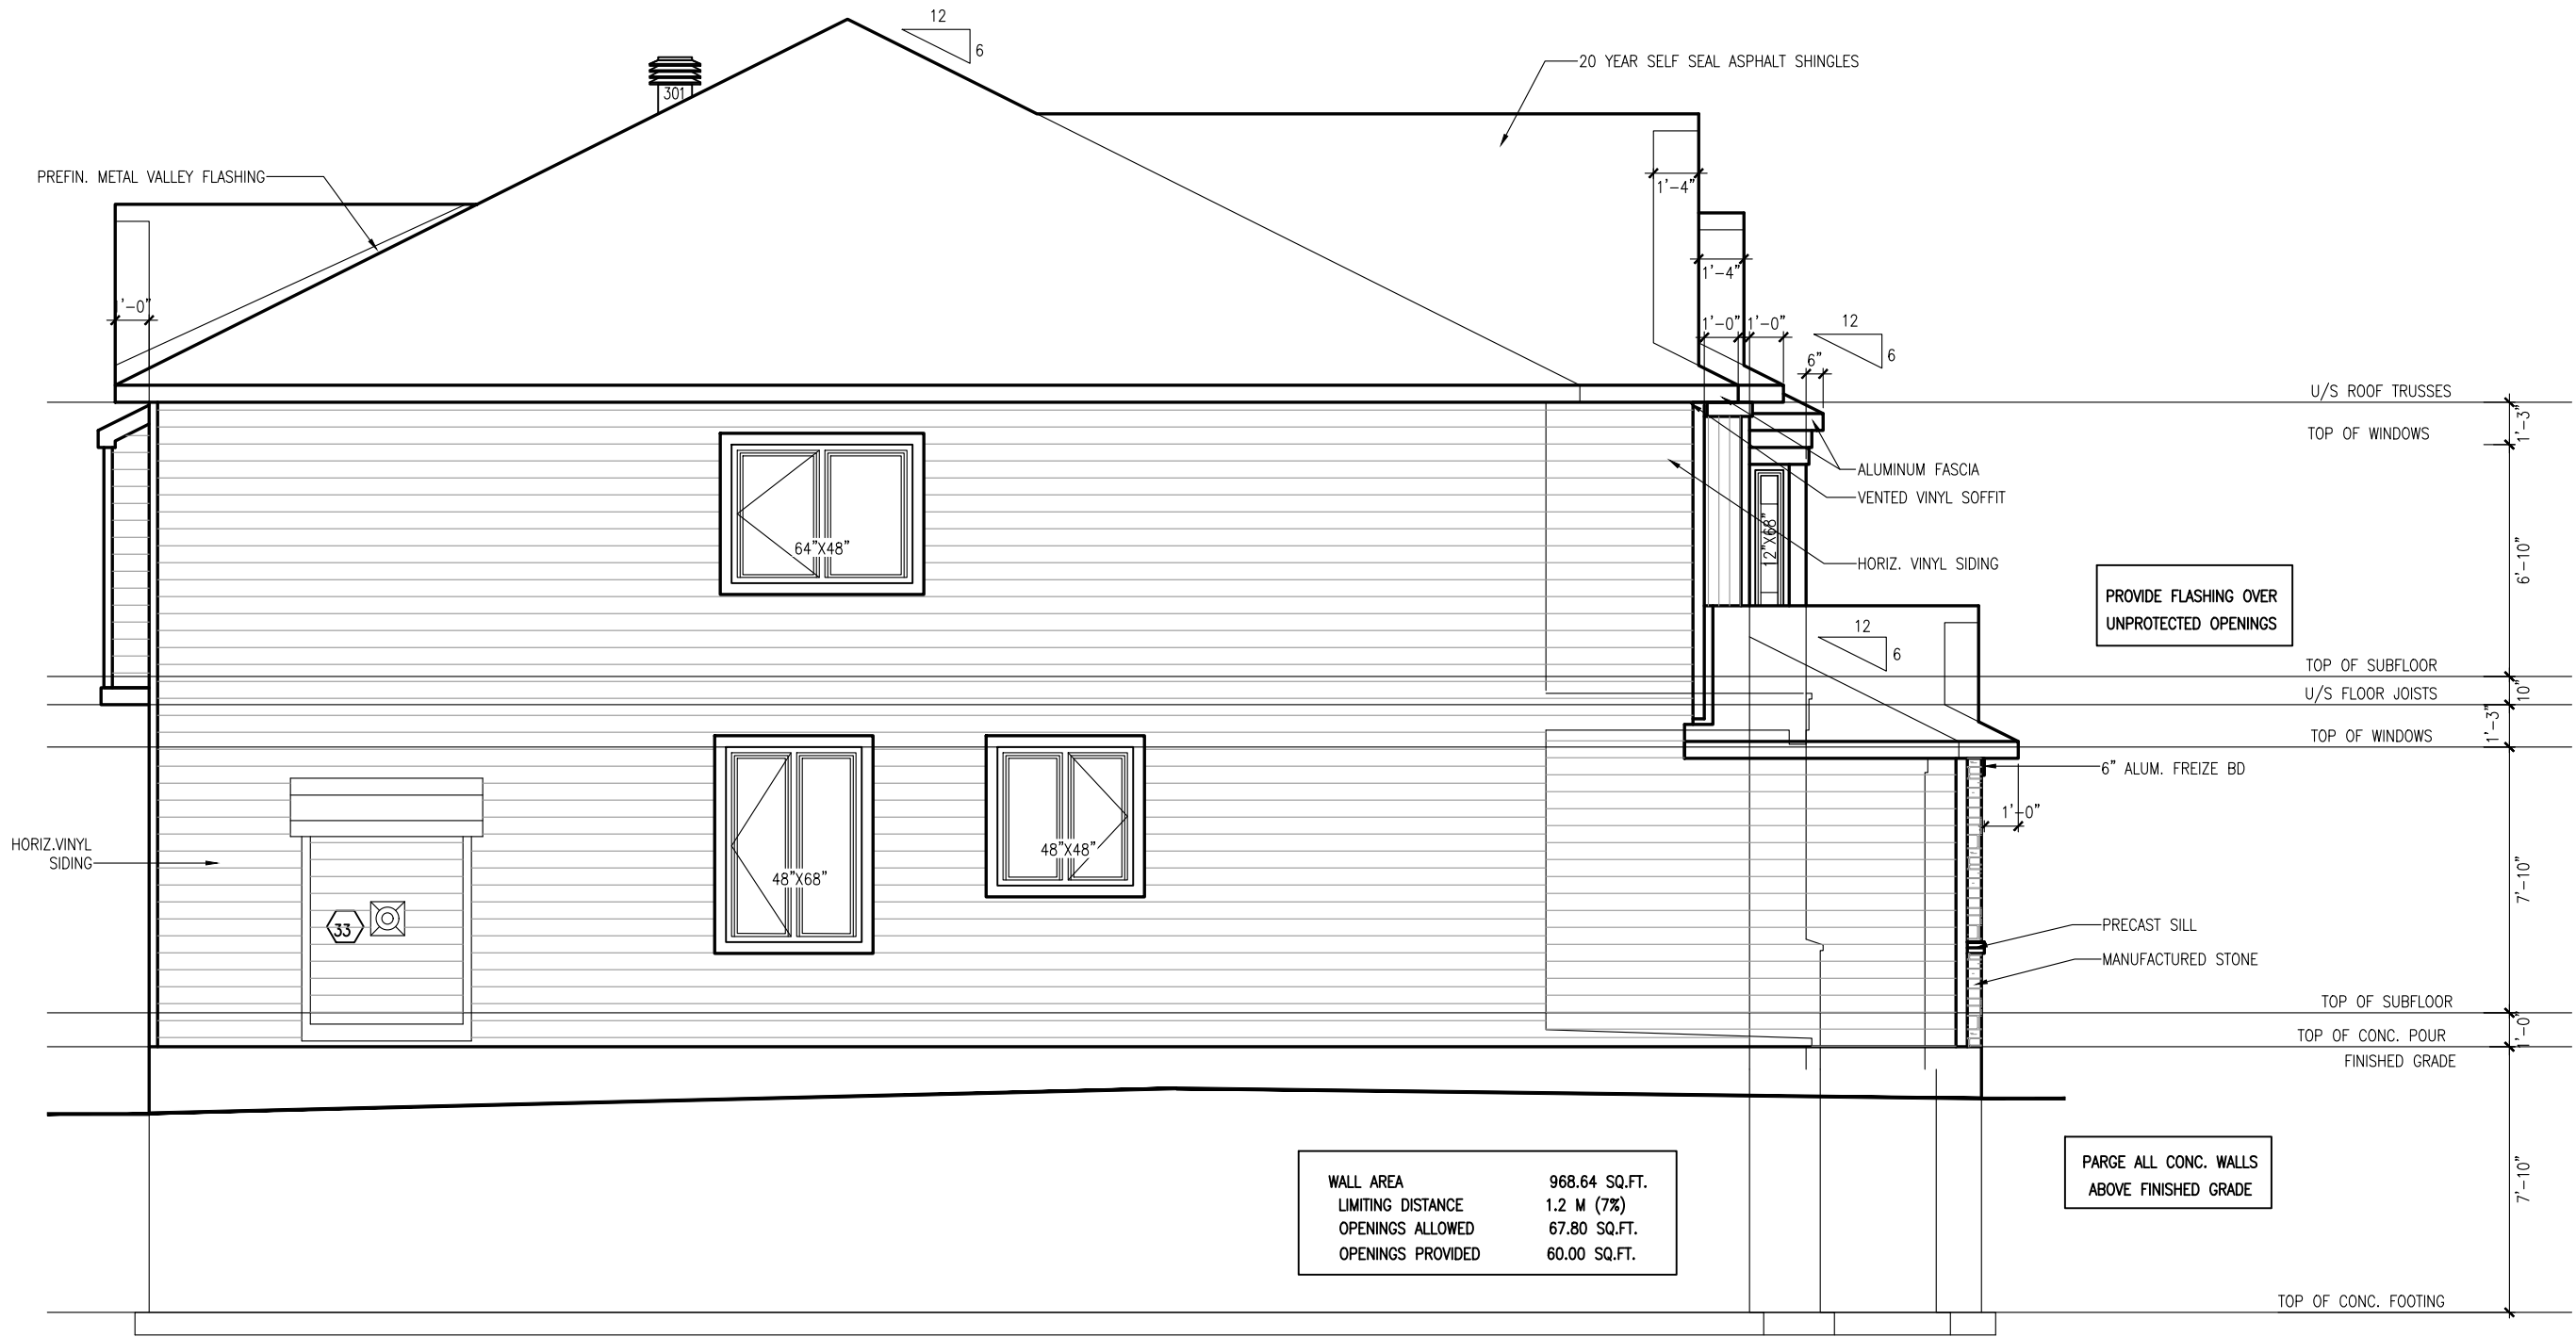

LEFT SIDE ELEVATION 'E'

file number:	508
drawn by:	A. FRANCOEUR
date:	OCT. 2003
scale:	3/16" = 1'
DCL-195	
sheet no:	

7
9

	19/11/21	GK
5	FINAL FOR SITE	GK
4	FINAL BLACKLINES	CB
3	BEP FOR SITE	CB
2	ENGINEERING REVIEW	CB
1	BEP BLACKLINES	CB
No.	Description	By
	REVISIONS	dd/mm/yy

CHESAPEAKE-2012-E

SITE: DIAMONDVIEW ESTATES

LOT NUMBER: 2-6


CIVIC ADDRESS: 1923 CESSNA PRIVATE

PHOENIX HOMES

E. & O.E. / FOR REFERENCE ONLY
SUBJECT TO CHANGES




REAR ELEVATION ELEV. E&F

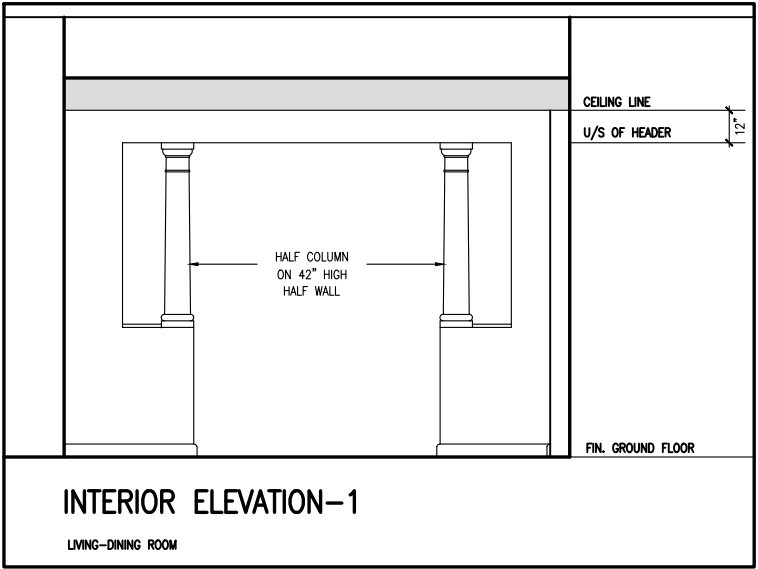


file number:	508
drawn by:	A. FRANCOEUR
date:	OCT. 2003
scale:	3/16"=1'
DCL-195	
sheet no:	8/9

	OK	OK	OK	OK	OK	By
5	FINAL FOR SITE	19/11/21				
4	FINAL BLACKLINES	03/11/21				
3	BEP FOR SITE	01/09/21				
2	ENGINEERING REVIEW	20/07/21				
1	BEP BLACKLINES	08/06/21				
No.	Description	dd/mm/yy				
REVISIONS						

CHESAPEAKE-2012-E
SITE: DIAMONDVIEW ESTATES
LOT NUMBER: 2-6
CIVIC ADDRESS: 1923 CESSNA PRIVATE

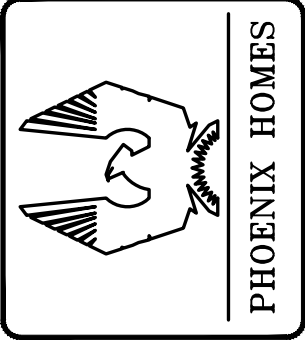

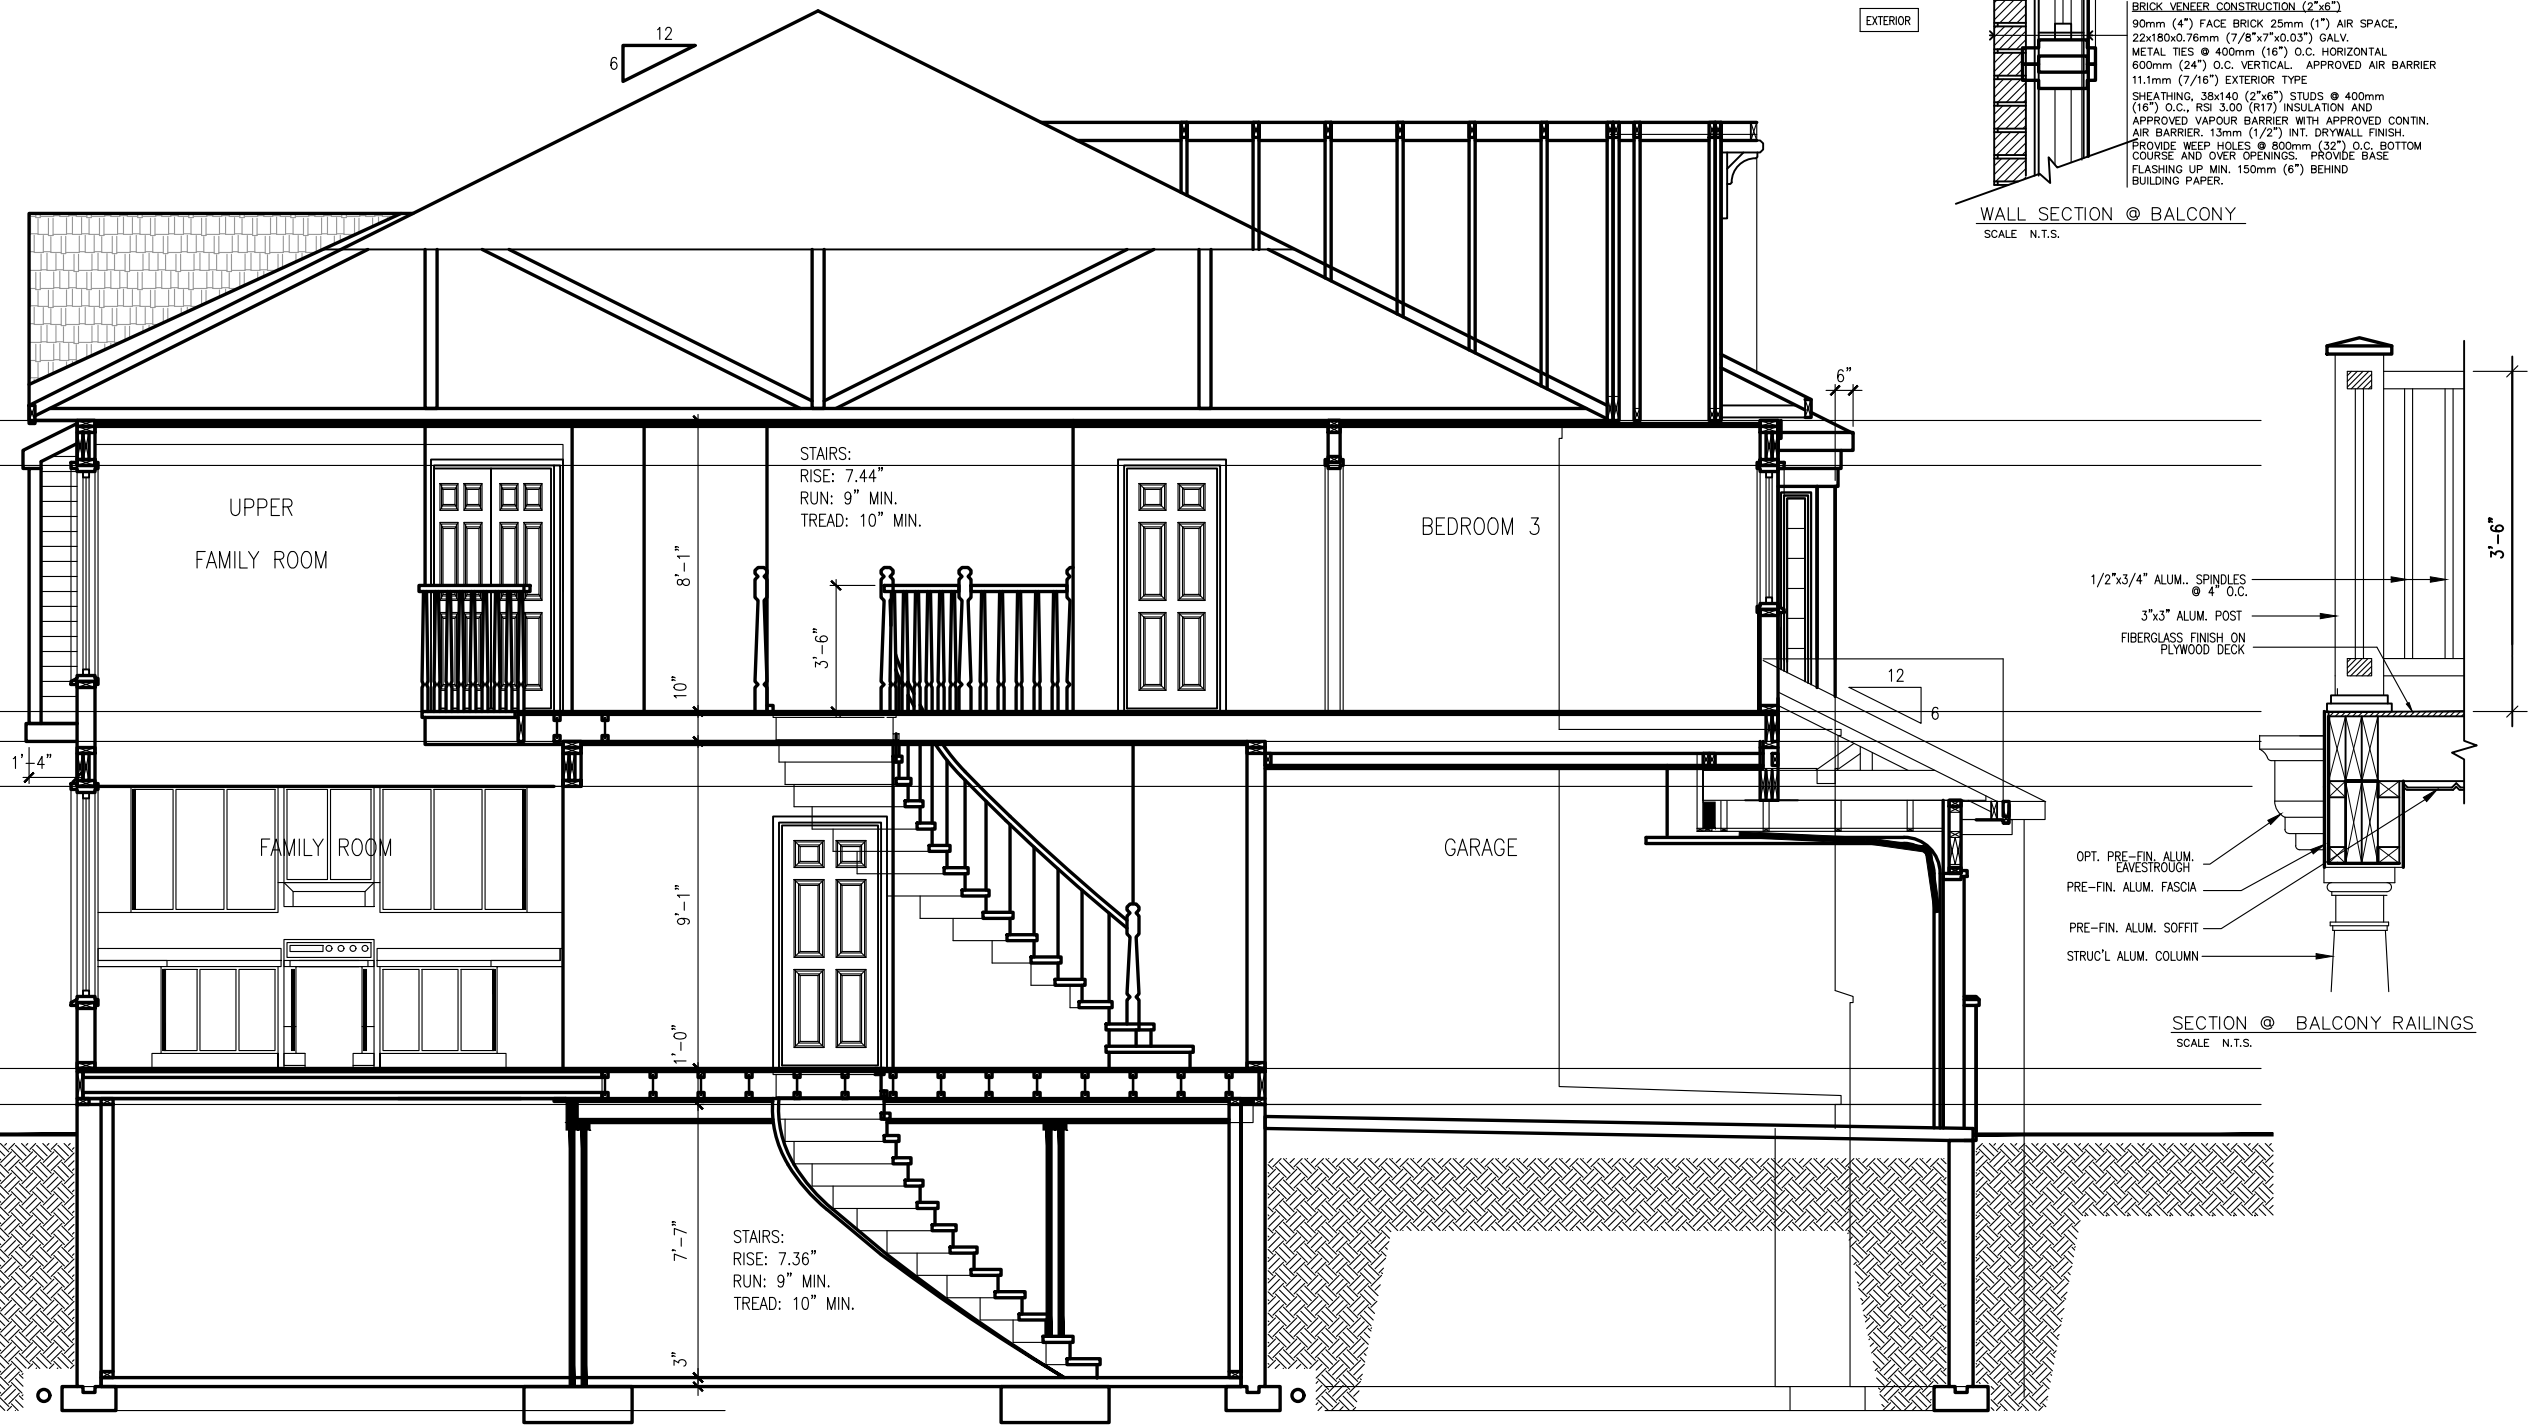

SECTION "AA" @ STAIRS (STD. ELEV.E)

file number: 508

drawn by: A. FRANCOEUR

date: OCT. 2003

scale: 3/16"=1'

DCL-195

sheet no: 9/9

	OK		OK	OK	OK	By
5	FINAL FOR SITE	19/11/21	4	FINAL BLACKLINES	03/11/21	
3	BEP FOR SITE	01/09/21	2	ENGINEERING REVIEW	20/07/21	
1	BEP BLACKLINES	08/06/21				
No. Description		dd/mm/yy	REVISIONS			

CHESAPEAKE-2012-E

SITE: DIAMONDVIEW ESTATES

LOT NUMBER: 2-6

CIVIC ADDRESS: 1923 CESSNA PRIVATE

PHOENIX HOMES