

DCR PHOENIX HOMES

FERNBANK CROSSING

MODEL - MELBOURNE 4 BED

KITCHEN

MOUNTING HEIGHT = 84

LINE - 1 & 2

HARDWARE - STD & 1ST UPGRADE

STANDARD WHITE INTERIORS

METAL DRAWER BOXES


6 PCS - 5/8 KICK FIN. BOTH SIDES

1 PCS - T-MOULD


1 PCS - 90 DEG. CORNER MOULD

8 PCS - FLAT MOULD

Delete upper Range Cabinet to accommodate for Chimney Hoodfan (No space beside)

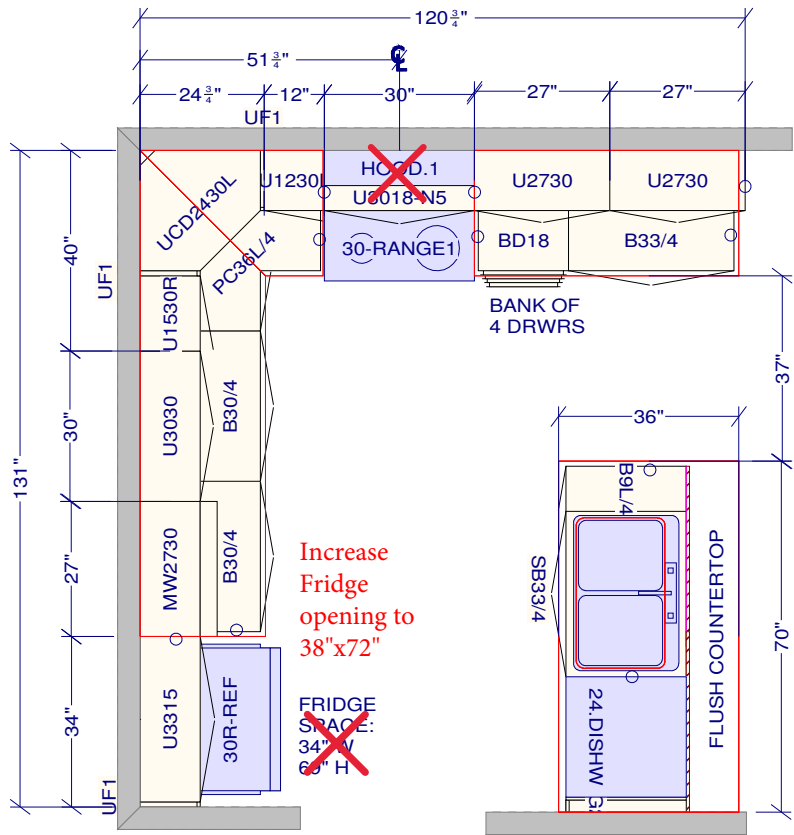

PWY2- 302

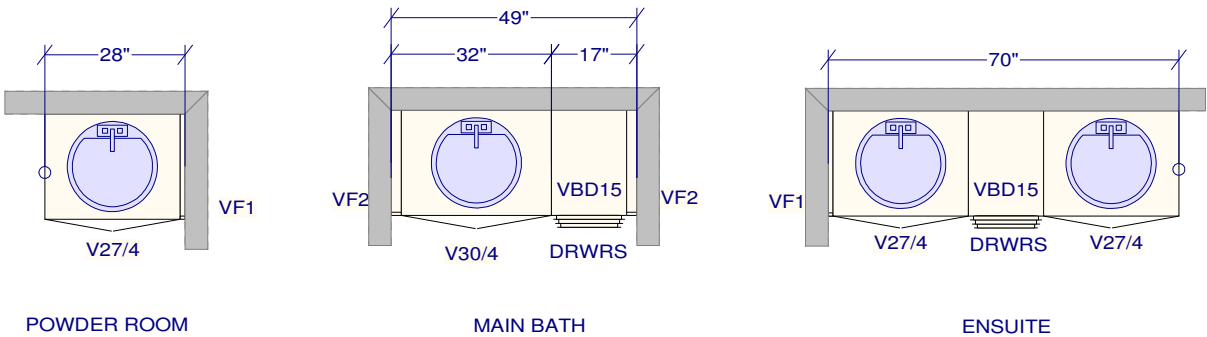

DS
STM

All dimensions ,size designations given are subject to verification on job site and adjustment to fit job conditions.


SPECTRUM KITCHENS INC.



This is an original design and must not be released or copied unless applicable fee has been paid or job order placed.

Drawn by: Lori Di Saverio, B.I.D. SPECTRUM KITCHENS INC.


Designed: 23/05/2016
Printed: 23/05/2016

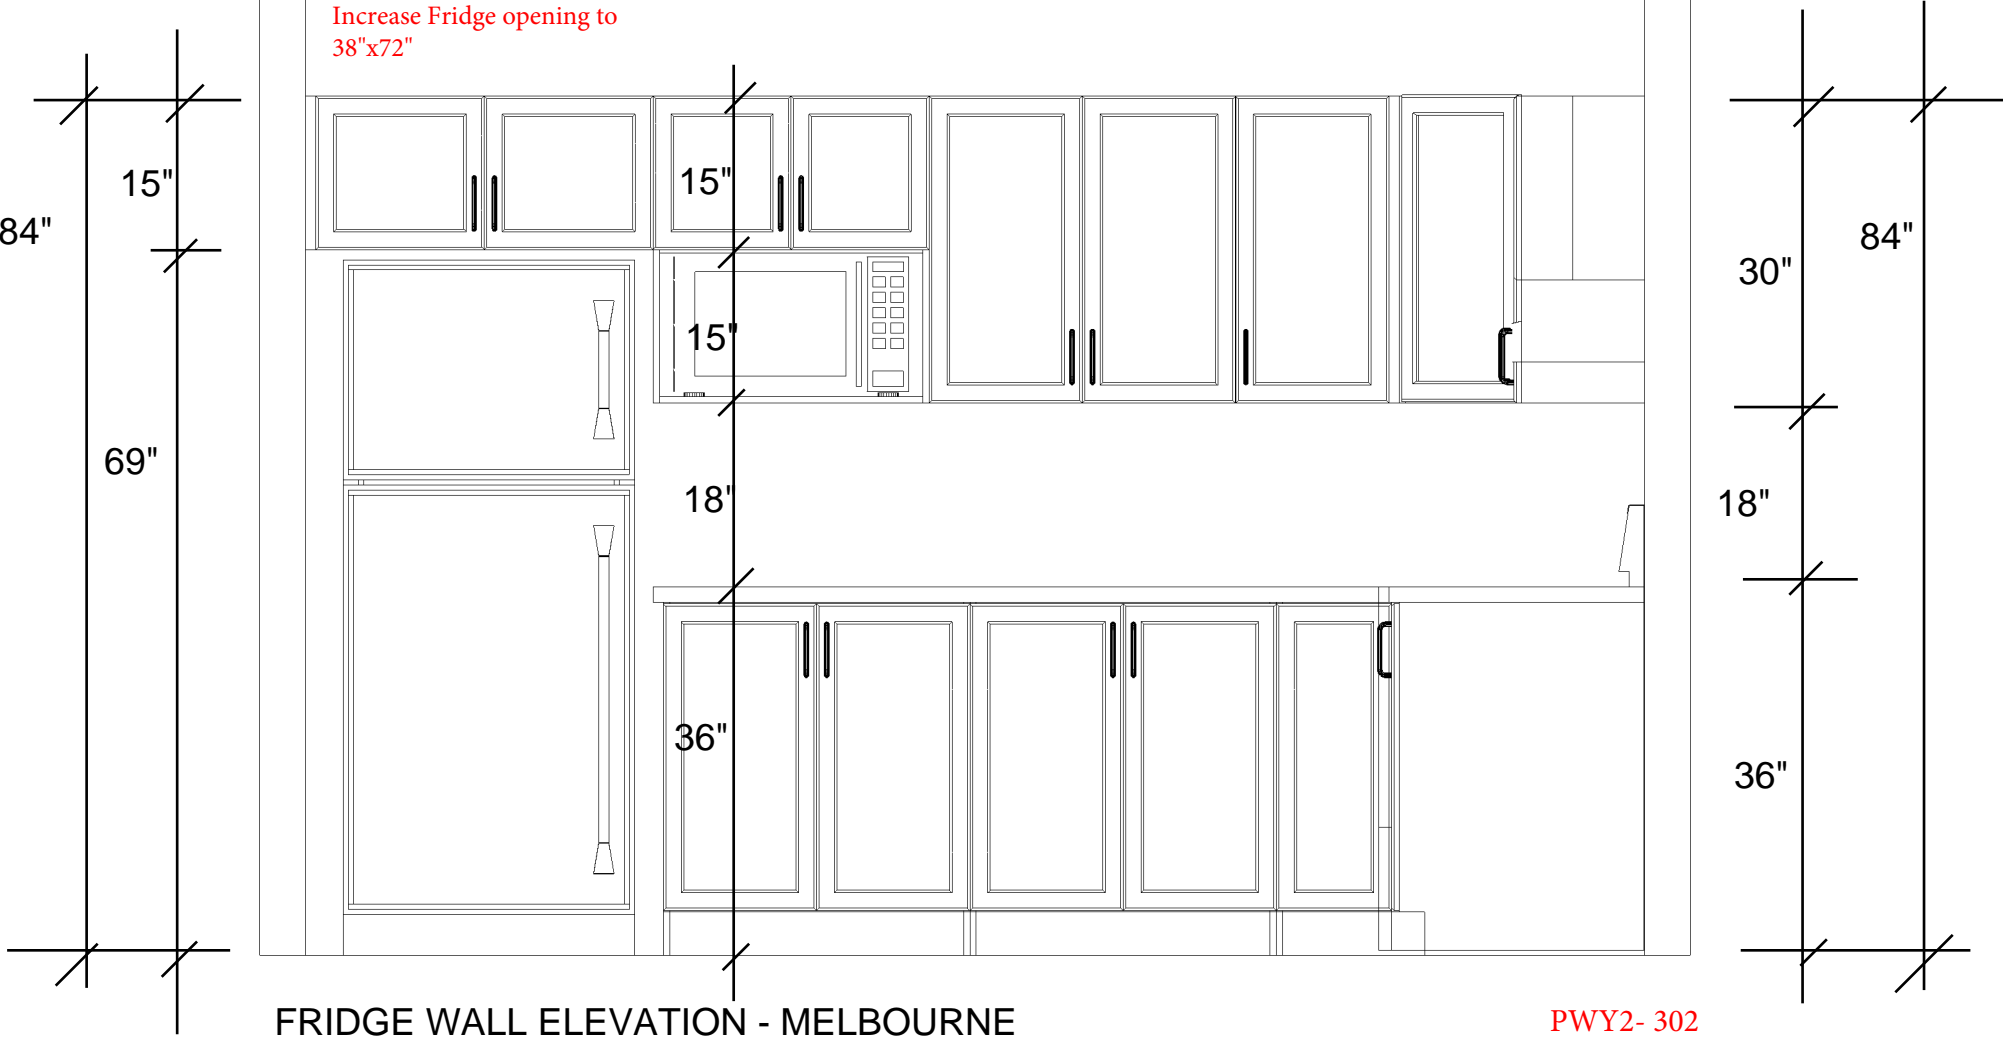


FRIDGE WALL ELEVATION - MELBOURNE

PWY2- 302

DS
STM

Note: This drawing is an artistic interpretation of the general appearance of the design. It is not meant to be an exact rendition.		Designed: 16/05/2016 Printed: 20/05/2016	
Drawn By: Lori D Saverio, B.I.D. SPECTRUM KITCHENS INC			
DCR Phoenix - 35-15 Melbourne - 2016.kit	All		Drawing #: 1

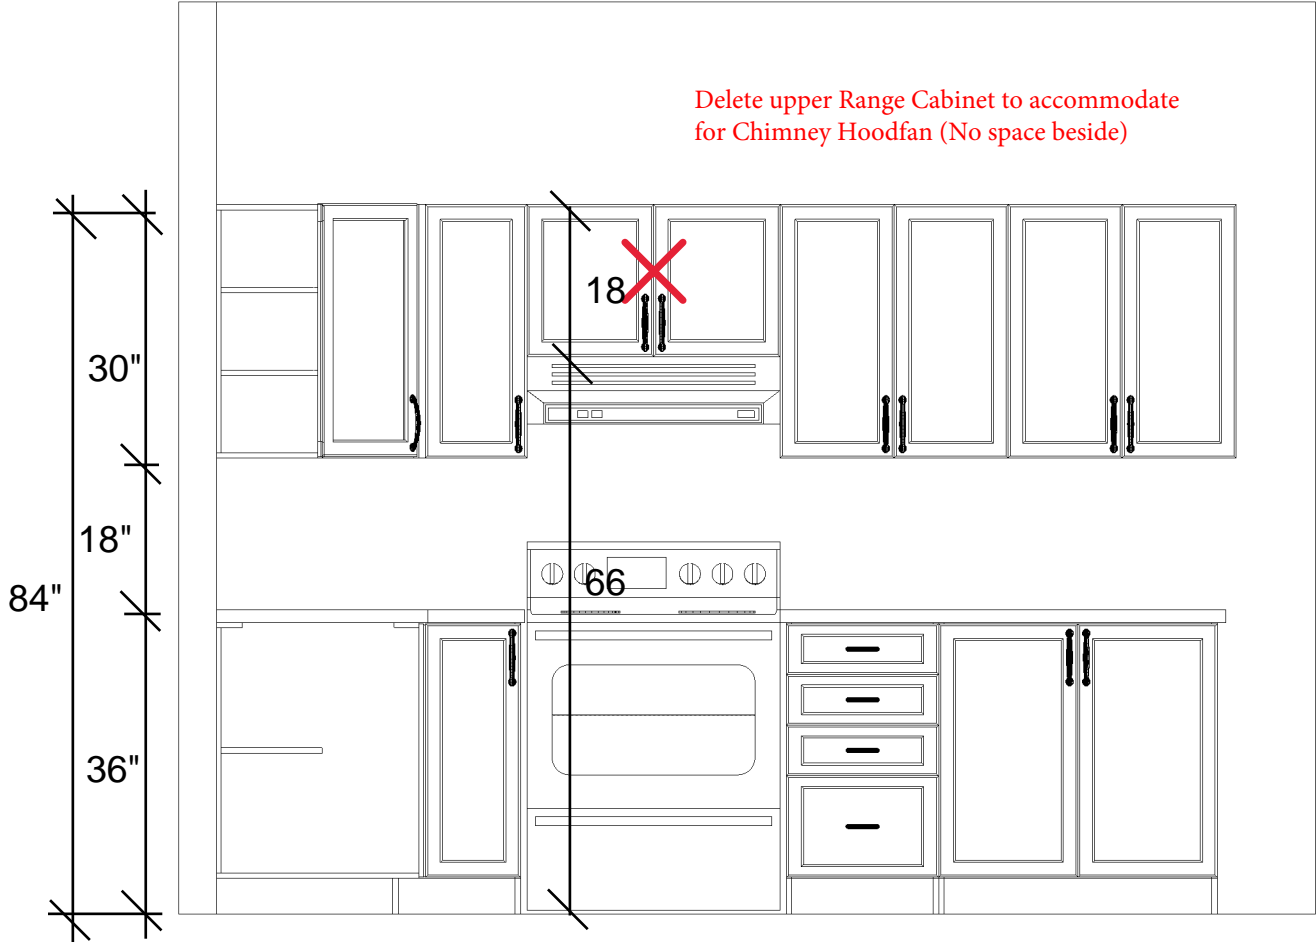

STOVE WALL ELEVATION
DCR PHOENIX - MELBOURNE


PWY2- 302

DS
STM

Note: This drawing is an artistic interpretation of the general appearance of the design. It is not meant to be an exact rendition.




Designed: 5/17/2016
Printed: 5/17/2016

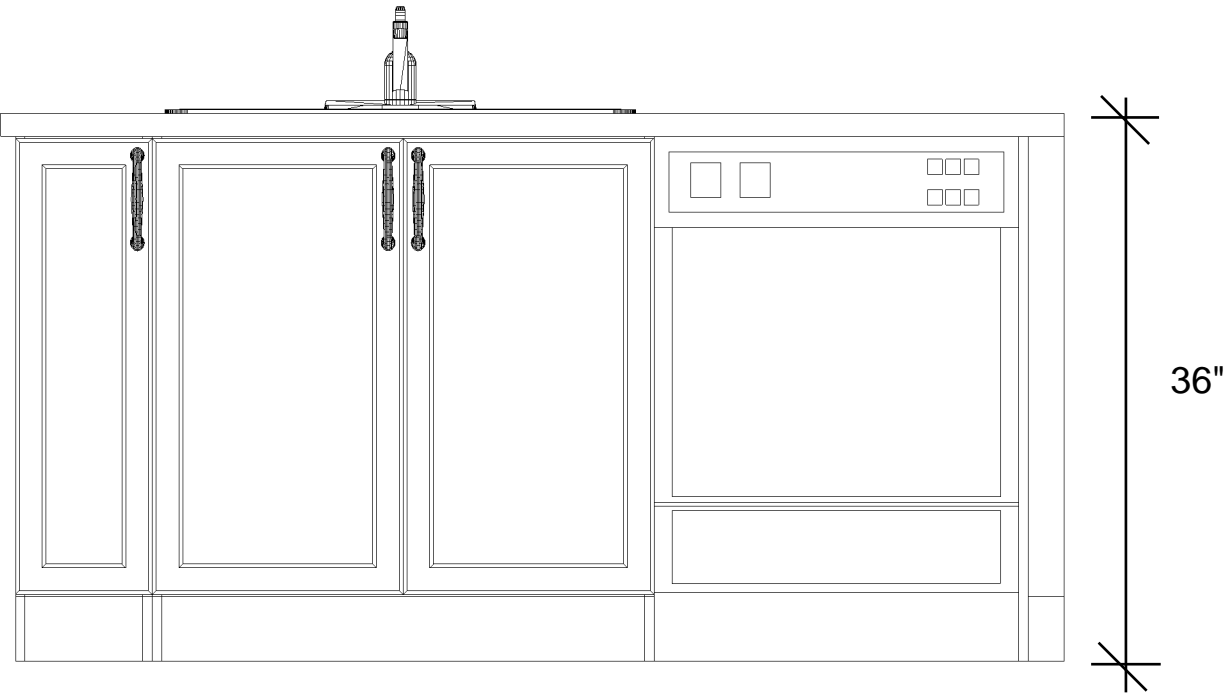

ISLAND ELEVATION

DCR PHOENIX - MELBOURNE

PWY2- 302

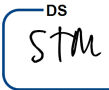


Note: This drawing is an artistic interpretation of the general appearance of the design. It is not meant to be an exact rendition.



Designed: 5/17/2016
Printed: 5/17/2016

Delete upper Range
Cabinet to accommodate
for Chimney Hoodfan (No
space beside)

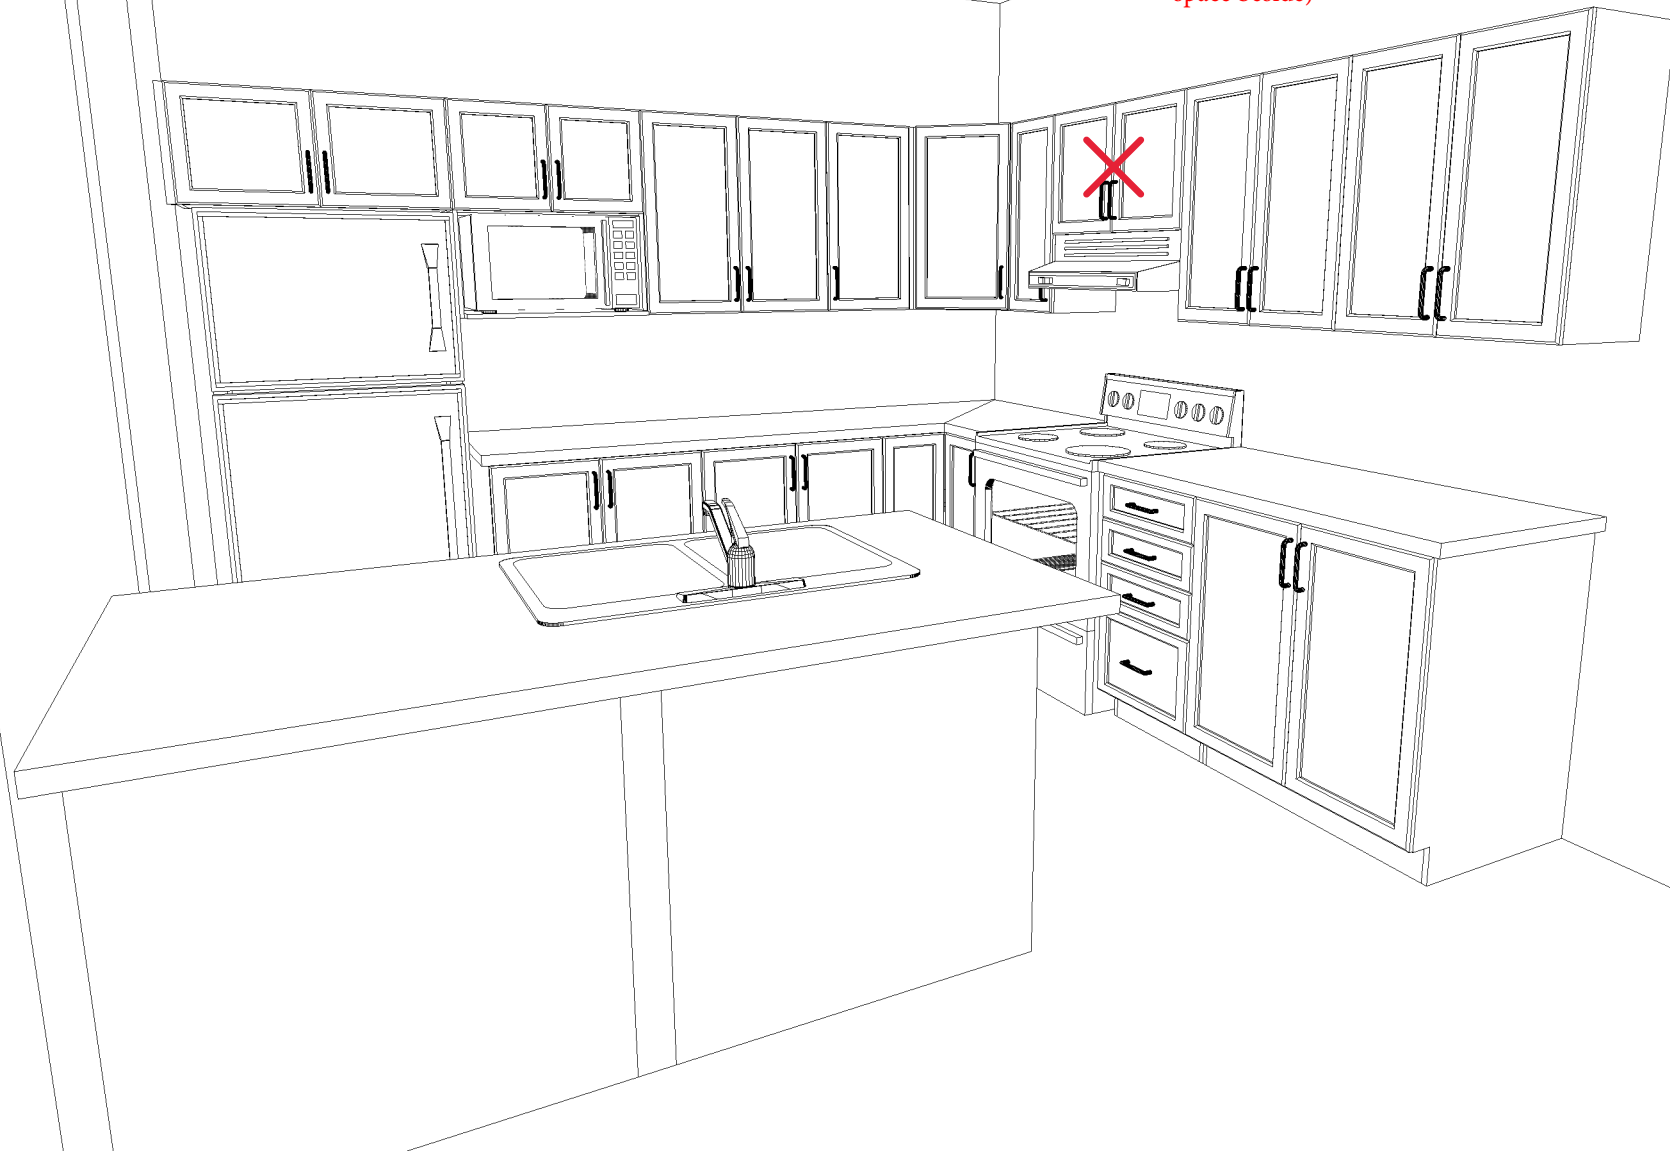

PWY2- 302

DS
STM

Note: This drawing is an artistic interpretation of the general appearance of the design. It is not meant to be an exact rendition.

2020
TECHNOLOGIES


Designed: 16/05/2016
Printed: 20/05/2016

Drawn By: Lori D Saverio, B.I.D.
SPECTRUM KITCHENS INC

DCR Phoenix - 35-15 Melbourne - 2016.kit

All

Drawing #: 1

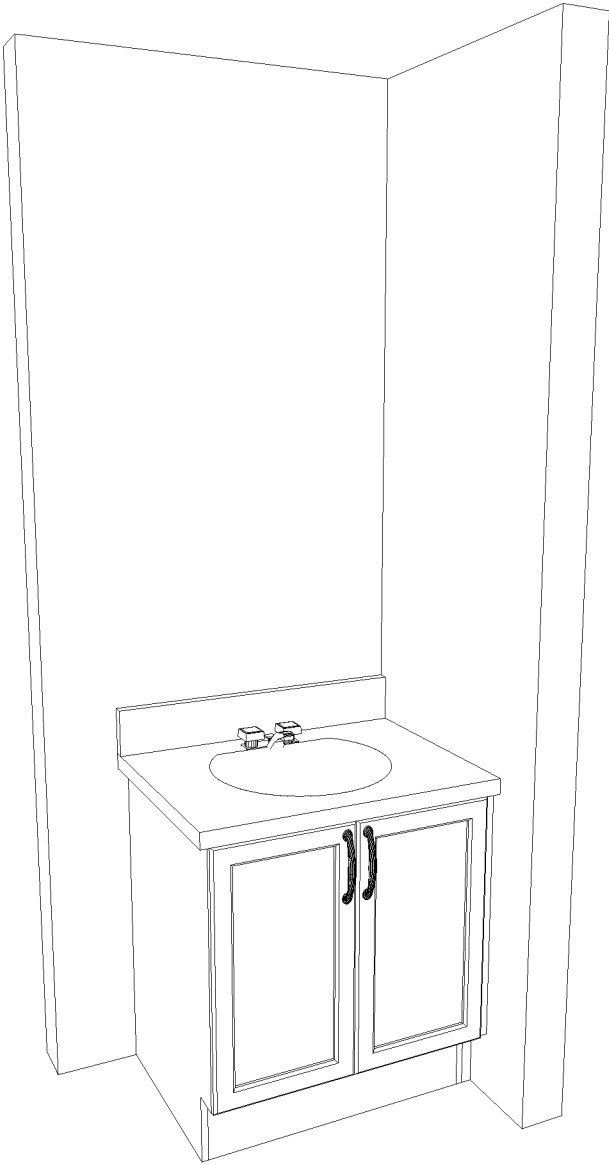

POWDER ROOM

DCR PHOENIX - MELBOUTNE


PWY2- 302

DS
STM

Note: This drawing is an artistic interpretation of the general appearance of the design. It is not meant to be an exact rendition.



Designed: 5/17/2016
Printed: 5/17/2016

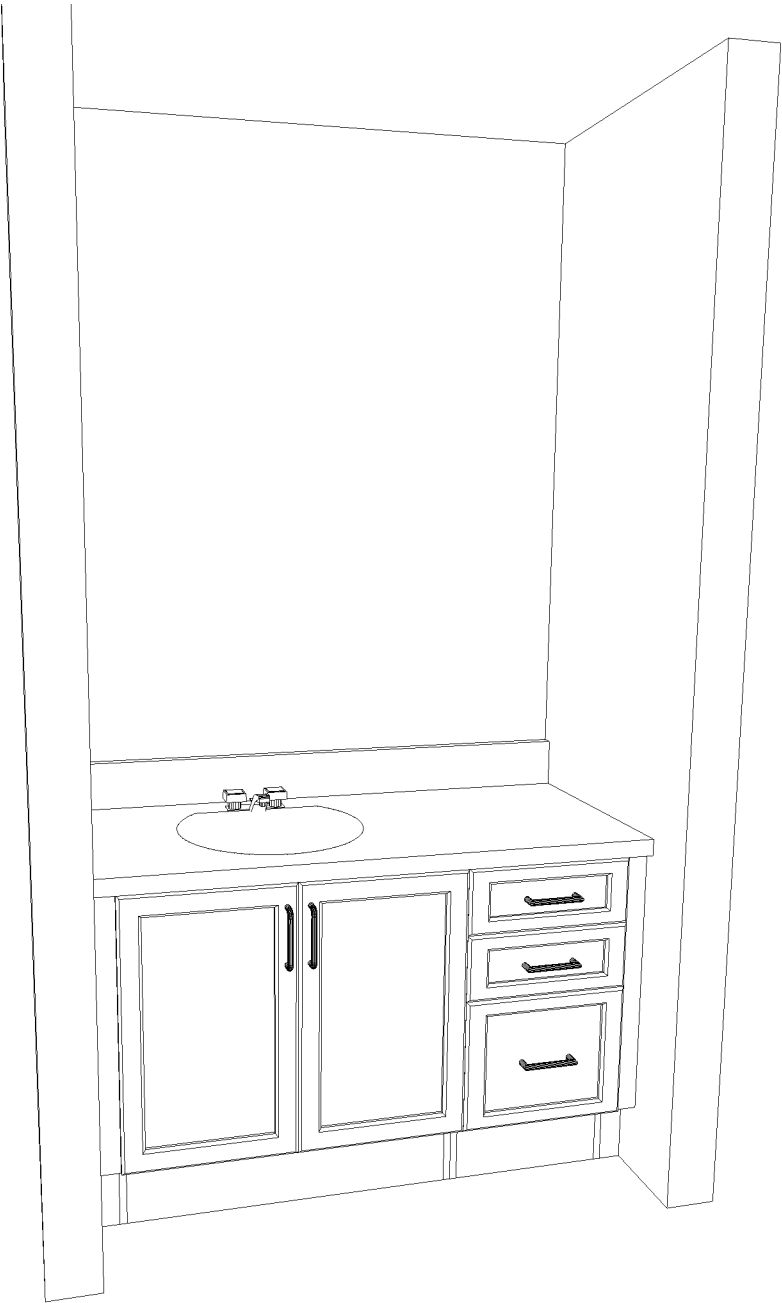

MAIN BATH VANITY
MELBOURNE (35-15) 4 BDRM

DS
STM


Note: This drawing is an artistic interpretation of the general appearance of the design. It is not meant to be an exact rendition.

Drawn By: Lori D Saverio, B.I.D.
SPECTRUM KITCHENS INC



Designed: 23/05/2016
Printed: 23/05/2016


PWY2- 302

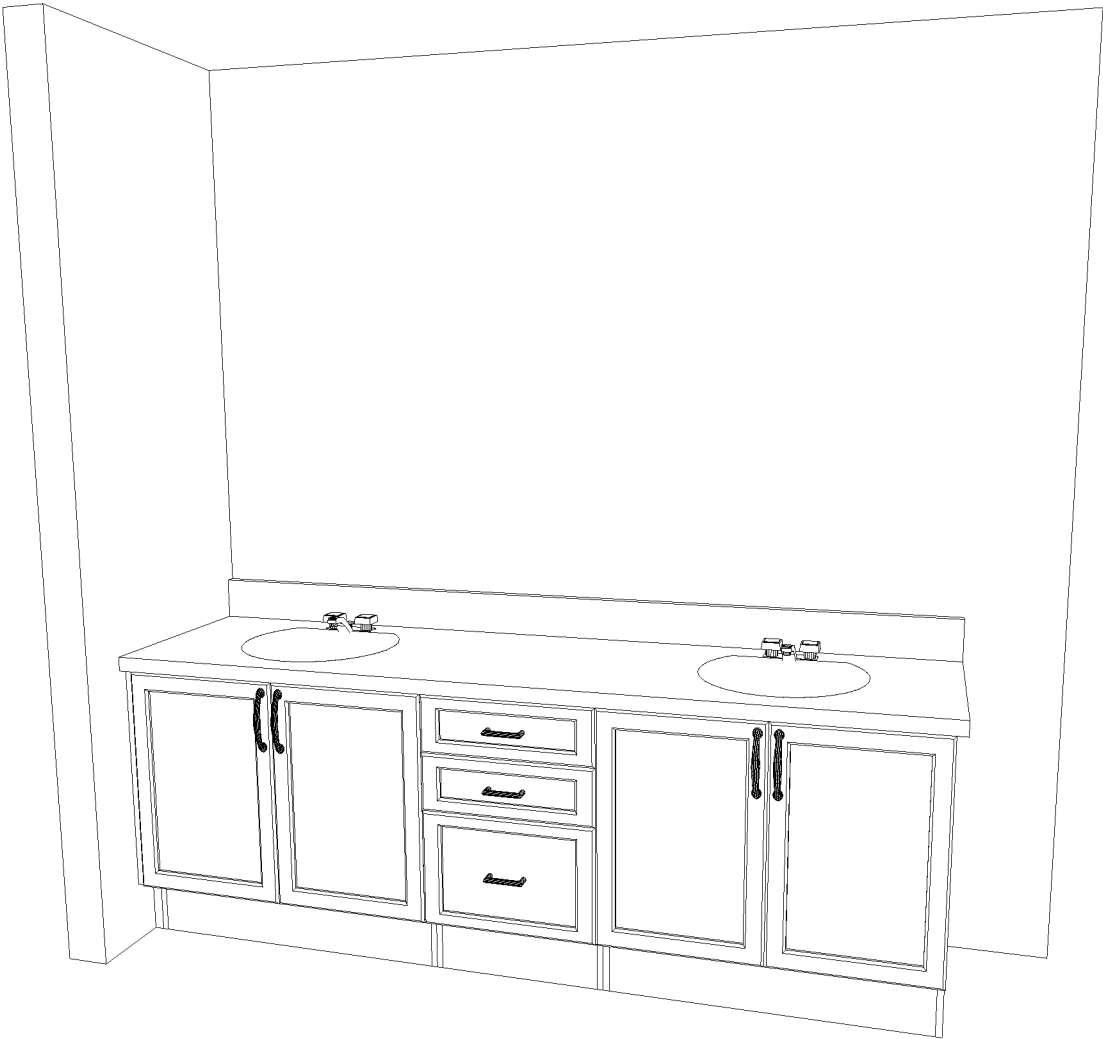

ENSUITE

DCR PHOENIX - MELBOURNE

PWY2- 302

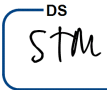

Note: This drawing is an artistic interpretation of the general appearance of the design. It is not meant to be an exact rendition.



Designed: 5/17/2016
Printed: 5/17/2016