


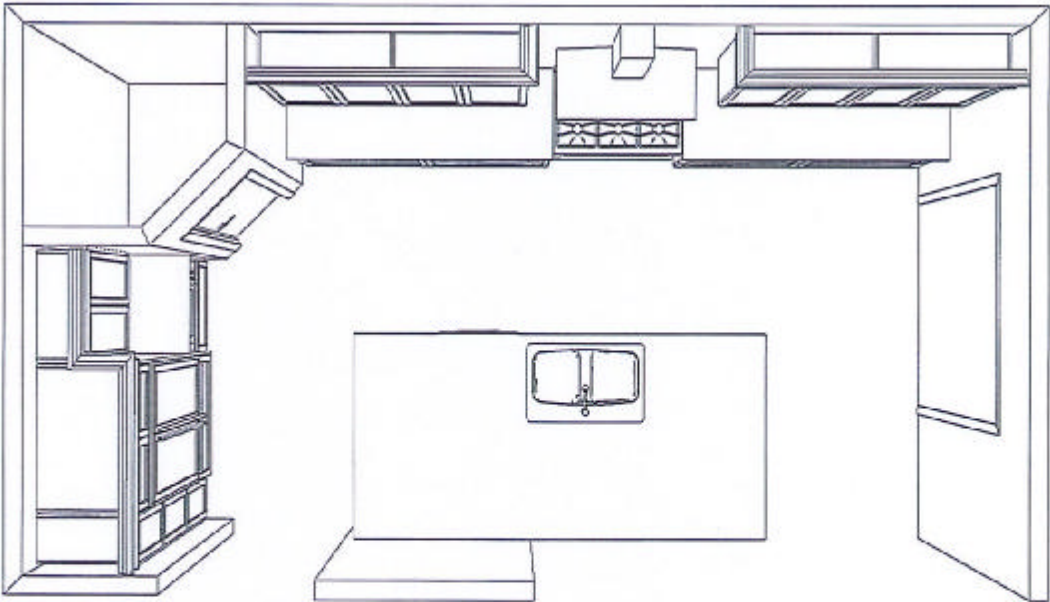


KITCHEN - TOP VIEW
LOT #65 PATHWAYS

CUSTOMER APPROVAL	
I have reviewed these drawings and understand the details of the design and the CARRIER KITCHENS specifications.	
Signature _____	
Date _____	

Note: This drawing is an artistic interpretation of the general appearance of the design. It is not meant to be an exact rendition.	Designed: 2018-01-12
	Printed: 2018-08-16
SPECTRUM KITCHEN and BATH DESIGN	
PATHWAYS - MODEL HOME 2.kit All	Drawing #: 1

DS

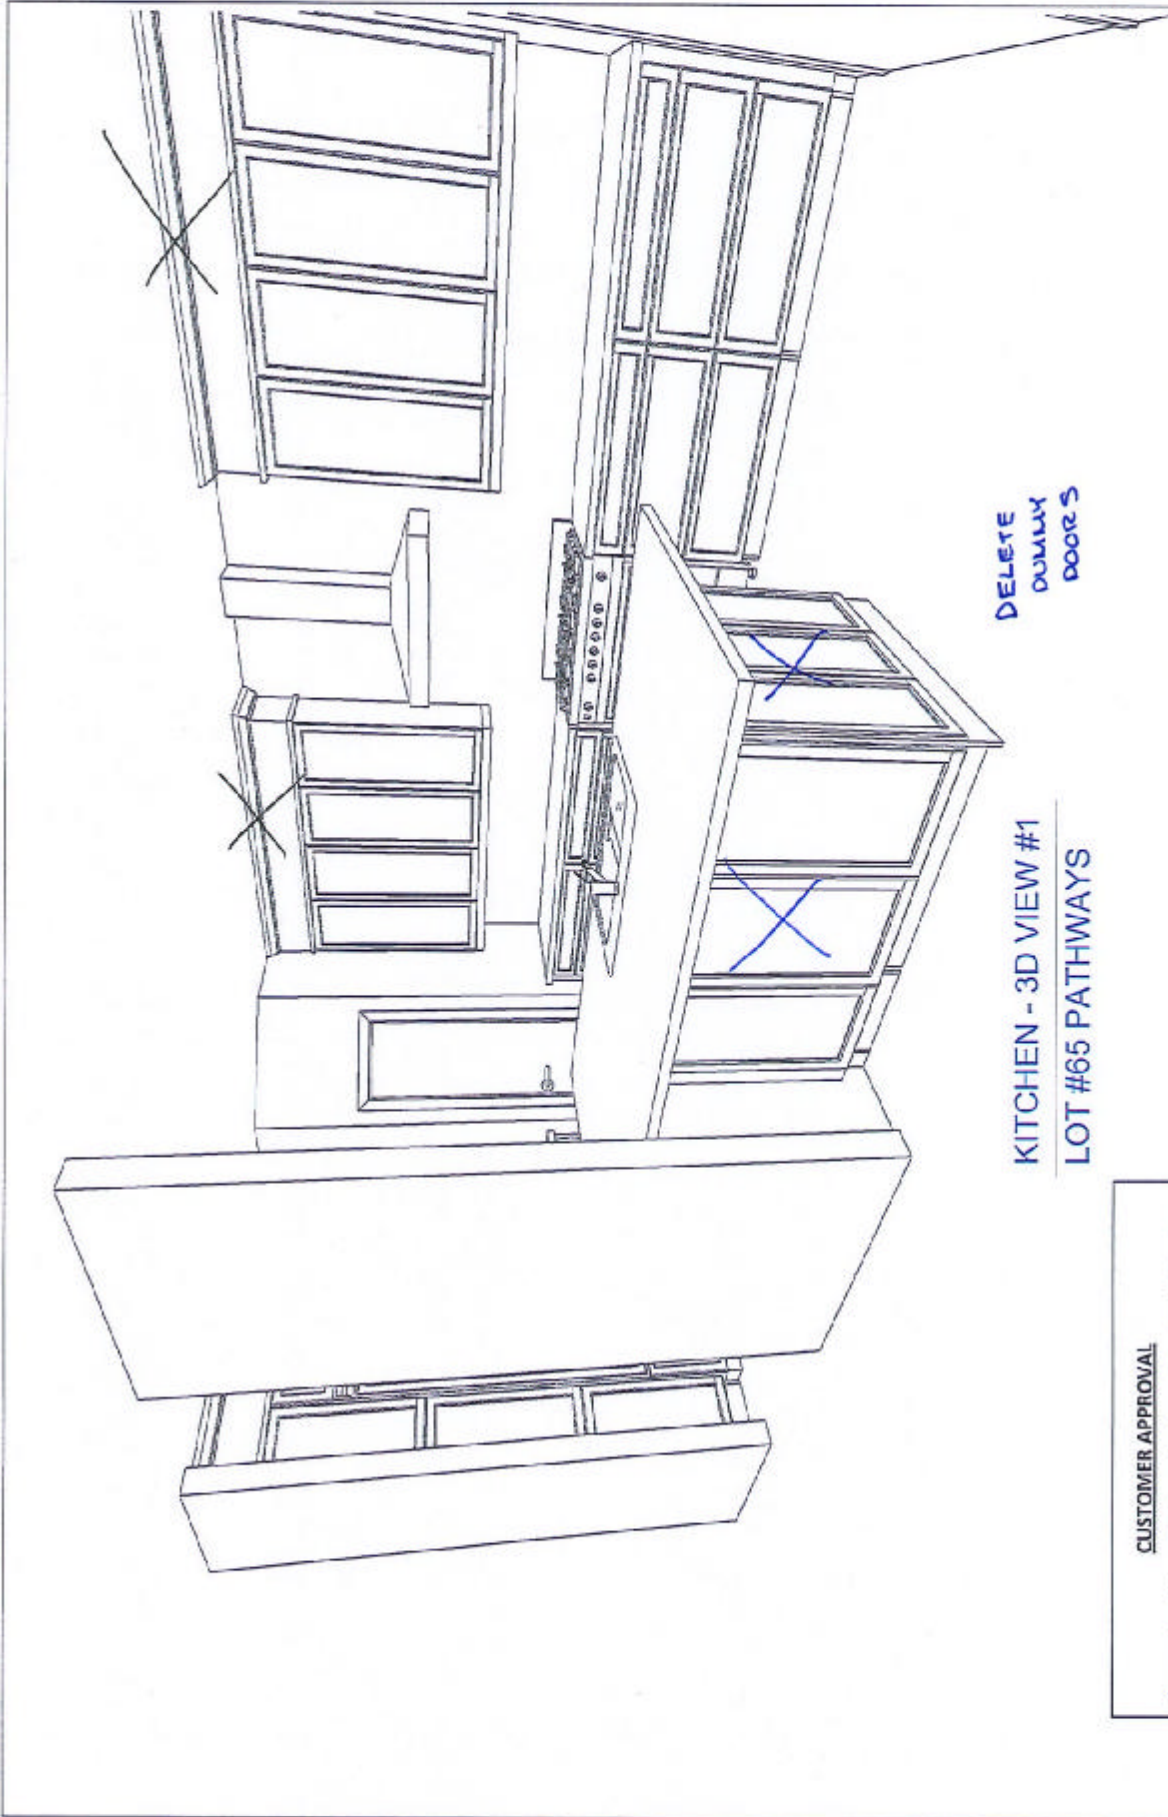DELETE
DUMMY
DOORS

KITCHEN - 3D VIEW #1
LOT #65 PATHWAYS

CUSTOMER APPROVAL

I have reviewed these drawings and understand the details of the design and the CARTIER KITCHENS specifications.

Signature _____

Date _____

Note: This drawing is an artistic interpretation of the general appearance of the design. It is not meant to be an exact rendition.

SPECTRUM KITCHEN and BATH
DESIGN


PATHWAYS - MODEL HOME 2.kit

All

Drawing #: 1

Designed: 2018-01-12
Printed: 2018-08-16

DS

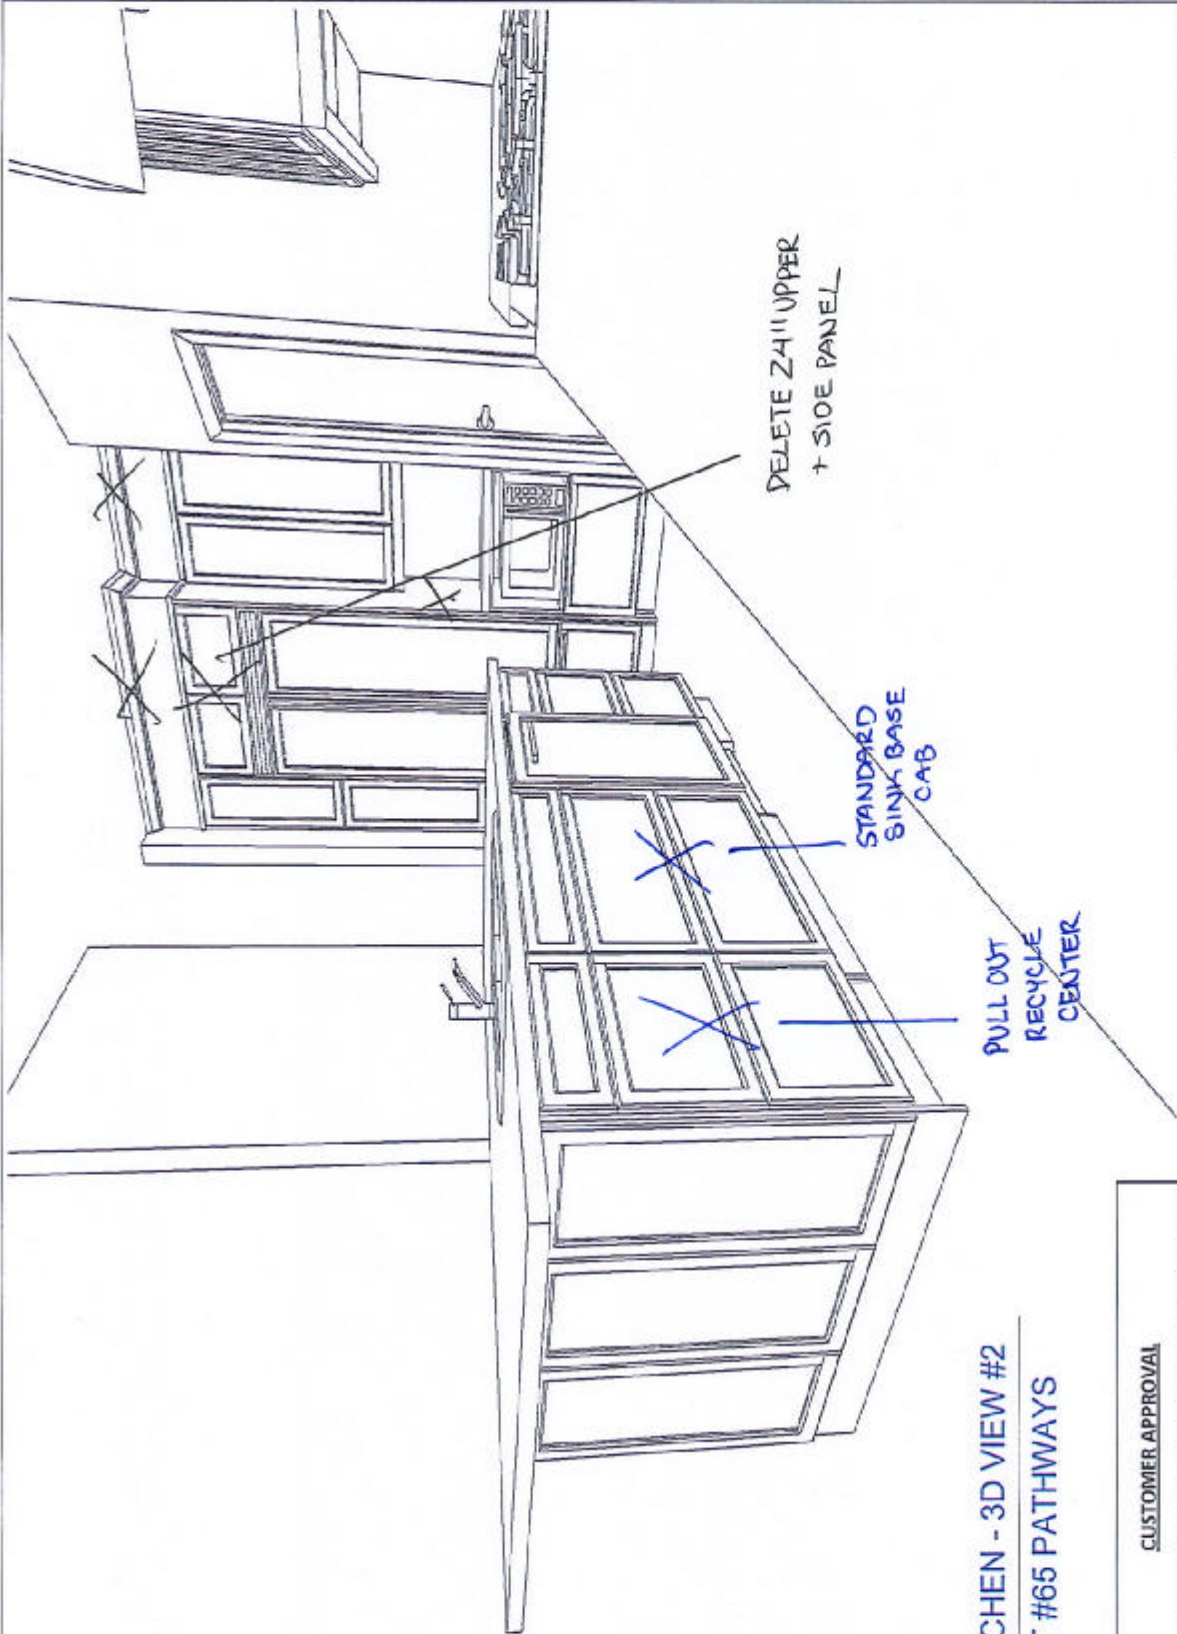

KITCHEN - 3D VIEW #2
LOT #65 PATHWAYS


CUSTOMER APPROVAL

I have reviewed these drawings and understand the details of the design and the CANTIER KITCHENS specifications.

Signature _____

Date _____

Note: This drawing is an artistic interpretation of the general appearance of the design. It is not meant to be an exact rendition.	Designed: 2018-01-12	
	Printed: 2018-08-16	
SPECTRUM KITCHEN and BATH DESIGN		
	PATHWAYS - MODEL HOME 2.kit	Drawing #: 1

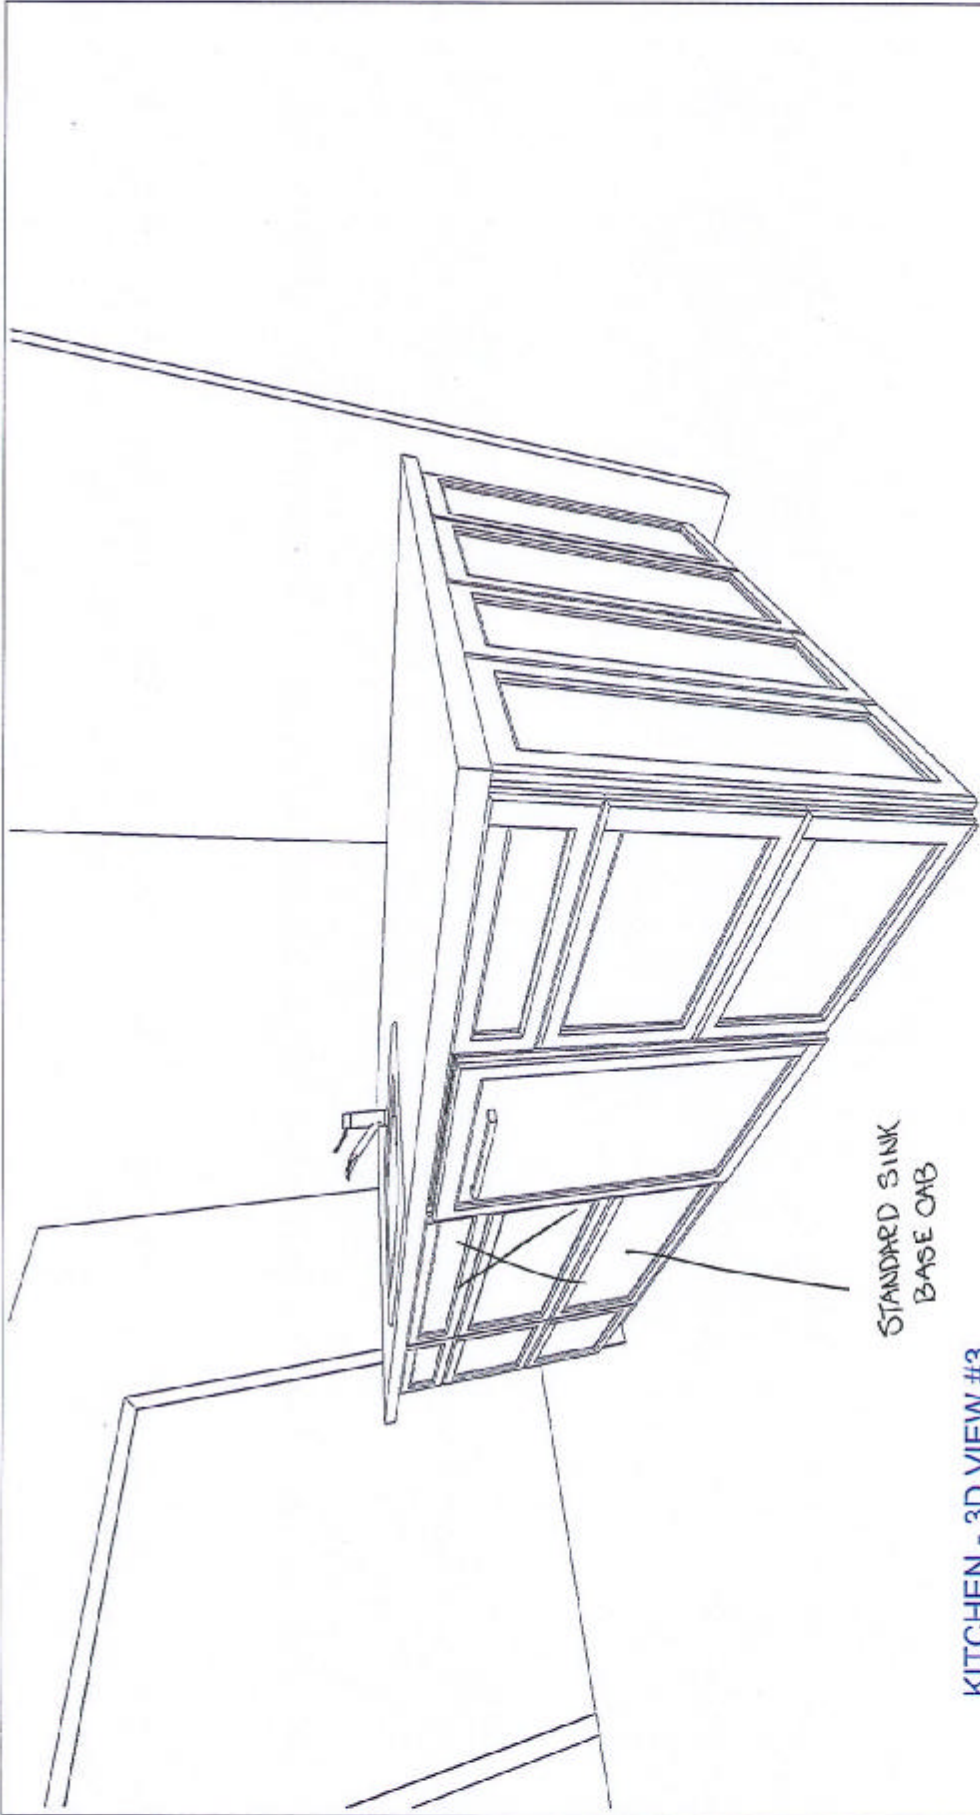

STANDARD SINK
BASE CAB

KITCHEN - 3D VIEW #3
LOT #65 PATHWAYS

CUSTOMER APPROVAL

I have reviewed these drawings and understand the details of the design and the CARTER KITCHENS specifications.

Signature _____

Date _____

Note: This drawing is an artistic interpretation of the general appearance of the design. It is not meant to be an exact rendition.

SPECTRUM KITCHEN and BATH
DESIGN

PATHWAYS - MODEL HOME 2.kit


All

Drawing #: 1

Designed: 2018-01-12

Printed: 2018-08-16

DS

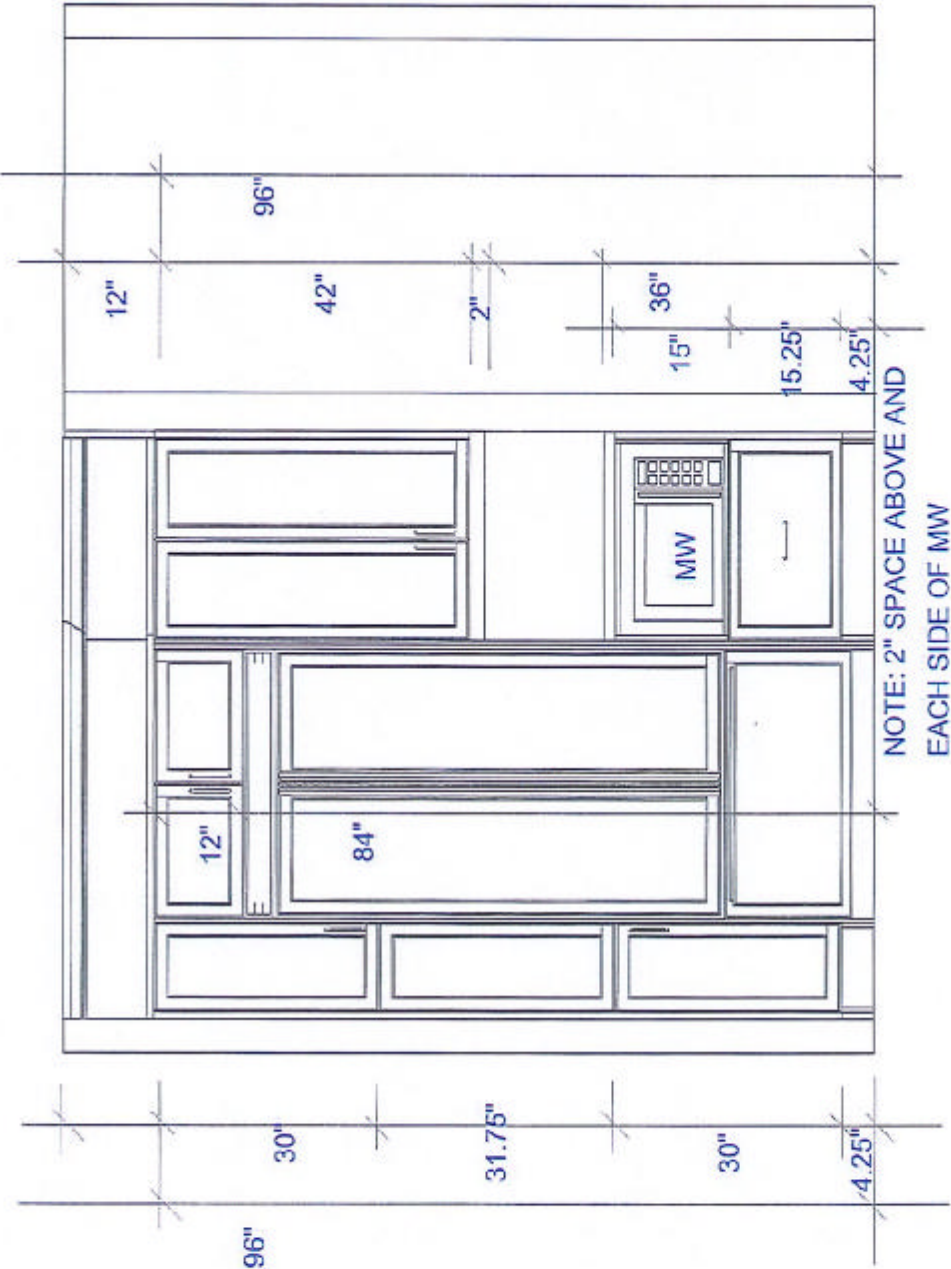

FRIDGE WALL ELEVATION - LOT 65 PATHWAYS

CUSTOMER APPROVAL


I have reviewed these drawings and understand the details of the design and the CARTIER KITCHENS specifications.

Signature _____

Date _____

Note: This drawing is an artistic interpretation of the general appearance of the design. It is not meant to be an exact rendition.	Designed: 2018-01-12 Printed: 2018-08-16	
	SPECTRUM KITCHEN and BATH DESIGN	PATHWAYS - MODEL HOME 2.kit
All		Drawing #: 1

DS

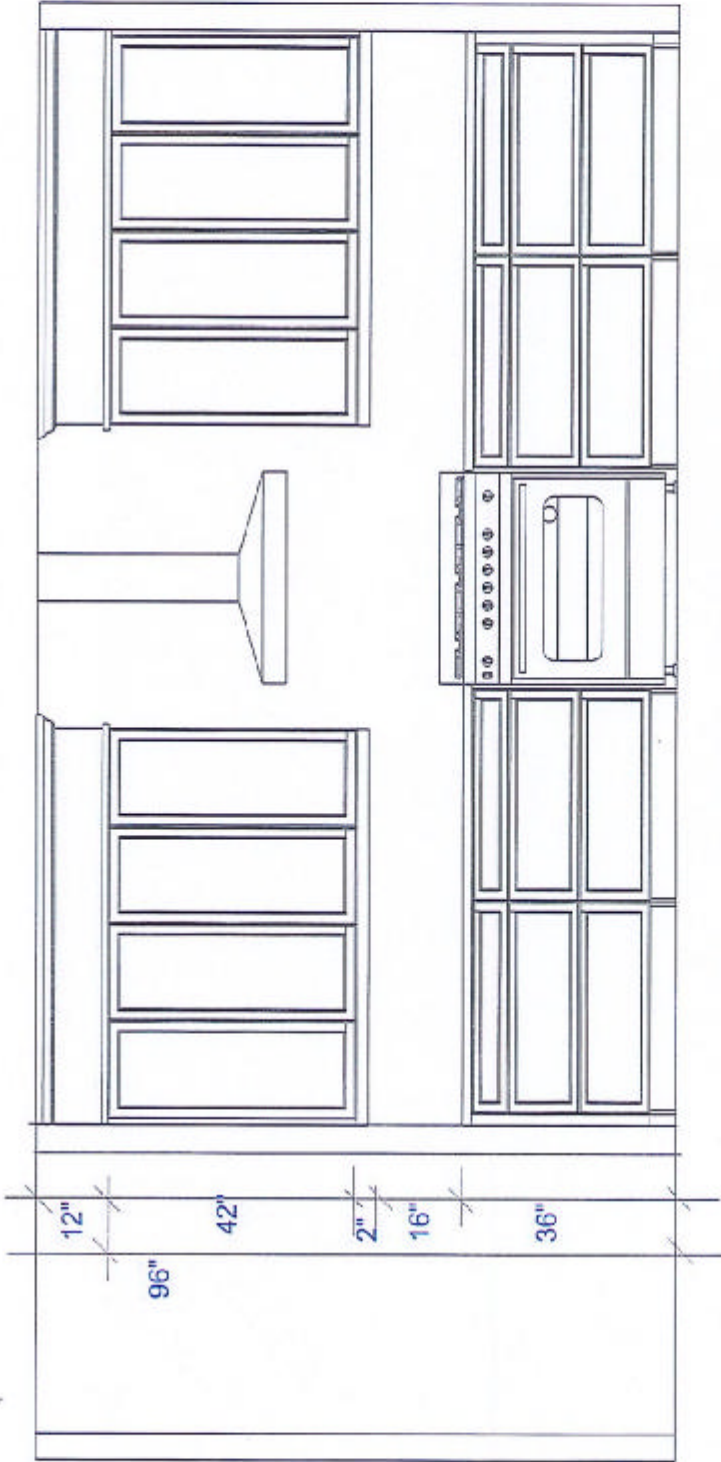RANGE WALL ELEVATION - LOT #65 PATHWAYS

CUSTOMER APPROVAL

I have reviewed these drawings and understand the details of the design and the CARTIER KITCHENS specifications.

Signature _____
Date _____


Note: This drawing is an artistic interpretation of the general appearance of the design. It is not meant to be an exact rendition.

SPECTRUM KITCHEN and BATH DESIGN

PATHWAYS - MODEL HOME 2.kit All

Designed: 2018-01-12
Printed: 2018-08-16


Drawing #: 1

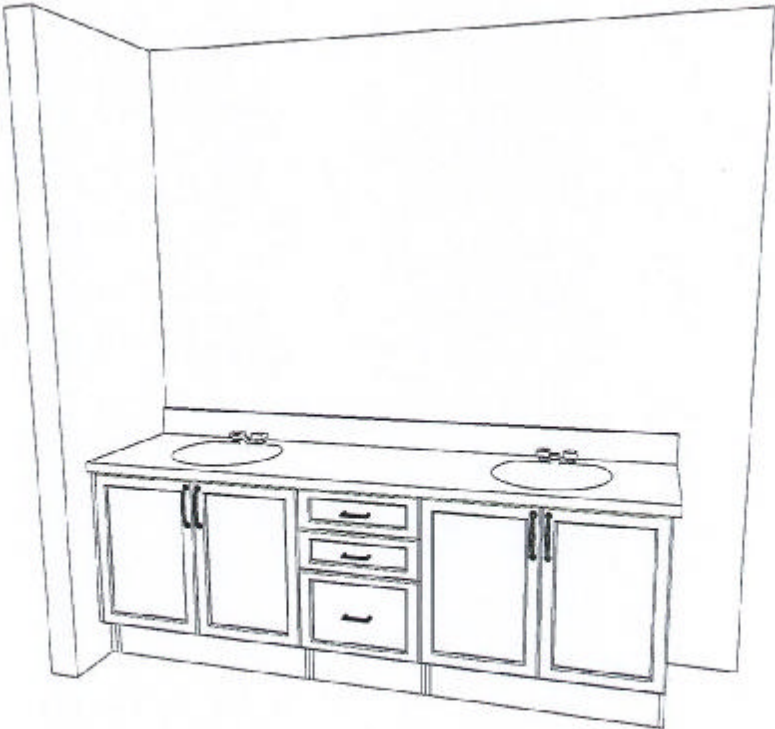

ENSUITE
DCR PHOENIX - MELBOURNE

Note: This drawing is an artistic interpretation of the general appearance of the design. It is not meant to be an exact rendition.	 	Designed: 5/17/2016
		Printed: 5/17/2016
DCR Phoenix - Melbourne - 2016	All	Drawing #: 1

DS

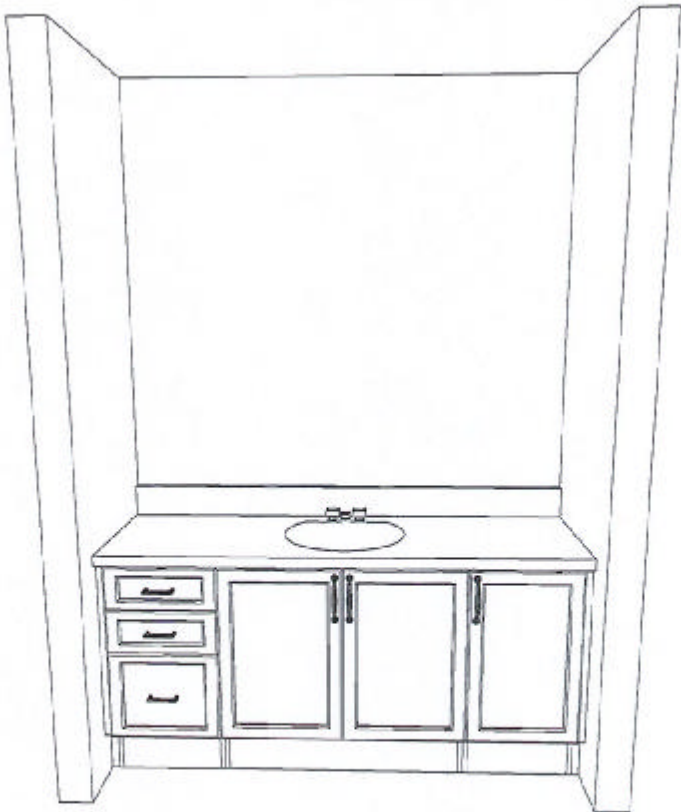ENSUITE
DCR PHOENIX - MELBOURNE


Note: This drawing is an artistic interpretation of the general appearance of the design. It is not meant to be an exact rendition.



Designed: 5/17/2016
Printed: 5/17/2016

DCR Phoenix - Melbourne - 2016	All	Drawing #: 1
--------------------------------	-----	--------------

DS

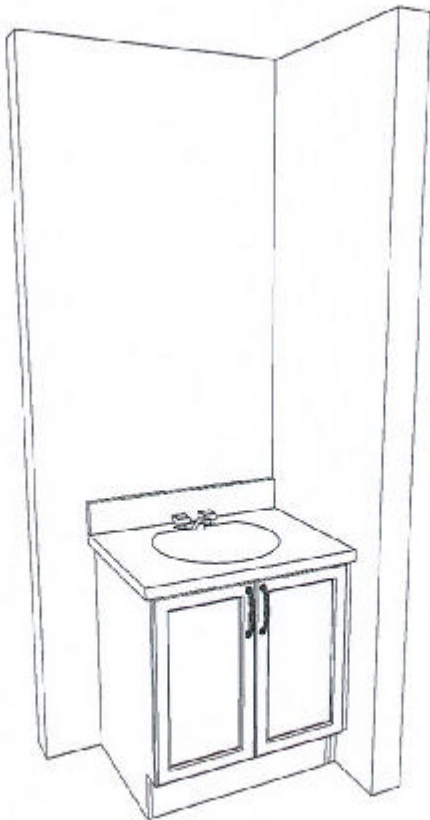

POWDER ROOM
DCR PHOENIX - MELBOUTNE

Note: This drawing is an artistic interpretation of the general appearance of the design. It is not meant to be an exact rendition.



Designed: 5/17/2016
Printed: 5/17/2016

DCR Phoenix - Melbourne - 2016

All

Drawing #: 1

DS