

DCR PHOENIX HOMES

SPRINGFIELD
STANDARD KITCHEN

STANDARD KITCHEN

MOUNTING HEIGHT - 84

KITCHEN

LINE 1 & 2

HARDWARE - STD & 1st UPGRADE

STANDARD WHITE INTERIOR

METAL DRAWER BOX




3 PCS - 5/8" KICK - FIN. BOTH ENDS

3 PCS - LOOSE FILLER - 3 x 96

2 PCS - 90 DEG. CORNER MOULD

1 PCS - T-MOULD

1 PCS - FLAT MOULDING

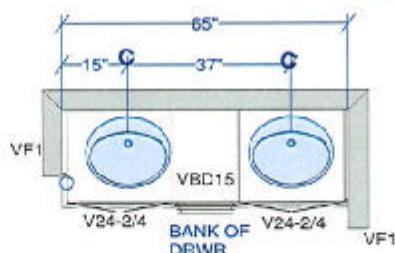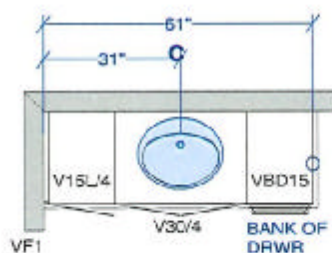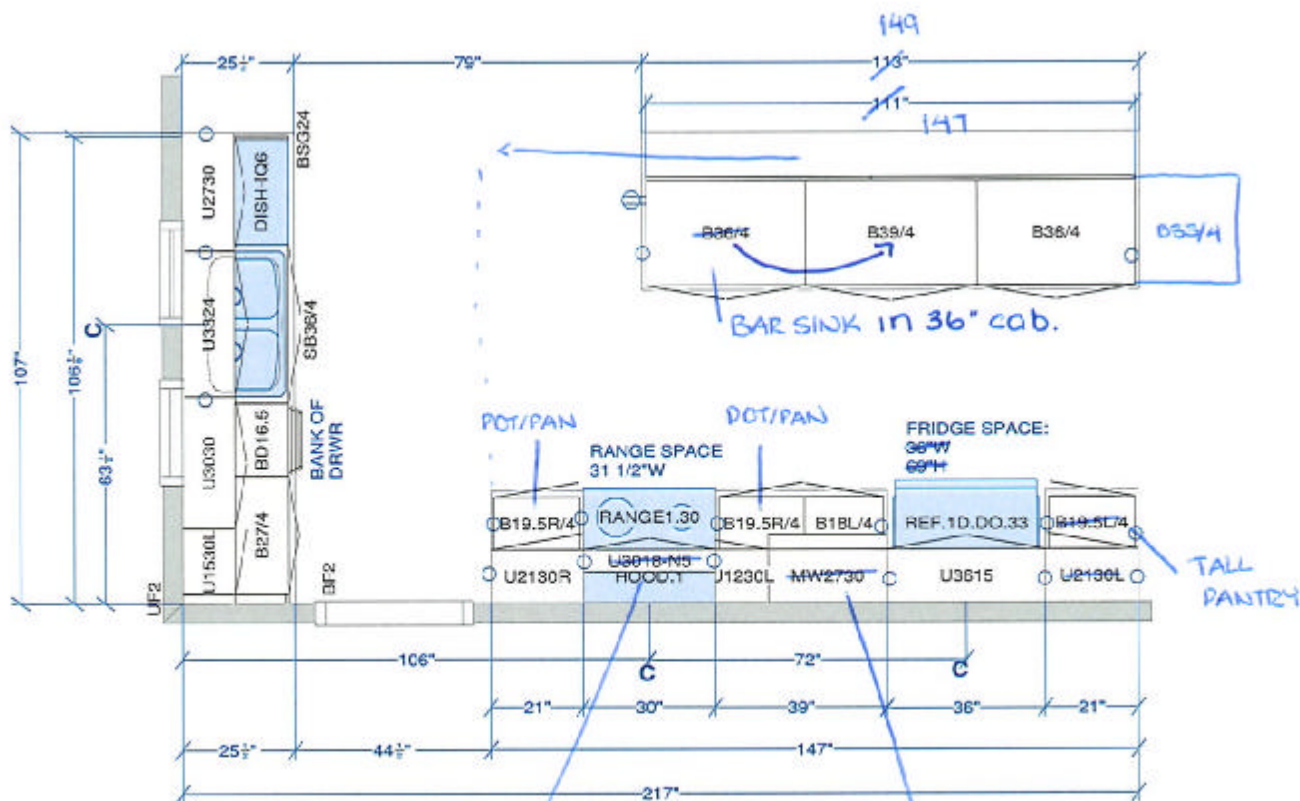

MAIN BATH

All dimensions, size designations given are subject to verification on job site and adjustment to fit job conditions.



ENSUITE

This is an original design and must not be released or copied unless applicable fee has been paid or job order placed.

Designed: 2017-11-15
Printed: 2017-11-29

Printed: 2017-11-29


Springfield Standard

АИ

Drawing #: 1

No Scale.

DS DS

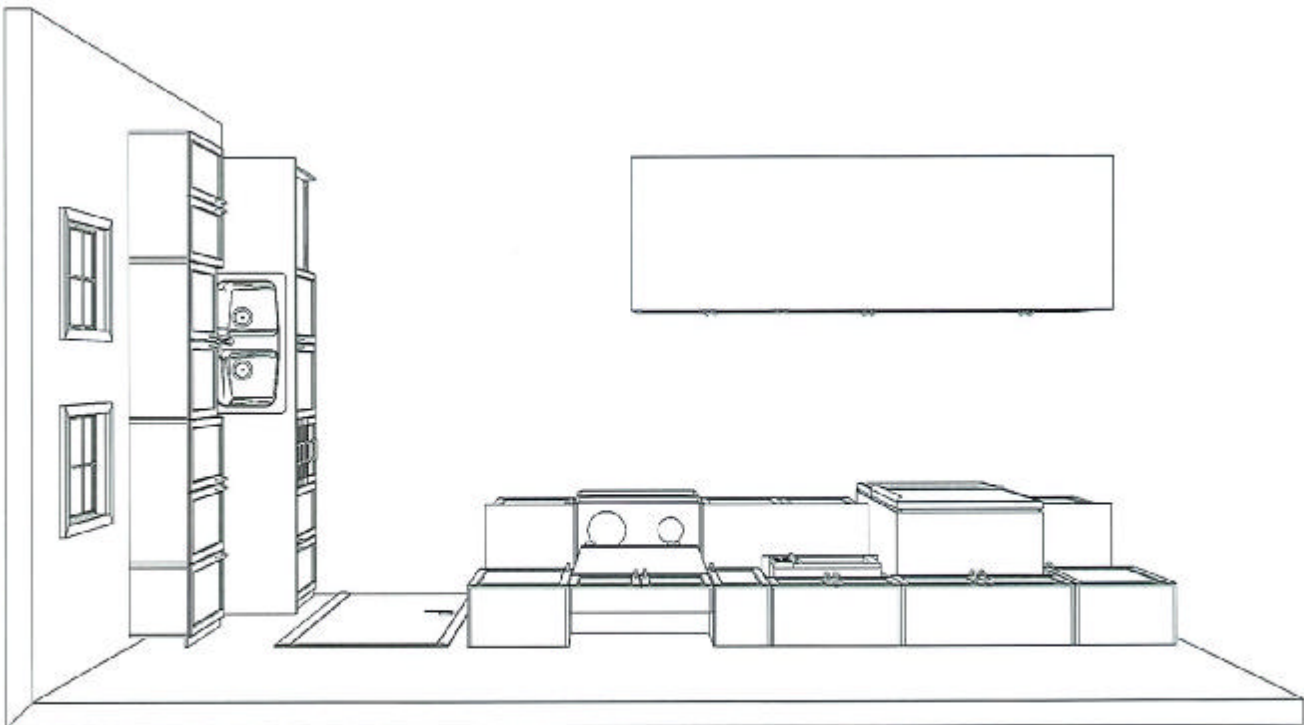

KITCHEN TOP VIEW
DCR - SPRINGFIELD STANDARD KITCHEN

CUSTOMER APPROVAL

I have reviewed these drawings and understand the details of the design and the Cartier Kitchens specifications

Signature _____
Date _____

Note: This drawing is an artistic interpretation of the general appearance of the design. It is not meant to be an exact rendition.



Designed: 2017-11-15
Printed: 2017-11-29




CUSTOMER APPROVAL:
Have reviewed these drawings and understand the details of the design and the Carrier Kitchen specifications.
Signature _____
Date _____


Note: This drawing is an artistic interpretation of the general appearance of the design. It is not meant to be an exact rendition.



Designed: 2017-11-15
Printed: 2017-11-29

Springfield Standard All Drawing #: 1

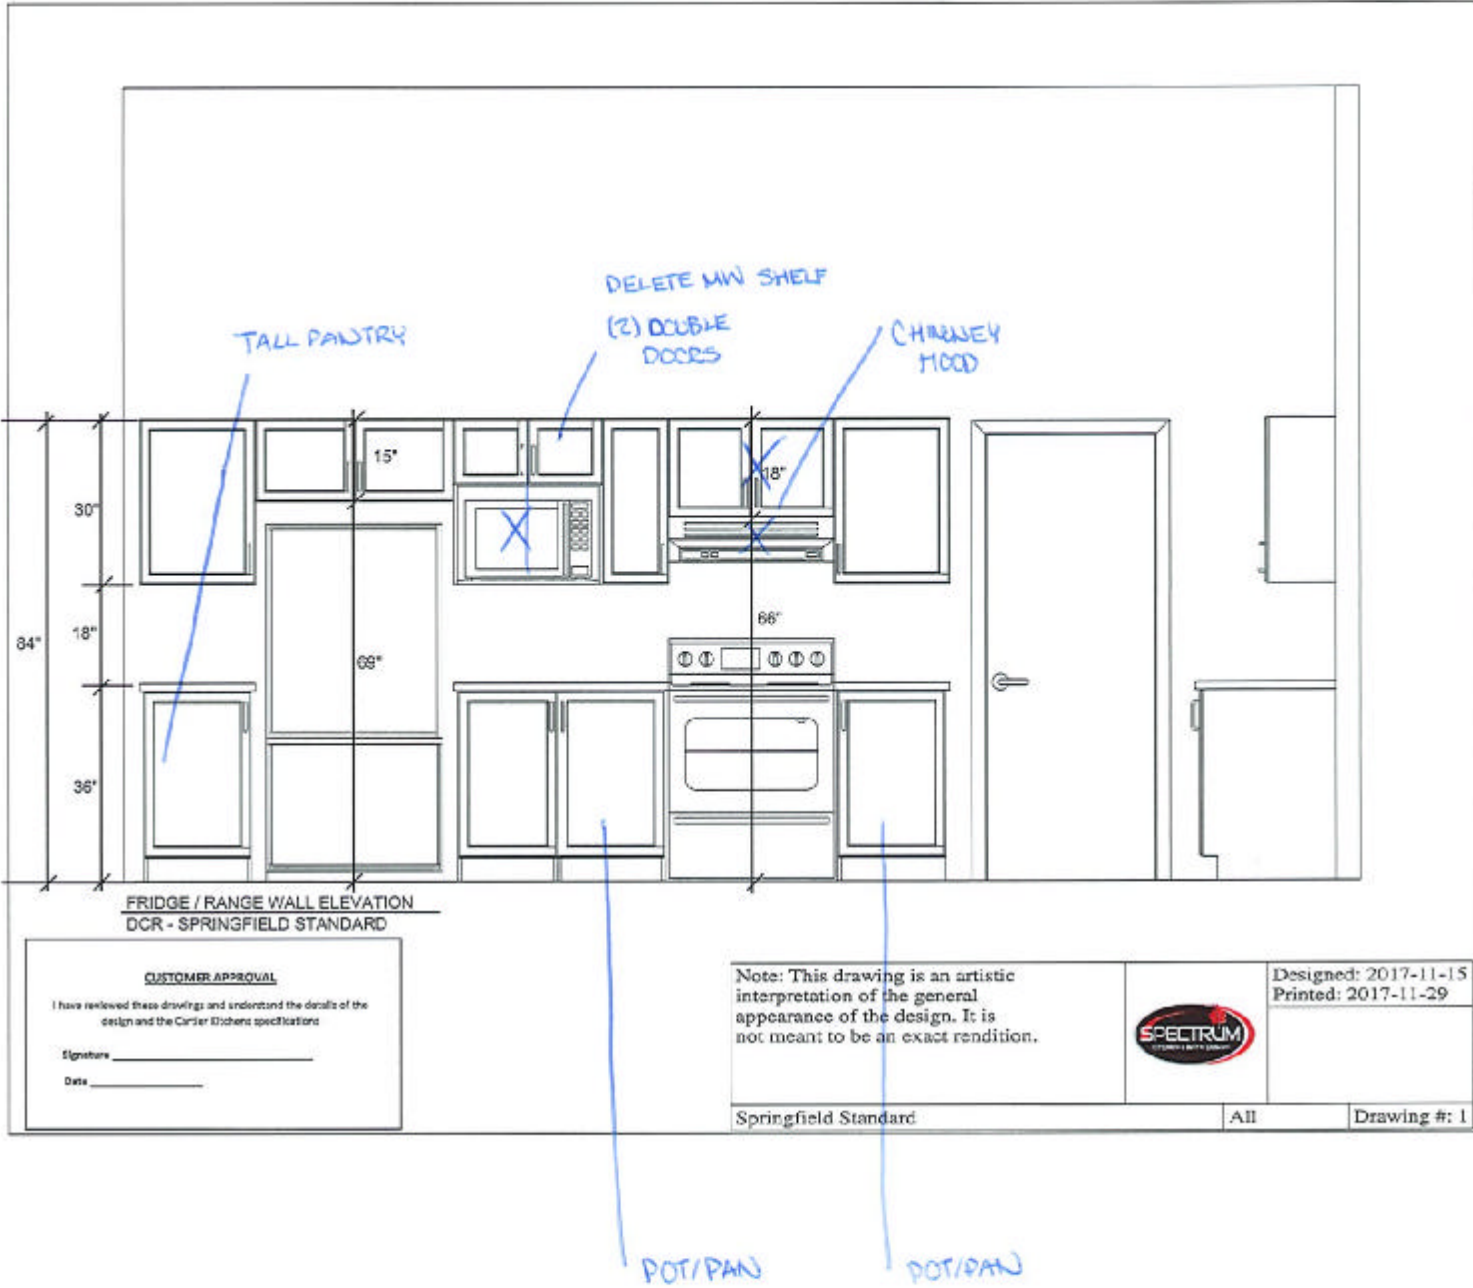

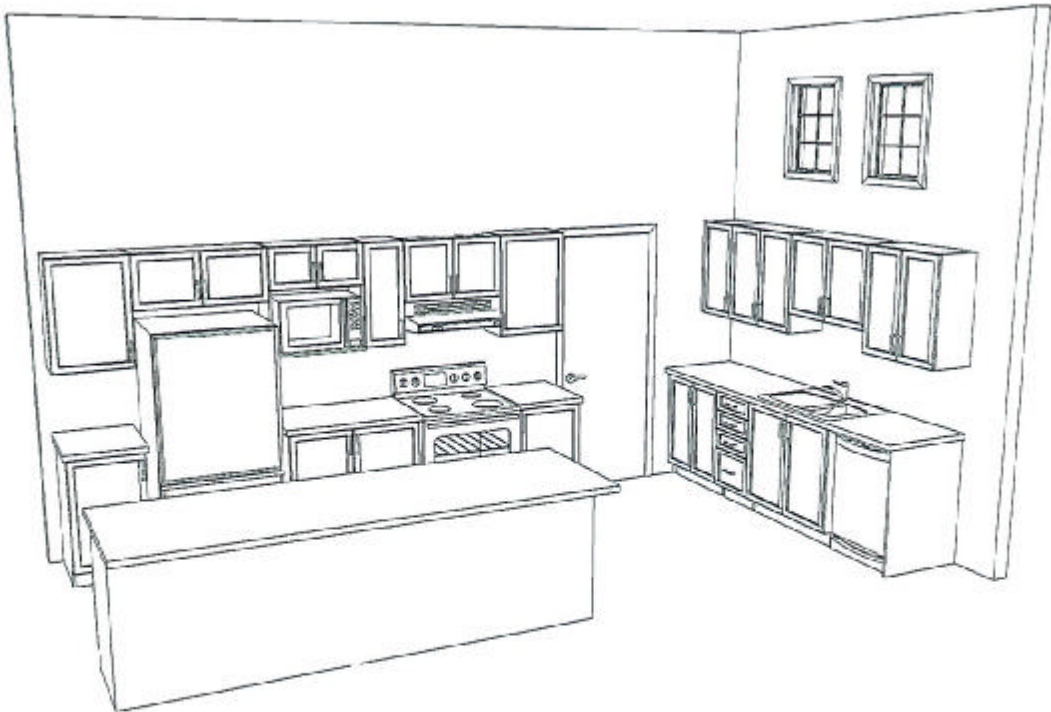

KITCHEN 3D-VIEW 1
DCR - SPRINGFIELD STANDARD KITCHEN

CUSTOMER APPROVAL I have reviewed these drawings and understand the details of the design and the Cartier Kitchens specifications Signature _____ Date _____

Note: This drawing is an artistic interpretation of the general appearance of the design. It is not meant to be an exact rendition.



Designed: 2017-11-15 Printed: 2017-11-29

A 3D perspective line drawing of a kitchen island. The island has a rectangular countertop and a base with cabinets. A blue circle is drawn on the countertop, with a blue arrow pointing to it from the text "BAR SINK". Another blue arrow points from the text "ADDITIONAL 33\" to a section of the island's side cabinets, with a plus sign and the word "CABINET" below it.

KITCHEN 3D-VIEW 2
DCR - SPRINGFIELD STANDARD KITCHEN

CUSTOMER APPROVAL

I have reviewed these drawings and understand the details of the design and the Cartier Kitchens specifications


Signature _____

Date _____

Note: This drawing is an artistic interpretation of the general appearance of the design. It is not meant to be an exact rendition.

Designed: 2017-11-15
Printed: 2017-11-29

Springfield Standard	All	Drawing #: 1
----------------------	-----	--------------

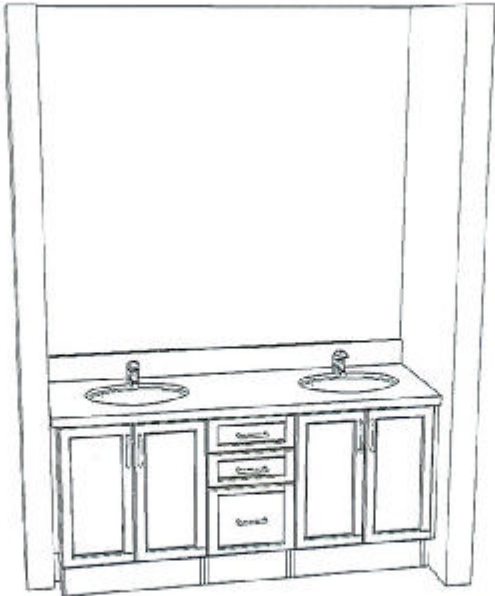

ENSUITE 3D-VIEW
DCR - SPRINGFIELD STANDARD

CUSTOMER APPROVAL

I have reviewed these drawings and understand the details of the design and the Cartier Kitchens specifications

Signature _____

Date _____

Note: This drawing is an artistic interpretation of the general appearance of the design. It is not meant to be an exact rendition.



Designed: 2017-11-15
Printed: 2017-11-29



MAIN BATH 3D-VIEW
DCR - SPRINGFIELD STANDARD

CUSTOMER APPROVAL

I have reviewed these drawings and understand the details of the design and the Cartier Kitchens specifications

Signature _____

Date _____

Note: This drawing is an artistic interpretation of the general appearance of the design. It is not meant to be an exact rendition.



Designed: 2017-11-15
Printed: 2017-11-29

Springfield Standard

All

Drawing #: 1