

DCR PHOENIX HOMES


LOT #158
PATHWAYS
MODEL: MIRAPOSA (Garagre Right)
KITCHEN & VANITIES

CABINETS - CARTIER LINE 1&2
HARDWARE - STD & 1ST UPGRADE
STANDARD WHITE INTERIORS
METAL DRAWER BOX
4 - 5/8" TOEKICK FINISHED BOTH ENDS
3- LOOSE FILLER , 3X96
1PCS - 90 DEG. CORNER MOULD
1PCS - T MOULD
8 PCS - FLAT MOULDINGS


GROUND FLOOR KITCHEN

MOUNTING HEIGHT 96"
42"H UPPERS @ 18" ABOVE COUNTER
CROWN MOULDING - 2"H

Increase Width of
Broom Pantry to 15"

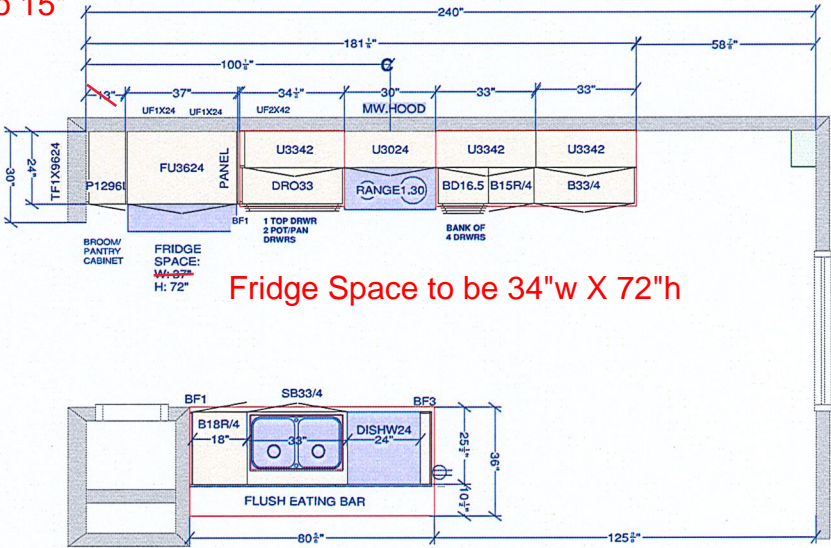


VANITIES

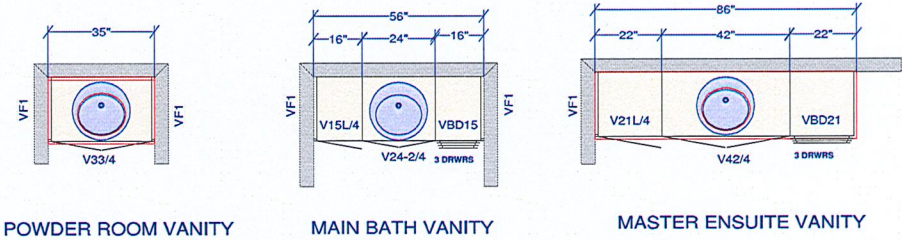

POWDER ROOM VANITY

MAIN BATH VANITY

MASTER ENSUITE VANITY

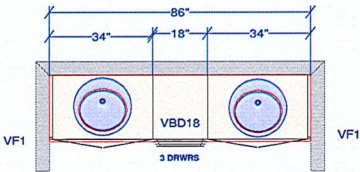

OPTIONAL LUXURY ENSUITE VANITY

CUSTOMER APPROVAL

I have reviewed these drawings and understand the details of the design and the CARTIER KITCHENS specifications.

Signature _____

Date _____

All dimensions ,size designations given are subject to verification on job site and adjustment to fit job conditions.

SPECTRUM KITCHEN and BATH DESIGN



This is an original design and must not be released or copied unless applicable fee has been paid or job order placed.

DRAWN BY: LORI DISAVERIO, B.I.D

Designed: 2021-03-29
Printed: 2021-03-29

DCR #158 Pathways - MIRAPOSA (right)- Kitchen ,vanities.kit

All


Drawing #: 1 No Scale.

DS

DA

DS

AA

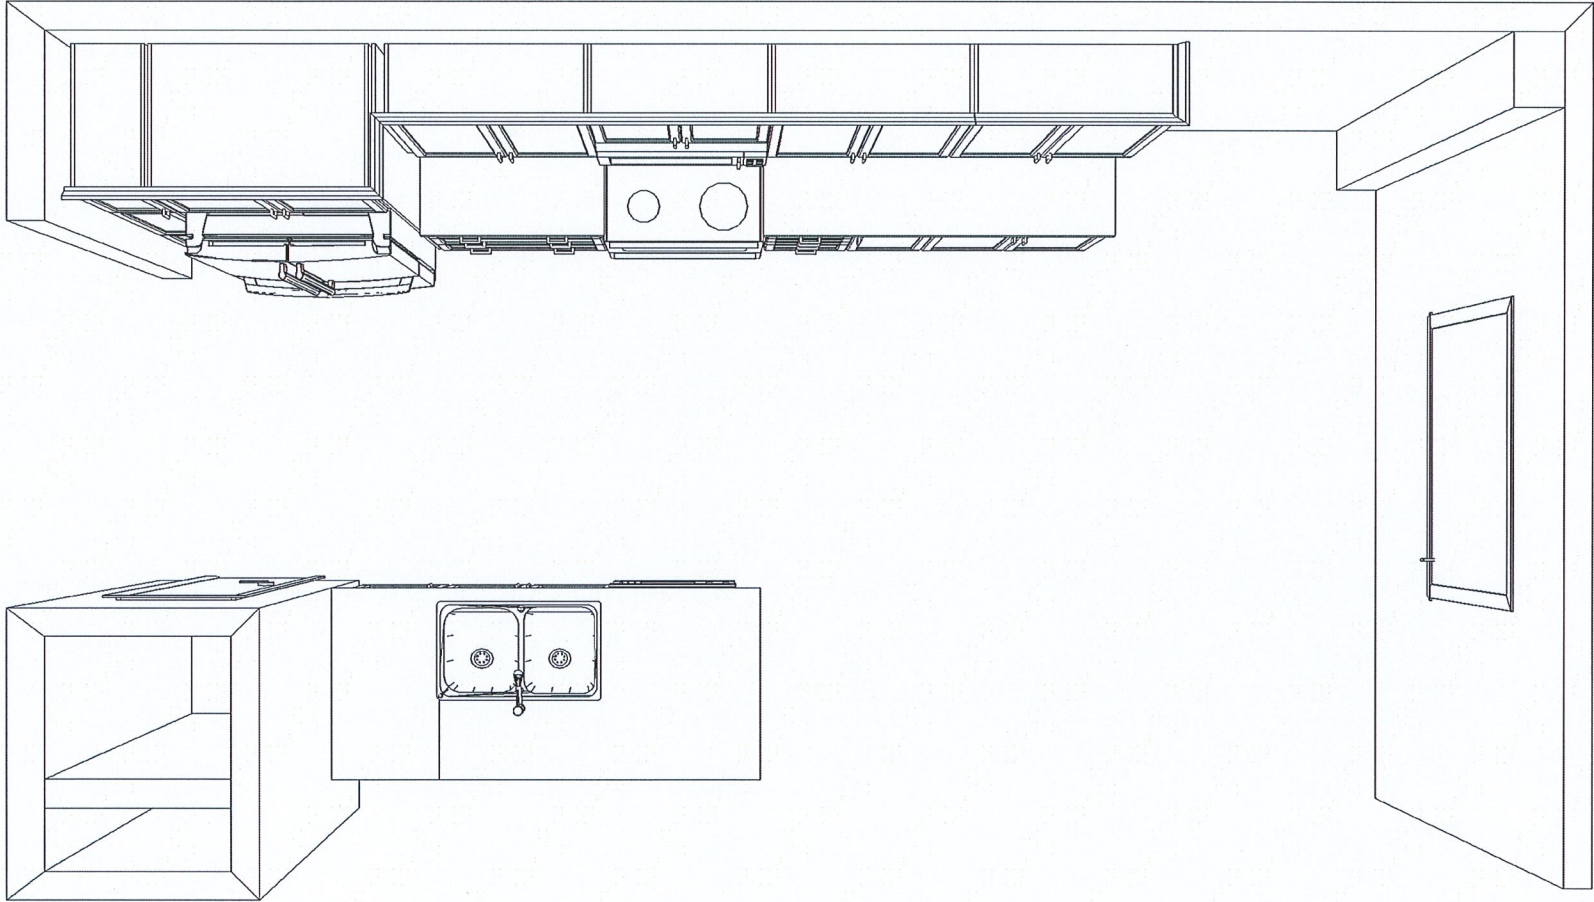

KITCHEN - TOP VIEW

CUSTOMER APPROVAL

I have reviewed these drawings and understand the details of the design and the CARTIER KITCHENS specifications.

Signature _____

Date _____

Note: This drawing is an artistic interpretation of the general appearance of the design. It is not meant to be an exact rendition.

SPECTRUM KITCHEN and BATH DESIGN



Designed: 2021-03-29
Printed: 2021-03-29



KITCHEN -3D VIEW #1

DS
DH

DS
DH

CUSTOMER APPROVAL

I have reviewed these drawings and understand the details of the design and the CARTIER KITCHENS specifications.

Signature_____

Date _____

Note: This drawing is an artistic interpretation of the general appearance of the design. It is not meant to be an exact rendition.


SPECTRUM KITCHEN and BATH DESIGN




Designed: 2021-03-29
Printed: 2021-03-29

DS
DH

DS
AH

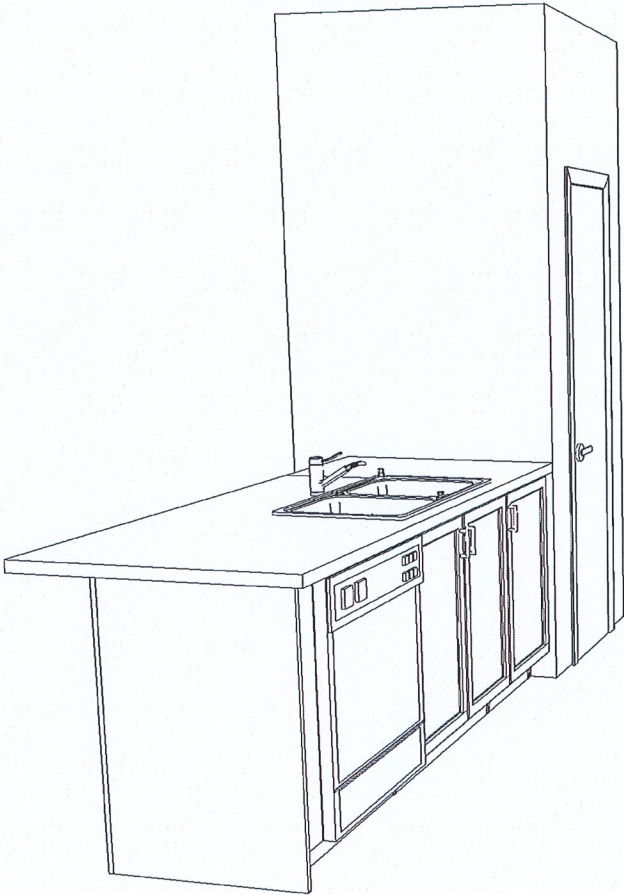

KITCHEN - 3D VIEW #2

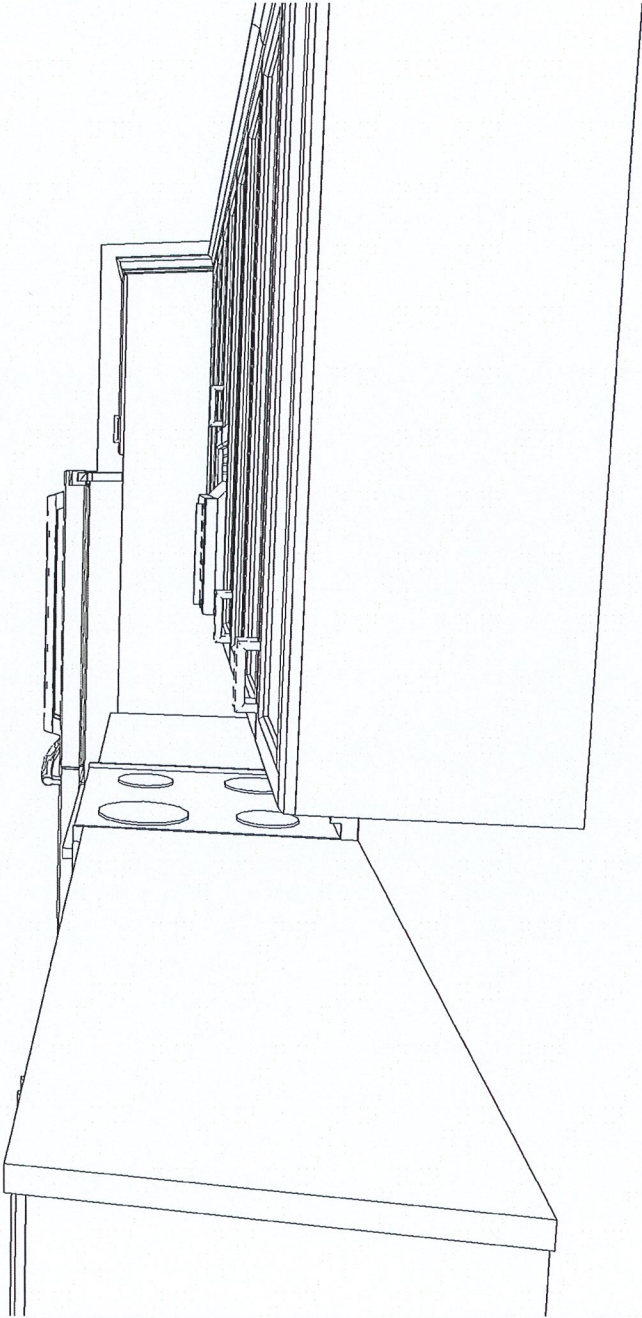

CUSTOMER APPROVAL

I have reviewed these drawings and understand the details of the design and the CARTIER KITCHENS specifications.

Signature _____


Date _____

Note: This drawing is an artistic interpretation of the general appearance of the design. It is not meant to be an exact rendition.

SPECTRUM KITCHEN and BATH DESIGN



Designed: 2021-03-29
Printed: 2021-03-29

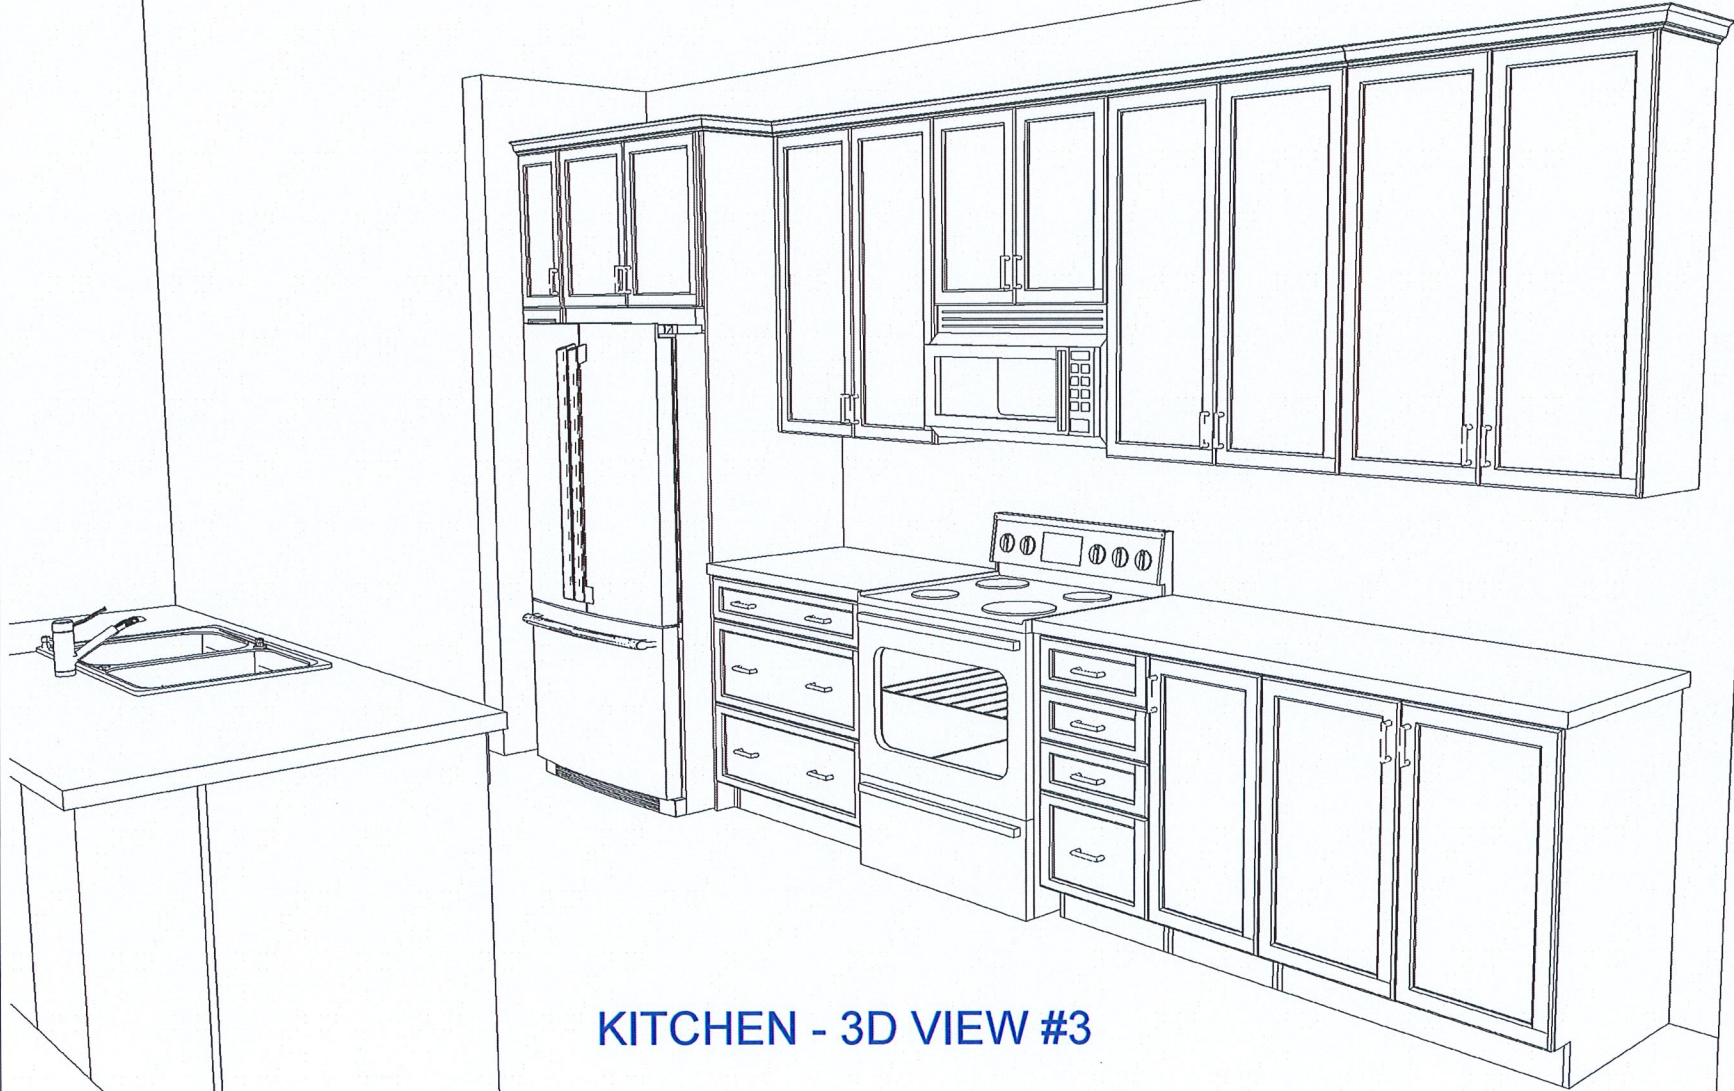

KITCHEN - 3D VIEW #3

CUSTOMER-APPROVAL

I have reviewed these drawings and understand the details of the design and the CARTIER KITCHENS specifications.

Signature _____

Date _____

Note: This drawing is an artistic interpretation of the general appearance of the design. It is not meant to be an exact rendition.

SPECTRUM KITCHEN and BATH DESIGN



Designed: 2021-03-29
Printed: 2021-03-29


DCR #158 Pathways - MIRAPOSA (right)- Kitchen _

All

Drawing #: 1

DS
DH

DS
AH

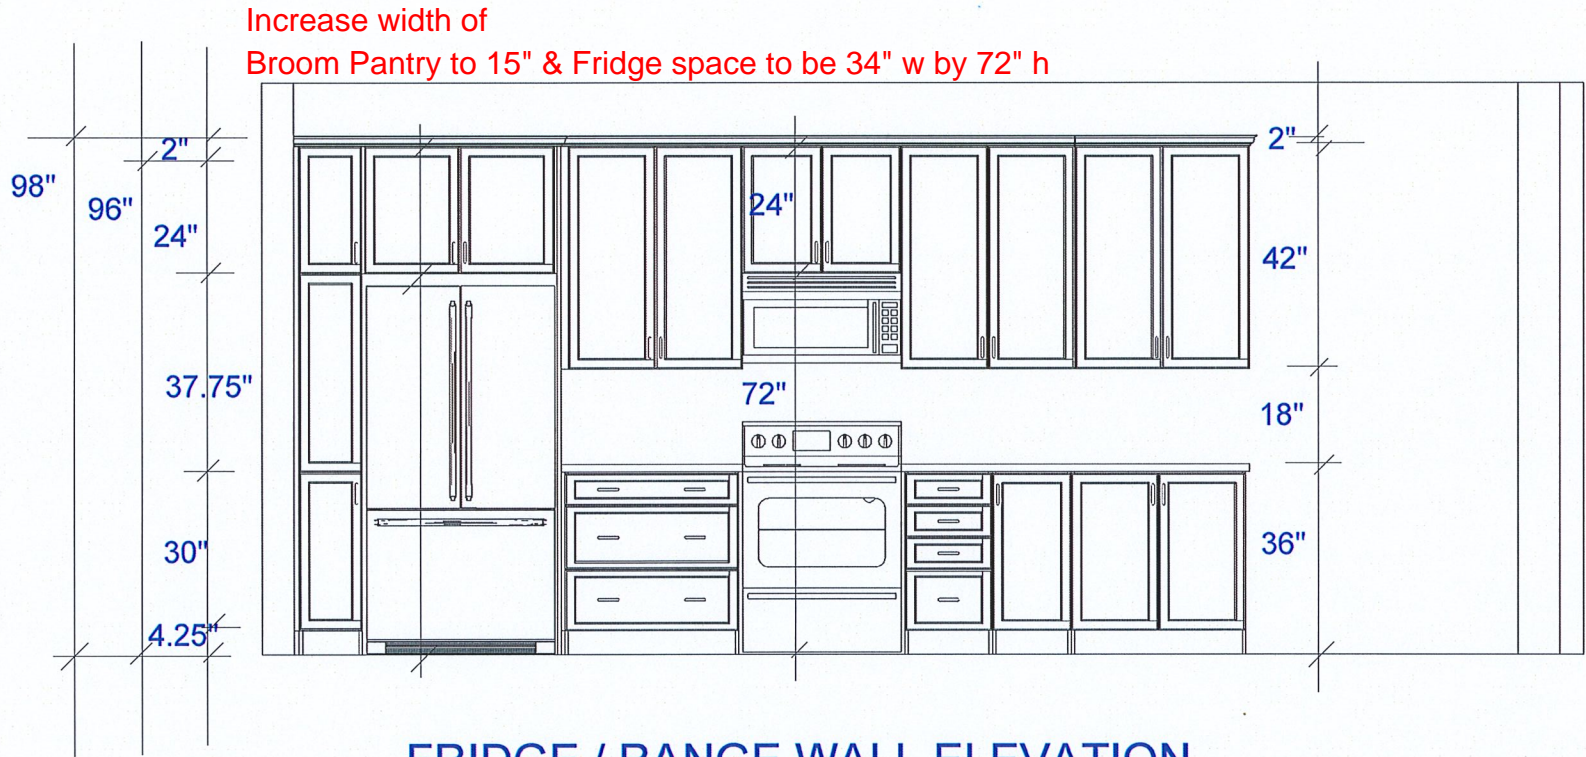

FRIDGE / RANGE WALL ELEVATION

CUSTOMER APPROVAL

I have reviewed these drawings and understand the details of the design and the CARTIER KITCHENS specifications.

Signature _____

Date _____

Note: This drawing is an artistic interpretation of the general appearance of the design. It is not meant to be an exact rendition.

SPECTRUM KITCHEN and BATH DESIGN




Designed: 2021-03-29
Printed: 2021-03-29

DCR #158 Pathways - MIRAPOSA (right)- Kitchen _ All

Drawing #: 1

DS
DH

DS
AH

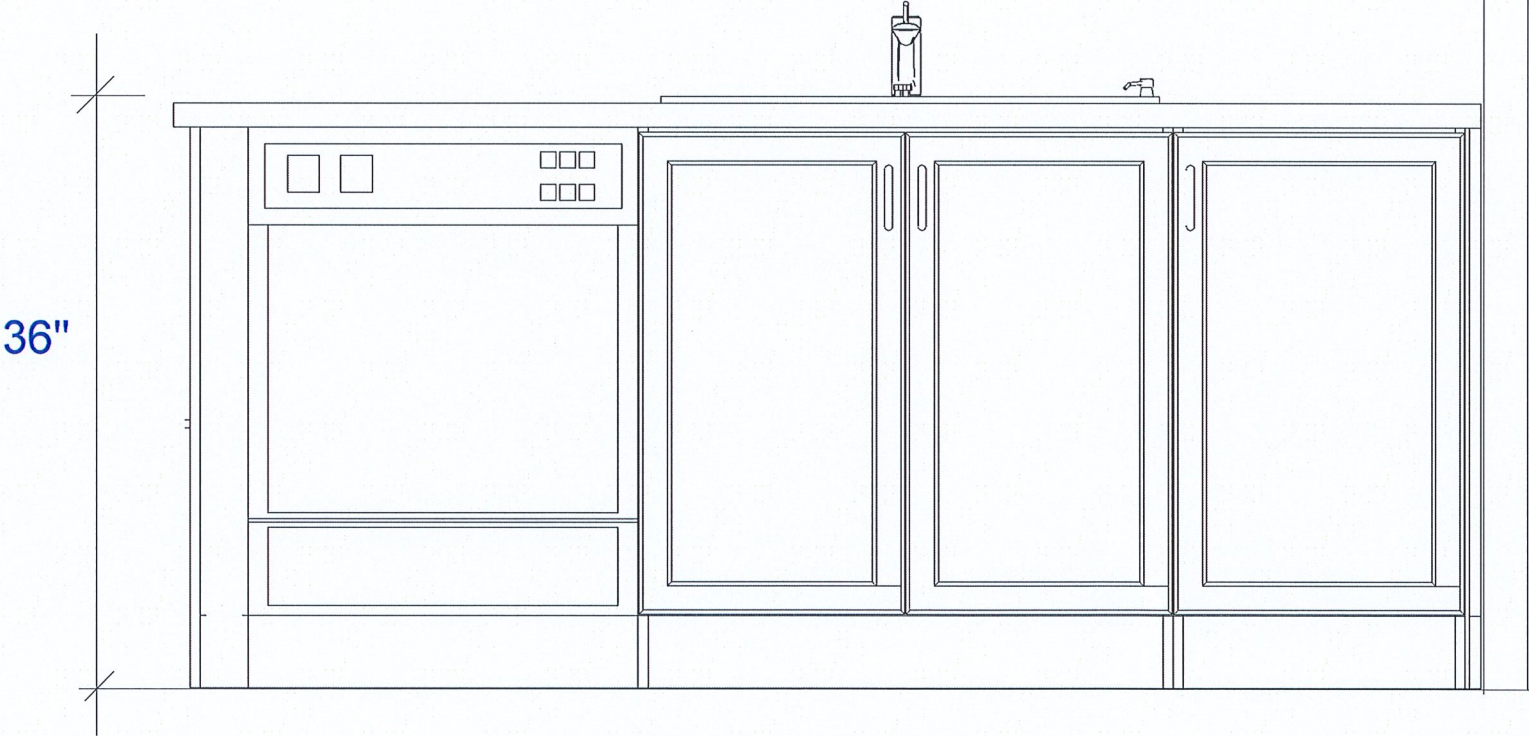

PENINSULA ELEVATION

CUSTOMER APPROVAL

I have reviewed these drawings and understand the details of the design and the CARTIER KITCHENS specifications.

Signature _____

Date _____

Note: This drawing is an artistic interpretation of the general appearance of the design. It is not meant to be an exact rendition.

SPECTRUM KITCHEN and BATH DESIGN



Designed: 2021-03-29
Printed: 2021-03-29

DCR #158 Pathways - MIRAPOSA (right)- Kitchen _

All

Drawing #: 1

DS
DH

DS
AH