





MAXI VENT #301, TWO REQ'D AT UPPER ROOF

NOTE: LOCATIONS SHOWN ARE APPROXIMATION ONLY AND
WILL BE LOCATED ON SITE BY QUALIFIED INSTALLER.

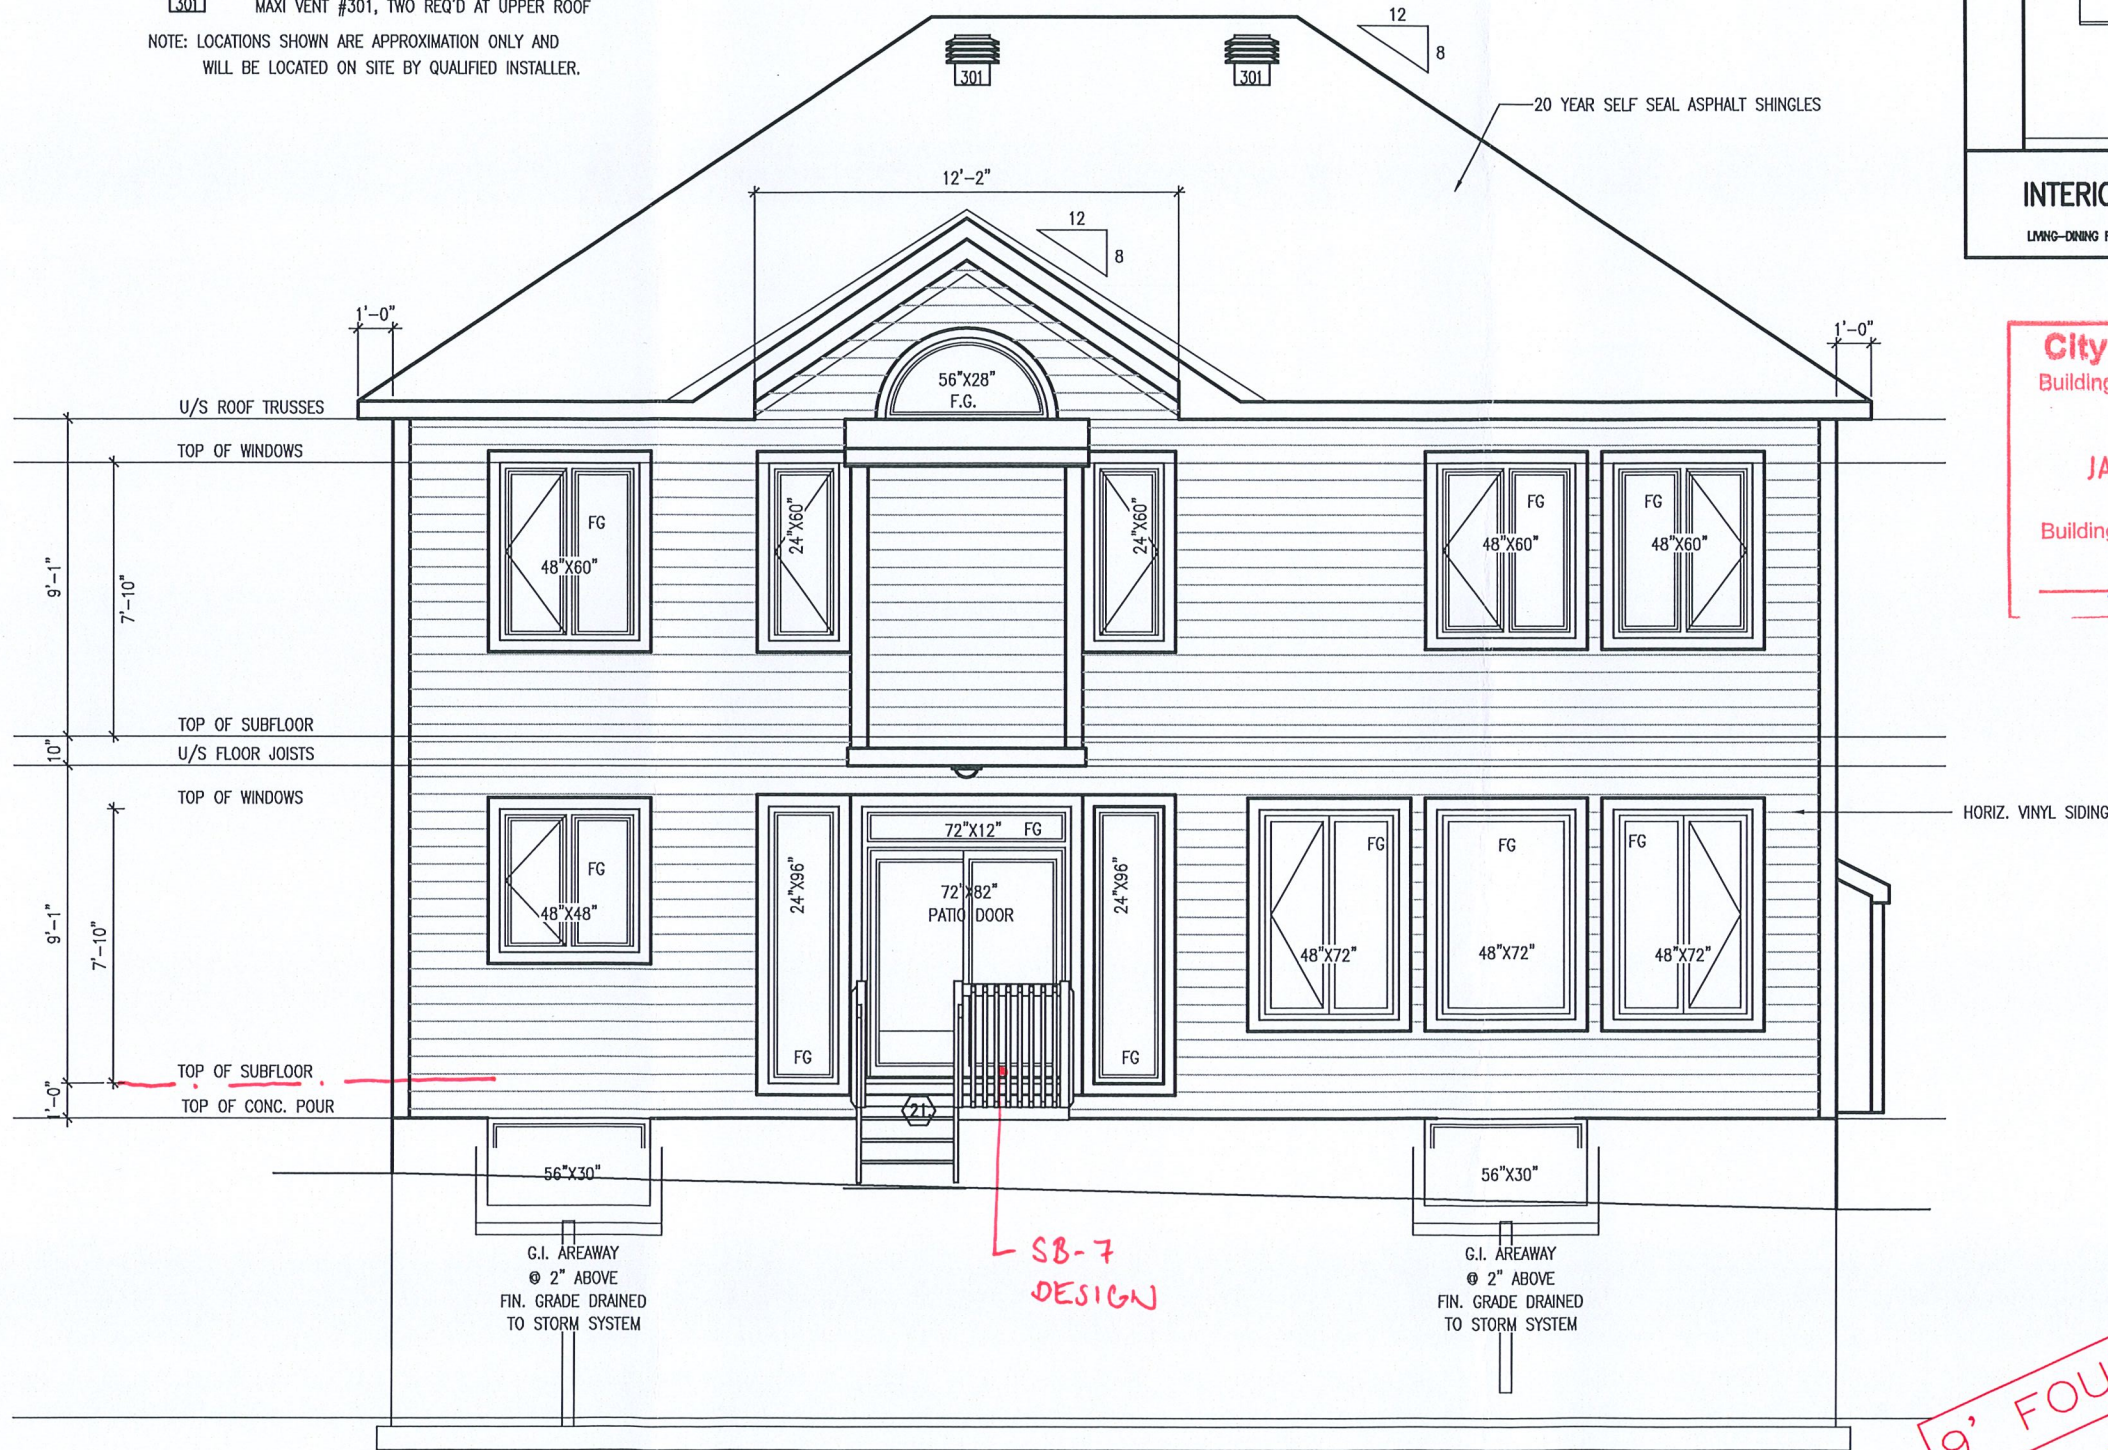

REAR ELEVATION ELEV. E&F
(ALT. 4 BED & OPT. 5 BED)

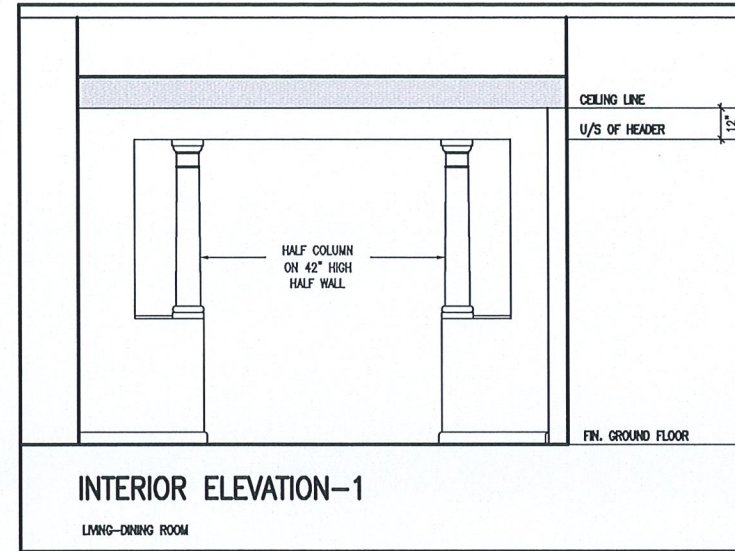

City of Ottawa
Building Services Branch

JAN 05 2022
Building Code Reviewed

Signature

SITE
COPY
City of Ottawa

9' FOUNDATION POUR
9' SECOND FLOOR

FOOTPRINT:	508
DRAWN BY:	S.D.
DATE:	AUG 2012
SCALE:	3/16"=1'-0"
SHEET NO:	38
D.C.L.:	100

No.	Description	By	dd/mm/yy
4	FOR ENGINEERING REVIEW	GK	12/11/21
3	FOR LAYOUTS	GK	20/10/21
2	BEP BLACKLINES REV.	GK	05/10/21
1	BEP BLACKLINES	GK	30/09/21

CHEESAPEAKE-2012-EF-4/5

SITE: DIAMONDVIEW


LOT NUMBER: 2-49

CIVIC ADDRESS: 1906 CESSNA PRIVATE

PHOENIX HOMES



ROOF PLAN-F

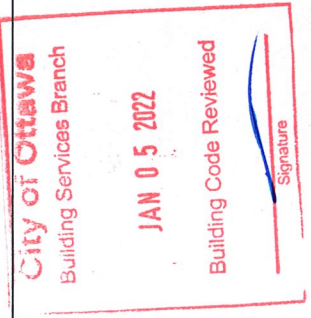




**SITE
COPY**
City of Ottawa

City of Ottawa
Building Services Branch

JAN 05 2022

Building Code Reviewed

Signature

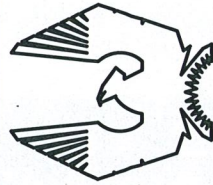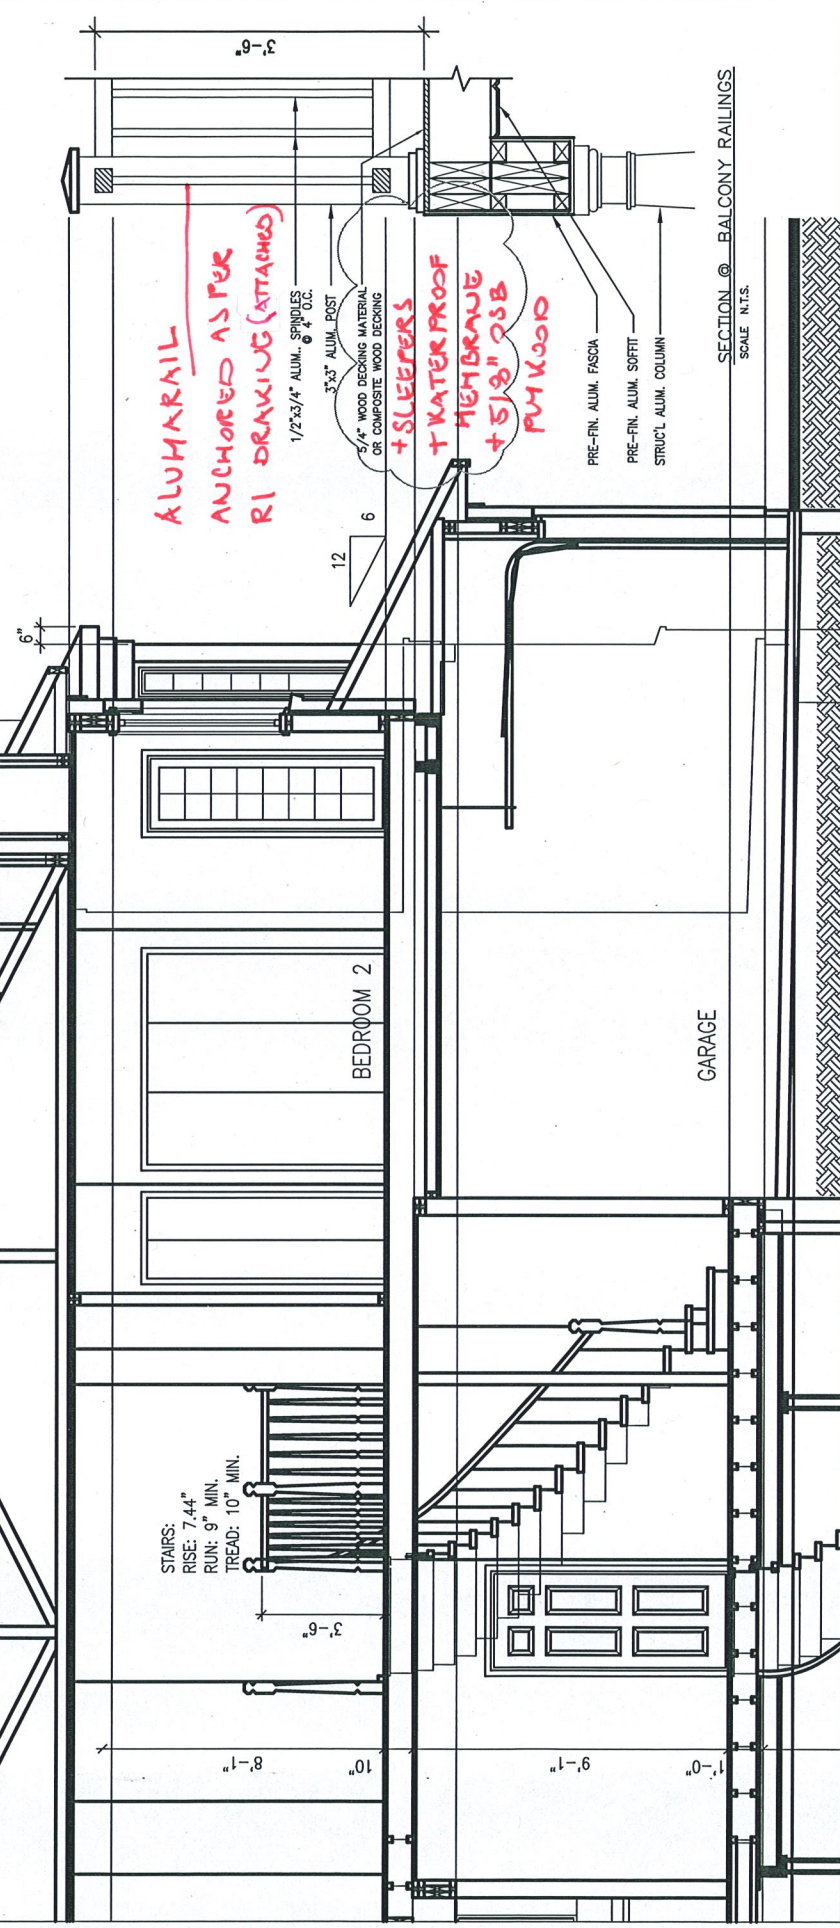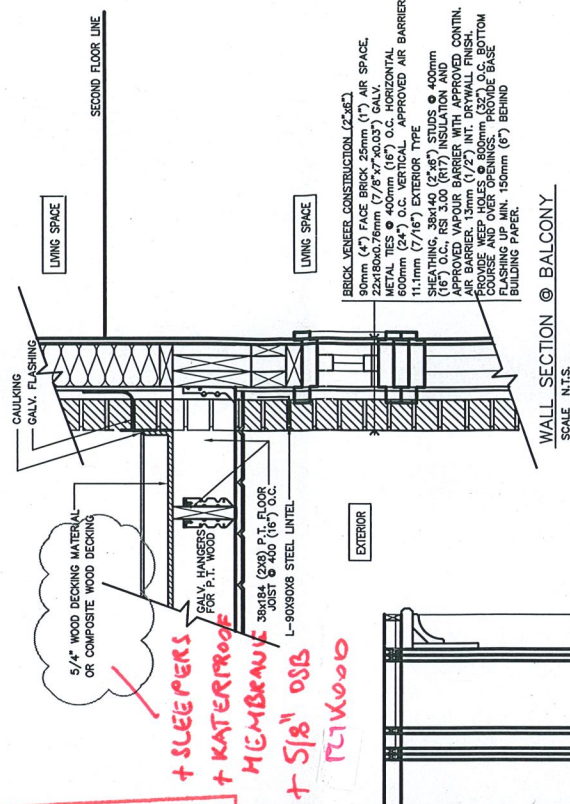

PHOENIX HOMES

CHESPEAKE-2019-A/B

SITE: DIAMONDVIEW

LOT NUMBER:

CIVIC ADDRESS:
1906 CESSNA PRIVATE

୨୪୨

No.	Description
-----	-------------

No.	Description
-----	-------------

REVISIONS

file number: 508

drawn by: A. FRANCOEUR

date:	OCT. 2003
-------	-----------

scale: $3/16"=1'$

DCL-201

sheet no: