

POWDER ROOM

↑ LAUNDRY ROOM
Side by side
w/d. Laminate
countertop would
work. No sink.
S/A (2) upper cabinets
as per plan.

MAIN BATH

ENSUITE

CUSTOMER APPROVAL

I have reviewed these drawings and understand the details of the design and the CARTIER KITCHENS specifications.

Signature _____

Date _____

DS DS
[Handwritten initials]

Note: This drawing is an artistic interpretation of the general appearance of the design. It is not meant to be an exact rendition.

SPECTRUM KITCHEN and BATH DESIGN


DCR #303 PWYS - Melbourne .kit



Designed: 2021-10-11
Printed: 2021-10-11

All

Drawing #: 1

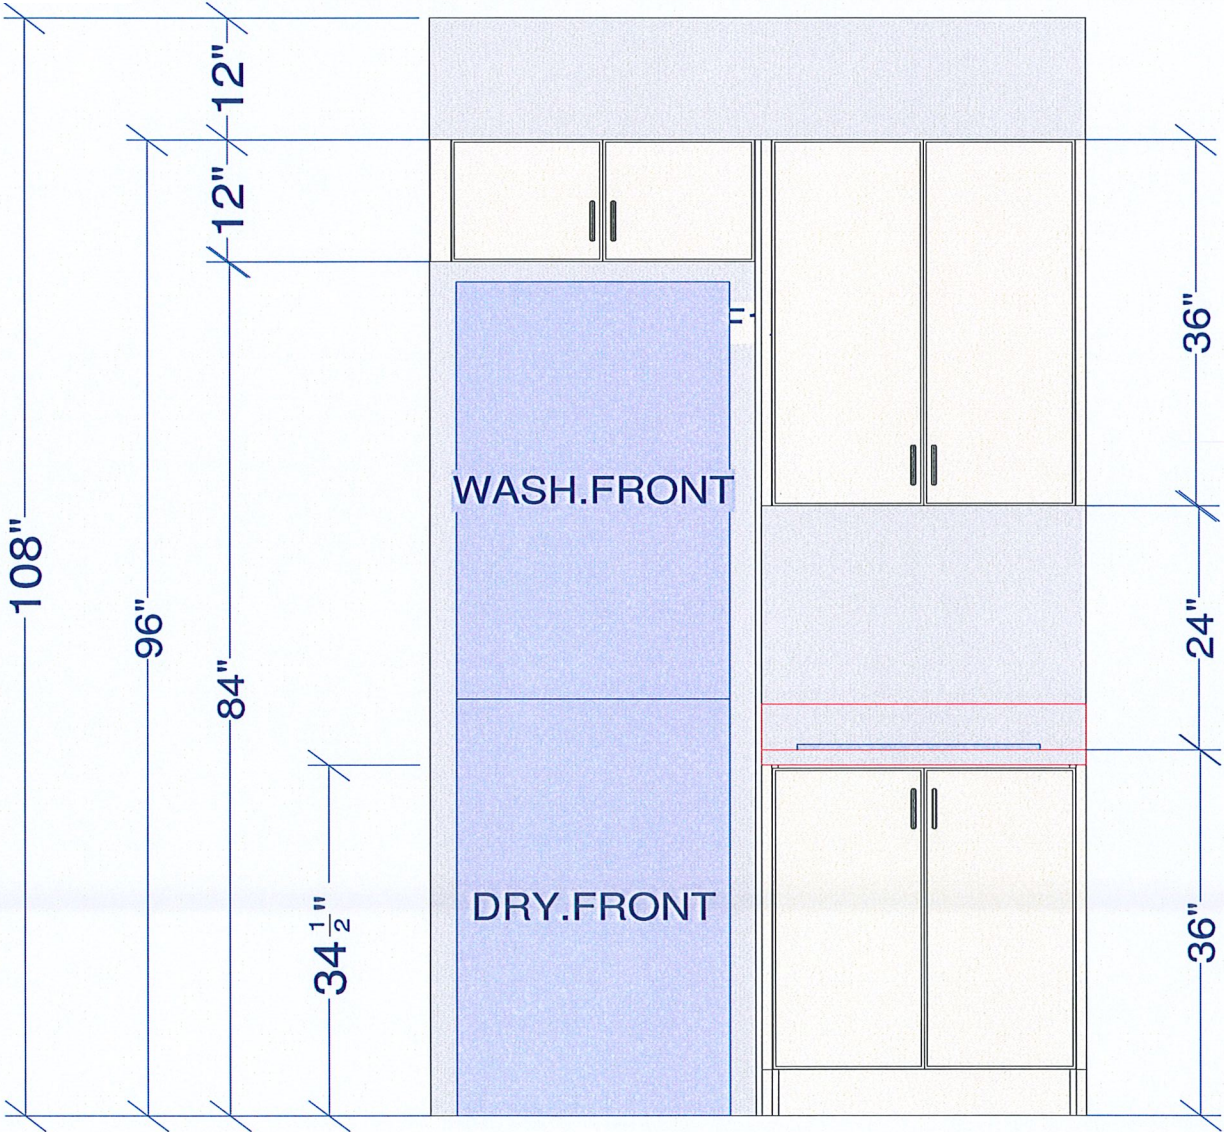

DS DS
KMS

CUSTOMER APPROVAL

I have reviewed these drawings and understand the details of the design and the CARTIER KITCHENS specifications.

Signature _____

Date _____

LAUNDRY ROOM - ELEVATION

All dimensions .size designations given are subject to verification on job site and adjustment to fit job conditions.

SPECTRUM KITCHEN and BATH DESIGN

DCR #303 PWYS - Melbourne .kit




This is an original design and must not be released or copied unless applicable fee has been paid or job order placed.

DRAWN BY: LORI DISAVERIO, B.I.D

Designed: 2021-10-11
Printed: 2021-10-11

Drawing #: 1 No Scale.

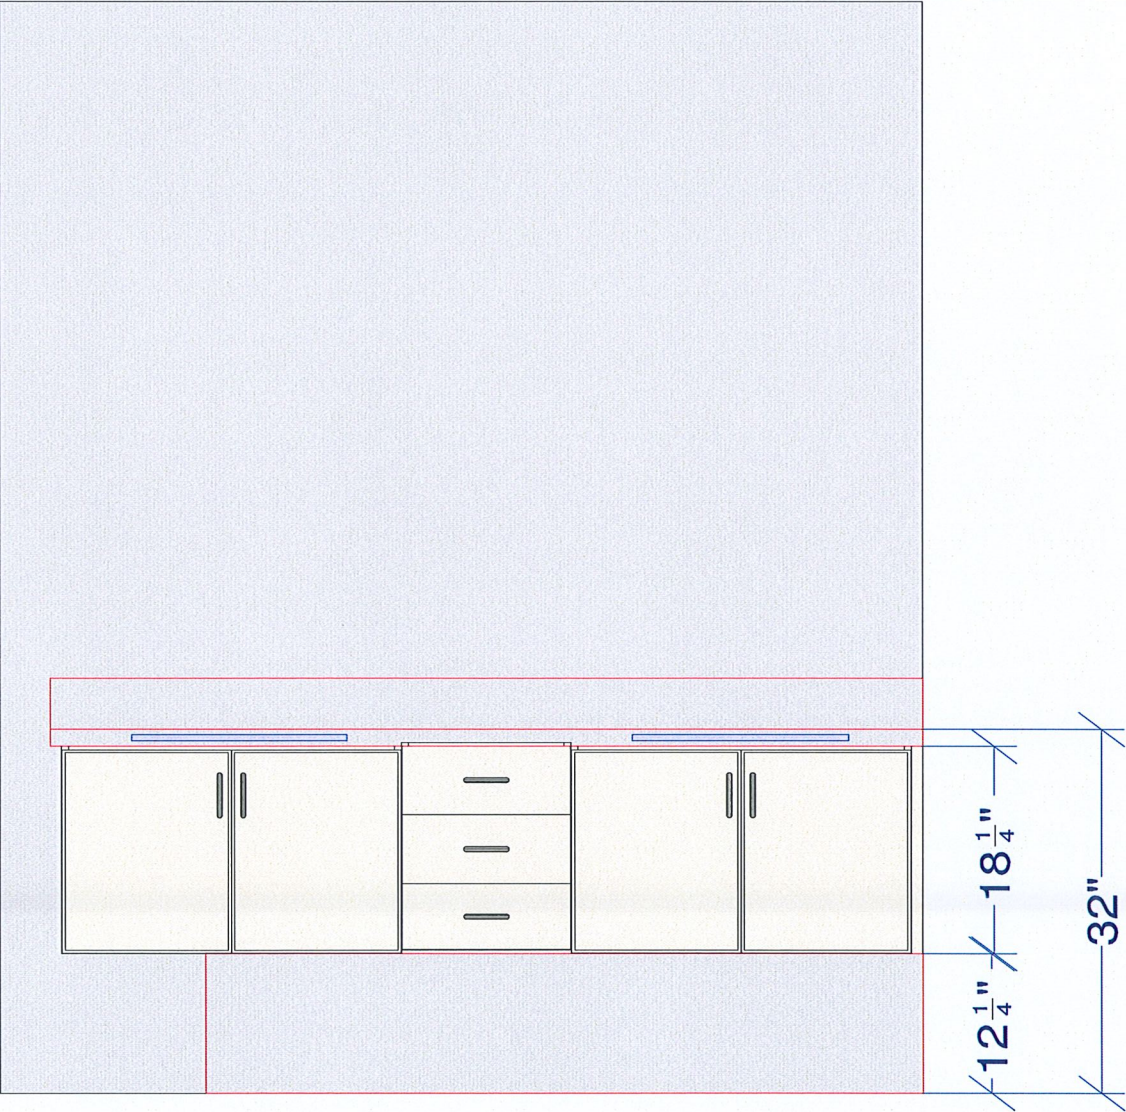

DS
DS
MS

ENSUITE VANITY - ELEVATION

CUSTOMER APPROVAL
I have reviewed these drawings and understand the details of the design and the CARTIER KITCHENS specifications.

Signature _____

Date _____

All dimensions .size designations given are subject to verification on job site and adjustment to fit job conditions.

SPECTRUM KITCHEN and BATH DESIGN
DCR #303 PWYS - Melbourne .kit



This is an original design and must not be released or copied unless applicable fee has been paid or job order placed.

DRAWN BY: LORI DISAVERIO, B.I.D

Designed: 2021-10-11
Printed: 2021-10-11