

LOT #311

PATHWAYS - PHASE 2

KLONDIKE


BASEMENT APARTMENT - 2 BDRM

MOUNTING HEIGHT -96
39" UPPERS @ 21" ABOVE COUNTER
~~LIGHT VALANCE~~

[illegible]

Drawing #: 1	No Scale.
--------------	-----------

Designed: 2021-11-17
Printed: 2021-11-18

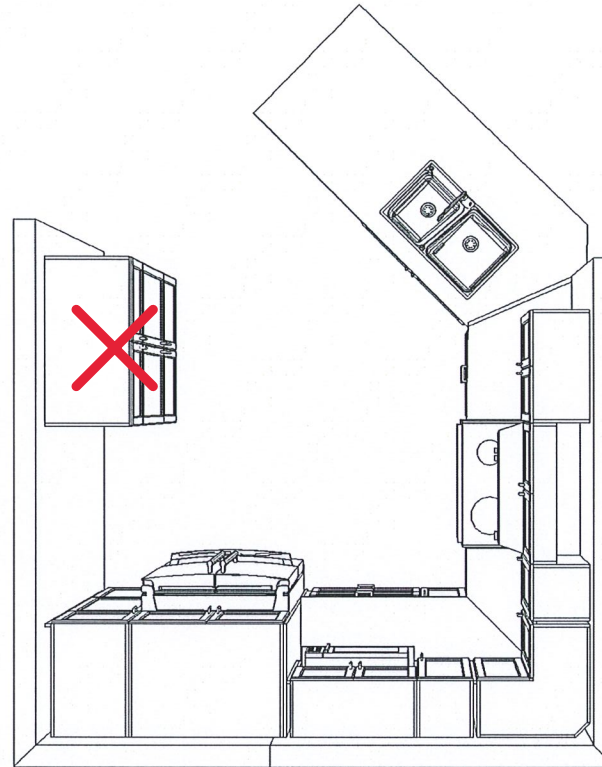

BASEMENT KITCHEN - TOP VIEW

CUSTOMER APPROVAL

I have reviewed these drawings and understand the details of the design and the CARTIER KITCHENS specifications.


Signature _____

Date _____

Note: This drawing is an artistic interpretation of the general appearance of the design. It is not meant to be an exact rendition.



Designed: 2021-11-17
Printed: 2021-11-18

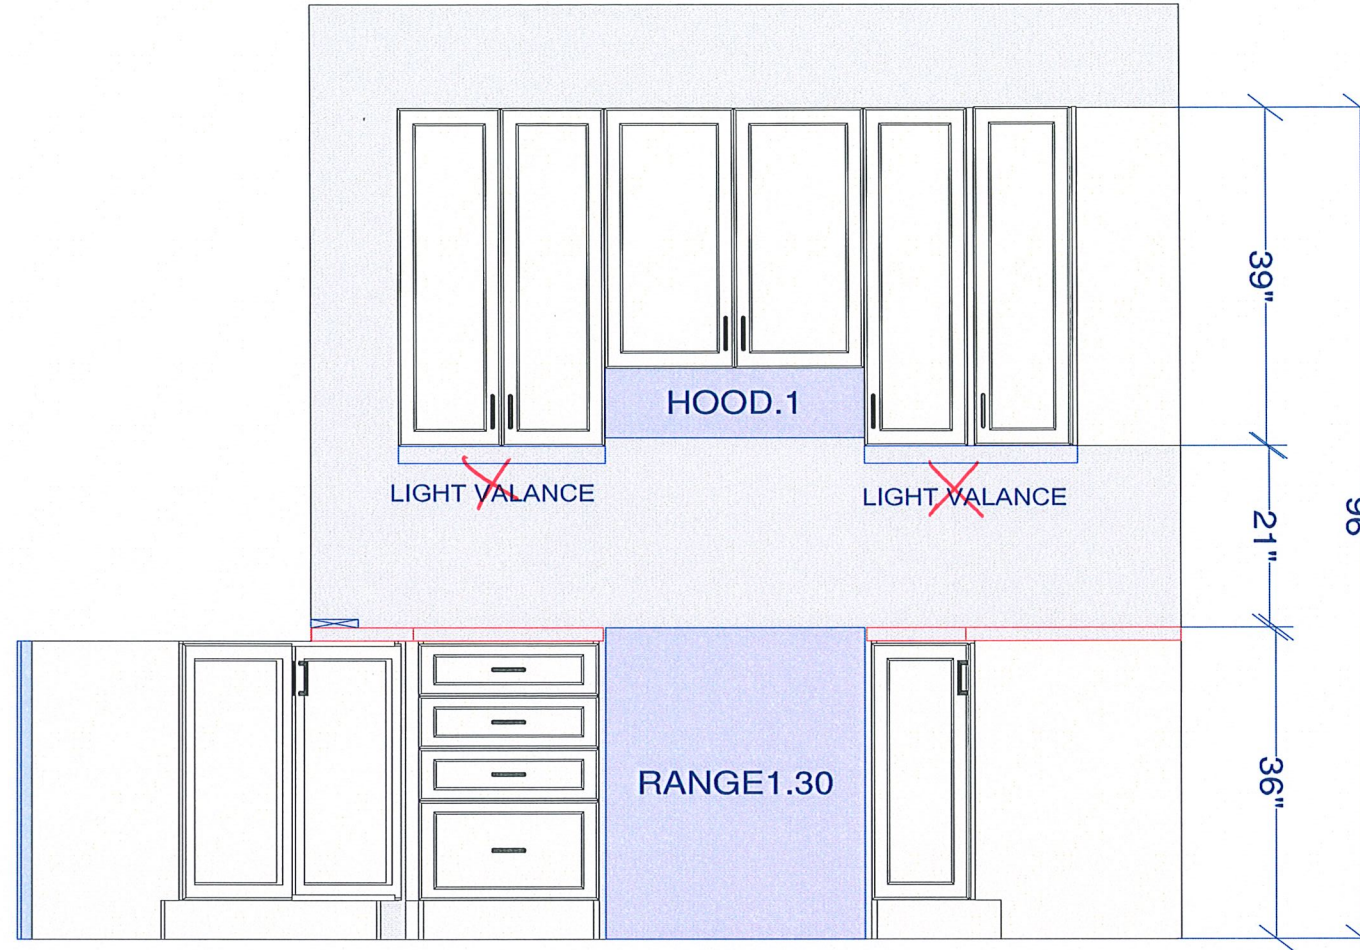

CUSTOMER APPROVAL

I have reviewed these drawings and understand the details of the design and the CARTIER KITCHENS specifications.

Signature _____

Date _____

RANGE WALL ELEVATION

All dimensions .size designations given are subject to verification on job site and adjustment to fit job conditions.




This is an original design and must not be released or copied unless applicable fee has been paid or job order placed.

Designed: 2021-11-17
Printed: 2021-11-18

DCR - #311 PWYS 2 - KLONDIKE - Bsmt Apt - 2 Bed.kit

El 3

Drawing #: 1 No Scale.

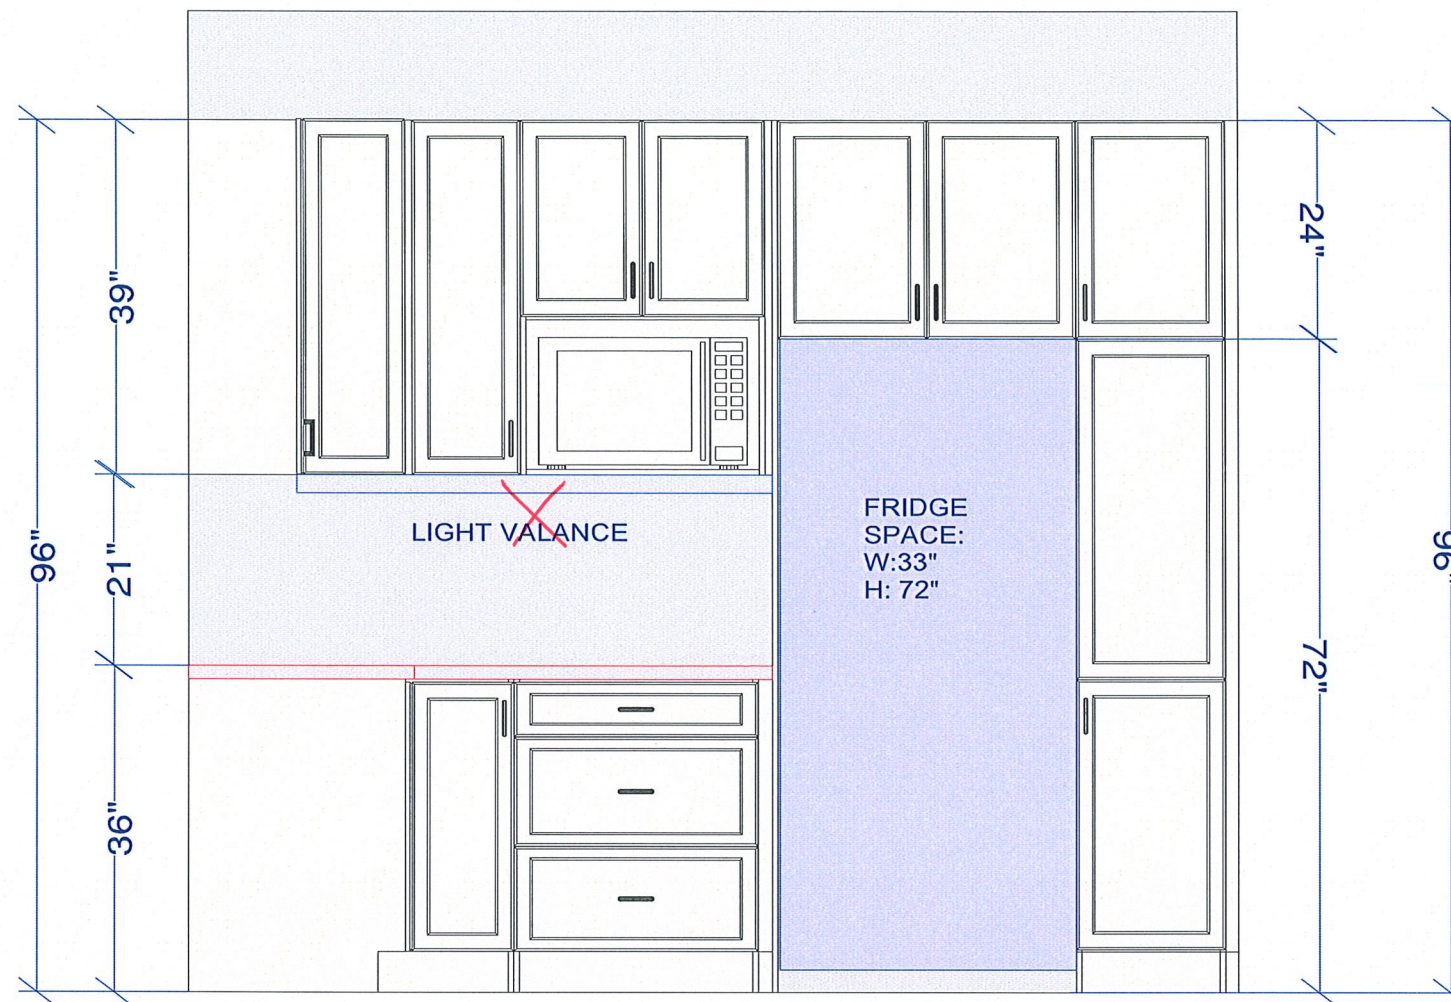

CUSTOMER APPROVAL

I have reviewed these drawings and understand the details of the design and the CARTIER KITCHENS specifications.

Signature _____

Date _____

FRIDGE WALL ELEVATION

All dimensions ,size designations given are subject to verification on job site and adjustment to fit job conditions.



This is an original design and must not be released or copied unless applicable fee has been paid or job order placed.

Designed: 2021-11-17
Printed: 2021-11-18

DCR - #311 PWYS 2 - KLONDIKE - Bsmt Apt - 2 Bed.kit

EI 2

Drawing #: 1 No Scale.



BASEMENT KITCHEN - 3D VIEW #1

CUSTOMER APPROVAL

I have reviewed these drawings and understand the details of the design and the CARTIER KITCHENS specifications.


Signature _____

Date _____

Note: This drawing is an artistic interpretation of the general appearance of the design. It is not meant to be an exact rendition.



Designed: 2021-11-17
Printed: 2021-11-18

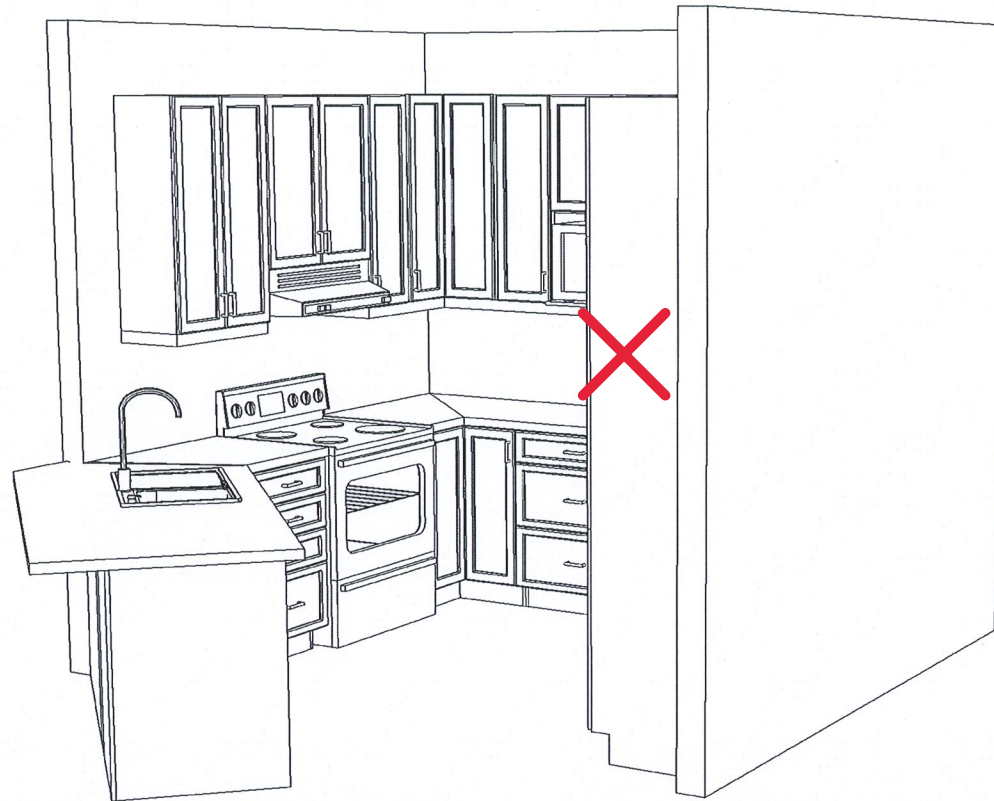

BASEMENT KITCHEN - 3D VIEW #2

CUSTOMER APPROVAL

I have reviewed these drawings and understand the details of the design and the CARTIER KITCHENS specifications.


Signature_____

Date_____

Note: This drawing is an artistic interpretation of the general appearance of the design. It is not meant to be an exact rendition.



Designed: 2021-11-17
Printed: 2021-11-18

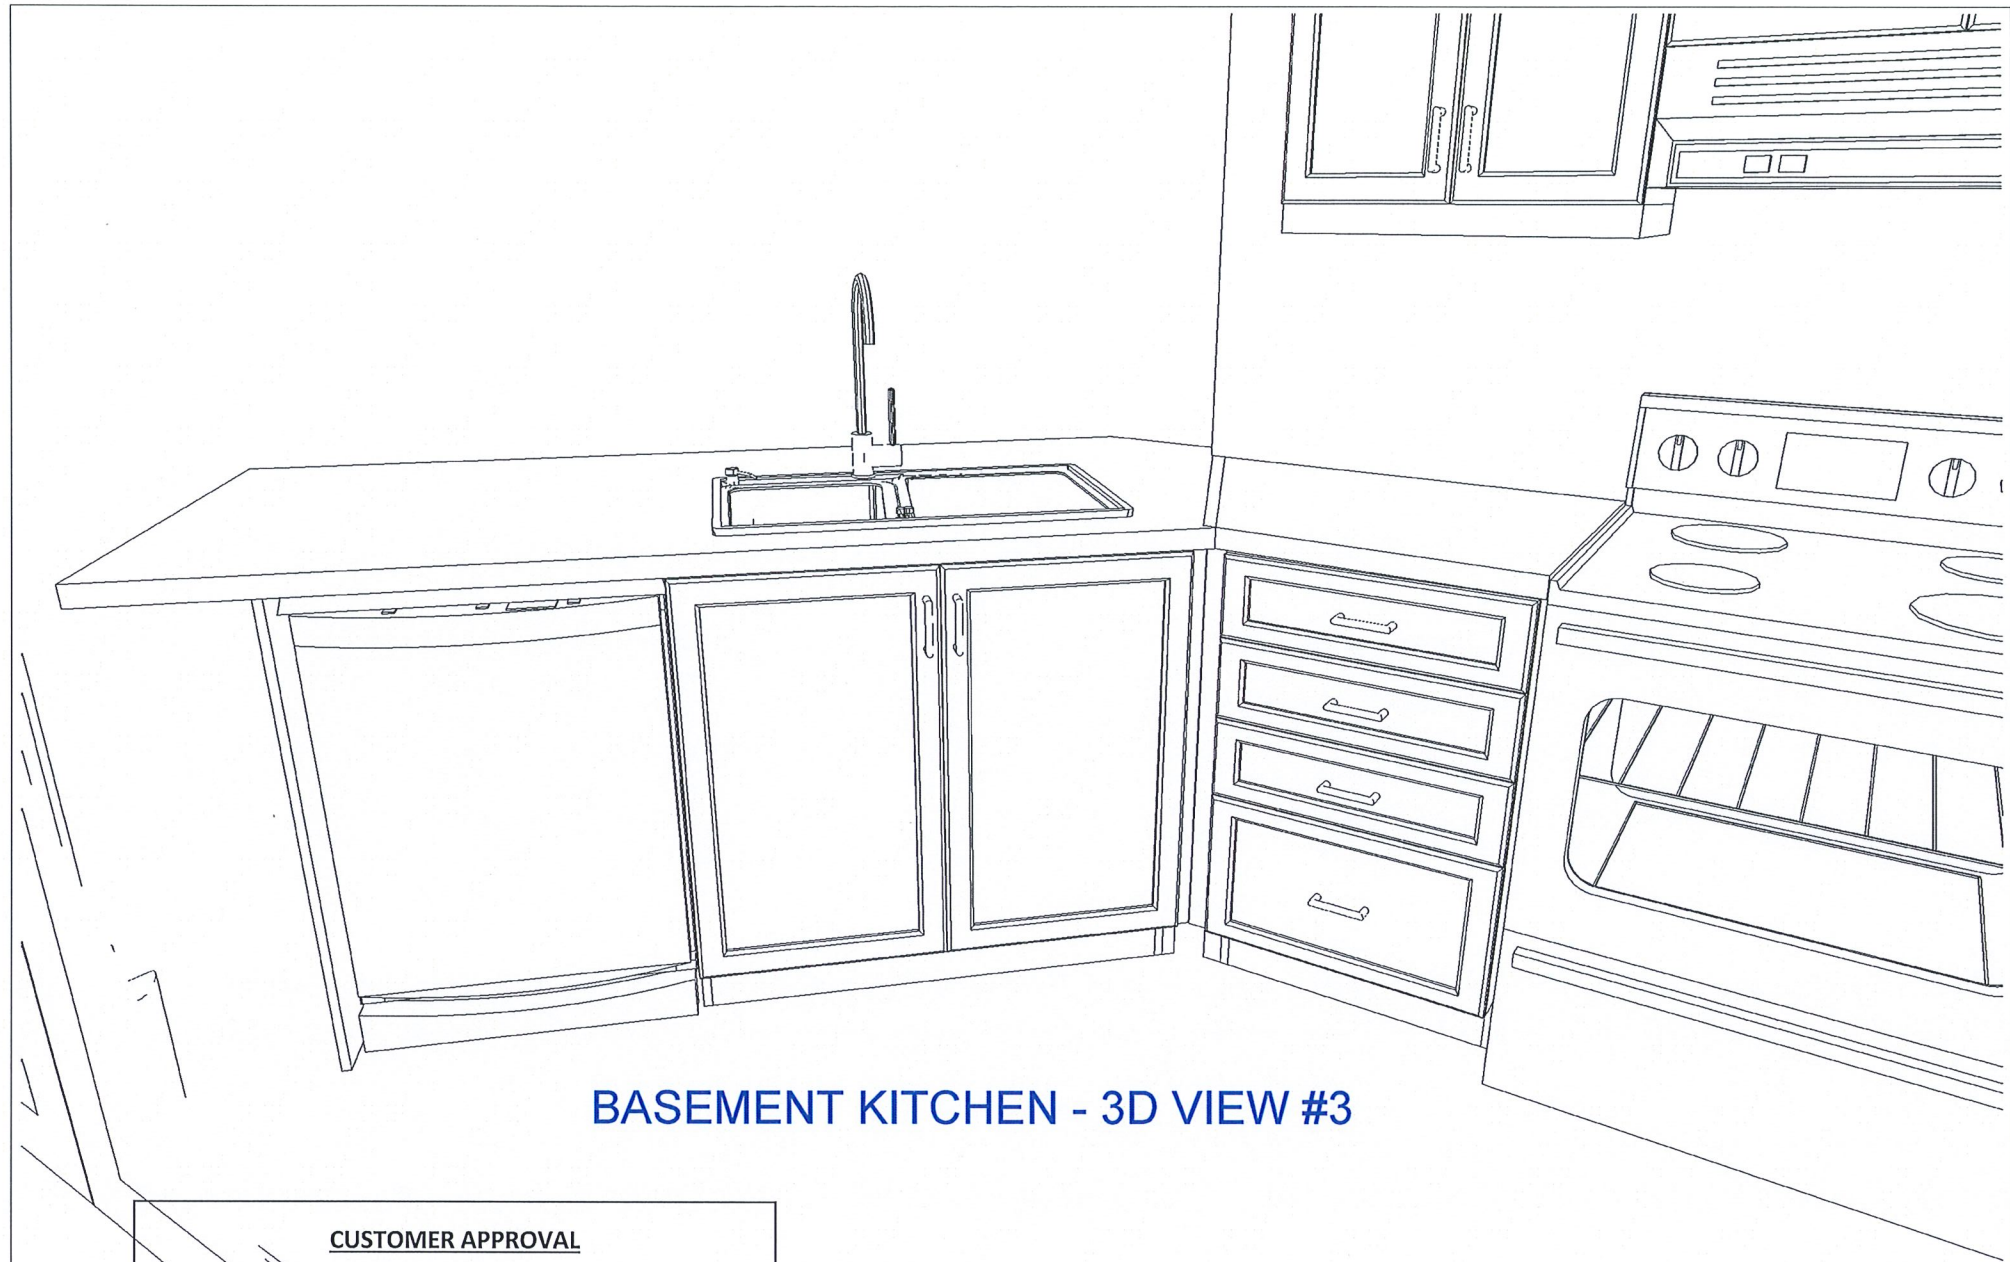

BASEMENT KITCHEN - 3D VIEW #3

CUSTOMER APPROVAL

I have reviewed these drawings and understand the details of the design and the CARTIER KITCHENS specifications.


Signature _____

Date _____

Note: This drawing is an artistic interpretation of the general appearance of the design. It is not meant to be an exact rendition.



Designed: 2021-11-17
Printed: 2021-11-18

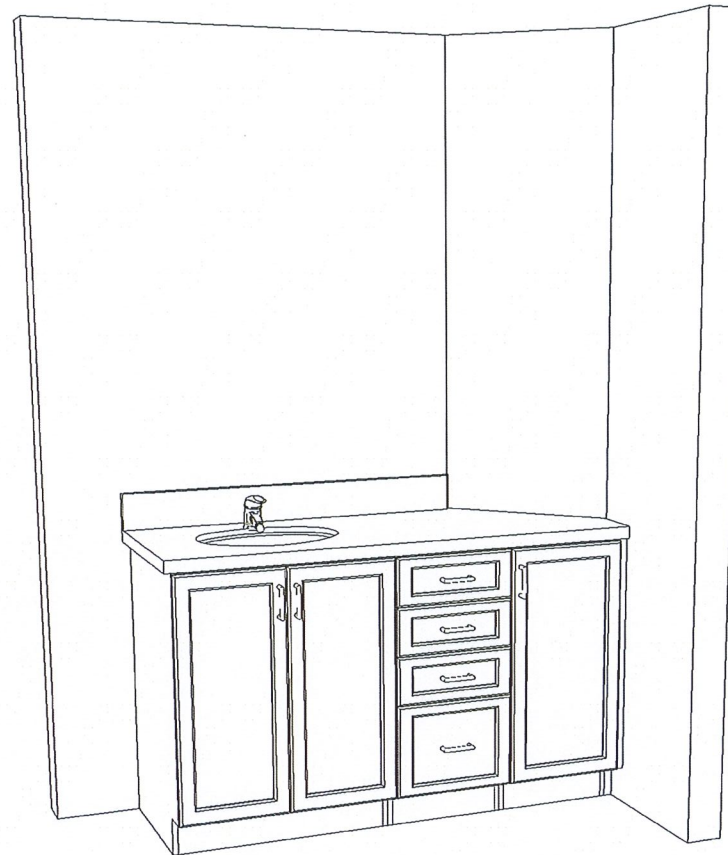

BASEMENT VANITY - 3D VIEW

~~NOTE: HEIGHT INCREASED TO 36"H~~

CUSTOMER APPROVAL

I have reviewed these drawings and understand the details of the design and the CARTIER KITCHENS specifications.

Signature _____

Date _____

Note: This drawing is an artistic interpretation of the general appearance of the design. It is not meant to be an exact rendition.



Designed: 2021-11-17
Printed: 2021-11-18

DCR - #311 PWYS 2 - KLONDIKE - Bsmt Apt - 2

All

Drawing #: 1