


DCR PHOENIX HOMES

LOT # 3-151
WHITETAIL RIDGE - PHASE 3
KITCHEN
WITH WALK-IN PANTRY
MODEL - PLATINA (512)

- CABINETS - :
HARDWARE -
STD WHITE INTERIORS
STD METAL BOXES
4 - PCS - TOE KICK
5 PCS - FLAT SHOE MOULDING
2 - PCS. 90 DEG. CORNER MOULD.
1 PC - T MOULD
- MOUNTING HEIGHT - 96"
42" UPPERS AT 18" ABOVE COUNTER
LIGHT VALANCE
CROWN MLDG

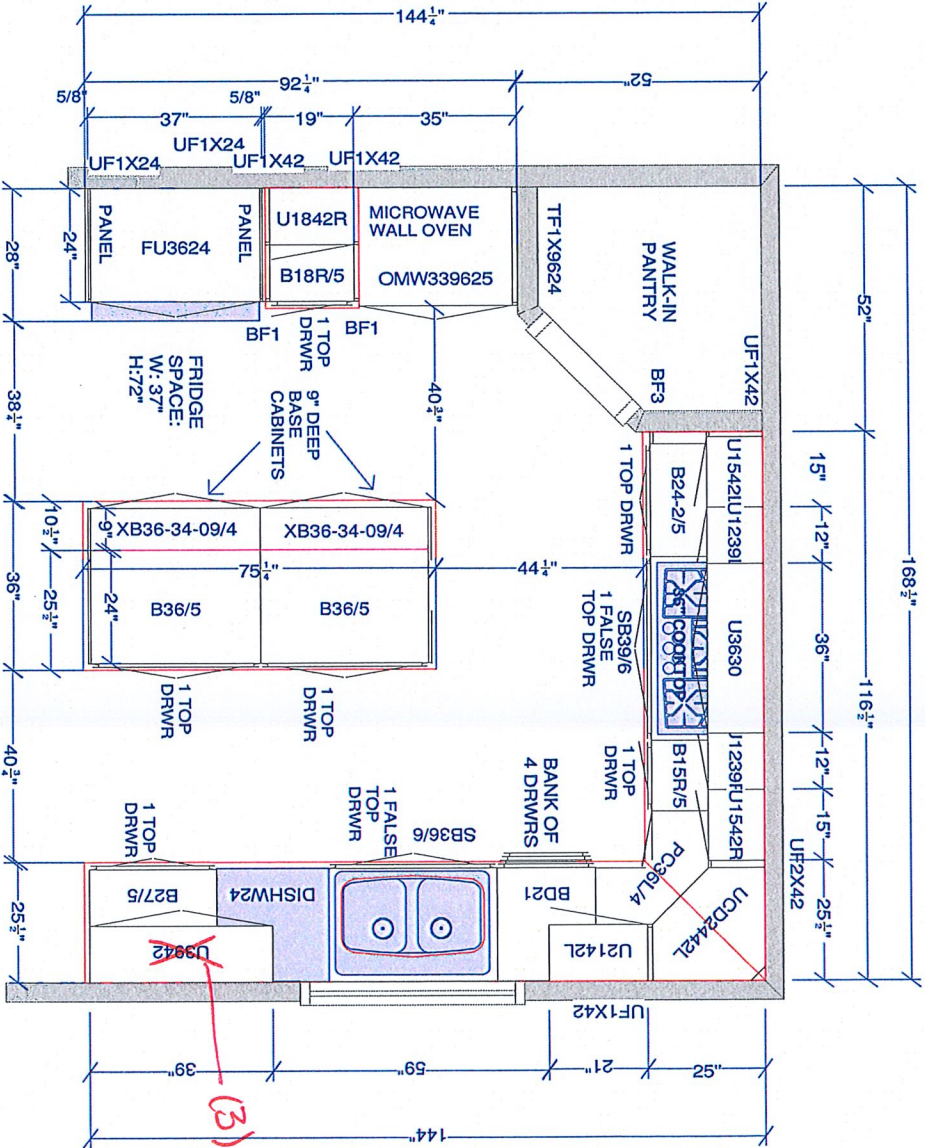

NOTE:
COUNTER DEPTH FRIDGE
RECOMMENDED

CUSTOMER APPROVAL

I have reviewed these drawings and understand the details of the design and the CARTER KITCHENS specifications.

Signature _____

Date _____

All dimensions, size designations given are subject to verification on job site and adjustment to fit job conditions.




This is an original design and must not be released or copied unless applicable fee has been paid or job order placed.

DCR - Platina - Walk-in Pantry LOT# 3-151.kit

ALL

Drawing #: 1 No Scale.

Designed: 2021-11-25
Printed: 2021-12-14

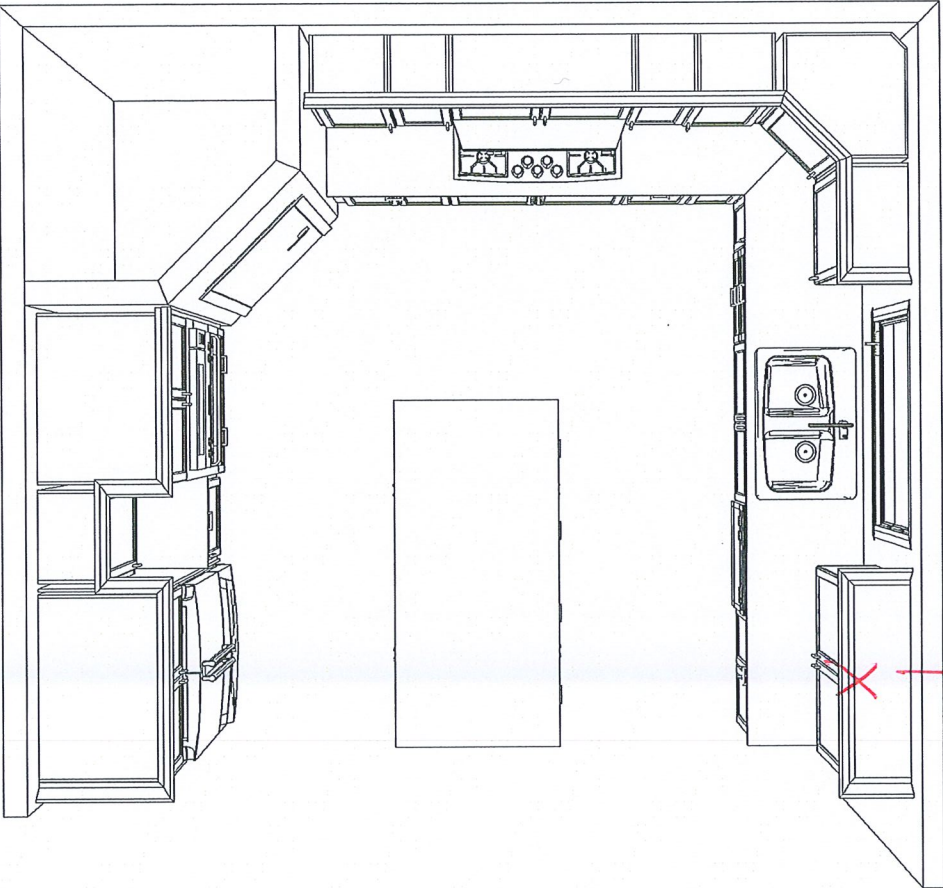

3 FLOATING
SHELVES

KITCHEN - TOP VIEW

CUSTOMER APPROVAL

I have reviewed these drawings and understand the details of the design and the CARTIER KITCHENS specifications.


Signature _____

Date _____

Note: This drawing is an artistic interpretation of the general appearance of the design. It is not meant to be an exact rendition.



Designed: 2021-11-25
Printed: 2021-12-14

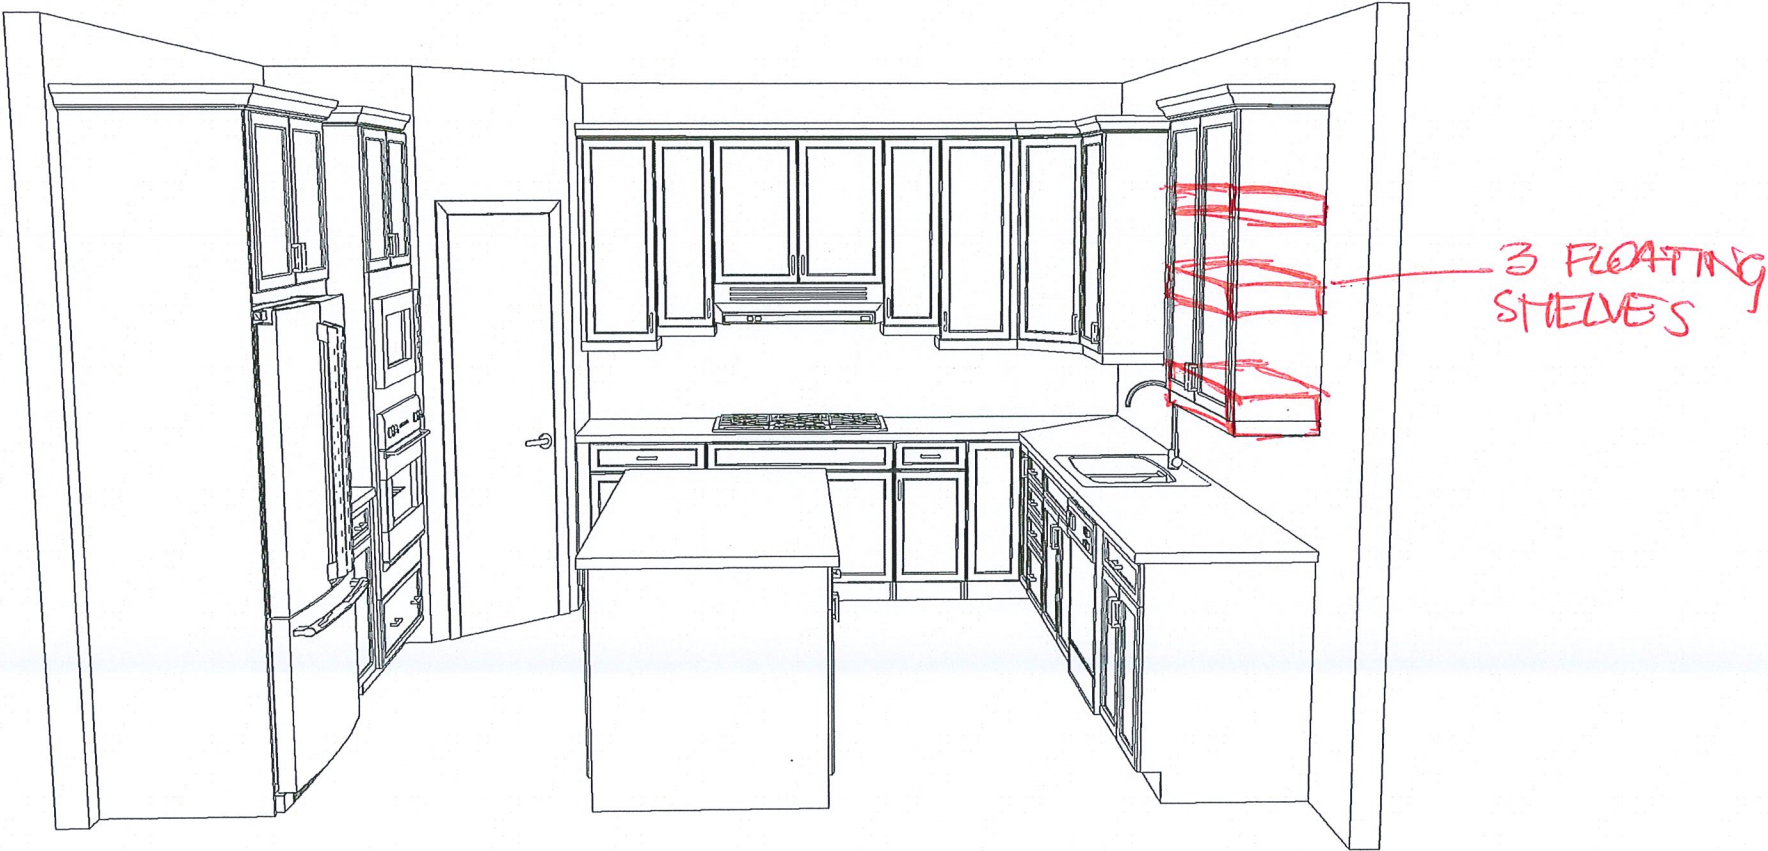

KITCHEN - 3D VIEW #1

CUSTOMER APPROVAL

I have reviewed these drawings and understand the details of the design and the CARTIER KITCHENS specifications.

Signature _____

Date _____

Note: This drawing is an artistic interpretation of the general appearance of the design. It is not meant to be an exact rendition.



Designed: 2021-11-25
Printed: 2021-12-14



KITCHEN- 3D VIEW #2

CUSTOMER APPROVAL

I have reviewed these drawings and understand the details of the design and the CARTIER KITCHENS specifications.

Signature _____

Date _____

Note: This drawing is an artistic interpretation of the general appearance of the design. It is not meant to be an exact rendition.



Designed: 2021-11-25
Printed: 2021-12-14

DS
K



KITCHEN - 3D VIEW #3

CUSTOMER APPROVAL

I have reviewed these drawings and understand the details of the design and the CARTIER KITCHENS specifications.

Signature _____


Date _____

DS
DS
K

Note: This drawing is an artistic interpretation of the general appearance of the design. It is not meant to be an exact rendition.



Designed: 2021-11-25
Printed: 2021-12-14

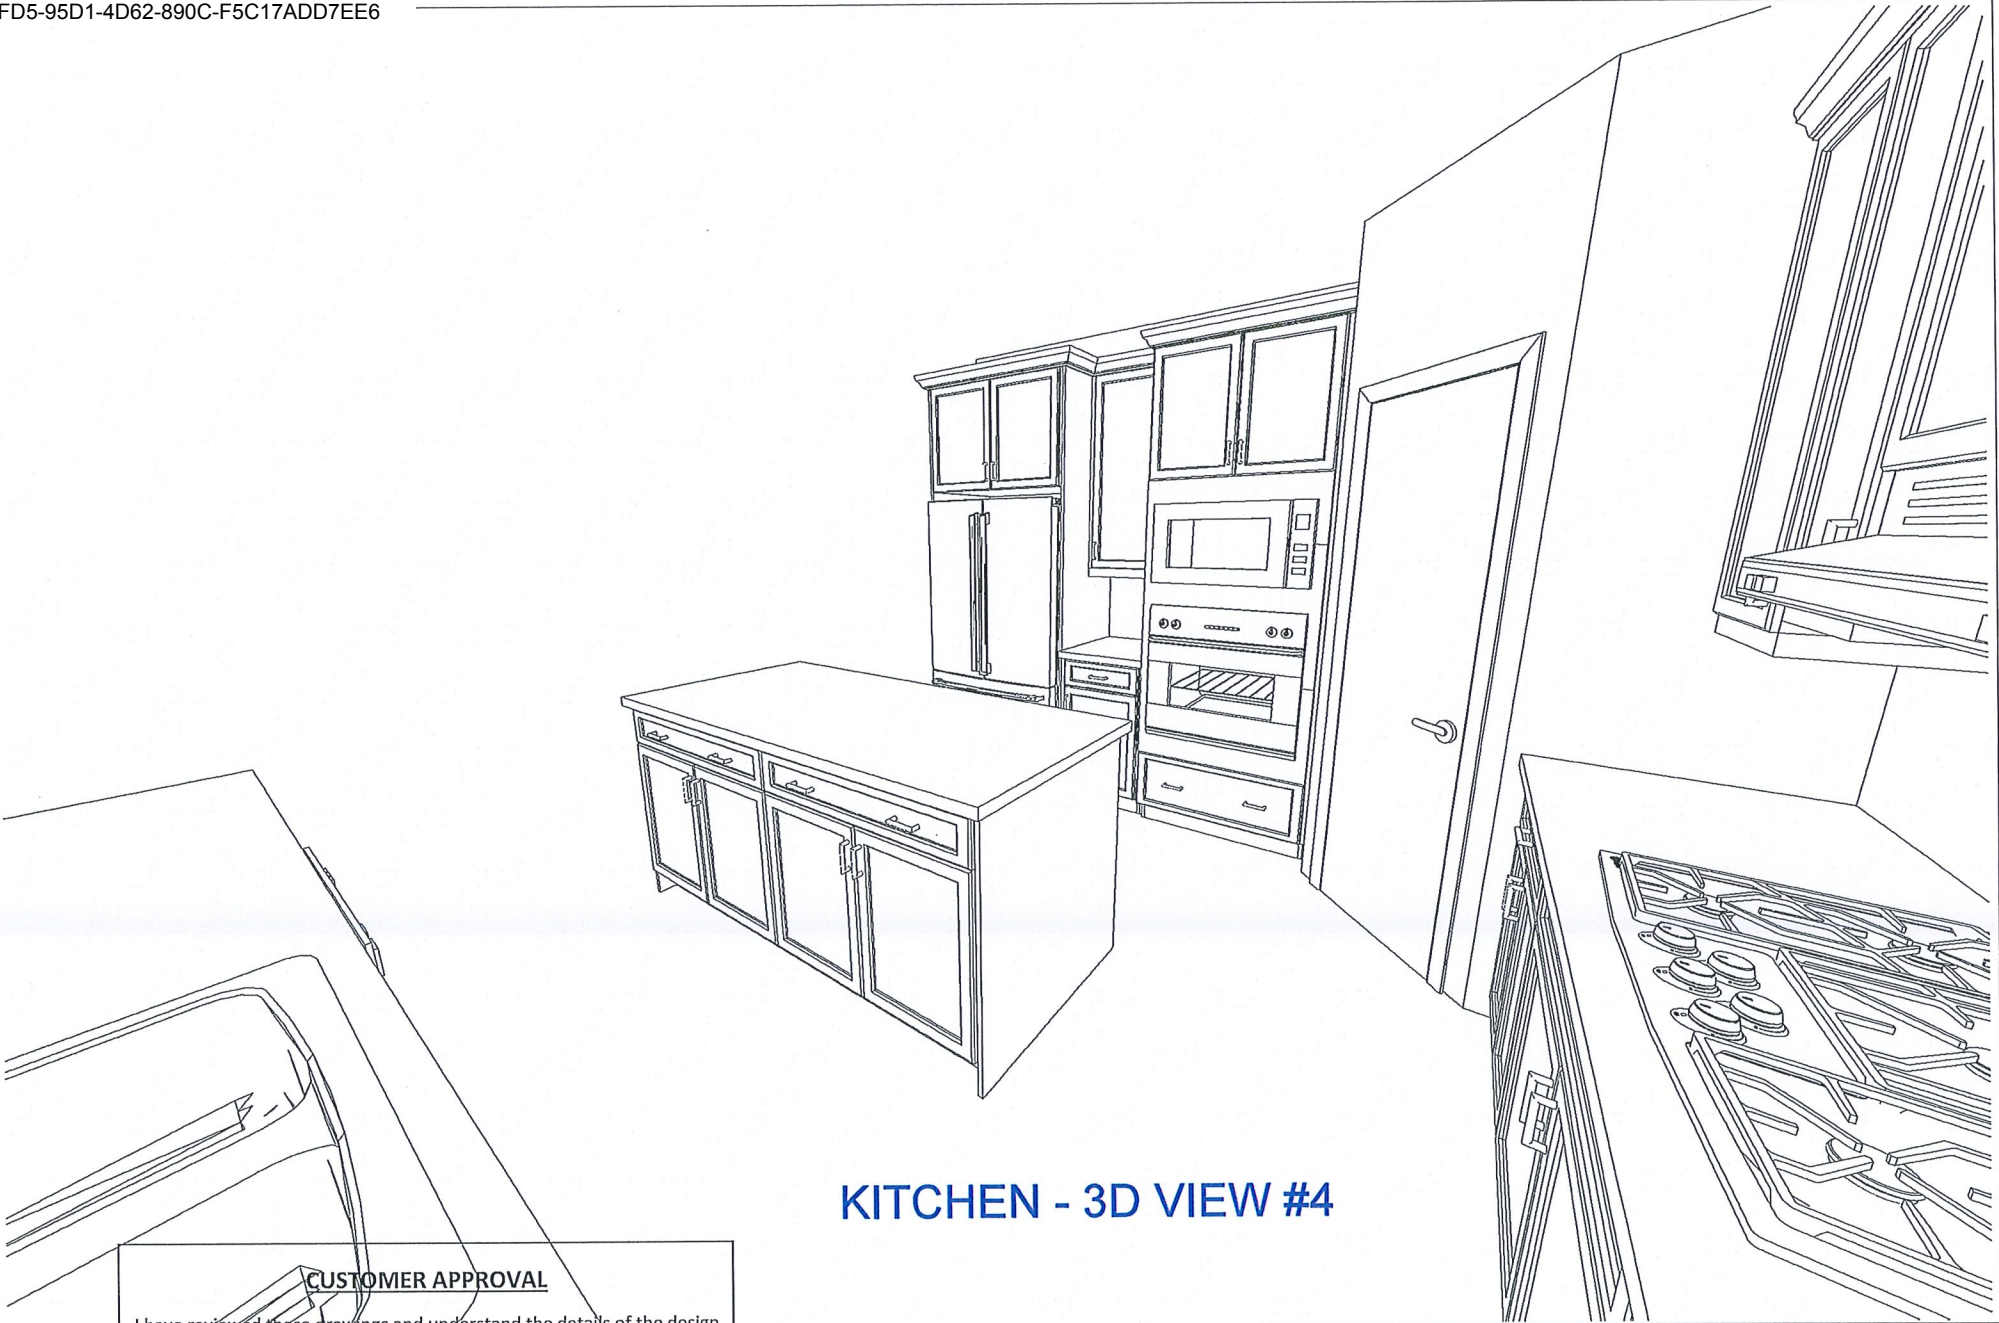

KITCHEN - 3D VIEW #4

CUSTOMER APPROVAL

I have reviewed these drawings and understand the details of the design and the CARTIER KITCHENS specifications.

Signature _____


Date _____

Note: This drawing is an artistic interpretation of the general appearance of the design. It is not meant to be an exact rendition.



Designed: 2021-11-25
Printed: 2021-12-14

DS
DS
K

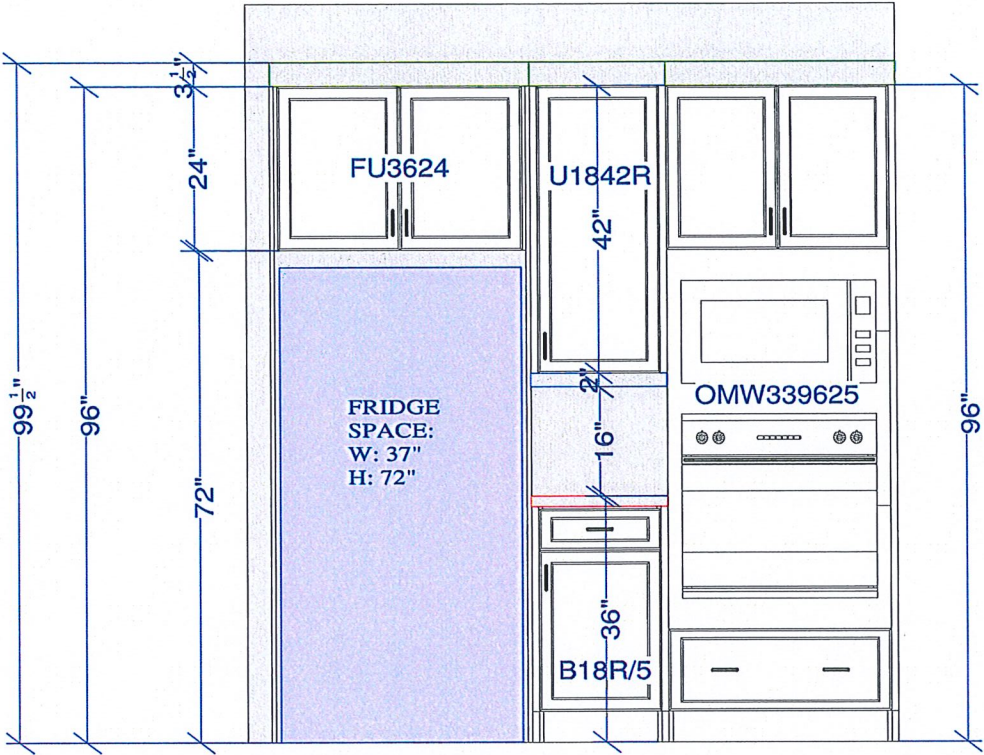

FRIDGE / OVEN WALL ELEVATION

CUSTOMER APPROVAL

I have reviewed these drawings and understand the details of the design and the CARTIER KITCHENS specifications.

Signature _____


Date _____

All dimensions _size designations given are subject to verification on job site and adjustment to fit job conditions.



This is an original design and must not be released or copied unless applicable fee has been paid or job order placed.

Designed: 2021-11-25
Printed: 2021-12-14

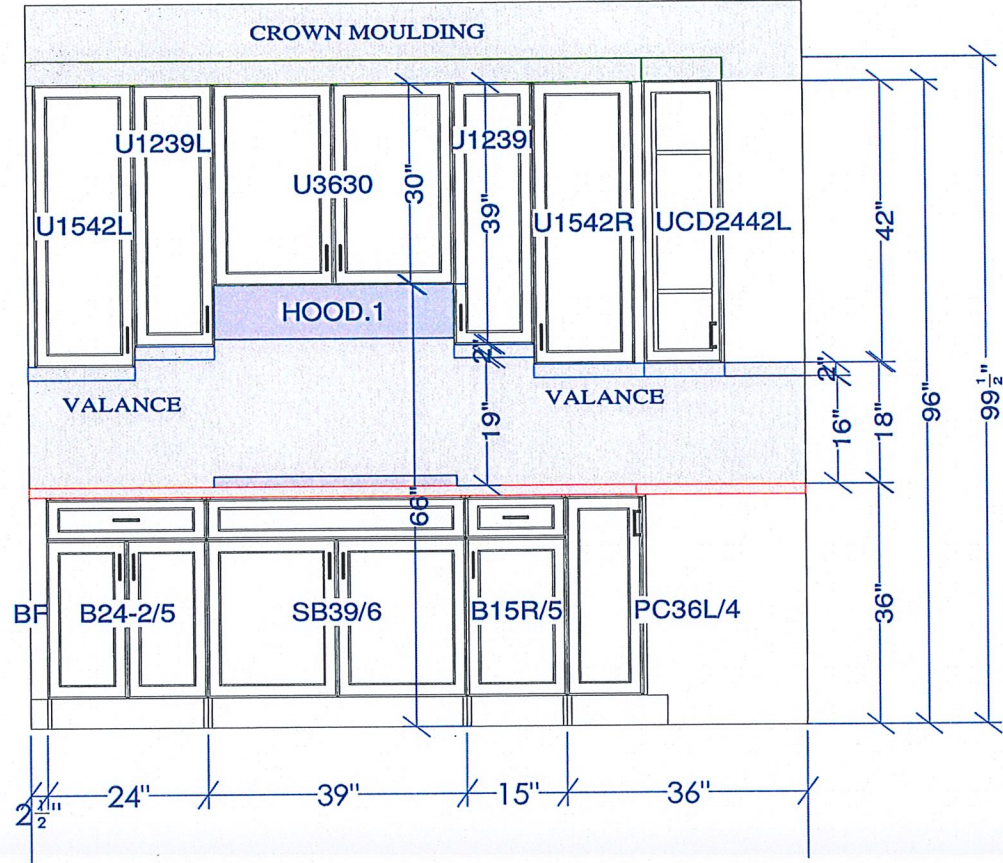

COOKTOP WALL ELEVATION

CUSTOMER APPROVAL


I have reviewed these drawings and understand the details of the design and the CARTIER KITCHENS specifications.

Signature _____

Date _____

All dimensions _size designations given are subject to verification on job site and adjustment to fit job conditions.		This is an original design and must not be released or copied unless applicable fee has been paid or job order placed.	Designed: 2021-11-25 Printed: 2021-12-14	
			DCR - Platina - Walk-in Pantry LOT# 3-151.kit	El 1 Drawing #: 1 No Scale.

DS DS K

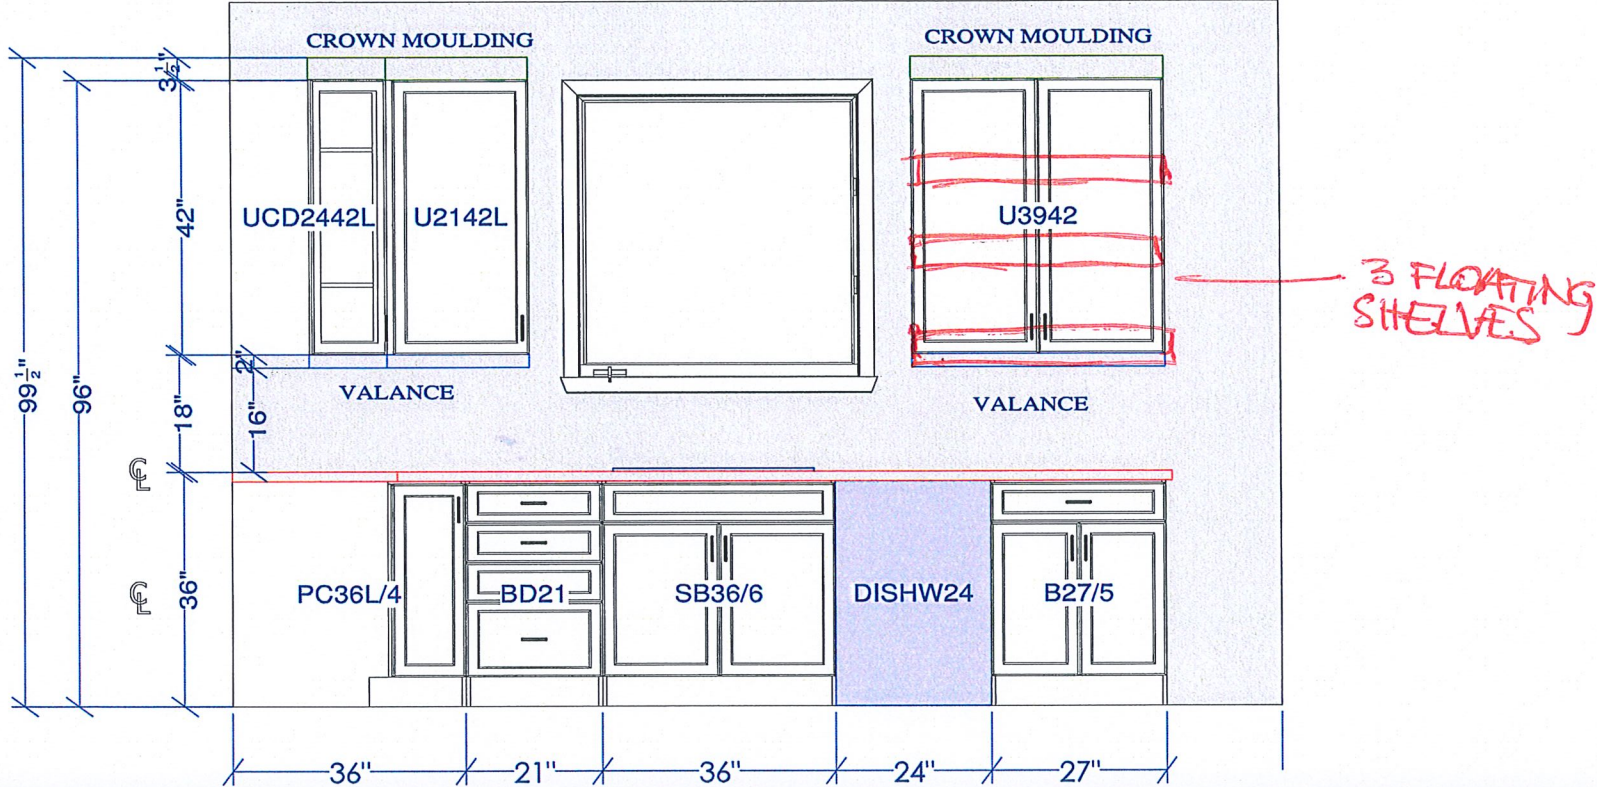


SINK WALL ELEVATION

CUSTOMER APPROVAL

I have reviewed these drawings and understand the details of the design and the CARTIER KITCHENS specifications.

Signature _____

Date _____

All dimensions _size designations given are subject to verification on job site and adjustment to fit job conditions.		This is an original design and must not be released or copied unless applicable fee has been paid or job order placed.	Designed: 2021-11-25 Printed: 2021-12-14
DCR - Platina - Walk-in Pantry LOT# 3-151.kit	El 2	Drawing #: 1	No Scale.

DS DS

