


DCR - PHOENIX HOMES


NEWINGTON III
KITCHEN

MOUNTING HEIGHT: 84

- KITCHEN
- LINE 1 & 2
- HARDWARE - STD & 1st UPGRADE
- STANDARD WHITE INTERIOR
- METAL DRAWER BOX
- 3 PCS - 5/8" KICK - FIN. BOTH ENDS
- 3 PCS - LOOSE FILLER - 3 x 96
- 2 PCS - 90 DEG. CORNER MOULD
- 1 PCS - T-MOULD
- 1 PCS - FLAT MOULDING

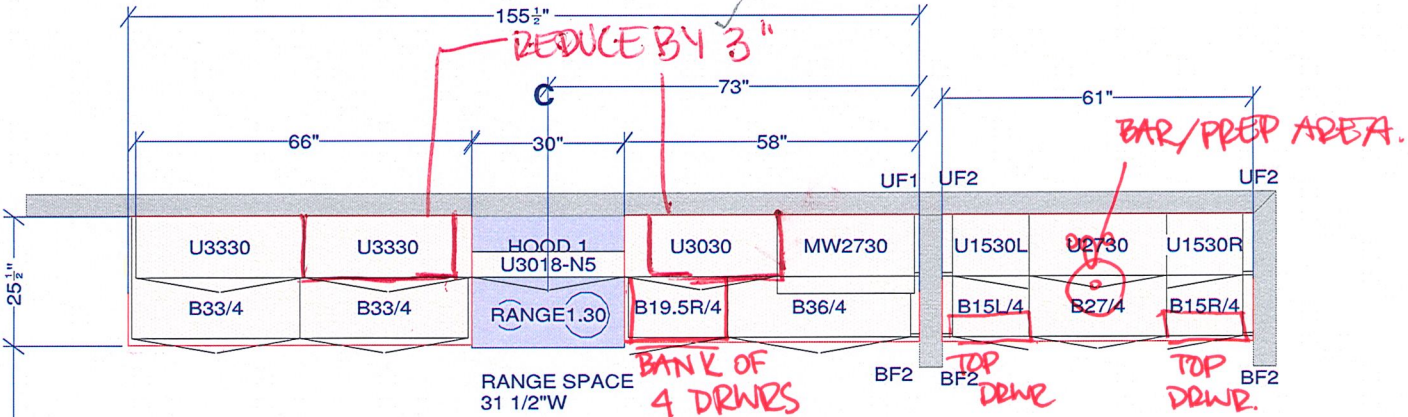

BUTLER'S PANTRY

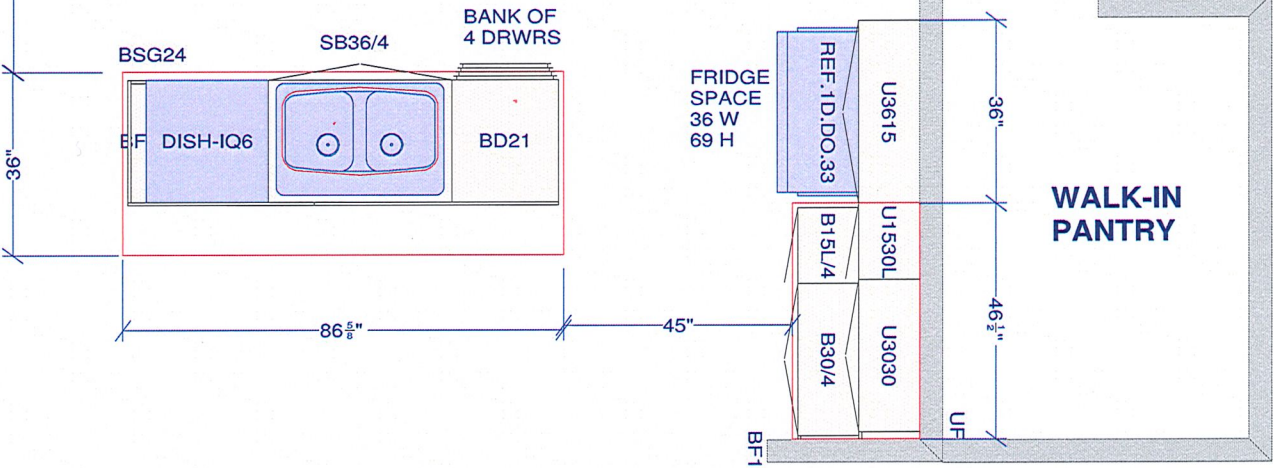

CUSTOMER APPROVAL

I have reviewed these drawings and understand the details of the design and the Cartier Kitchens specifications

Signature _____

Date _____




All dimensions ,size designations given are subject to verification on job site and adjustment to fit job conditions.

NEWINGTON III



This is an original design and must not be released or copied unless applicable fee has been paid or job order placed.

Designed: 2017-07-04
Printed: 2017-07-04

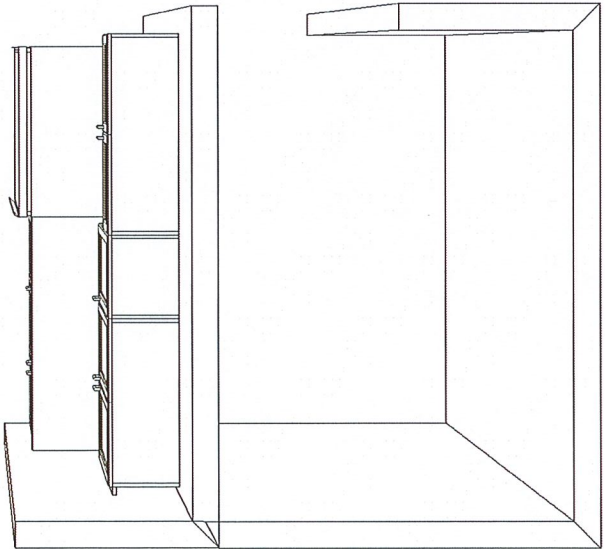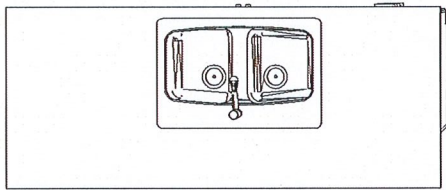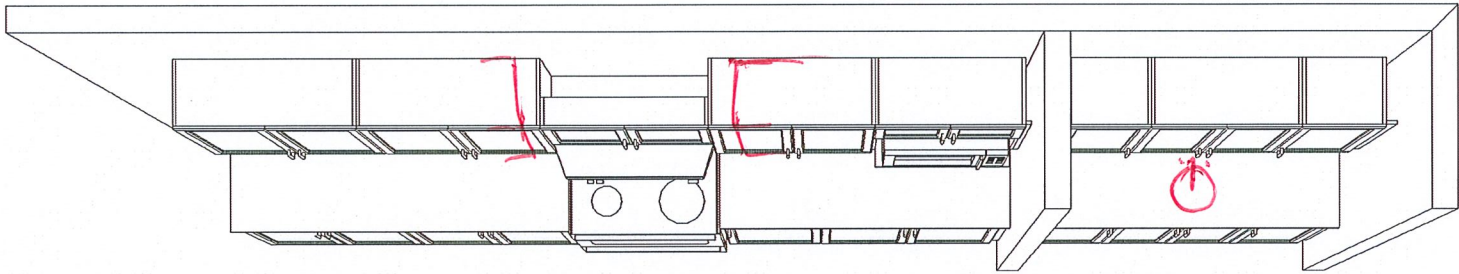

KITCHEN TOP VIEW
NEWINGTON III - STANDARD KITCHEN

CUSTOMER APPROVAL

I have reviewed these drawings and understand the details of the design and the Cartier Kitchens specifications

Signature _____

Date _____

DS
6/11

DS
XL

Note: This drawing is an artistic interpretation of the general appearance of the design. It is not meant to be an exact rendition.



Designed: 2017-07-04
Printed: 2017-07-05



DS
GU

DS
XL

KITCHEN 3D-VIEW 1
NEWINGTON III - STANDARD KITCHEN

CUSTOMER APPROVAL

I have reviewed these drawings and understand the details of the design and the Cartier Kitchens specifications


Signature _____

Date _____

Note: This drawing is an artistic interpretation of the general appearance of the design. It is not meant to be an exact rendition.



Designed: 2017-07-04
Printed: 2017-07-04

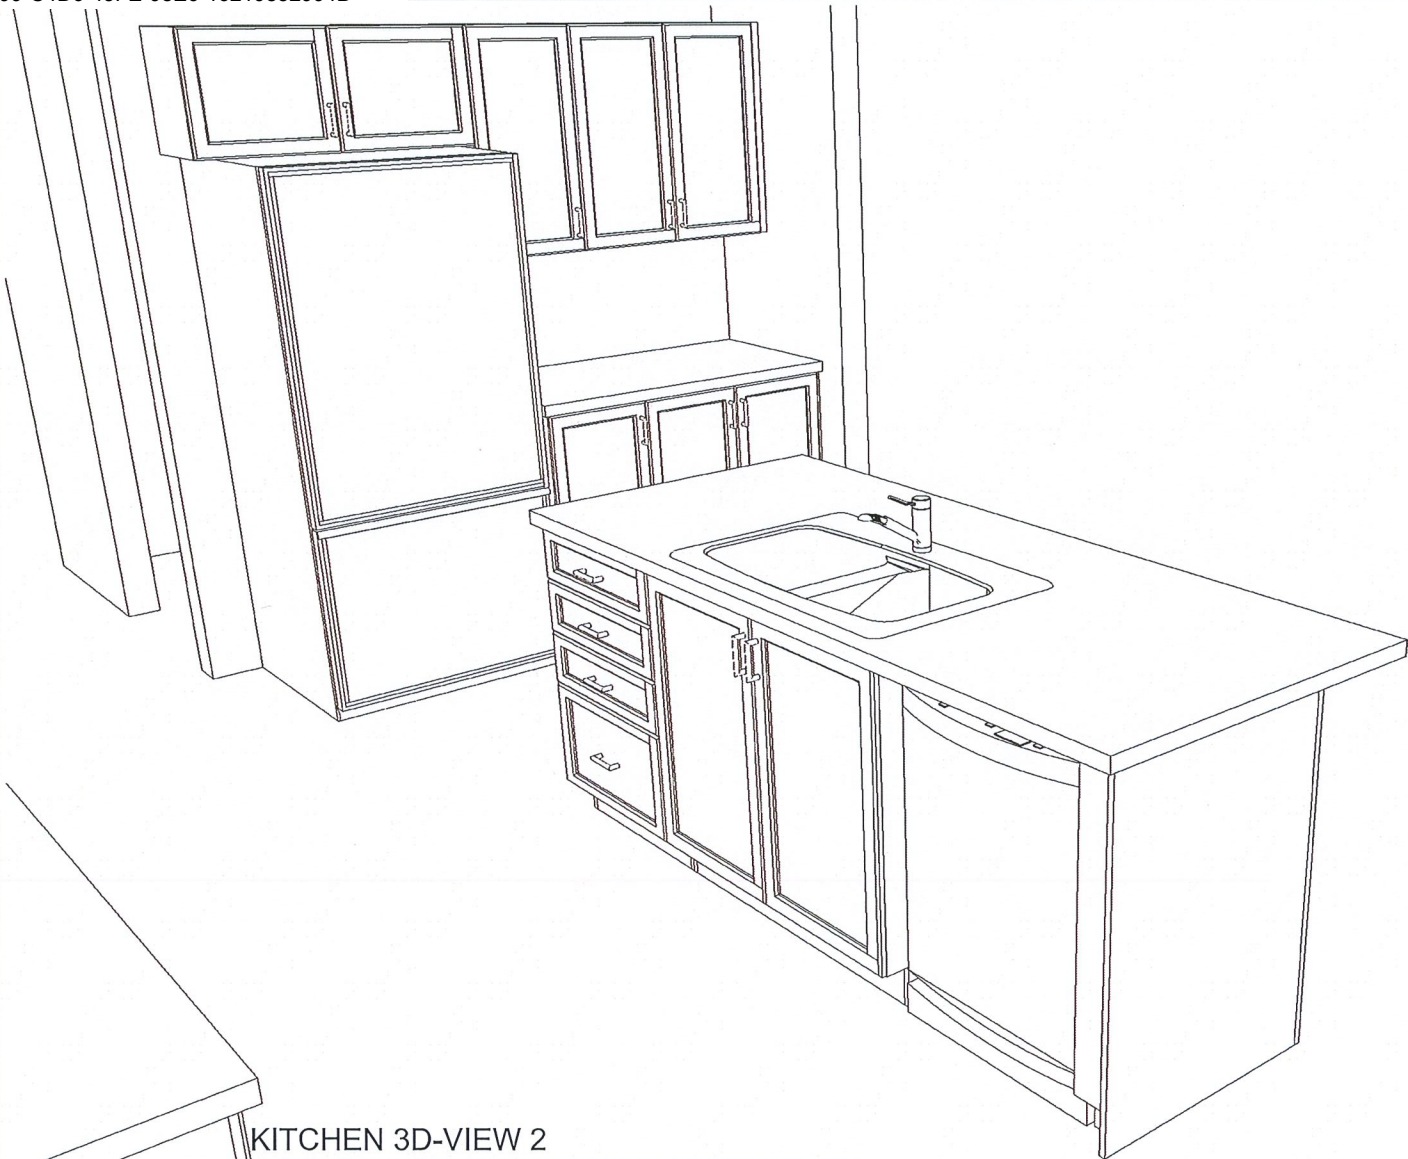

KITCHEN 3D-VIEW 2
NEWINGTON III - STANDARD KITCHEN

CUSTOMER APPROVAL

I have reviewed these drawings and understand the details of the design and the Cartier Kitchens specifications

Signature _____

Date _____

DS

GL

DS


XL

Note: This drawing is an artistic interpretation of the general appearance of the design. It is not meant to be an exact rendition.



Designed: 2017-07-04

Printed: 2017-07-04

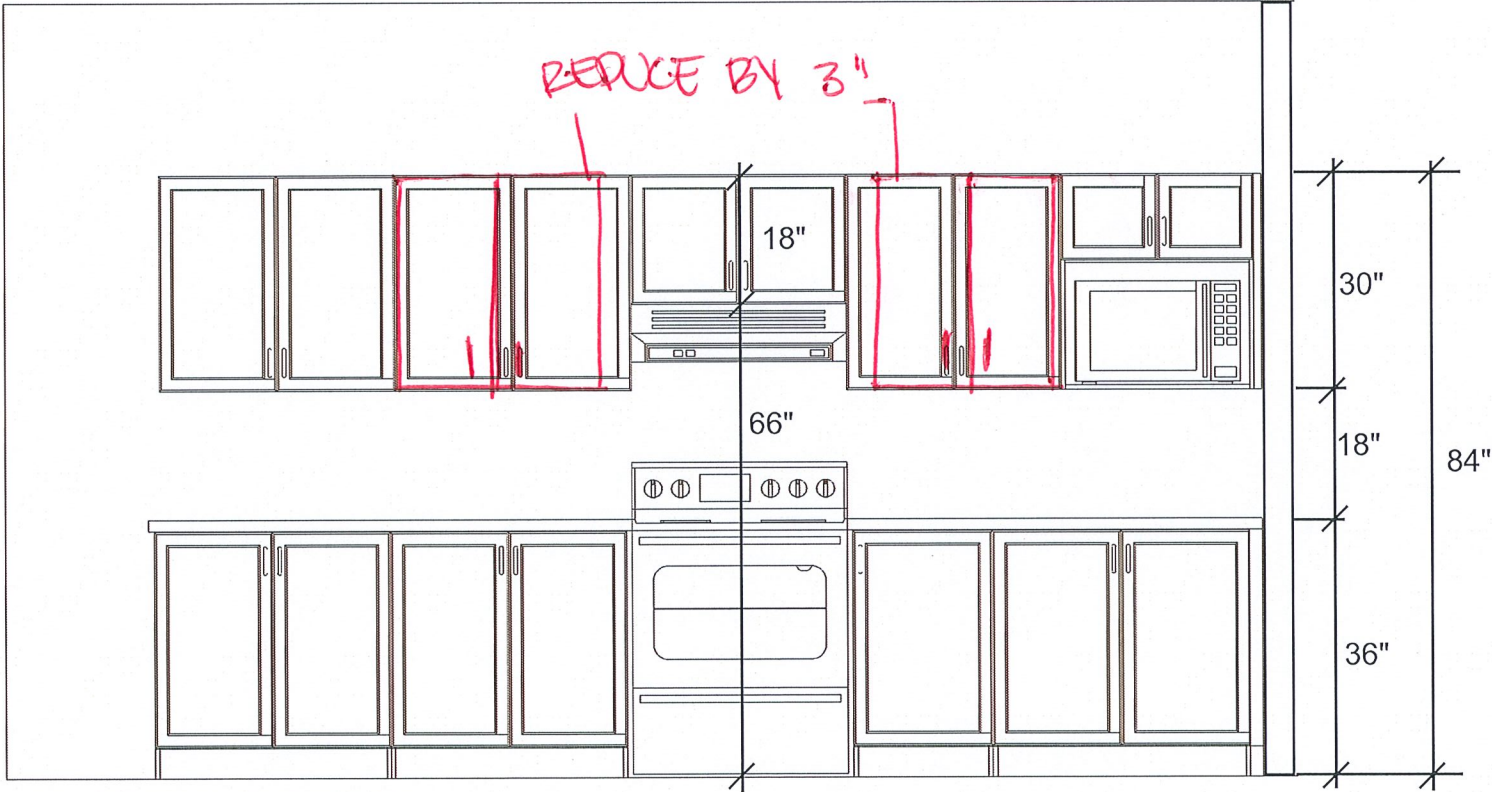

RANGE WALL ELEVATION
NEWINGTON III - STANDARD KITCHEN

CUSTOMER APPROVAL

I have reviewed these drawings and understand the details of the design and the Cartier Kitchens specifications

Signature _____

Date _____


DS

GLL

DS

XL

Note: This drawing is an artistic interpretation of the general appearance of the design. It is not meant to be an exact rendition.




Designed: 2017-07-04
Printed: 2017-07-04

NEWINGTON III

All

Drawing #: 1

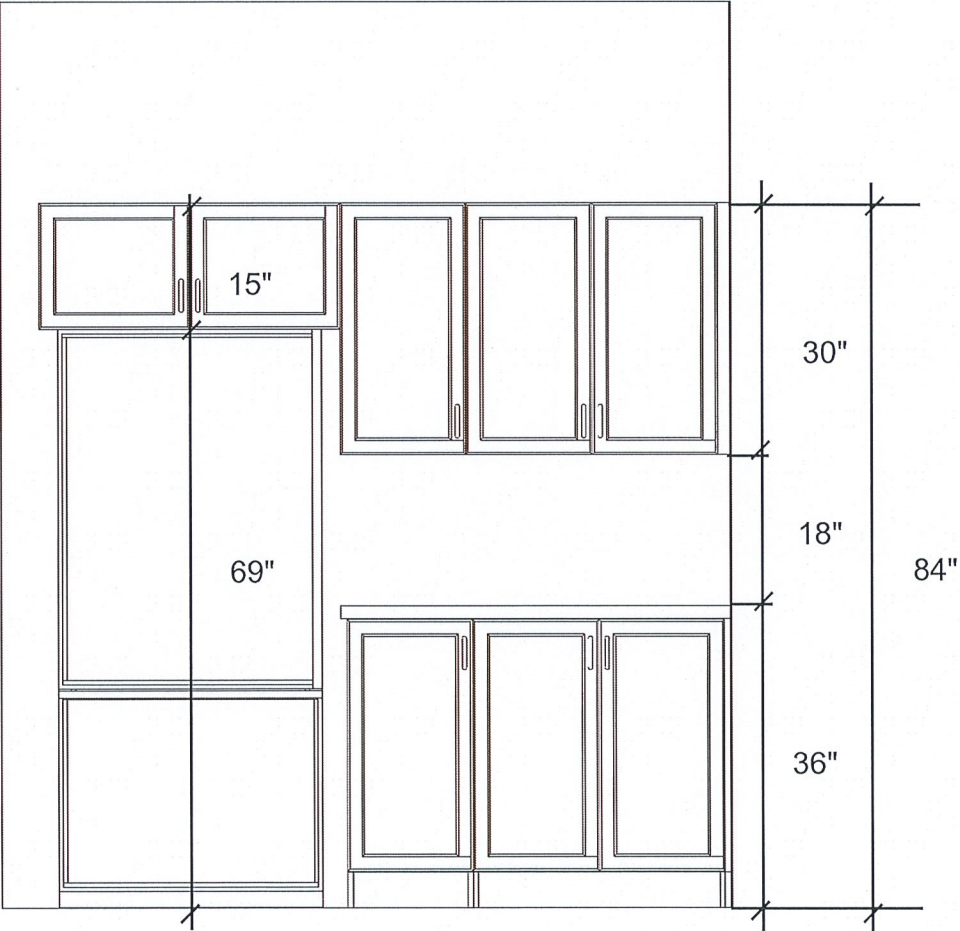

FRIDGE WALL ELEVATION
NEWINGTON III - STANDARD KITCHEN

CUSTOMER APPROVAL

I have reviewed these drawings and understand the details of the design and the Cartier Kitchens specifications

Signature _____

Date _____

DS
GL

DS
XL

Note: This drawing is an artistic interpretation of the general appearance of the design. It is not meant to be an exact rendition.




Designed: 2017-07-04
Printed: 2017-07-04

NEWINGTON III

All

Drawing #: 1

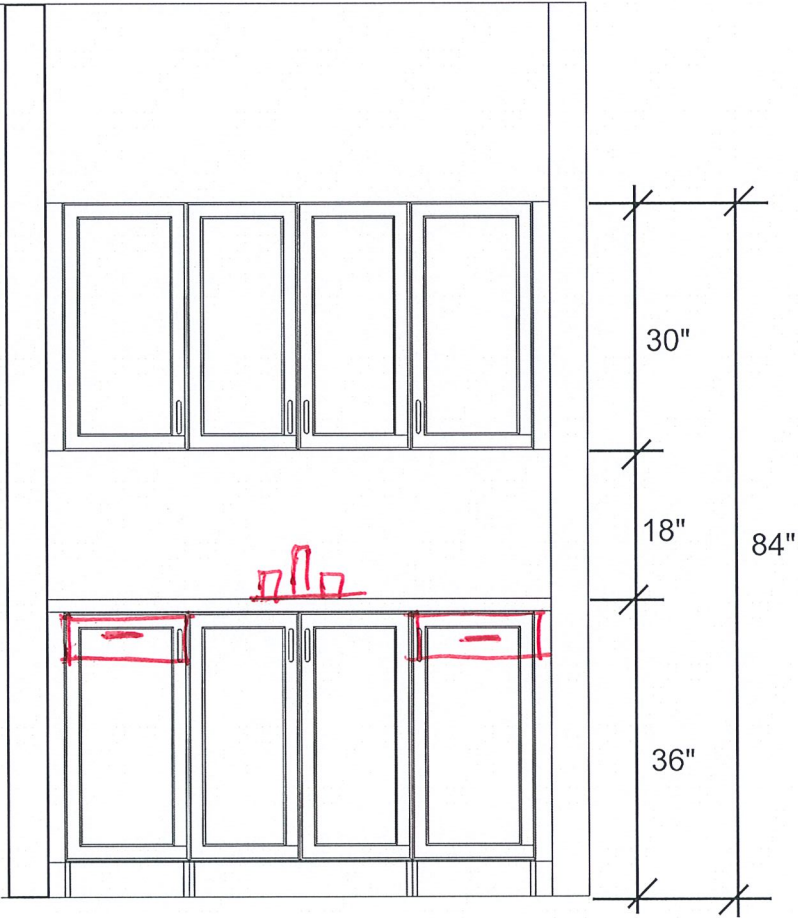

BUTLER'S PANTRY WALL ELEVATION
NEWINGTON III - STANDARD KITCHEN

CUSTOMER APPROVAL

I have reviewed these drawings and understand the details of the design and the Cartier Kitchens specifications

Signature _____

Date _____


DS

GL

DS

XL

Note: This drawing is an artistic interpretation of the general appearance of the design. It is not meant to be an exact rendition.



Designed: 2017-07-04
Printed: 2017-07-04

NEWINGTON III

All

Drawing #: 1