


DCR PHOENIX HOMES

FERNBANK CROSSING
MODEL - MELBOURNE (35-15)
KITCHEN


MOUNTING HEIGHT = 84

PW42-313

- LINE - 1 & 2
- HARDWARE -
- STANDARD WHITE INTERIORS
- METAL DRAWER BOXES
- 6 PCS - 5/8 KICK FIN. BOTH SIDES
- 1 PCS - T-MOULD
- 1 PCS - 90 DEG. CORNER MOULD
- 8 PCS - FLAT MOULD

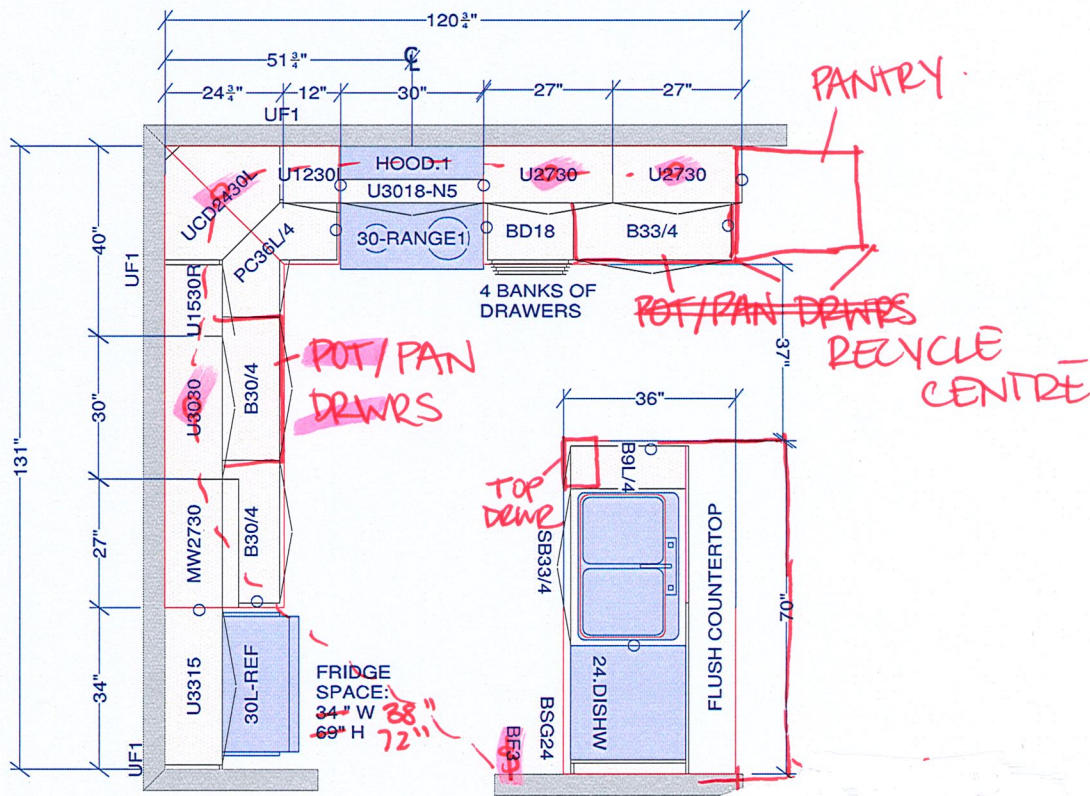

VANIITES - 3 BDRM + LOFT

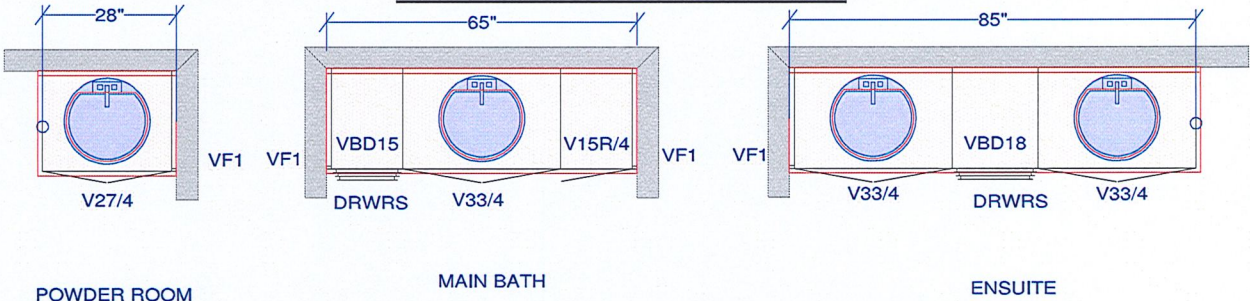

All dimensions size designations given are subject to verification on job site and adjustment to fit job conditions. SPECTRUM KITCHENS INC.		This is an original design and must not be released or copied unless applicable fee has been paid or job order placed. Drawn by: Lori Di Saverio, B.I.D. SPECTRUM KITCHENS INC.	Designed: 16/05/2016 Printed: 20/05/2016	
			DCR Phoenix - 35-15 Melbourne - 2016.kit	Drawing #: 1 No Scale.



DS
TK

DS
LP

Note: This drawing is an artistic interpretation of the general appearance of the design. It is not meant to be an exact rendition.


Drawn By: Lori D Saverio, B.I.D.
SPECTRUM KITCHENS INC
DCR Phoenix - 35-15 Melbourne - 2016.kit



Designed: 16/05/2016
Printed: 20/05/2016

All

Drawing #: 1

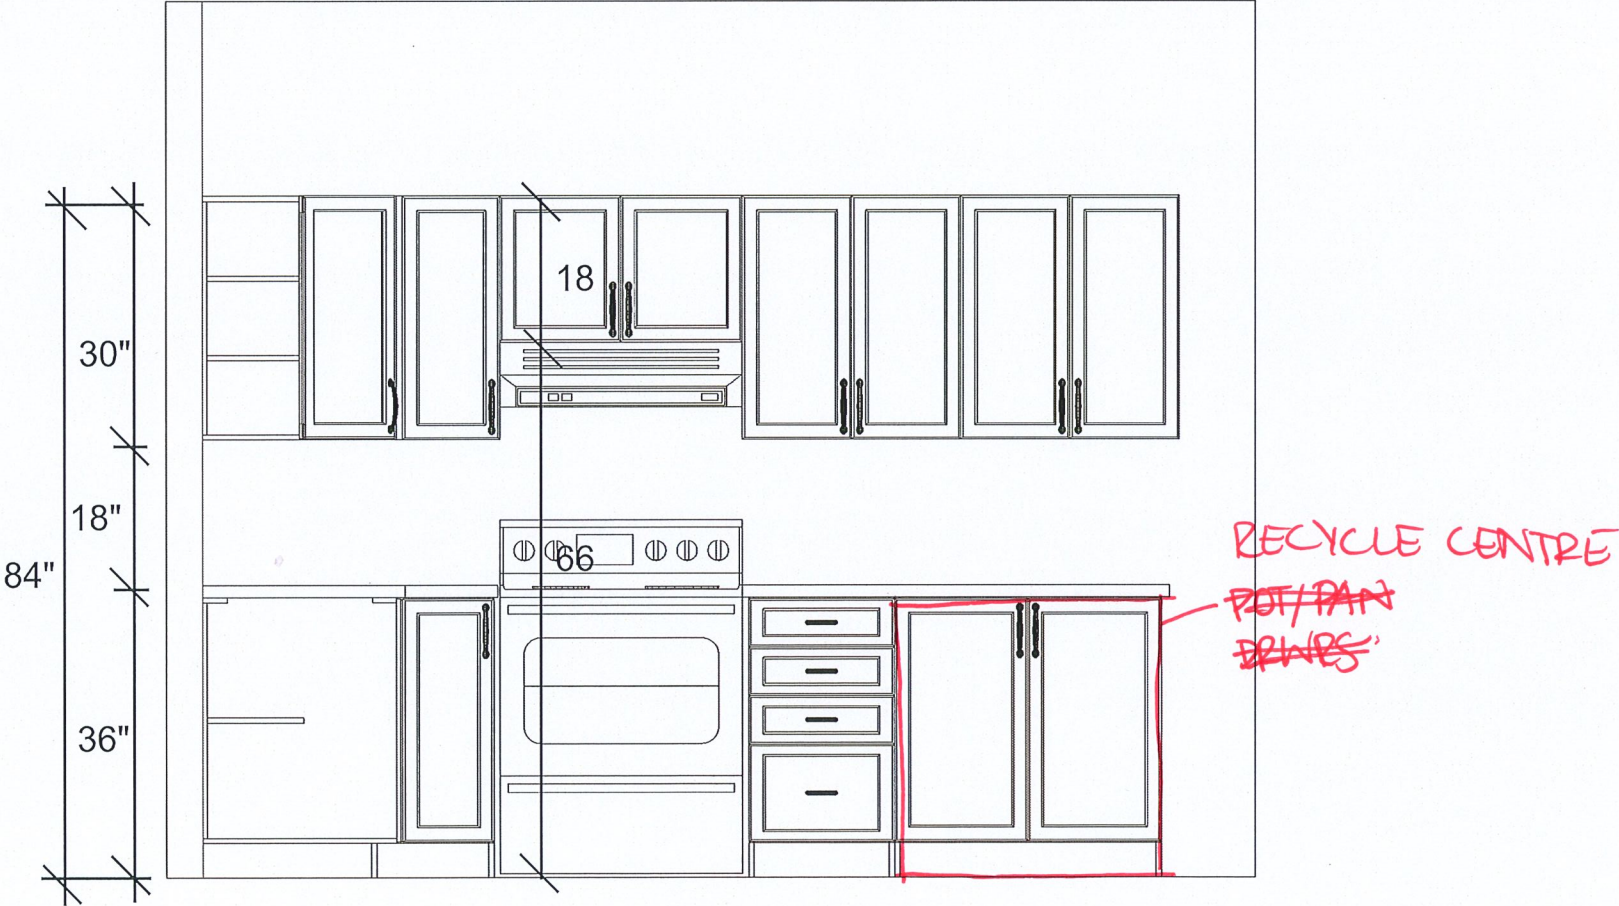


STOVE WALL ELEVATION
DCR PHOENIX - MELBOURNE

DS
TK

DS
LP

Note: This drawing is an artistic interpretation of the general appearance of the design. It is not meant to be an exact rendition.	2020 TECHNOLOGIES SPECTRUM KITCHEN & BATH DESIGN	Designed: 5/17/2016 Printed: 5/17/2016
	DCR Phoenix - Melbourne - 2016 All Drawing #: 1	

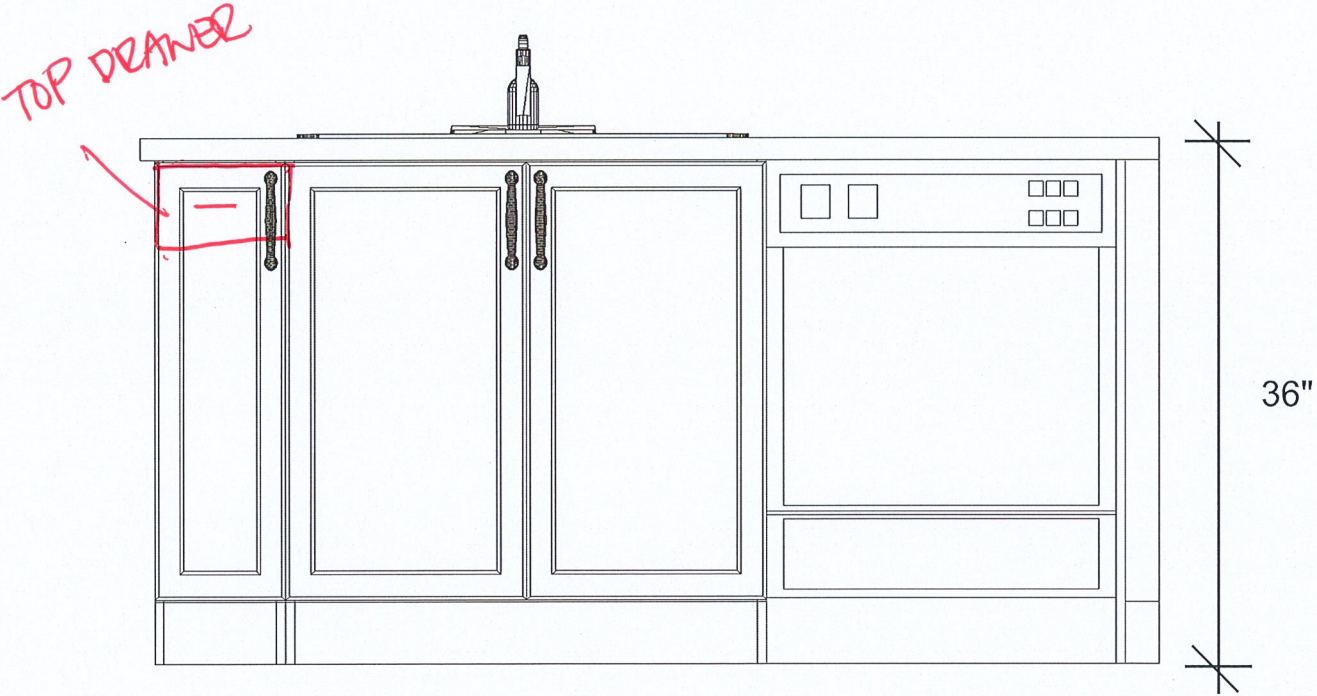


ISLAND ELEVATION
DCR PHOENIX - MELBOURNE

DS
TK

DS
LP

Note: This drawing is an artistic interpretation of the general appearance of the design. It is not meant to be an exact rendition.	 	Designed: 5/17/2016 Printed: 5/17/2016	
		All	Drawing #: 1

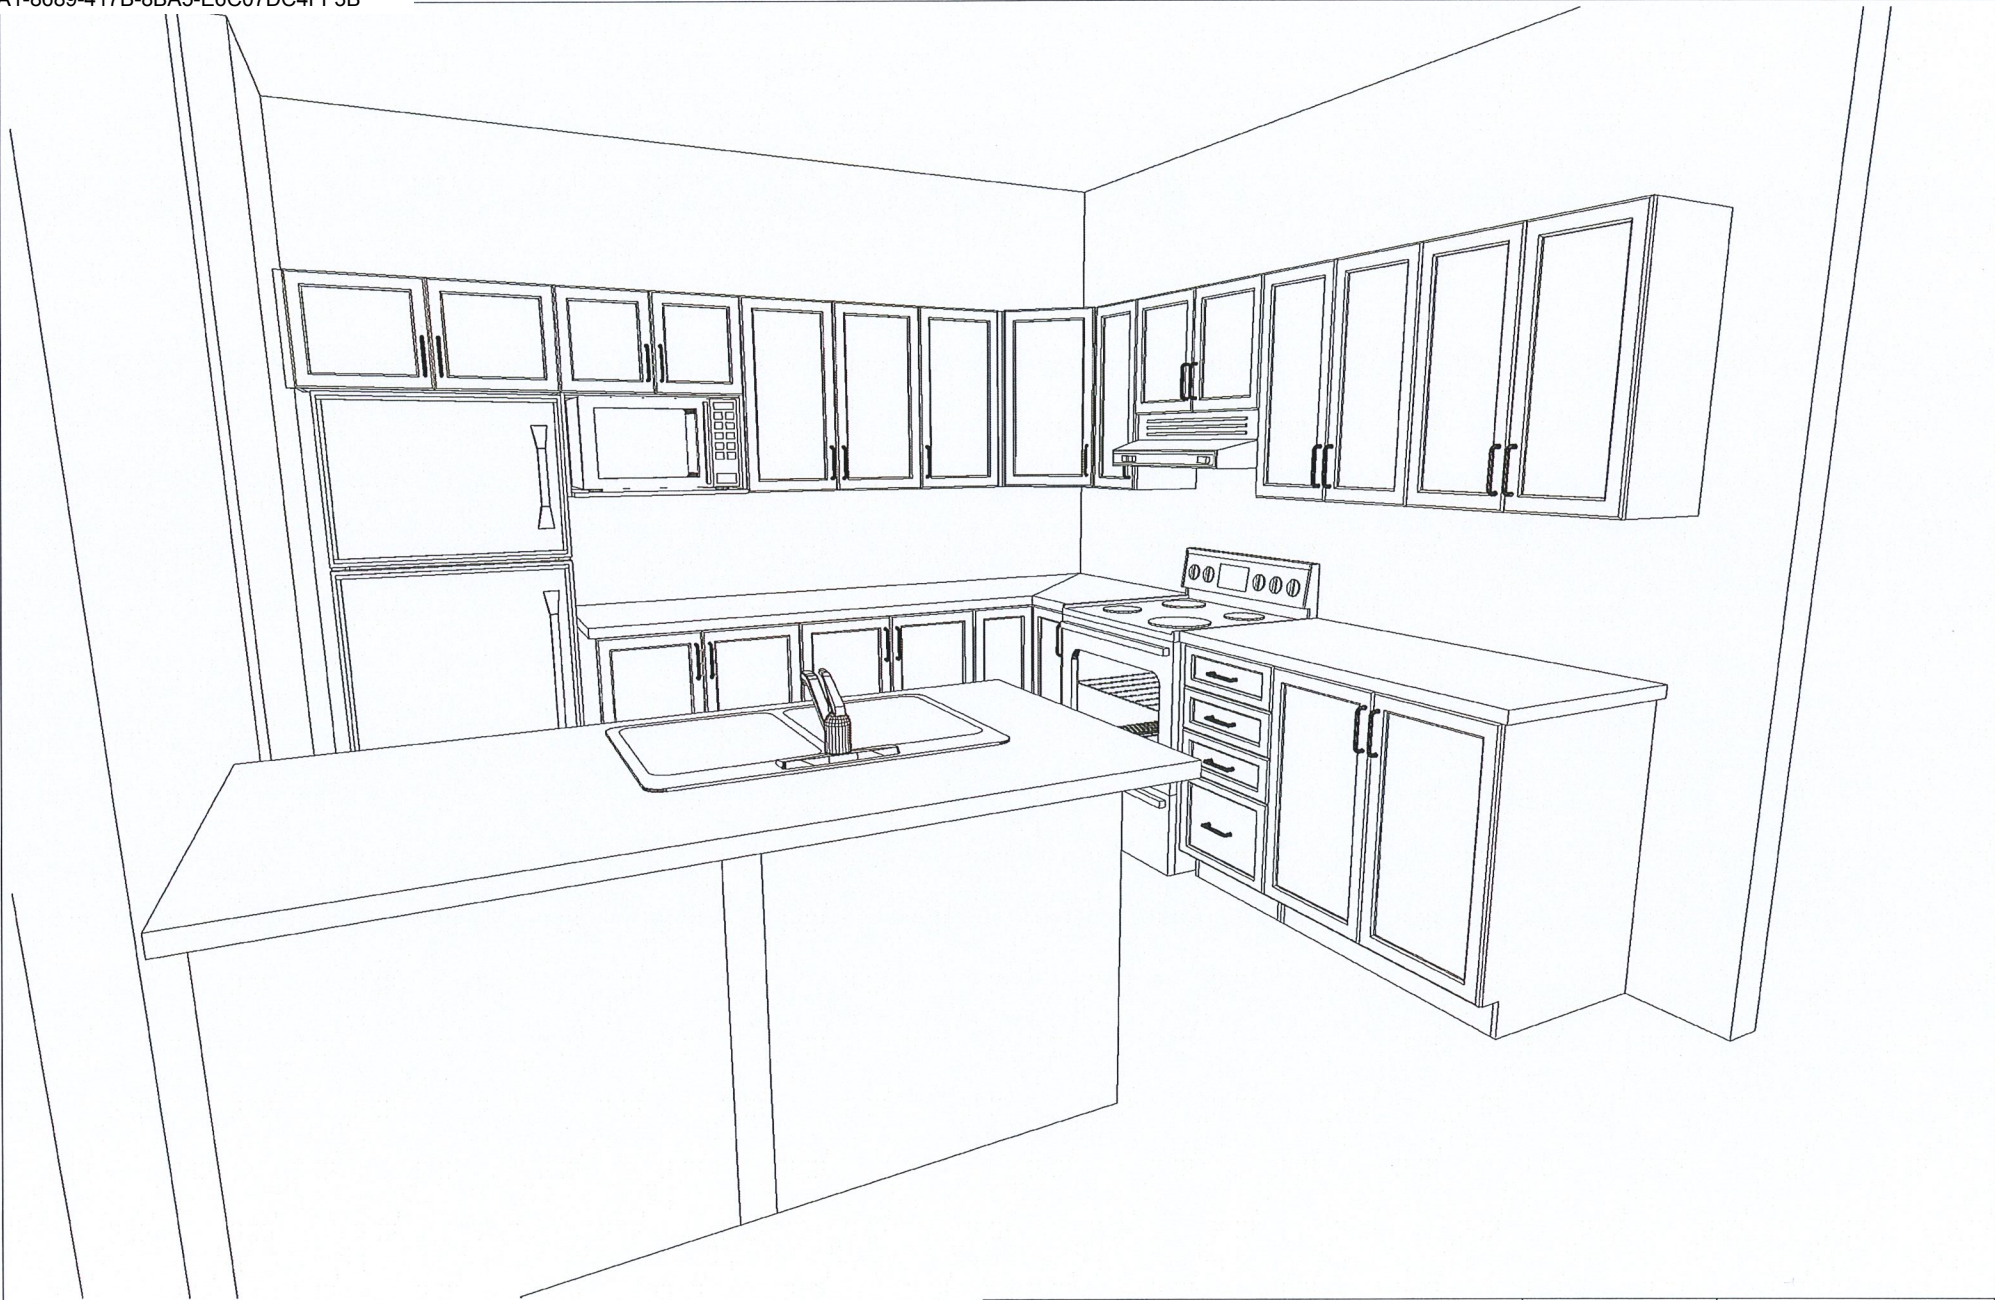

DS
TK

DS
LP

Note: This drawing is an artistic interpretation of the general appearance of the design. It is not meant to be an exact rendition.

Drawn By: Lori D Saverio, B.I.D.
SPECTRUM KITCHENS INC
DCR Phoenix - 35-15 Melbourne - 2016.kit



Designed: 16/05/2016
Printed: 20/05/2016

All

Drawing #: 1