

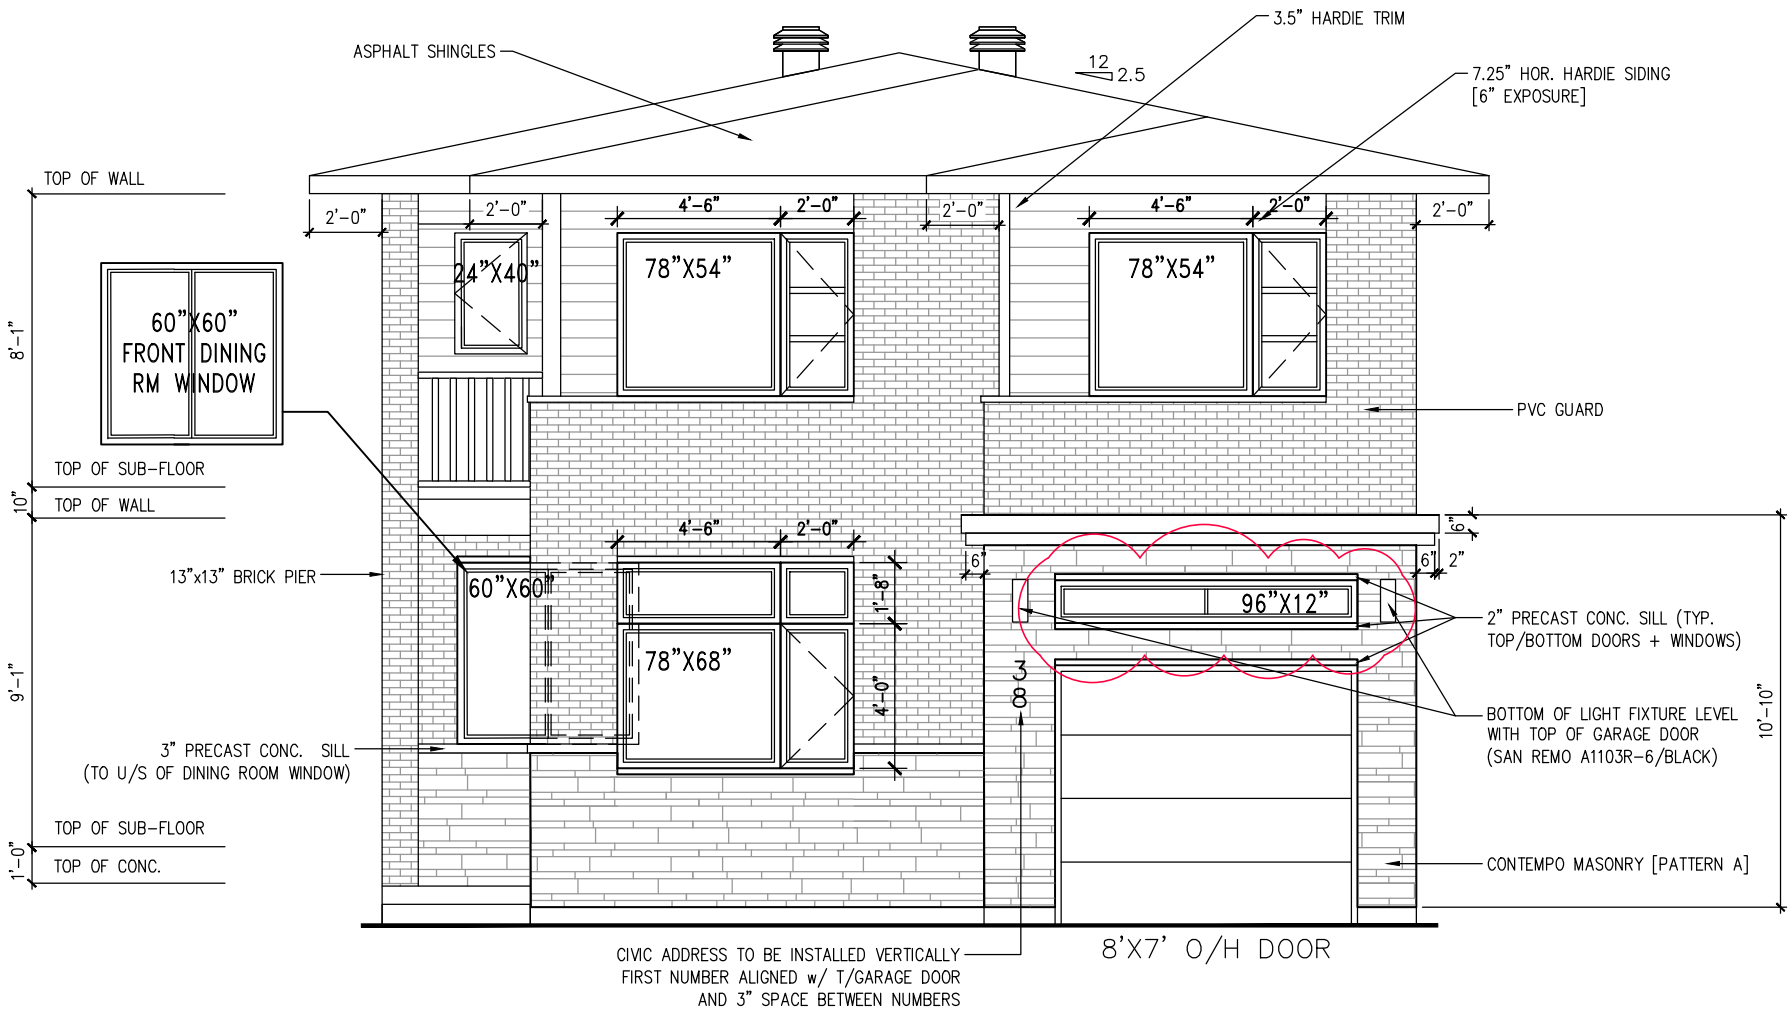


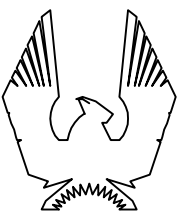

ELEVATION M

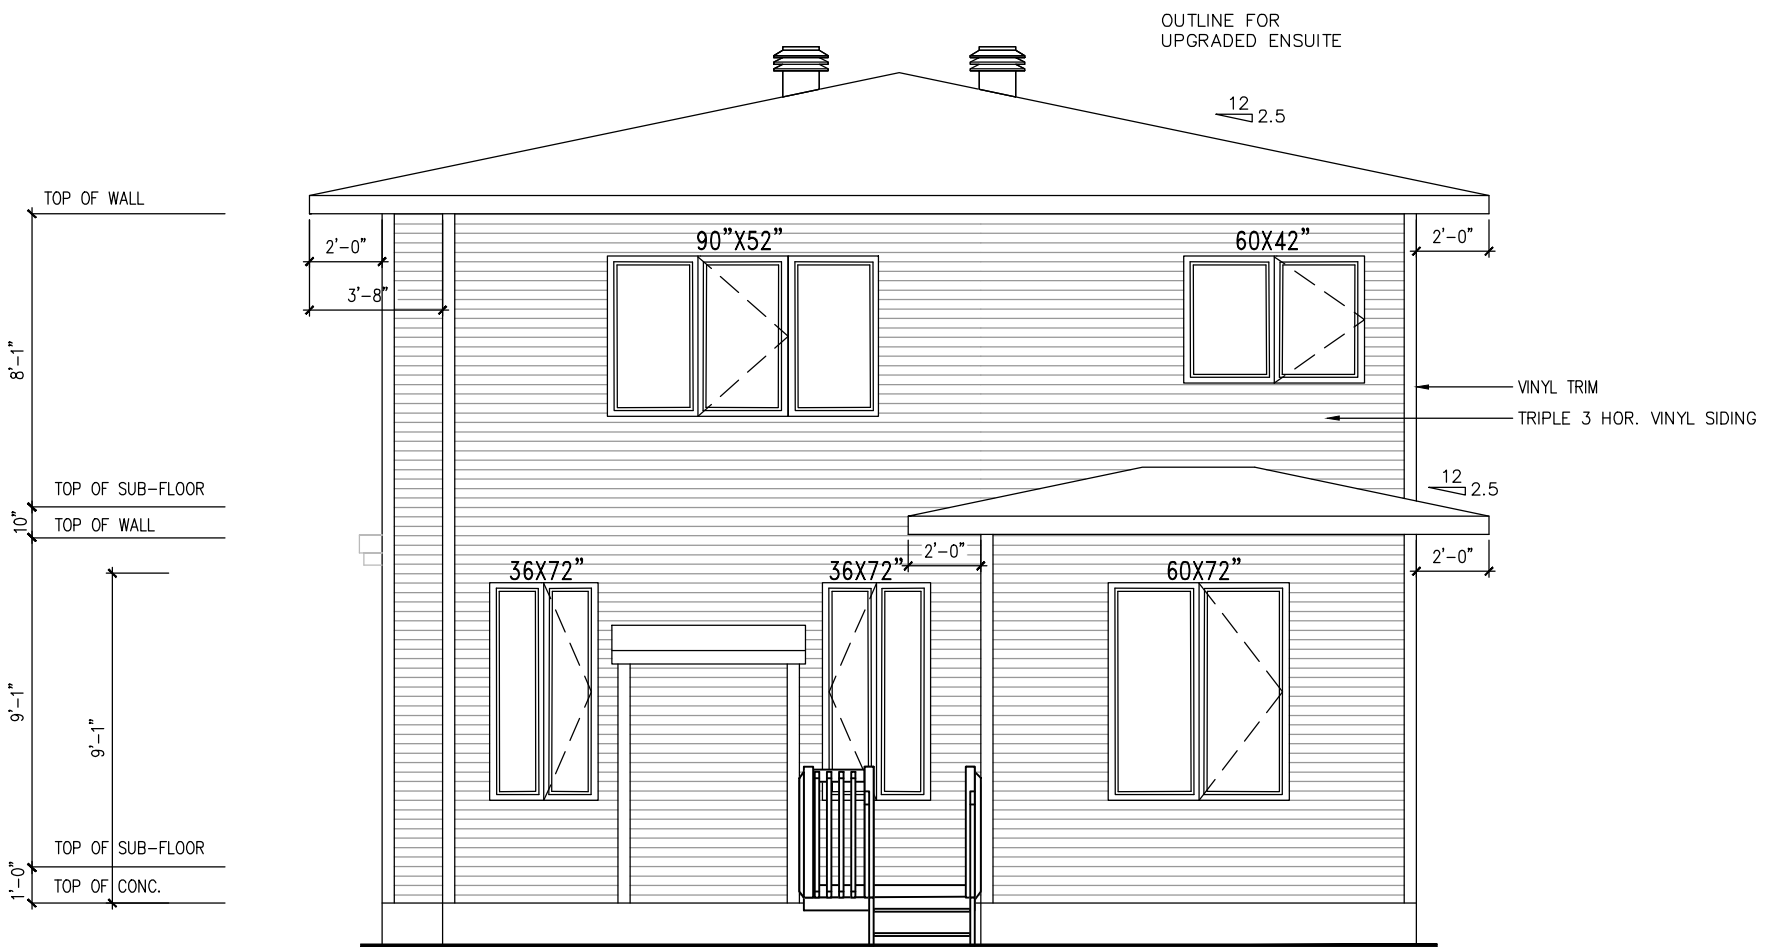

PHOENIX HOMES

MIRAPOSA PLUS

SITE: PATHWAYS PH2

LOT NUMBER:

295

CIVIC ADDRESS:
38 DUN SKIPPER DRIVE

6	WINDOW MODIFICATION AT O/H GARAGE	10/05/22	SP
5	KITCHEN MODIFICATION	26/10/21	SP
4	FINAL BLACKLINES	16/09/21	GK
3	ADDED GARAGE SECTION - ELEVATION M	12/07/19	SP
2	STRUCTURAL REVIEW	29/05/19	SP
1	PRELIMINARY - CONCEPT PROPOSAL	29/10/16	SP
No.	Description	dd/mm/yy	By
REVISIONS			

footprint: 35-33

drawn by: SP

date: OCT/16

scale: 3/16"=1'-0"

sheet no:

DCL-194

5

8