


DCR PHOENIX HOMES

LOT #318
PATHWAYS - PHASE 2
RUTHERFORD (517)
ALTERNATE KITCHEN
MOUNTING HEIGHT - 96

CABINETS -
HARDWARE -
STANDARD WHITE INTERIOR
STANDARD METAL DRAWERS
STANDARD HINGES
4 PCS - 5/8" KICK - FIN. BOTH ENDS
5 PCS - FLAT MOULD

42" UPPERS AT 18" ABOVE COUNTER
CROWN MLDG

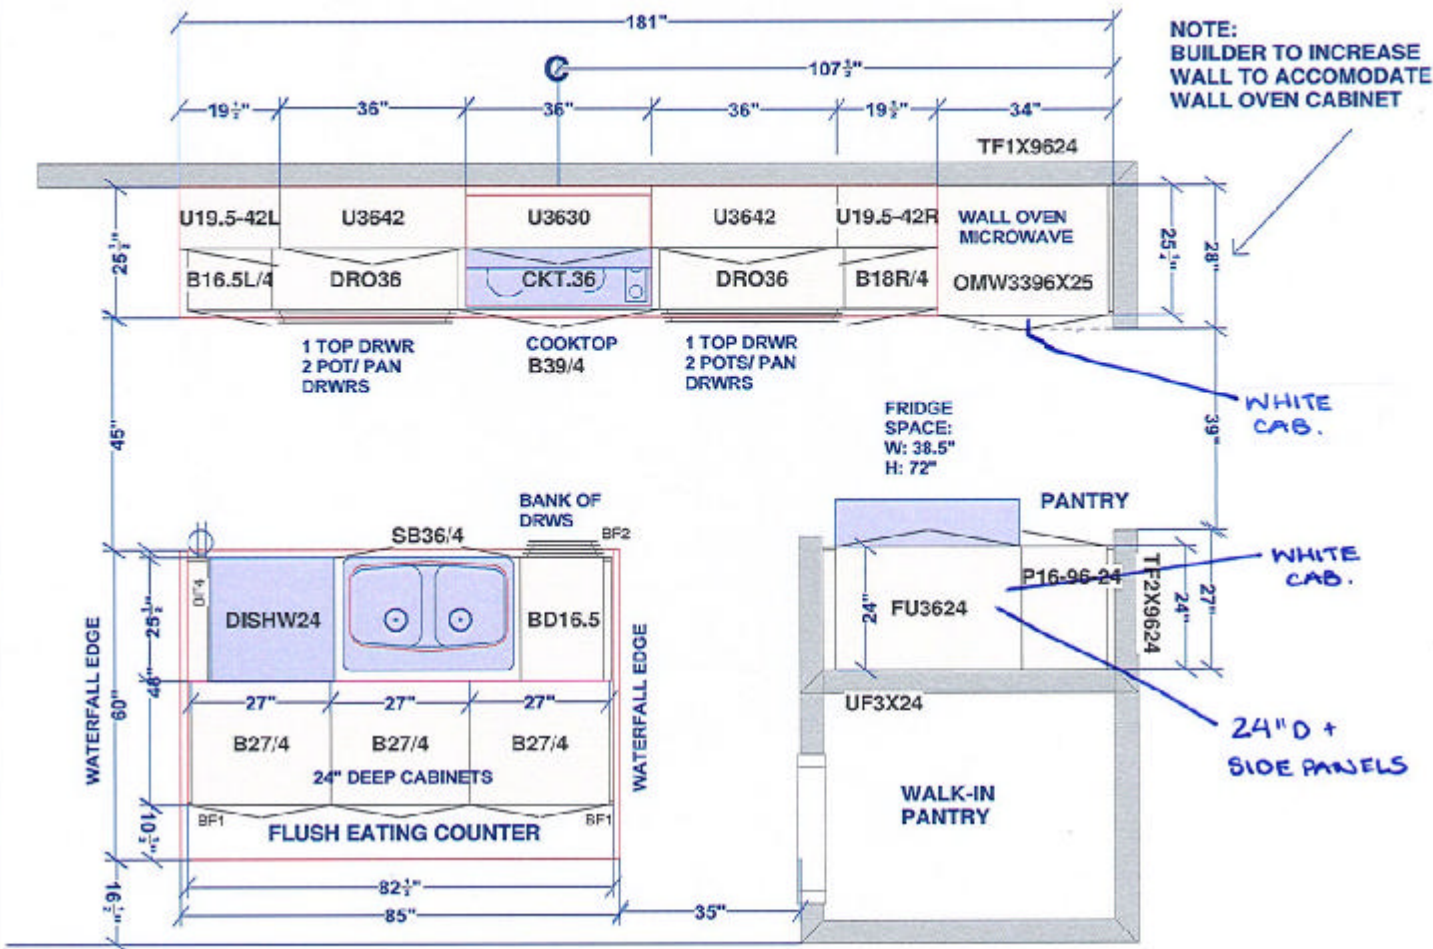

CUSTOMER APPROVAL

I have reviewed these drawings and understand the details of the design and the CARRIER KITCHENS specifications.

Signature: _____

Date: _____

All dimensions, size designations given are subject to verification on job site and adjustment to fit job conditions.



This is an original design and must not be released or copied unless applicable fee has been paid or job order placed.


Designed: 2021-12-03
Printed: 2021-12-22

DCR - 318 PWYS 2 - Rutherford .kit

All

Drawing #: 1 No Seal.

DS
SK

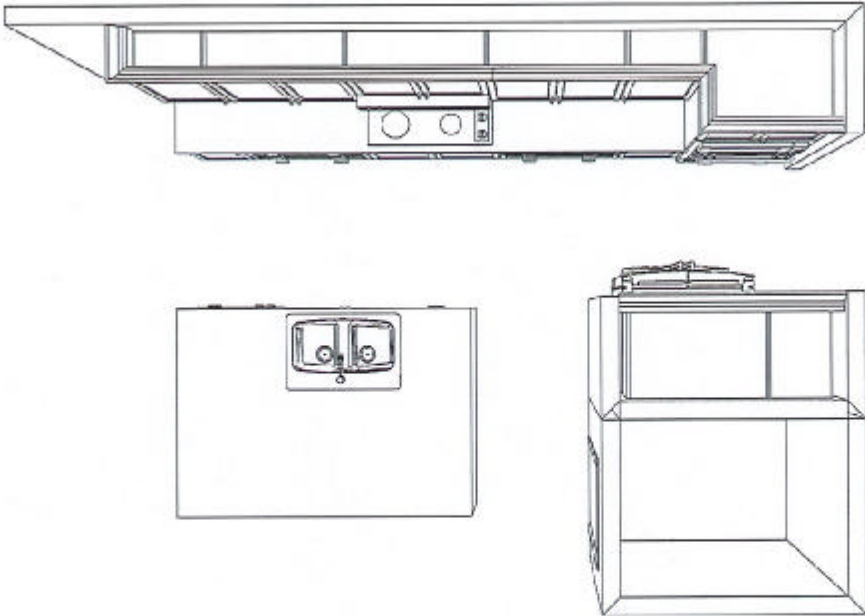

KITCHEN - TOP VIEW


CUSTOMER APPROVAL

I have reviewed these drawings and understand the details of the design and the CARTIER KITCHENS specifications.

Signature_____

Date_____

Note: This drawing is an artistic interpretation of the general appearance of the design. It is not meant to be an exact rendition.		Designed: 2021-12-03
		Printed: 2021-12-22
DCR - 318 PWYS 2 - Rutherford .kit		Drawing #: 1

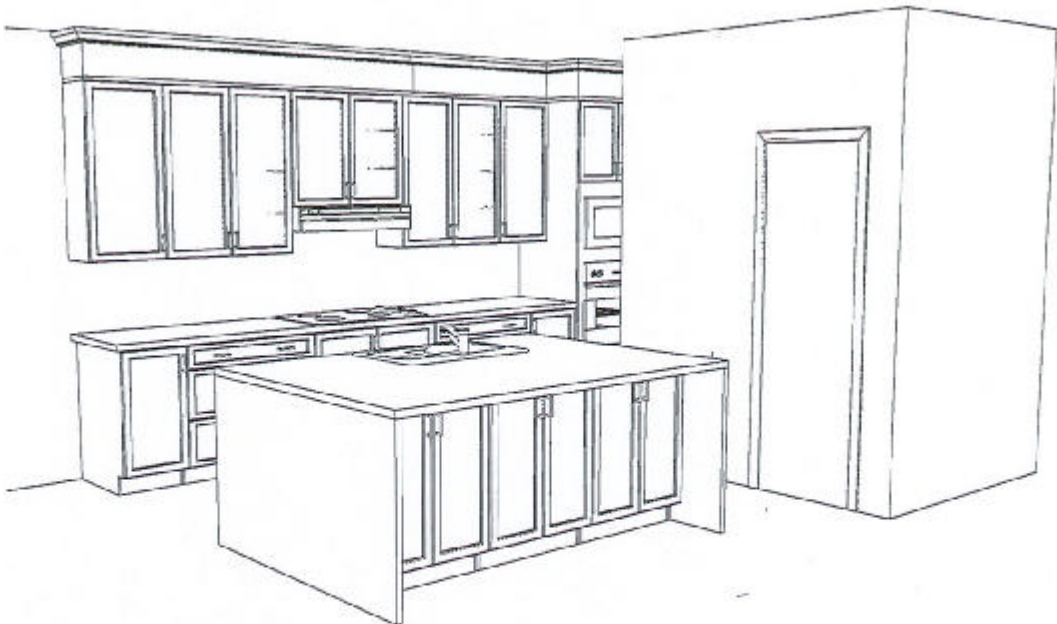


KITCHEN - 3D VIEW #1

CUSTOMER APPROVAL I have reviewed these drawings and understand the details of the design and the GARTIER KITCHENS specifications. Signature _____ Date _____
--

Note: This drawing is an artistic interpretation of the general appearance of the design. It is not meant to be an exact rendition.



Designed: 2021-12-03
Printed: 2021-12-22

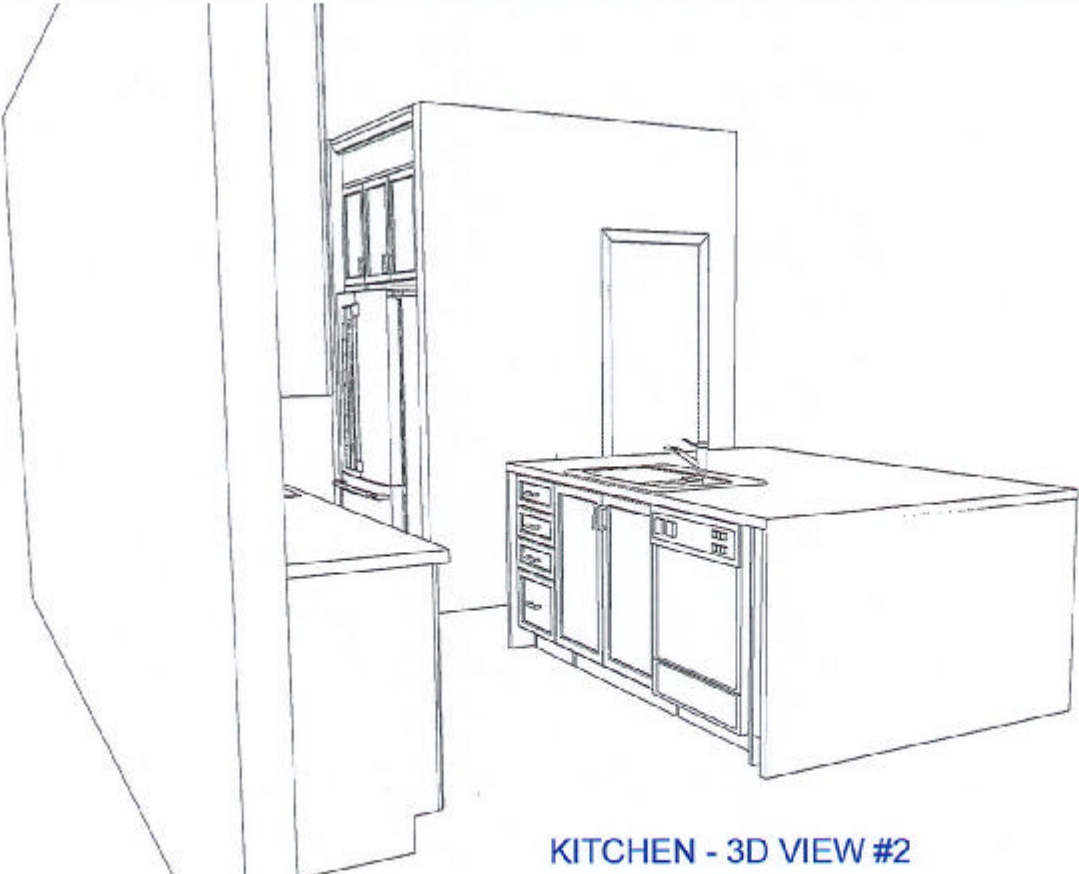

KITCHEN - 3D VIEW #2

CUSTOMER APPROVAL

I have reviewed these drawings and understand the details of the design and the CARTIER KITCHENS specifications.

Signature _____

Date _____

Note: This drawing is an artistic interpretation of the general appearance of the design. It is not meant to be an exact rendition.




Designed: 2021-12-03
Printed: 2021-12-22

DCR - 318 PWYS 2 - Rutherford .kit

All

Drawing #: 1

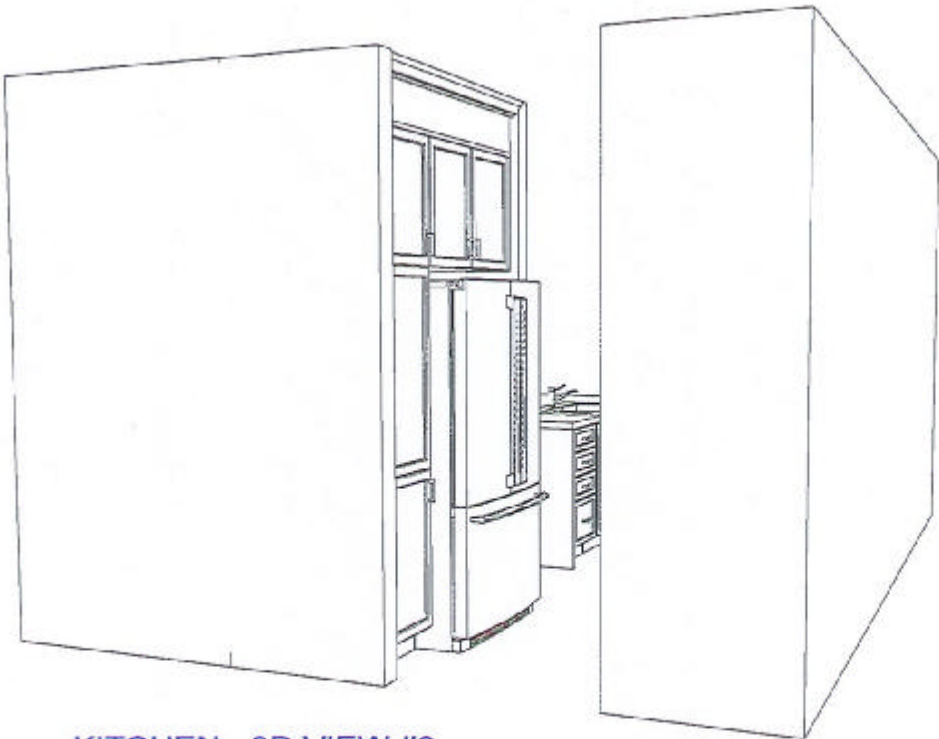

KITCHEN - 3D VIEW #3

CUSTOMER APPROVAL	
I have reviewed these drawings and understand the details of the design and the CARTIER KITCHENS specifications.	
Signature _____	
Date _____	


Note: This drawing is an artistic interpretation of the general appearance of the design. It is not meant to be an exact rendition.		Designed: 2021-12-03
		Printed: 2021-12-22
DCR - 318 PWYS 2 - Rutherford .kit	All	Drawing #: 1

DS

Sk

DS

Sk

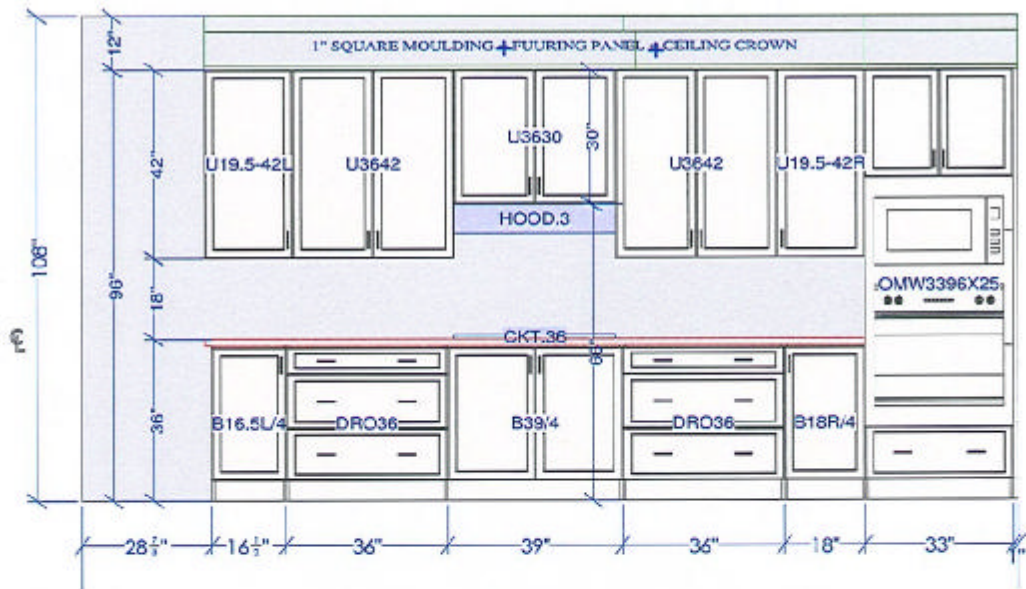

COOKTOP / OVEN WALL ELEVATION

CUSTOMER APPROVAL

I have reviewed these drawings and understand the details of the design and the CARTIER KITCHENS specifications.

Signature _____


Date _____

All dimensions ,size designations given are subject to verification on job site and adjustment to fit job conditions.



This is an original design and must not be released or copied unless applicable fee has been paid or job order placed.

Designed: 2021-12-03
Printed: 2021-12-22

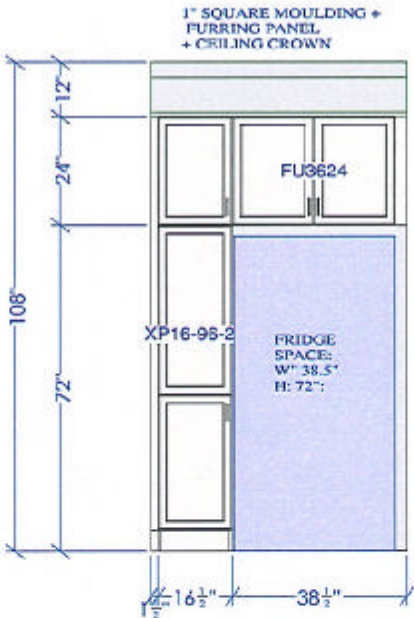

FRIDGE WALL ELEVATION

CUSTOMER APPROVAL

I have reviewed these drawings and understand the details of the design and the CARTER KITCHENS specifications.

Signature: _____

Date: _____

All dimensions ,size designations given are subject to verification on job site and adjustment to fit job conditions.



This is an original design and must not be released or copied unless applicable fee has been paid or job order placed.

Designed: 2021-12-03
Printed: 2021-12-22