


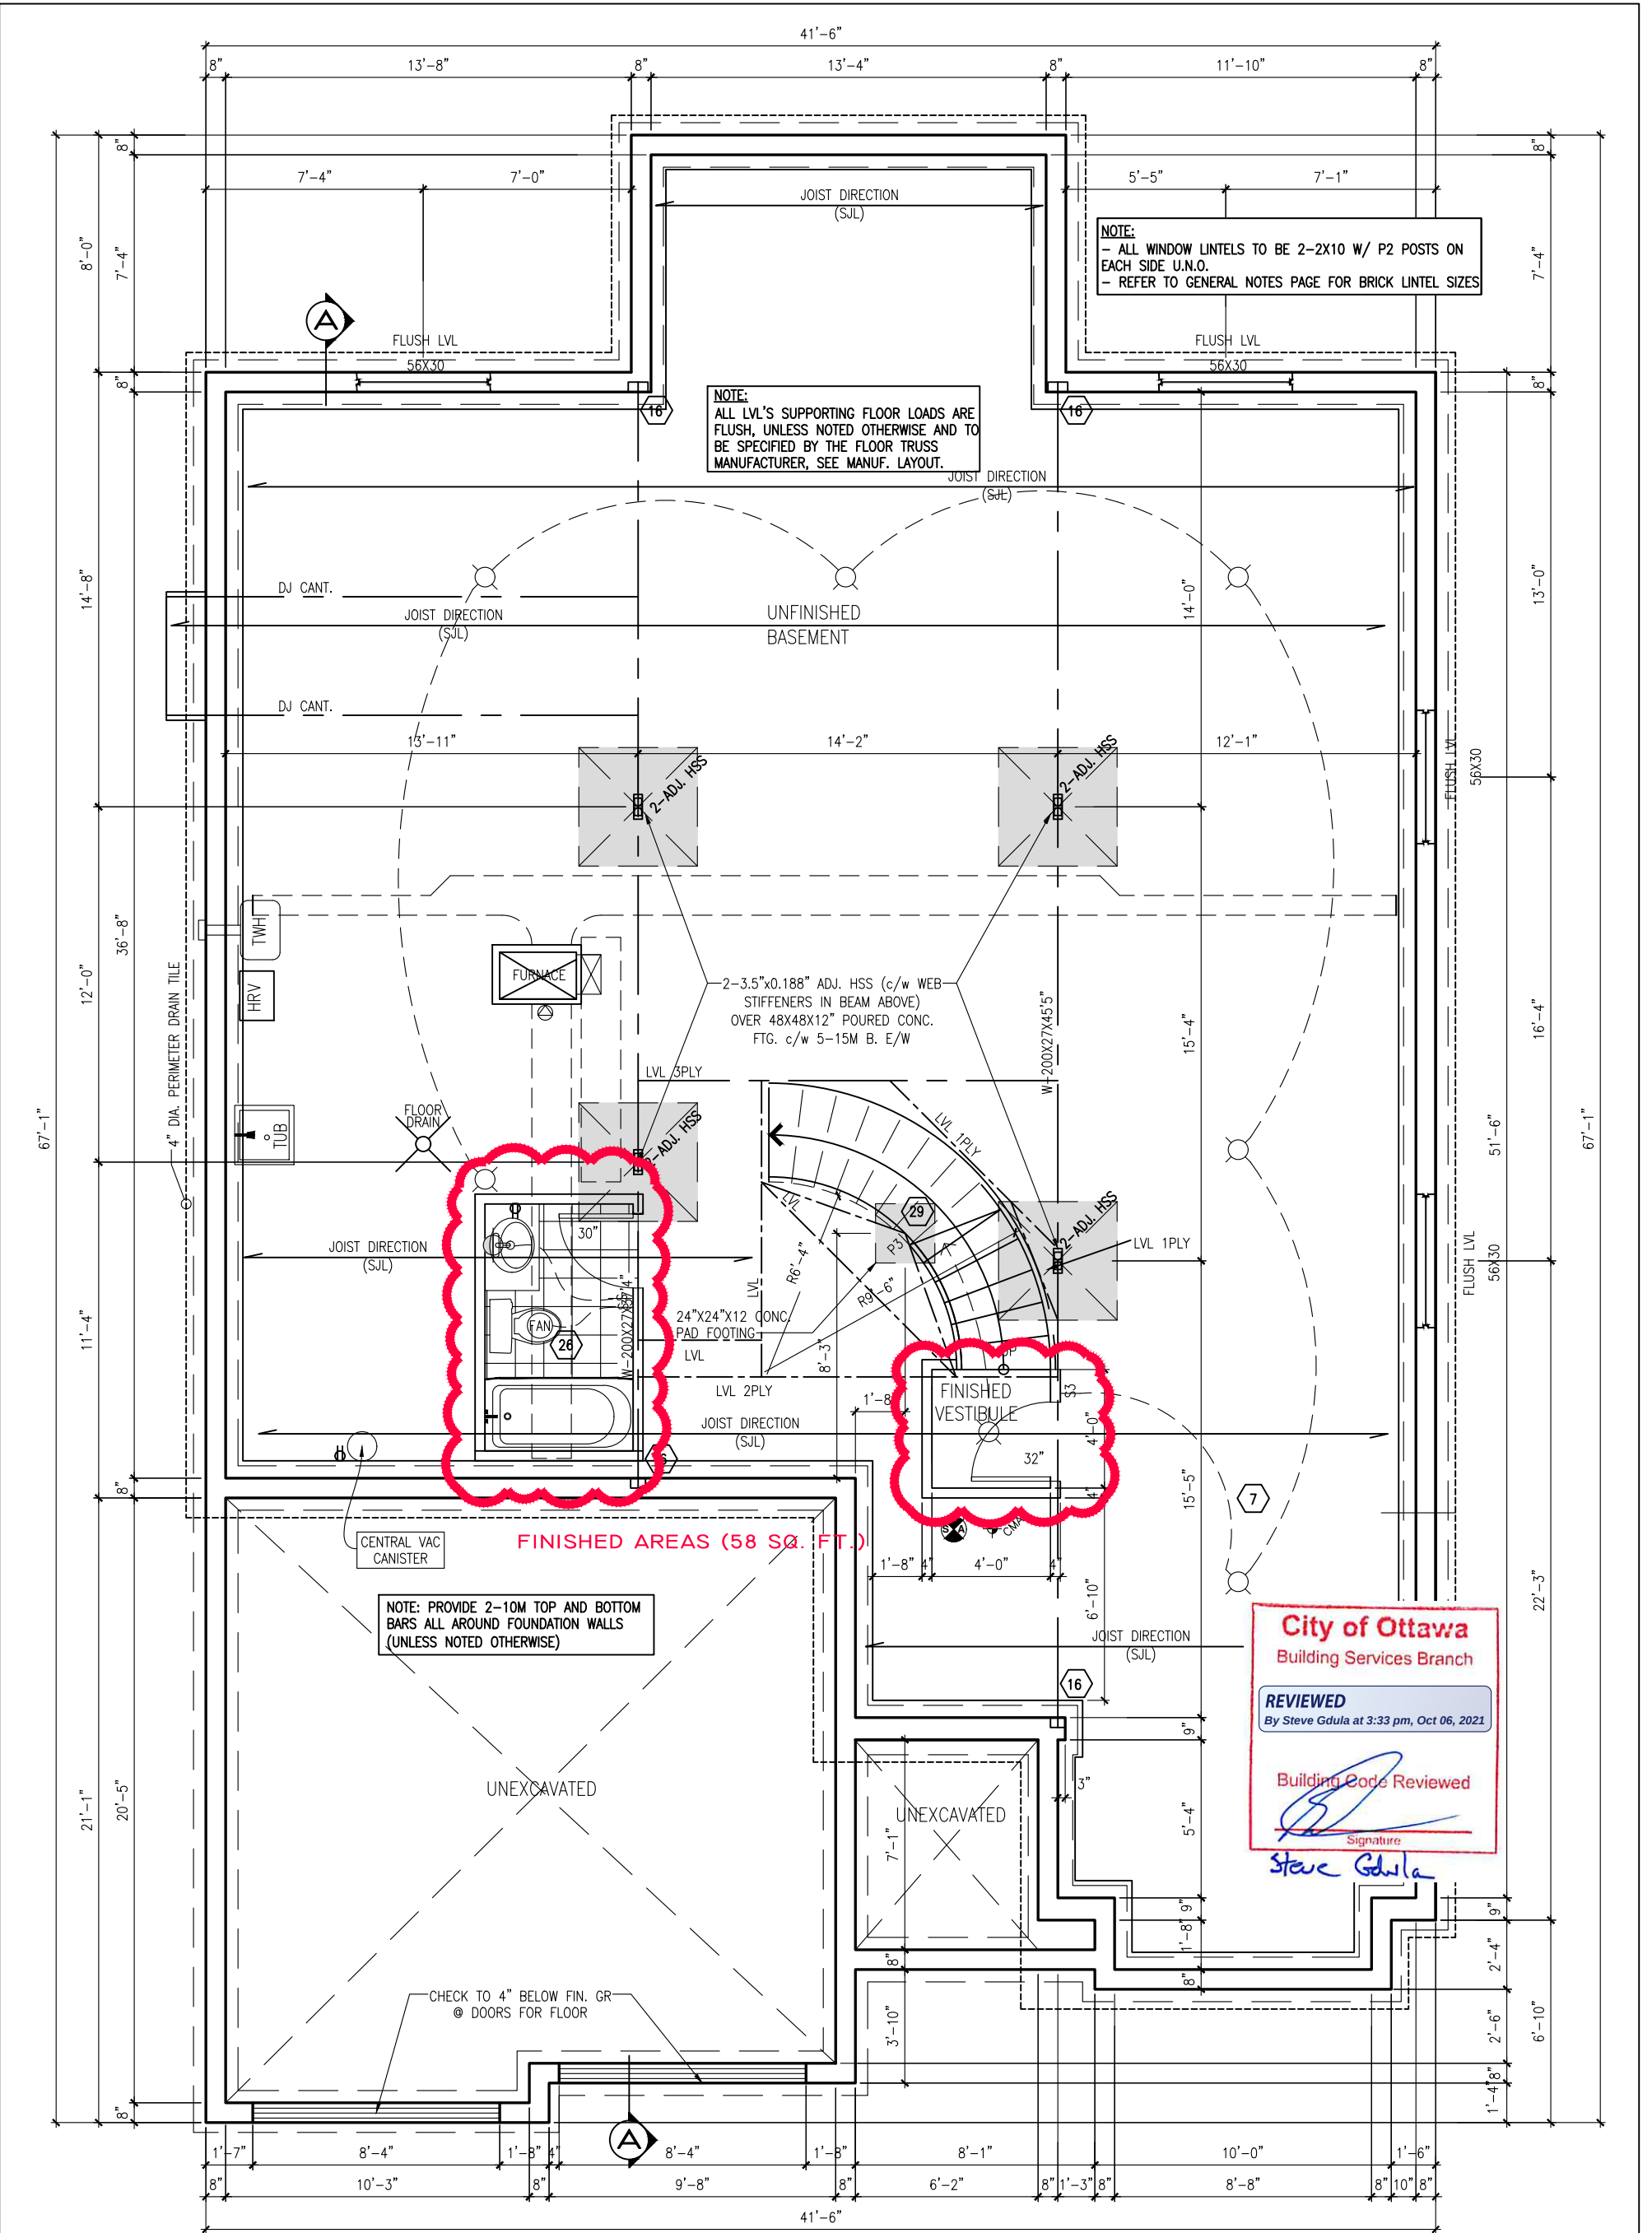

BASEMENT FLOOR PLAN EL. E 58 sq. ft.



ANNAPOLIS-2019-A,B,E,F

SITE:PATHWAYS PH2

LOT NUMBER: 308

CIVIC ADDRESS:
31 DUN SKIPPER DRIVE

8	FOR BUILDING PERMIT	SEP-24-21	SP
7	BEP BLACKLINES	SEP-17-21	GK
6	STRUCTURAL REVIEW	JUN-25-19	SP
5	ADD GARAGE WALL HEIGHTS	SEP-20-18	SP
No.	Description	Date	By
REVISIONS			

file number: 509

drawn by: T.L.


date: DEC. 2012

scale: 3/16"=1'

DCL-192
sheet no:

2

9

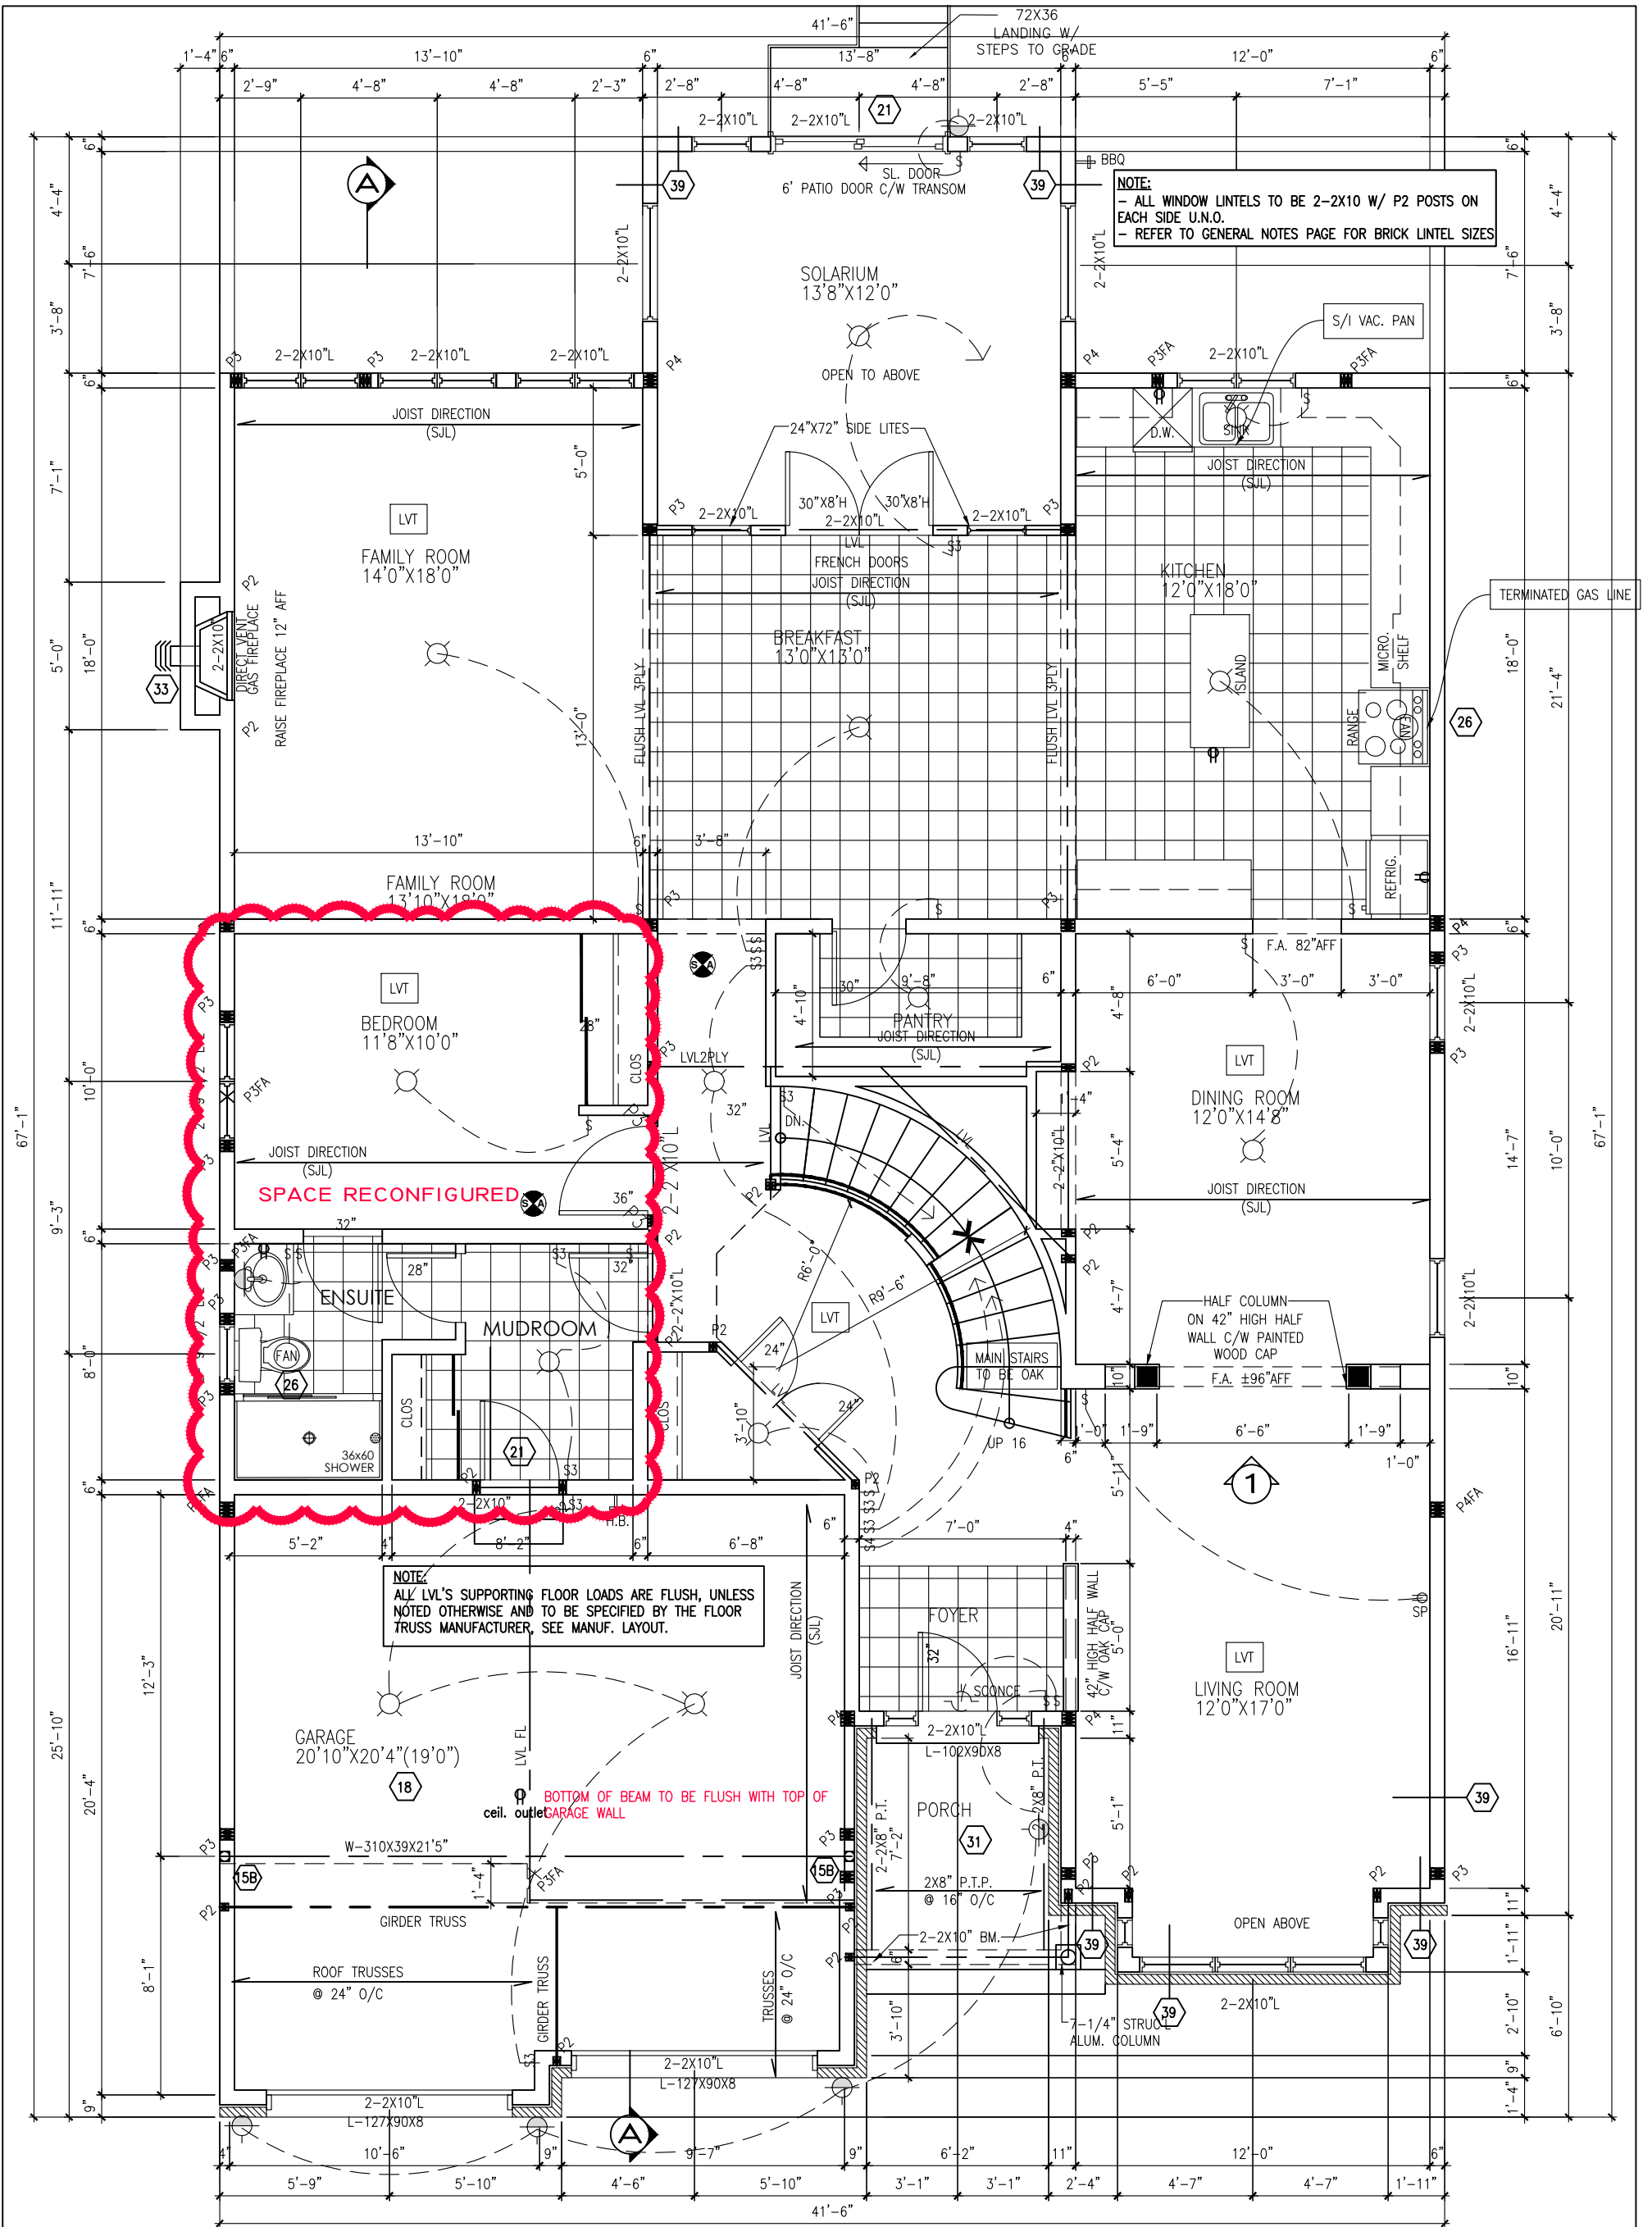


MAIN FLOOR PLAN ELEV. E - 1958 SF



ANNAPOLIS-2019-E	
SITE:PATHWAYS PH2	
LOT NUMBER:	308
CIVIC ADDRESS: 31 DUN SKIPPER DRIVE	

8	FOR BUILDING PERMIT	SEP-24-21	SP
7	BEP BLACKLINES	SEP-17-21	GK
6	STRUCTURAL REVIEW	JUN-25-19	SP
5	ADD GARAGE WALL HEIGHTS	SEP-20-18	SP
No.	Description	Date	By
REVISIONS			

file number: 509	
drawn by: T.L.	
date: DEC. 2012	
scale: 3/16"=1'	
DCL-192 sheet no:	3E 9
15	

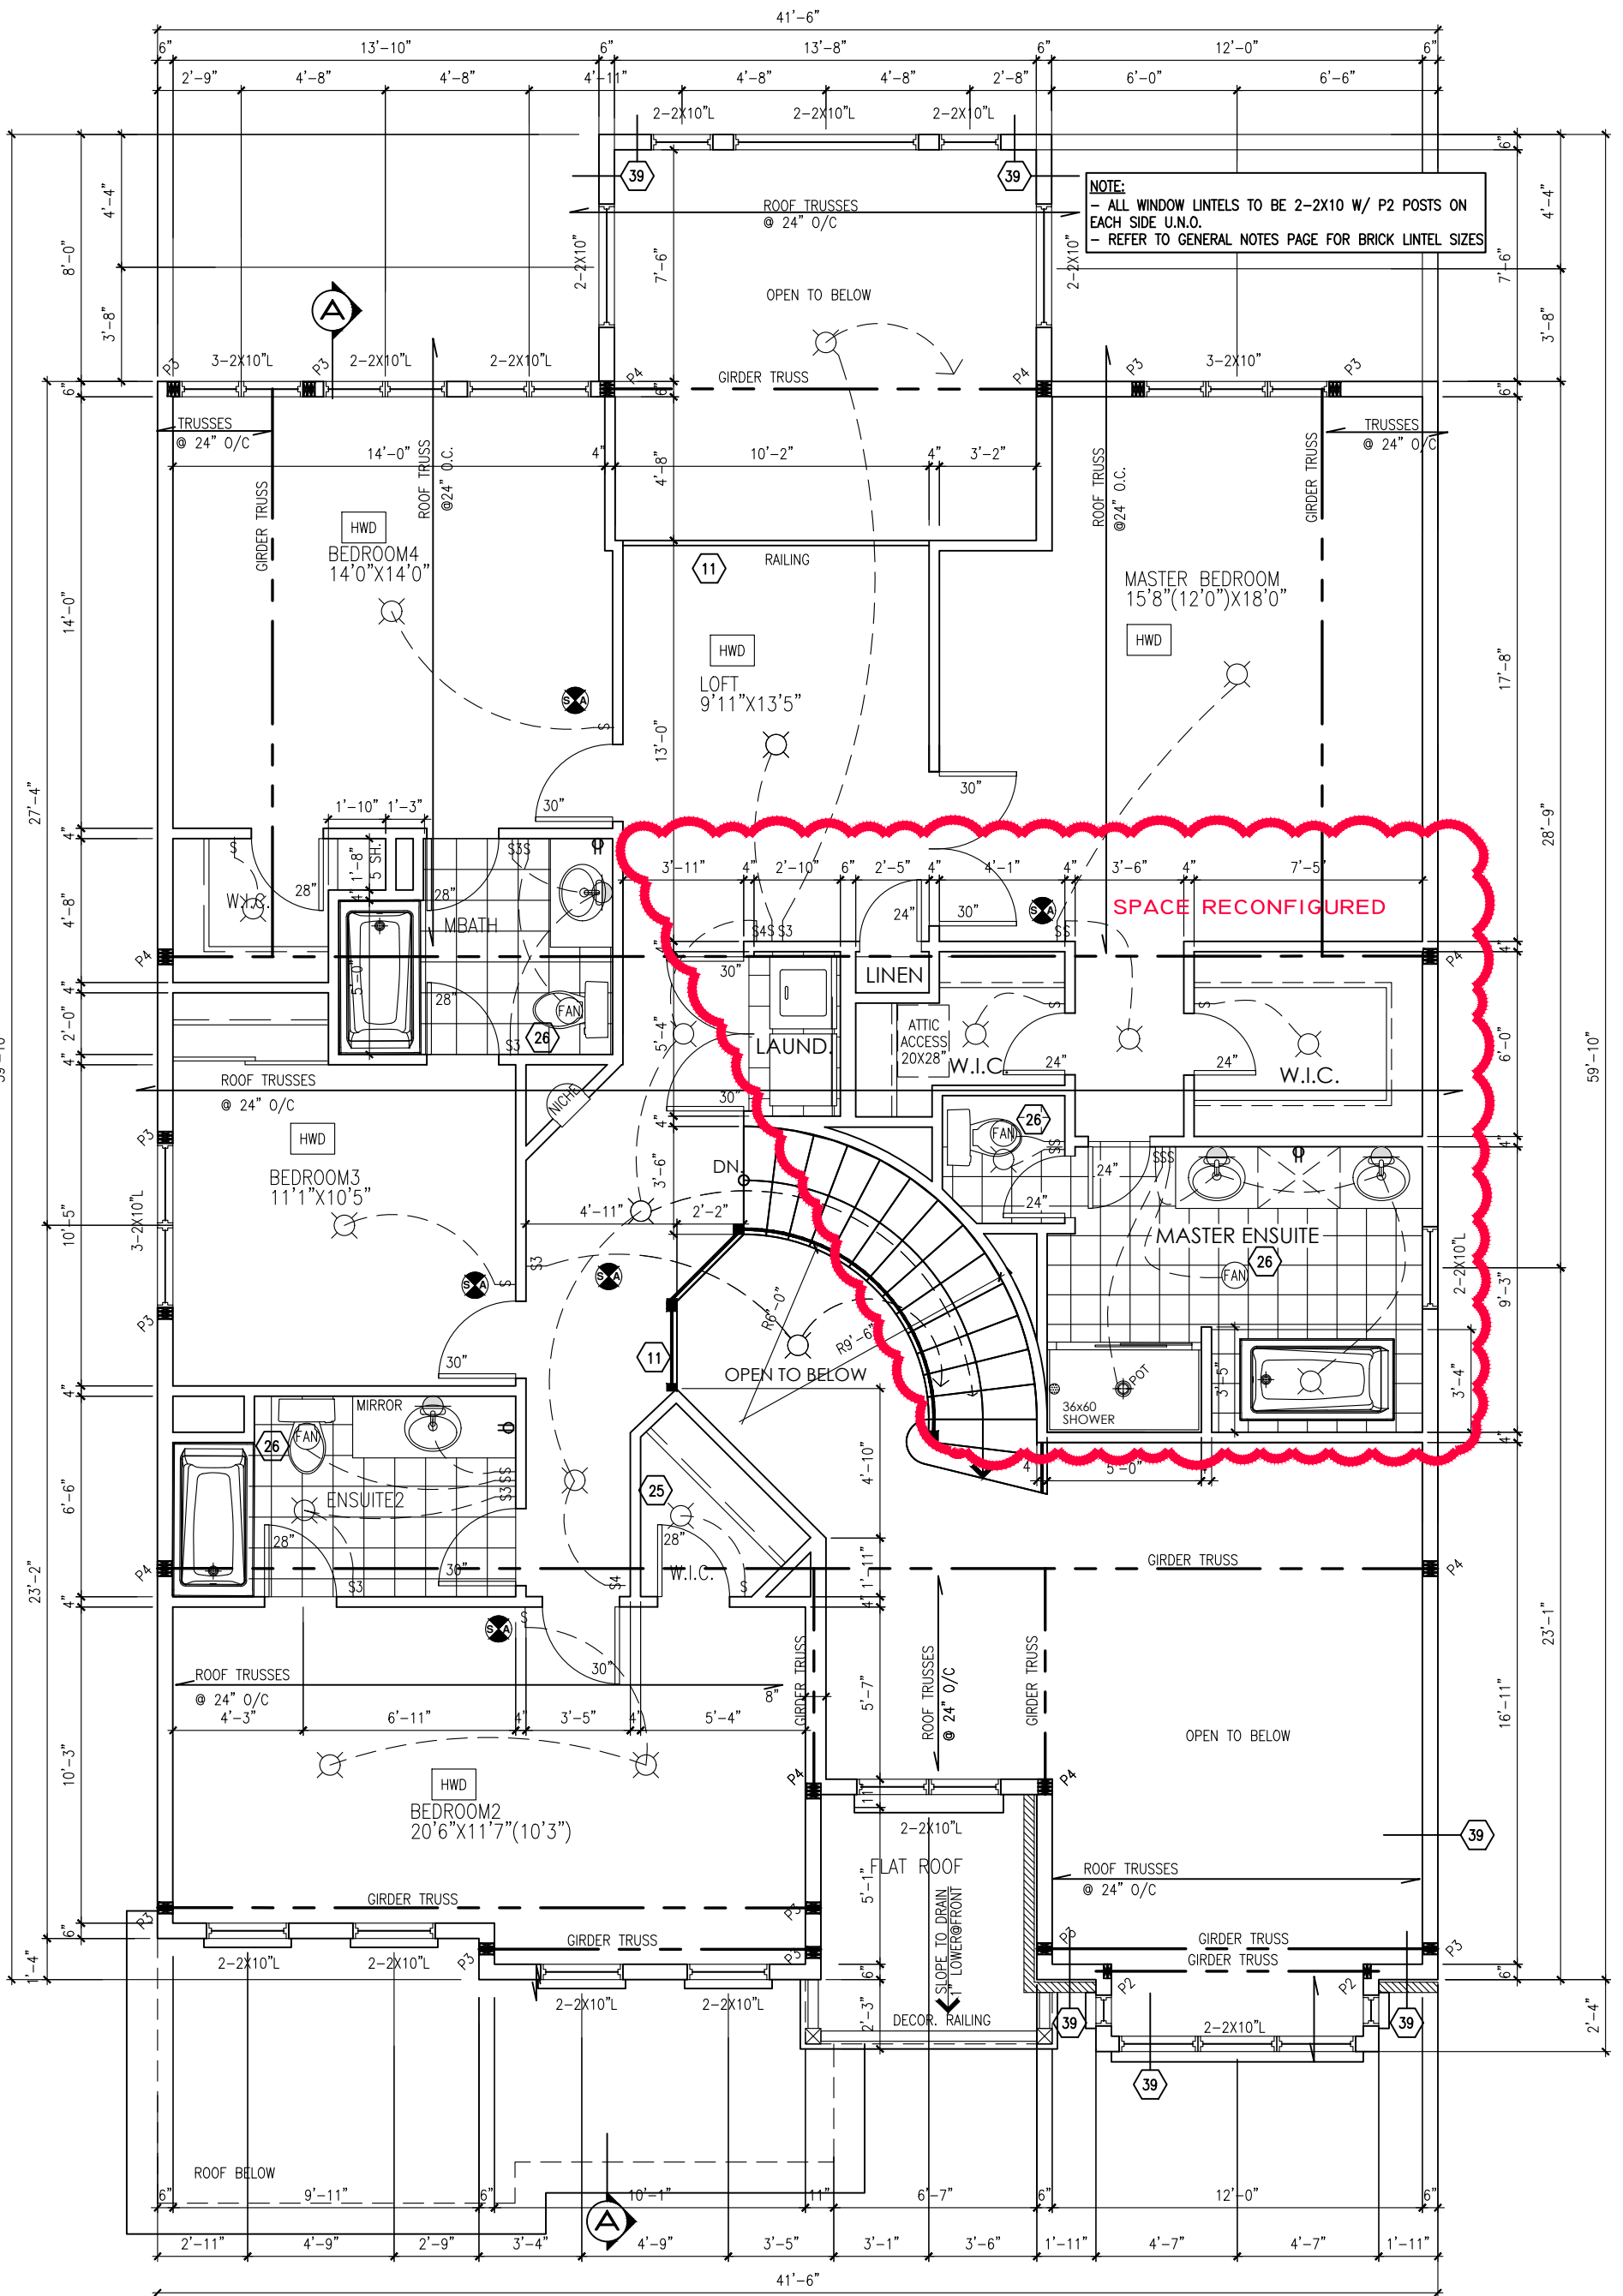

SECOND FLOOR PLAN ELEV. E - 1672 SF

9' SECOND FLOOR



ANNAPOLIS-2019-E

SITE:PATHWAYS PH2

LOT NUMBER: 308

CIVIC ADDRESS:
31 DUN SKIPPER DRIVE

8	FOR BUILDING PERMIT	SEP-24-21	SP
7	BEP BLACKLINES	SEP-17-21	GK
6	STRUCTURAL REVIEW	JUN-25-19	SP
5	ADD GARAGE WALL HEIGHTS	SEP-20-18	SP
No. Description		Date	By
REVISIONS			

file number: 509

drawn by: T.L.

date: DEC. 2012

scale: 3/16"=1'

DCL-192
sheet no:

16

4E
9