

DCR PHOENIX HOMES

LOT #221

PATHWAYS - PHASE 2

MODEL - STRATHMORE

ALTERNATE KITCHEN

GARAGE LEFT

- CABINETS -
- HARDWARE -
- STANDARD WHITE INTERIOR
- STANDARD METAL DRAWER BOX
- 4 PCS - 5/8" KICK - FIN. BOTH ENDS
- 1 PCS - 90 DEG. CORNER MOULD
- 1 PCS - T-MOULD
- 4 PCS - FLAT MOULD

KITCHEN / VANITIES

MOUNTING HEIGHT - 96





42"H. UPPERS @ 18" ABOVE COUNTER
LIGHT VALANCE

CUSTOMER APPROVAL

I have reviewed these drawings and understand the details of the design and the CARTER KITCHENS specifications.

Signature _____

Date _____

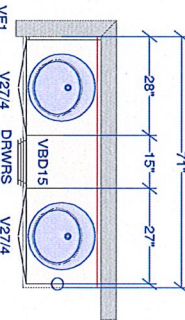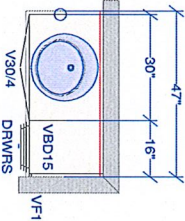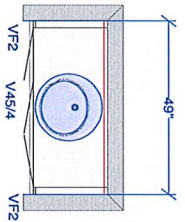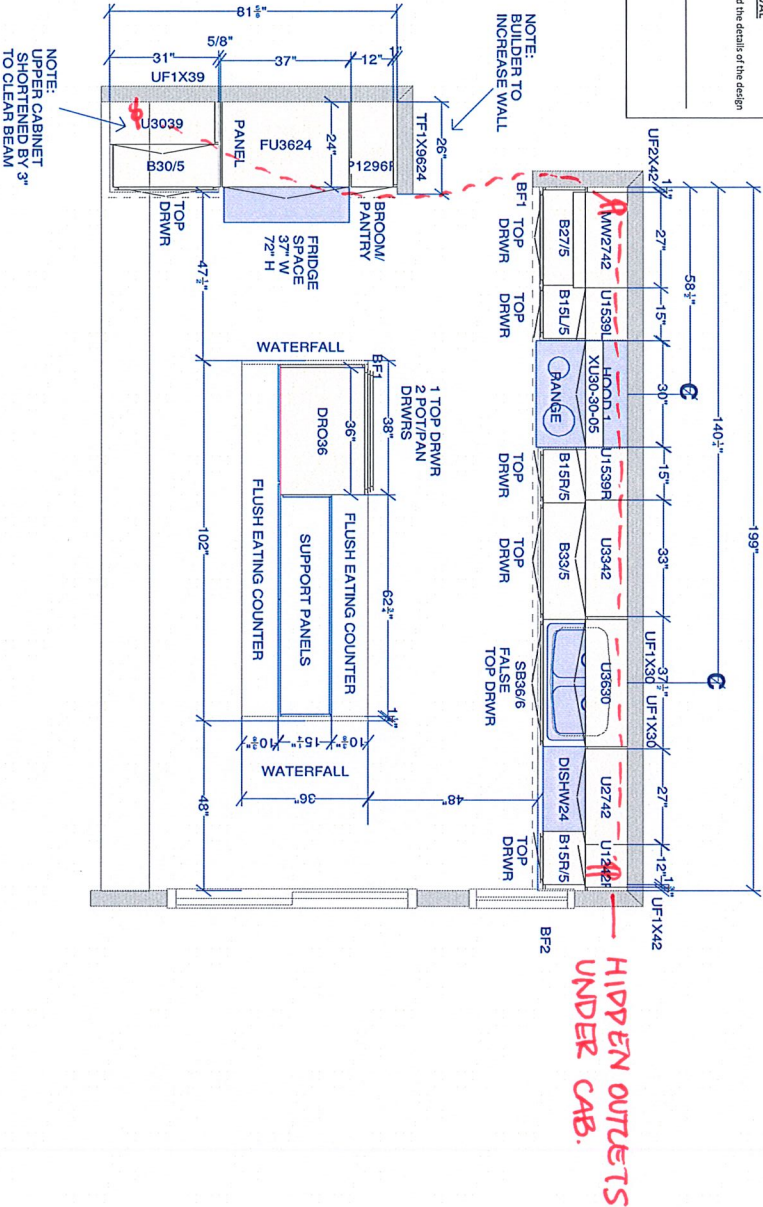

POWDER ROOM

MAIN BATH

ENSUITE

All dimensions, size designations given are subject to verification on job site and adjustment to fit job conditions.



This is an original design and must not be released or copied unless applicable fee has been paid or job order placed.

Designed: 2021-08-26
Printed: 2021-08-27


SPECTRUM KITCHEN and BATH DESIGN

DRAWN BY: LORI DISAVERIO, B.I.D

DCR - #221 PWYS 2 - STRATHMORE Alt Kitchen .(LEFT) kit

All

Drawing #: 1 No Scale.

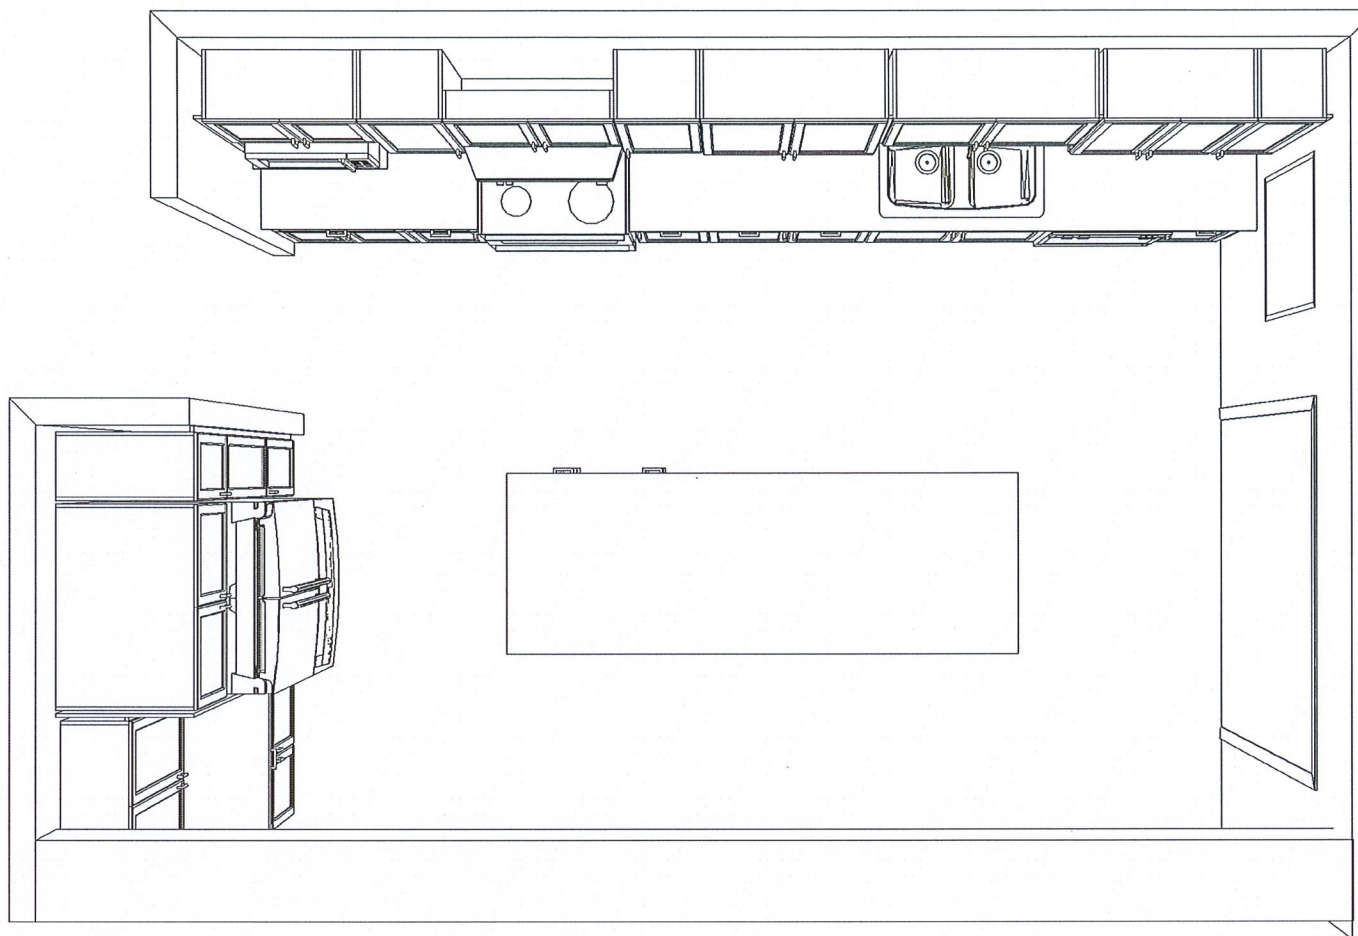

KITCHEN - TOP VIEW

CUSTOMER APPROVAL

I have reviewed these drawings and understand the details of the design and the CARTIER KITCHENS specifications.

Signature _____

Date _____

Note: This drawing is an artistic interpretation of the general appearance of the design. It is not meant to be an exact rendition.

SPECTRUM KITCHEN and BATH
DESIGN




Designed: 2021-08-26
Printed: 2021-08-27

DCR - #221 PWYS 2 - STRATHMORE Alt Kitchen

All

Drawing #: 1

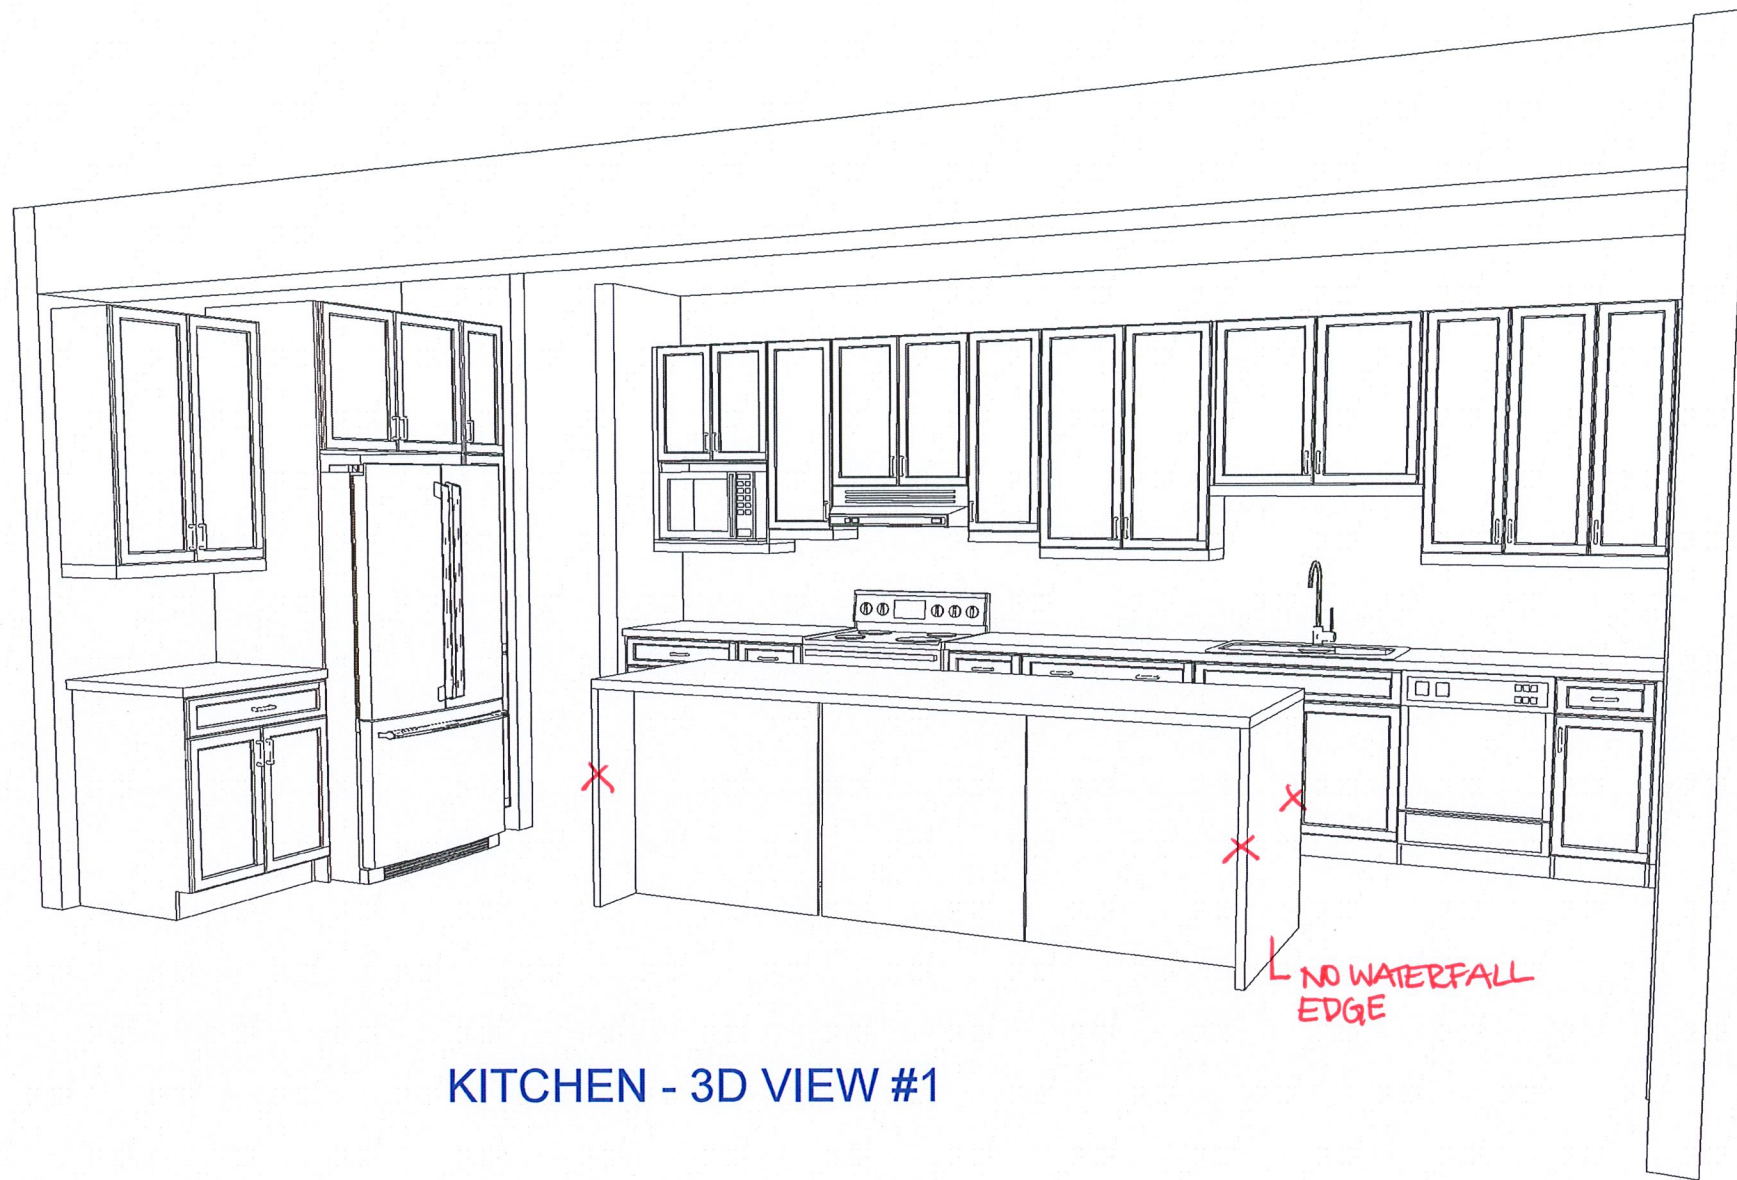

KITCHEN - 3D VIEW #1

CUSTOMER APPROVAL

I have reviewed these drawings and understand the details of the design and the CARTIER KITCHENS specifications.

Signature _____

Date _____

Note: This drawing is an artistic interpretation of the general appearance of the design. It is not meant to be an exact rendition.

SPECTRUM KITCHEN and BATH DESIGN


DCR - #221 PWYS 2 - STRATHMORE Alt Kitchen



Designed: 2021-08-26
Printed: 2021-08-27

All

Drawing #: 1

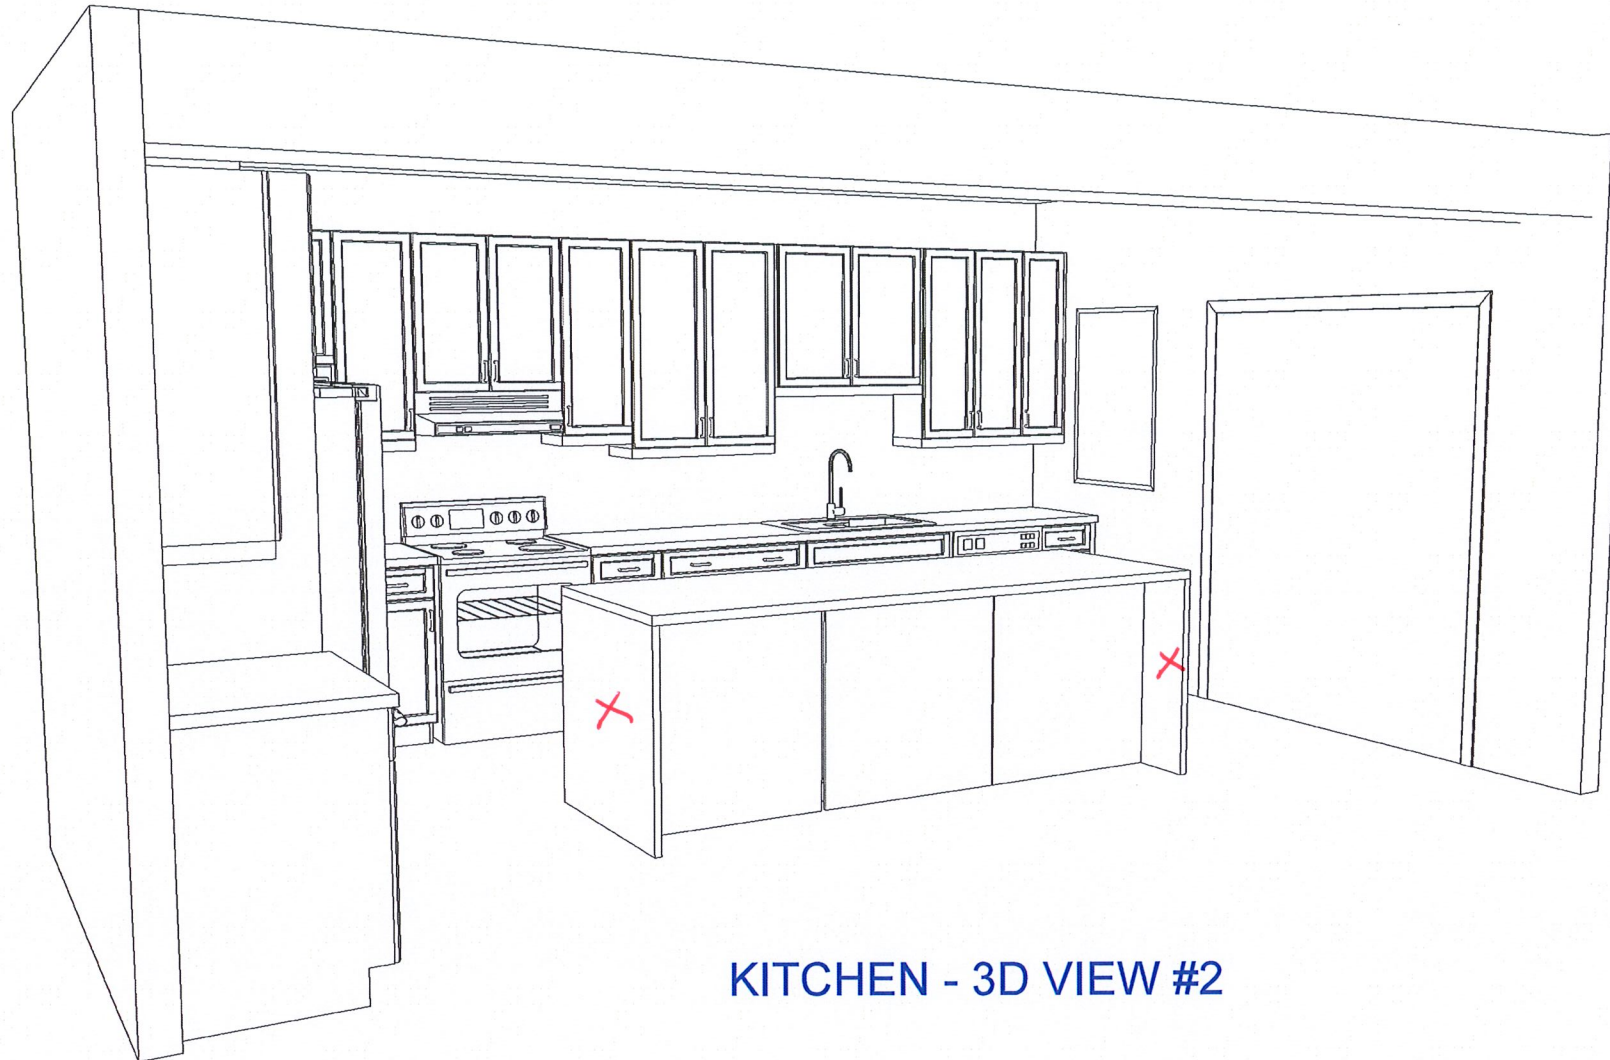

KITCHEN - 3D VIEW #2

CUSTOMER APPROVAL

I have reviewed these drawings and understand the details of the design and the CARTIER KITCHENS specifications.

Signature _____

Date _____

Note: This drawing is an artistic interpretation of the general appearance of the design. It is not meant to be an exact rendition.

SPECTRUM KITCHEN and BATH DESIGN





Designed: 2021-08-26
Printed: 2021-08-27

DCR - #221 PWYS 2 - STRATHMORE Alt Kitchen

All

Drawing #: 1

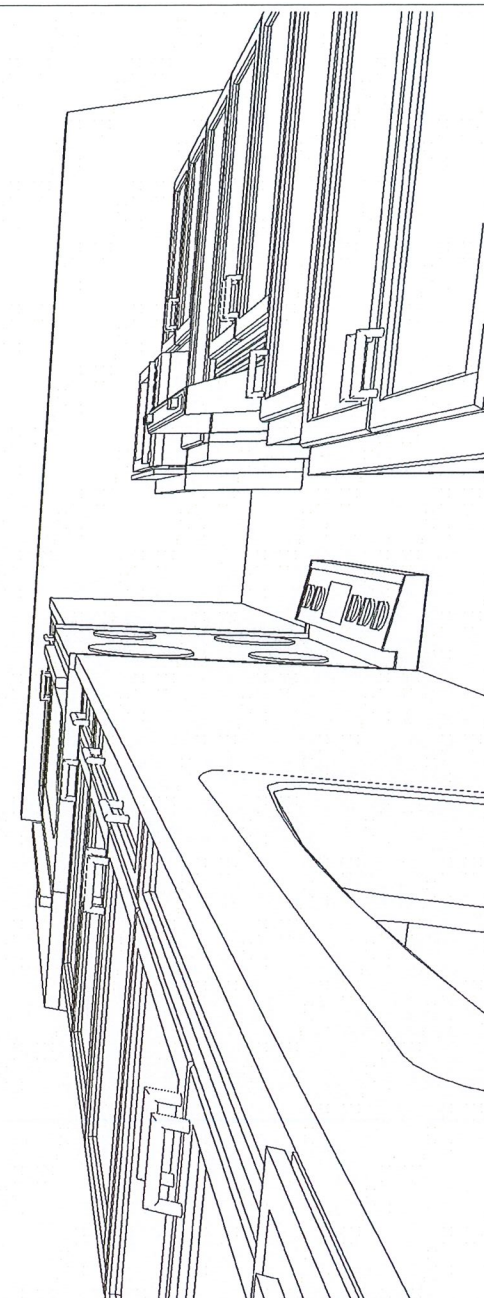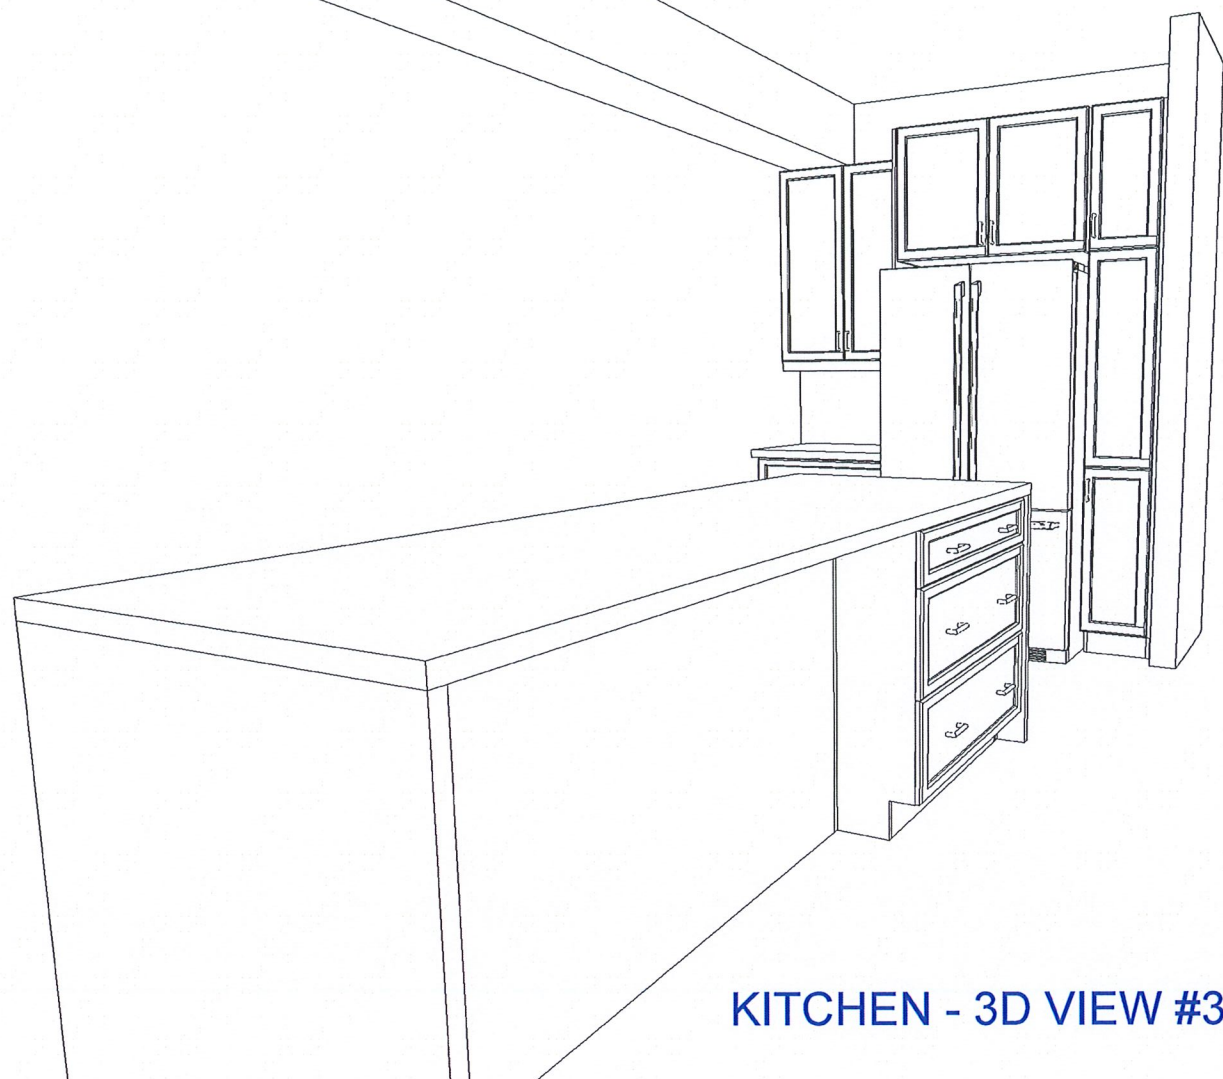

KITCHEN - 3D VIEW #3

CUSTOMER APPROVAL

I have reviewed these drawings and understand the details of the design and the CARTIER KITCHENS specifications.

Signature _____

Date _____

Note: This drawing is an artistic interpretation of the general appearance of the design. It is not meant to be an exact rendition.

SPECTRUM KITCHEN and BATH DESIGN




Designed: 2021-08-26
Printed: 2021-08-27

DCR - #221 PWYS 2 - STRATHMORE Alt Kitchen

All

Drawing #: 1

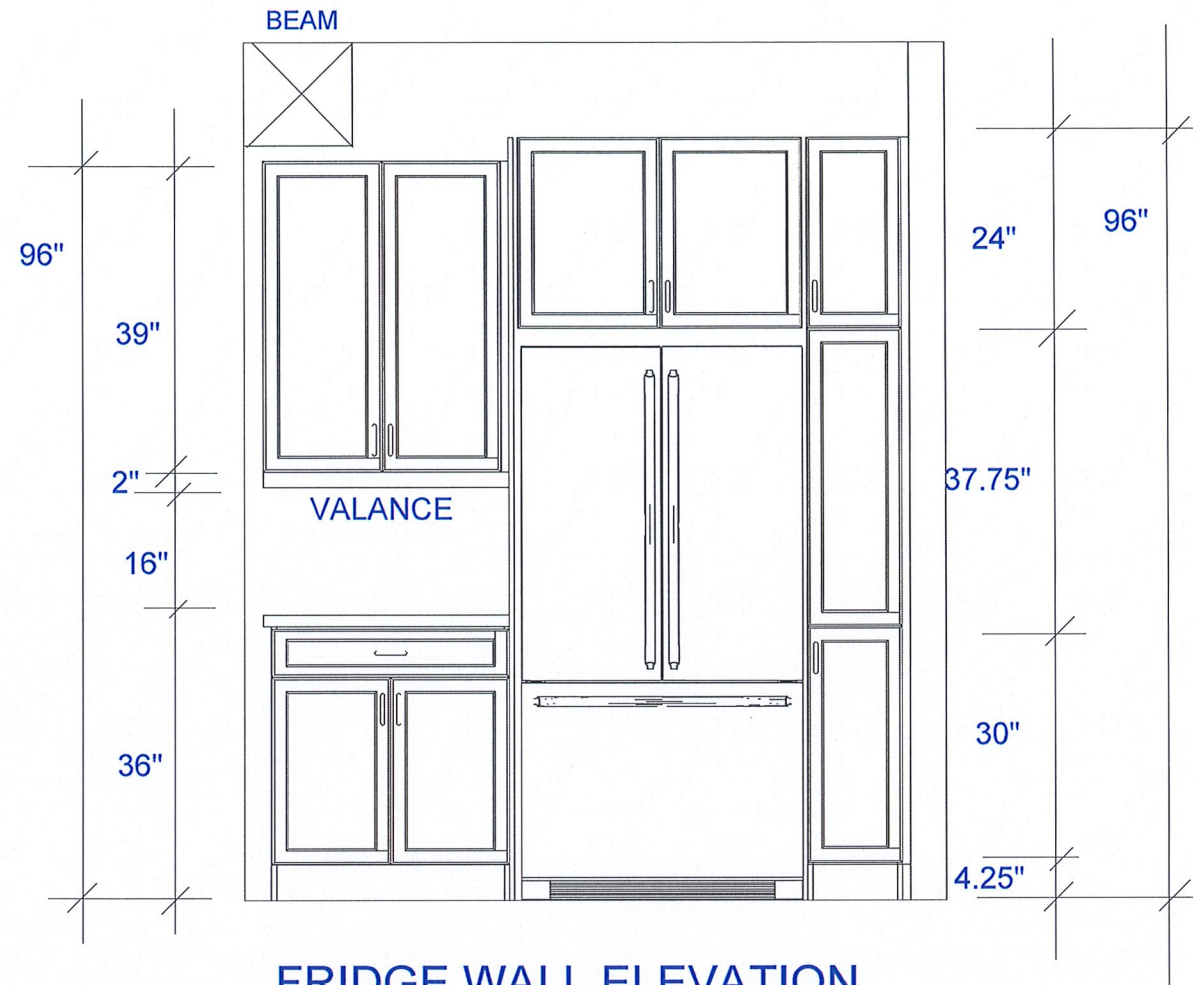

FRIDGE WALL ELEVATION

CUSTOMER APPROVAL

I have reviewed these drawings and understand the details of the design and the CARTIER KITCHENS specifications.

Signature _____

Date _____

Note: This drawing is an artistic interpretation of the general appearance of the design. It is not meant to be an exact rendition.

SPECTRUM KITCHEN and BATH DESIGN




Designed: 2021-08-26
Printed: 2021-08-27

DCR - #221 PWYS 2 - STRATHMORE Alt Kitchen

All

Drawing #: 1

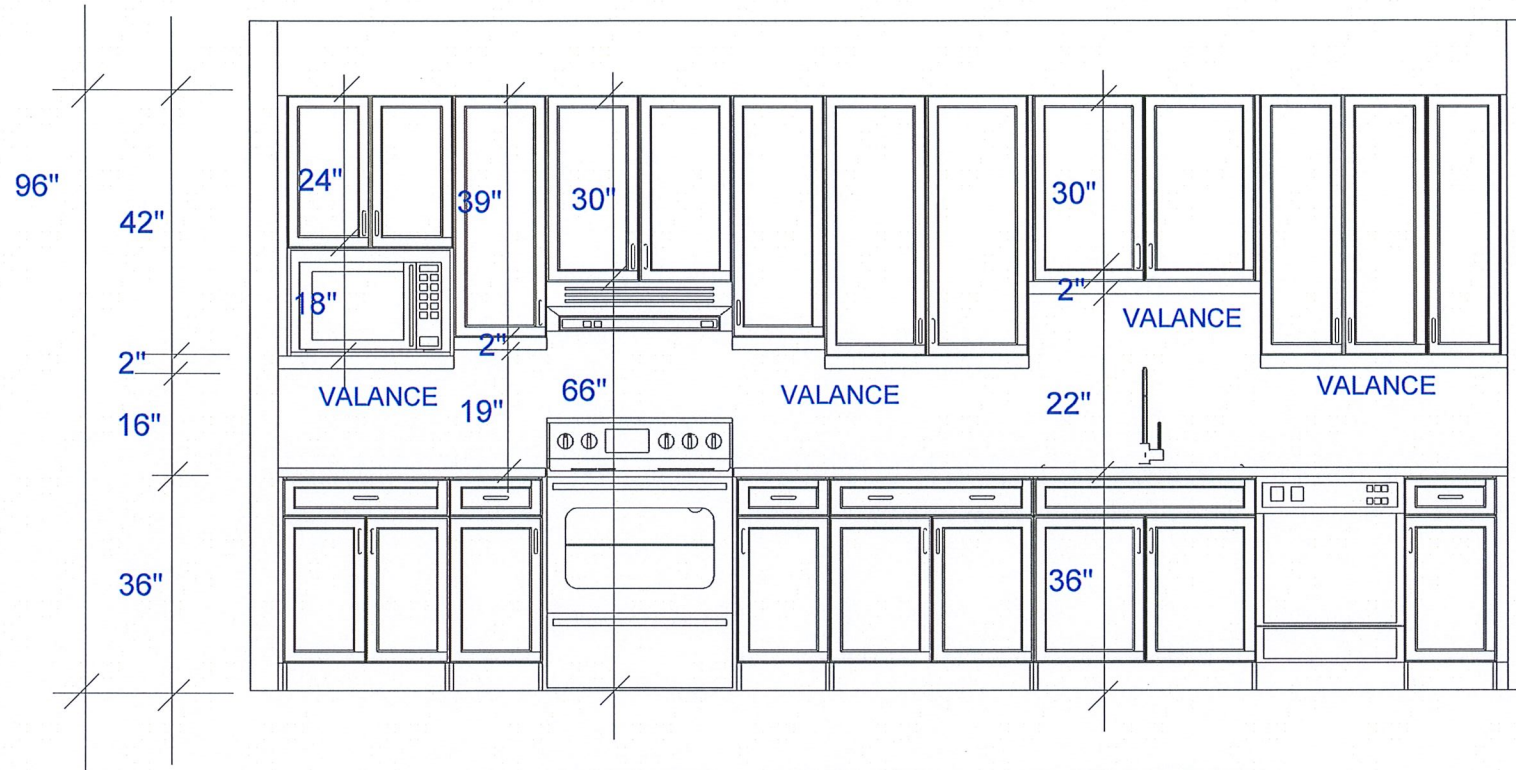

RANGE / SINK WALL ELEVATION

CUSTOMER APPROVAL

I have reviewed these drawings and understand the details of the design and the CARTIER KITCHENS specifications.

Signature _____

Date _____

Note: This drawing is an artistic interpretation of the general appearance of the design. It is not meant to be an exact rendition.

SPECTRUM KITCHEN and BATH DESIGN



Designed: 2021-08-26
Printed: 2021-08-27

DCR - #221 PWYS 2 - STRATHMORE Alt Kitchen

All

Drawing #: 1