



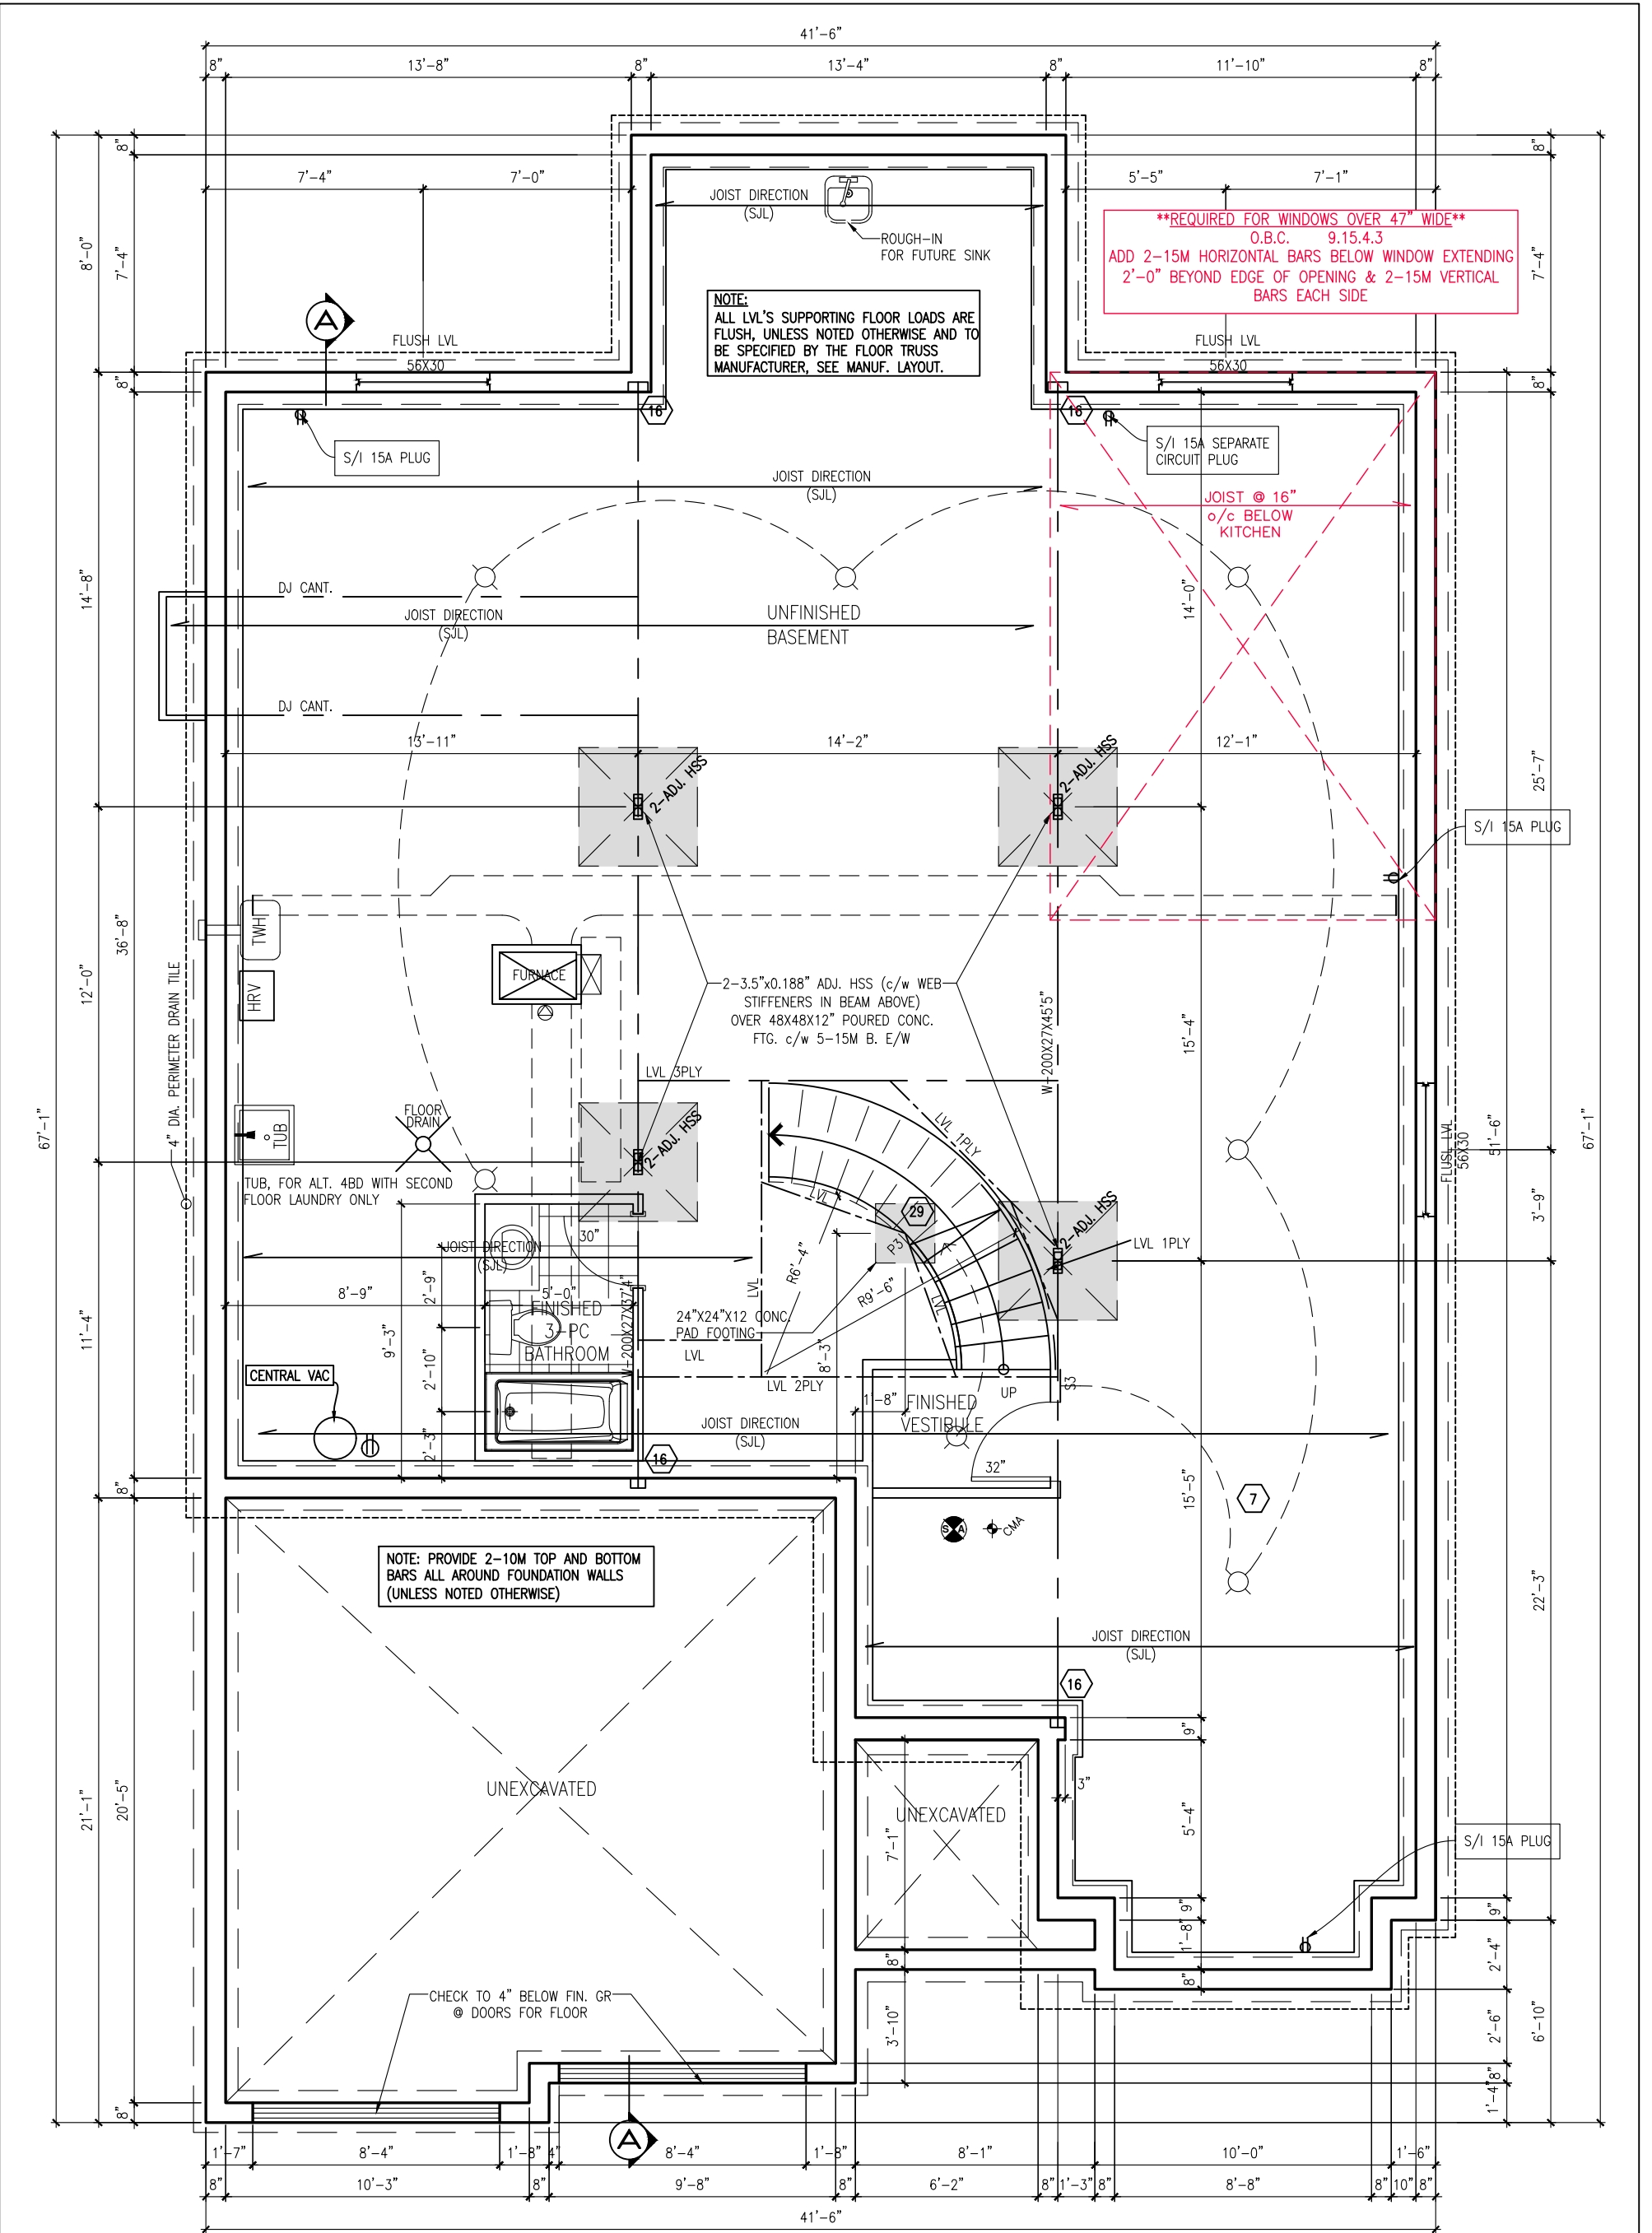

BASEMENT FLOOR PLAN EL. A,B,E,F

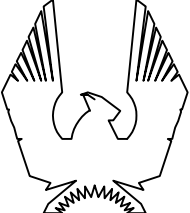

PHOENIX HOMES

ANNAPOLIS-2019-A,B,E,F

SITE:PATHWAYS PH2

LOT NUMBER: 309

CIVIC ADDRESS: 29 DUN SKIPPER DRIVE

11	FRONT DOOR WINDOW GRILL REVISION	JUN-11-22	SP
10	WINDOW REVISION	JUN-11-22	SP
9	FINAL FOR CONSTRUCTION	MAY-18-22	SP
8	FINAL BLACKLINES	JAN-07-22	GK
7	BEP FOR BLACKLINES	OCT-25-21	KE
6	STRUCTURAL REVIEW	JUN-25-19	SP
No.	Description	Date	By
REVISIONS			

file number: 509

drawn by: T.L.


date: DEC. 2012

scale: 3/16"=1'

DCL-192 sheet no:

2

9

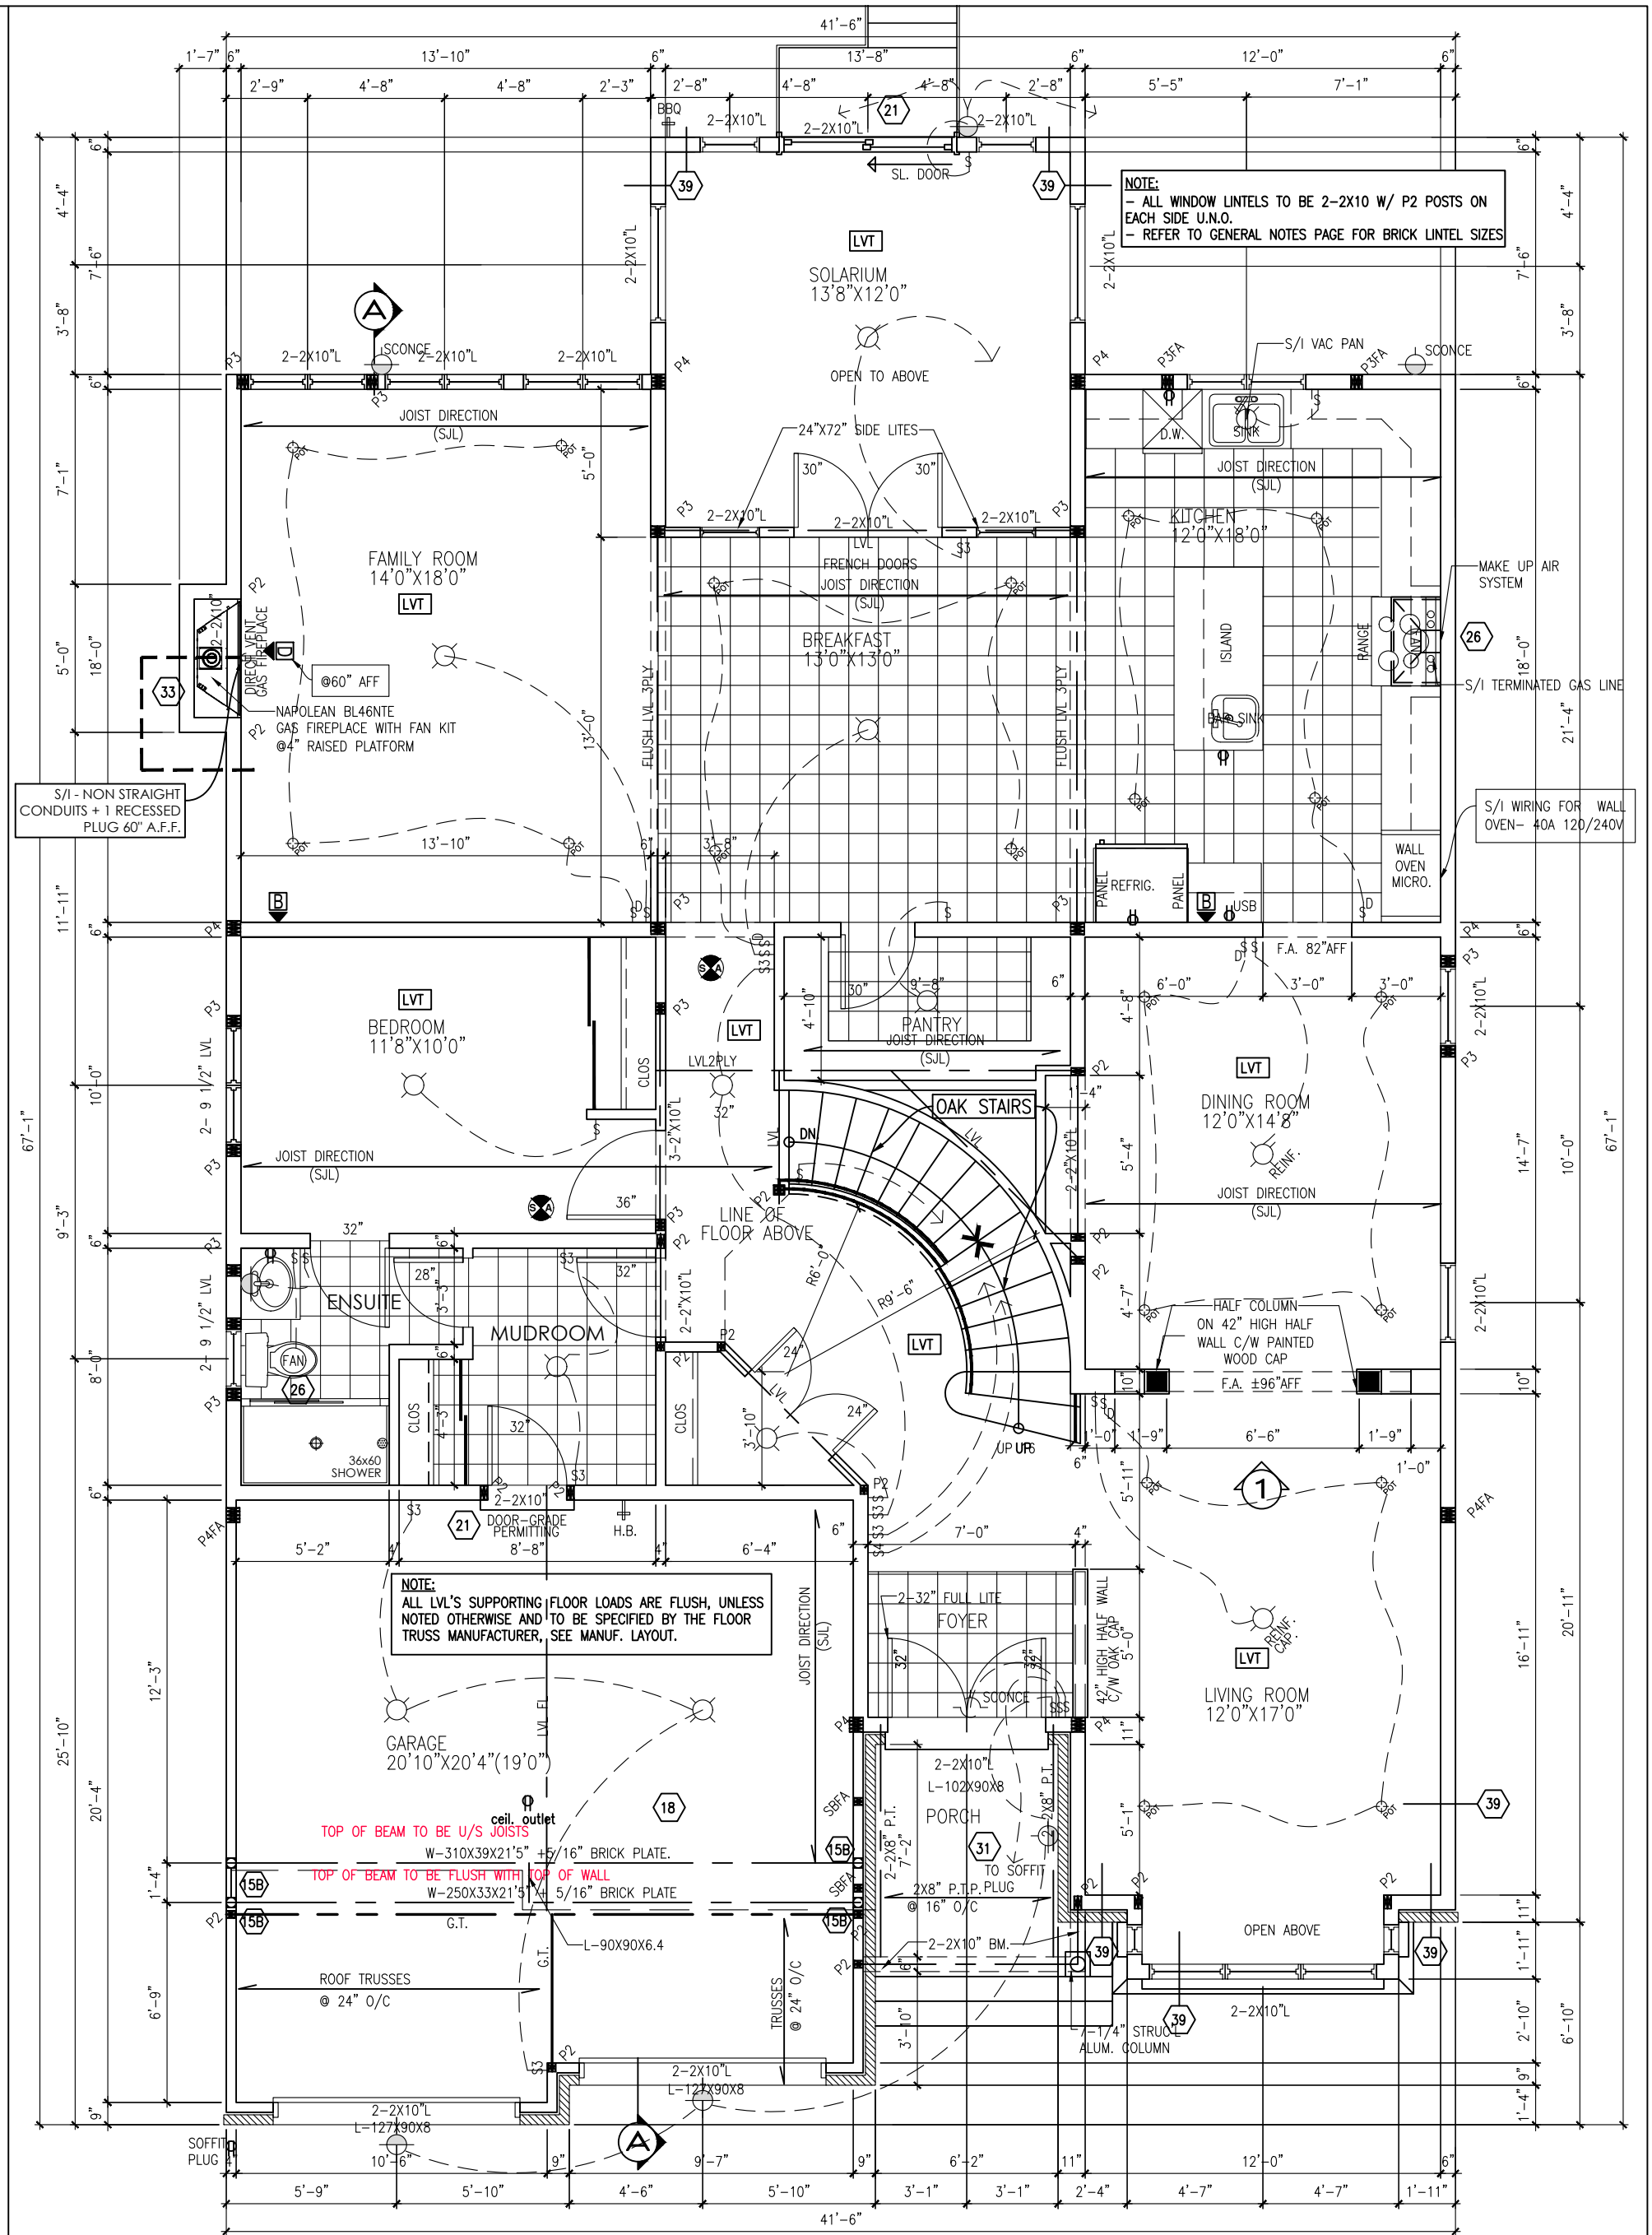

MAIN FLOOR PLAN ELEV. B – 1958 SF



ANNAPOLIS-2019-B

SITE:PATHWAYS PH2

LOT NUMBER:

309

CIVIC ADDRESS:
29 DUN SKIPPER DRIVE

11	FRONT DOOR WINDOW GRILL REVISION	JUN-11-22	SP
10	WINDOW REVISION	JUN-11-22	SP
9	FINAL FOR CONSTRUCTION	MAY-18-22	SP
8	FINAL BLACKLINES	JAN-07-22	GK
7	BEP FOR BLACKLINES	OCT-25-21	KE
6	STRUCTURAL REVIEW	JUN-25-19	SP
No.	Description	Date	By
REVISIONS			

file number: 509

drawn by: T.L.


date: DEC. 2012

scale: 3/16"=1'

DCL-192
sheet no:

10

3B
9

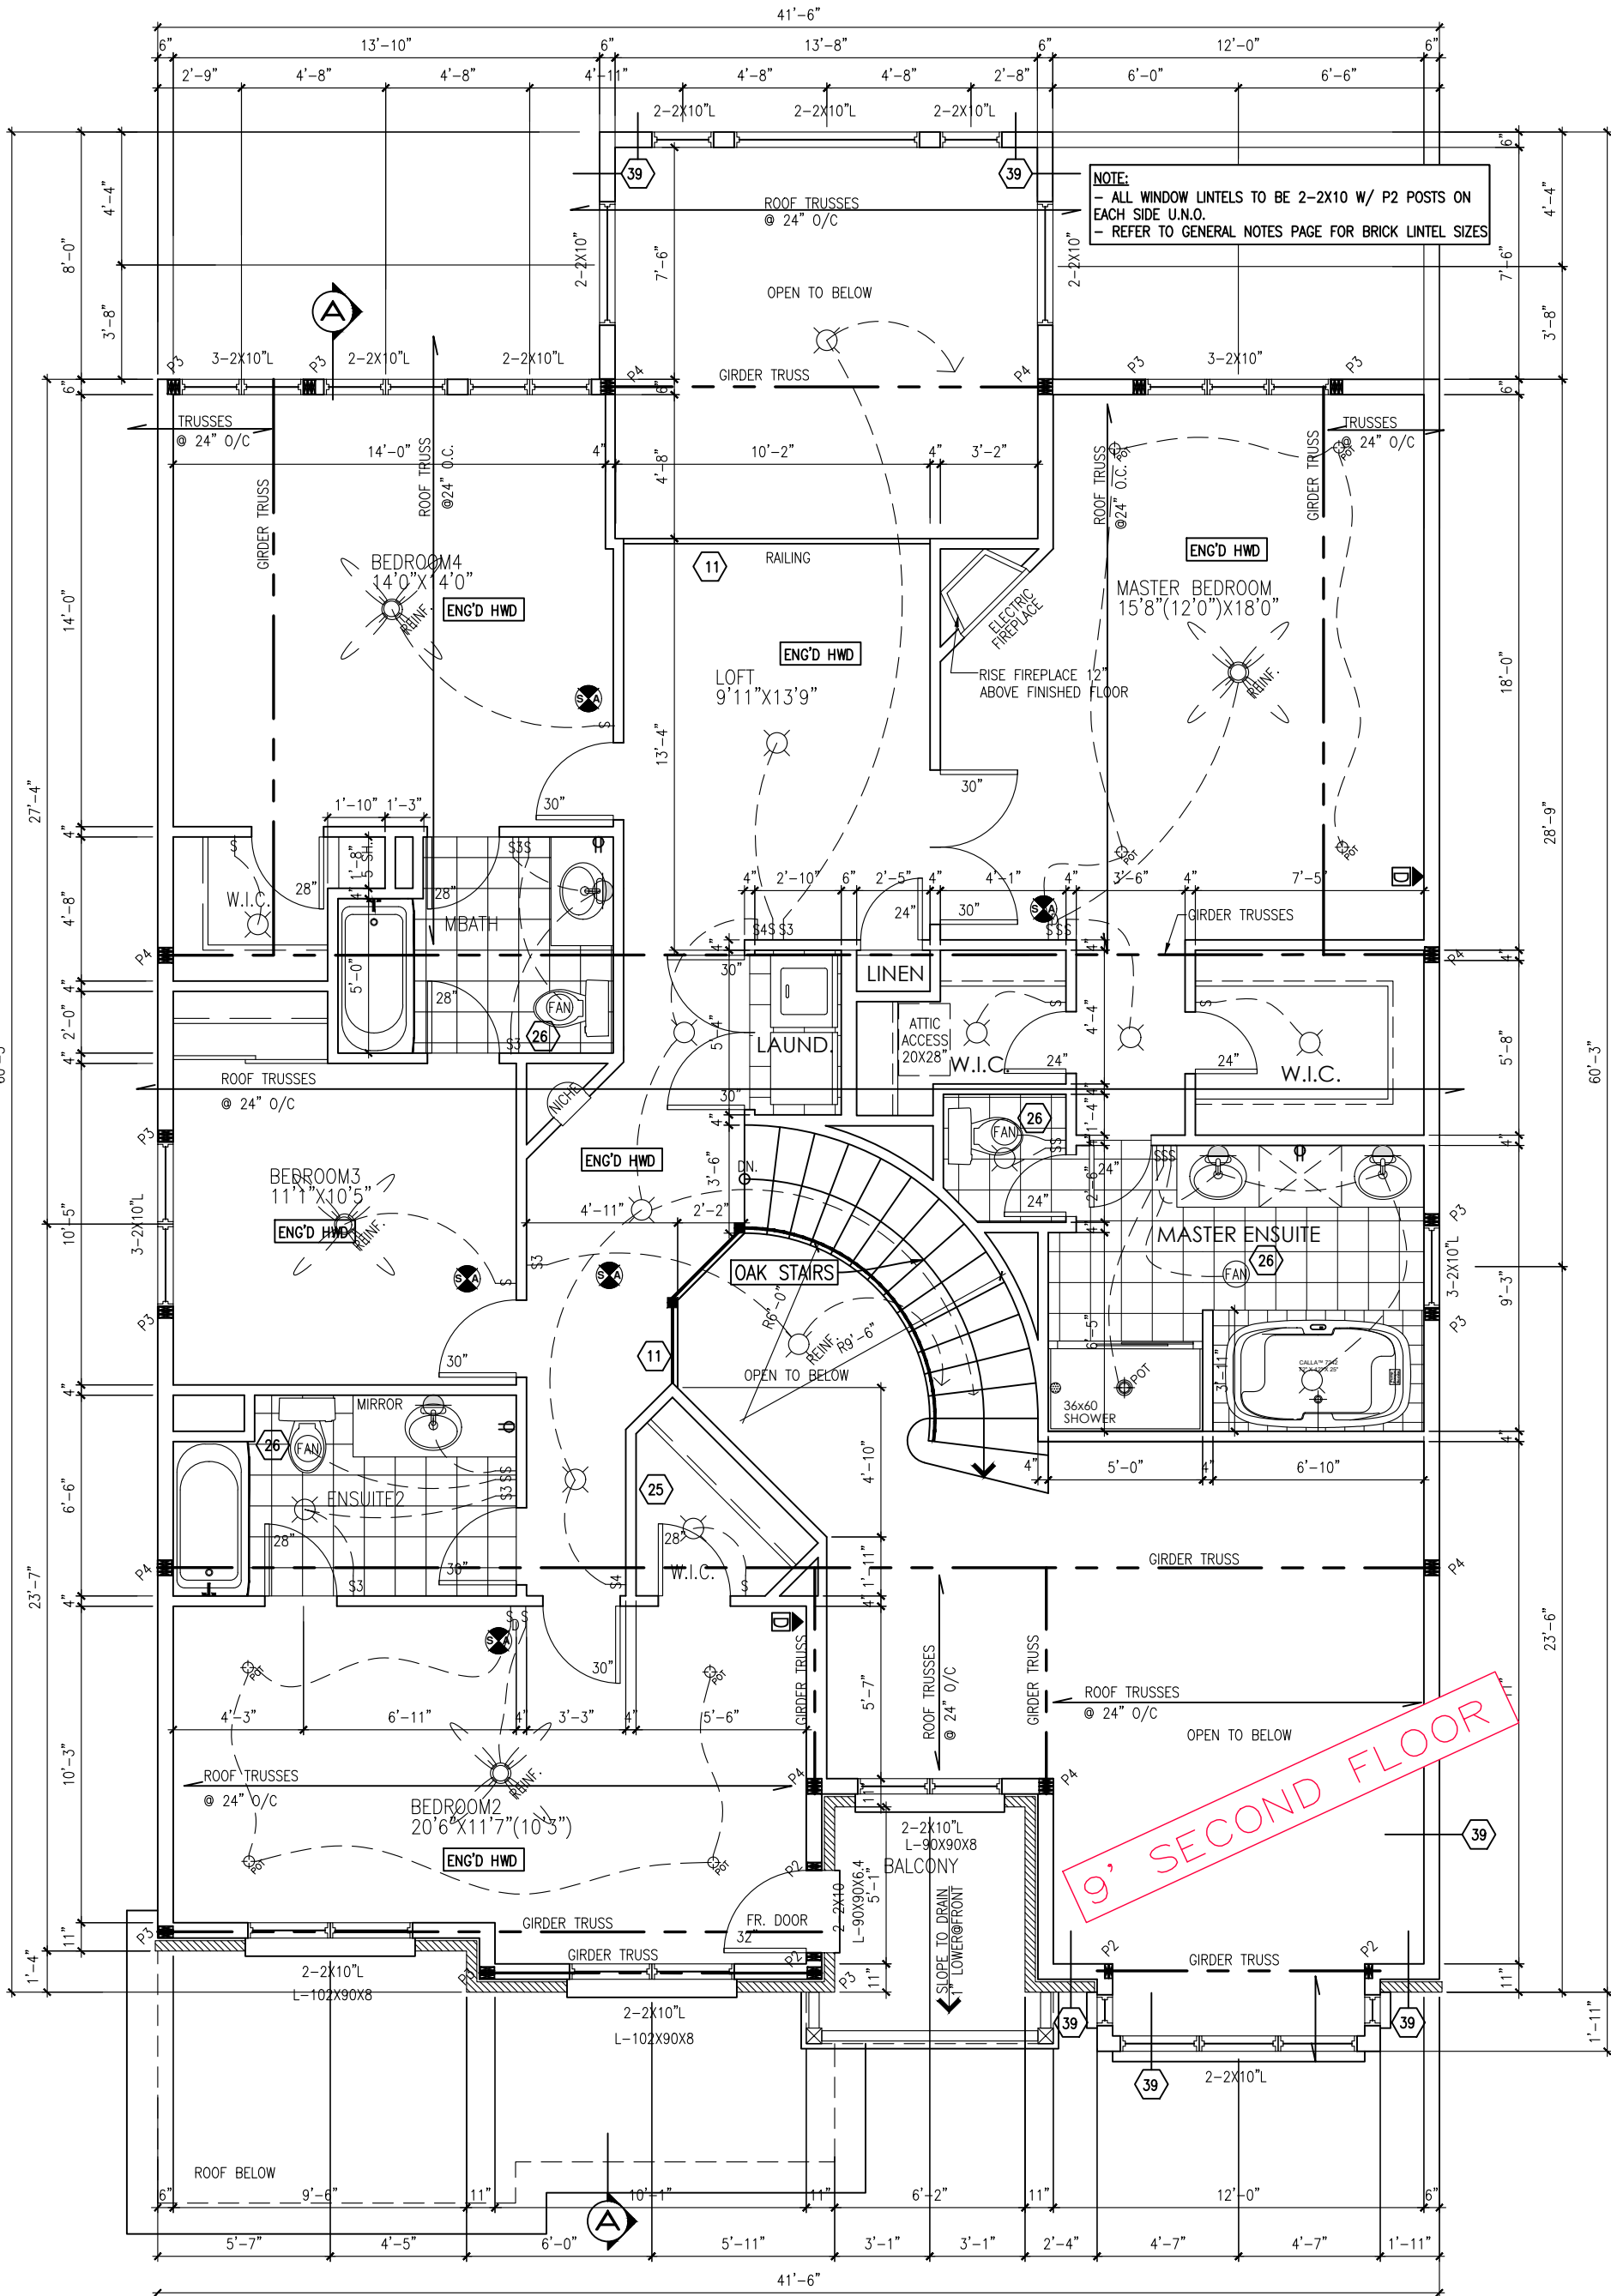

ANNAPOLIS-2019-B

SITE:PATHWAYS PH2

LOT NUMBER:

309

CIVIC ADDRESS:
29 DUN SKIPPER DRIVE

11	FRONT DOOR WINDOW GRILL REVISION	JUN-11-22	SP
10	WINDOW REVISION	JUN-11-22	SP
9	FINAL FOR CONSTRUCTION	MAY-18-22	SP
8	FINAL BLACKLINES	JAN-07-22	GK
7	BEP FOR BLACKLINES	OCT-25-21	KE
6	STRUCTURAL REVIEW	JUN-25-19	SP
No.	Description	Date	By
REVISIONS			

file number: 509

drawn by: T.L.

date: DEC. 2012

scale: 3/16"=1'



DCL-192
sheet no:

11

4B
9

CONTRACTOR MUST VERIFY ALL DIMENSIONS ON THE JOB AND REPORT ANY DISCREPANCY TO DCR/PHOENIX BEFORE PROCEEDING WITH THE WORK. ALL DRAWINGS AND SPECIFICATIONS ARE INSTRUMENTS OF SERVICE AND THE PROPERTY OF THE DCR/PHOENIX WHICH MUST BE RETURNED AT THE COMPLETION OF THE WORK. ALL DRAWINGS TO BE USED FOR CONSTRUCTION ONLY AFTER BUILDING PERMIT HAS BEEN ISSUED. DO NOT SCALE DRAWINGS, USE DIMENSIONS PROVIDED.

9' SECOND FLOOR

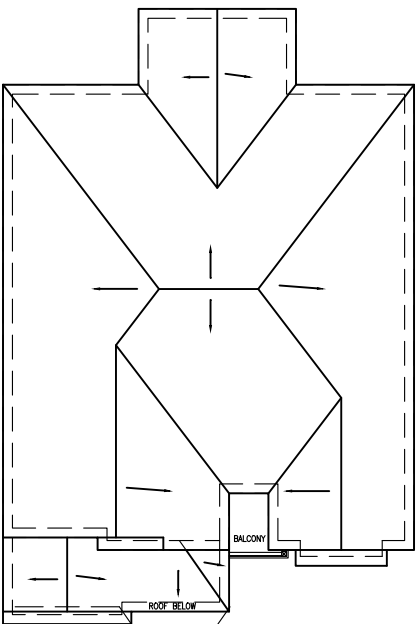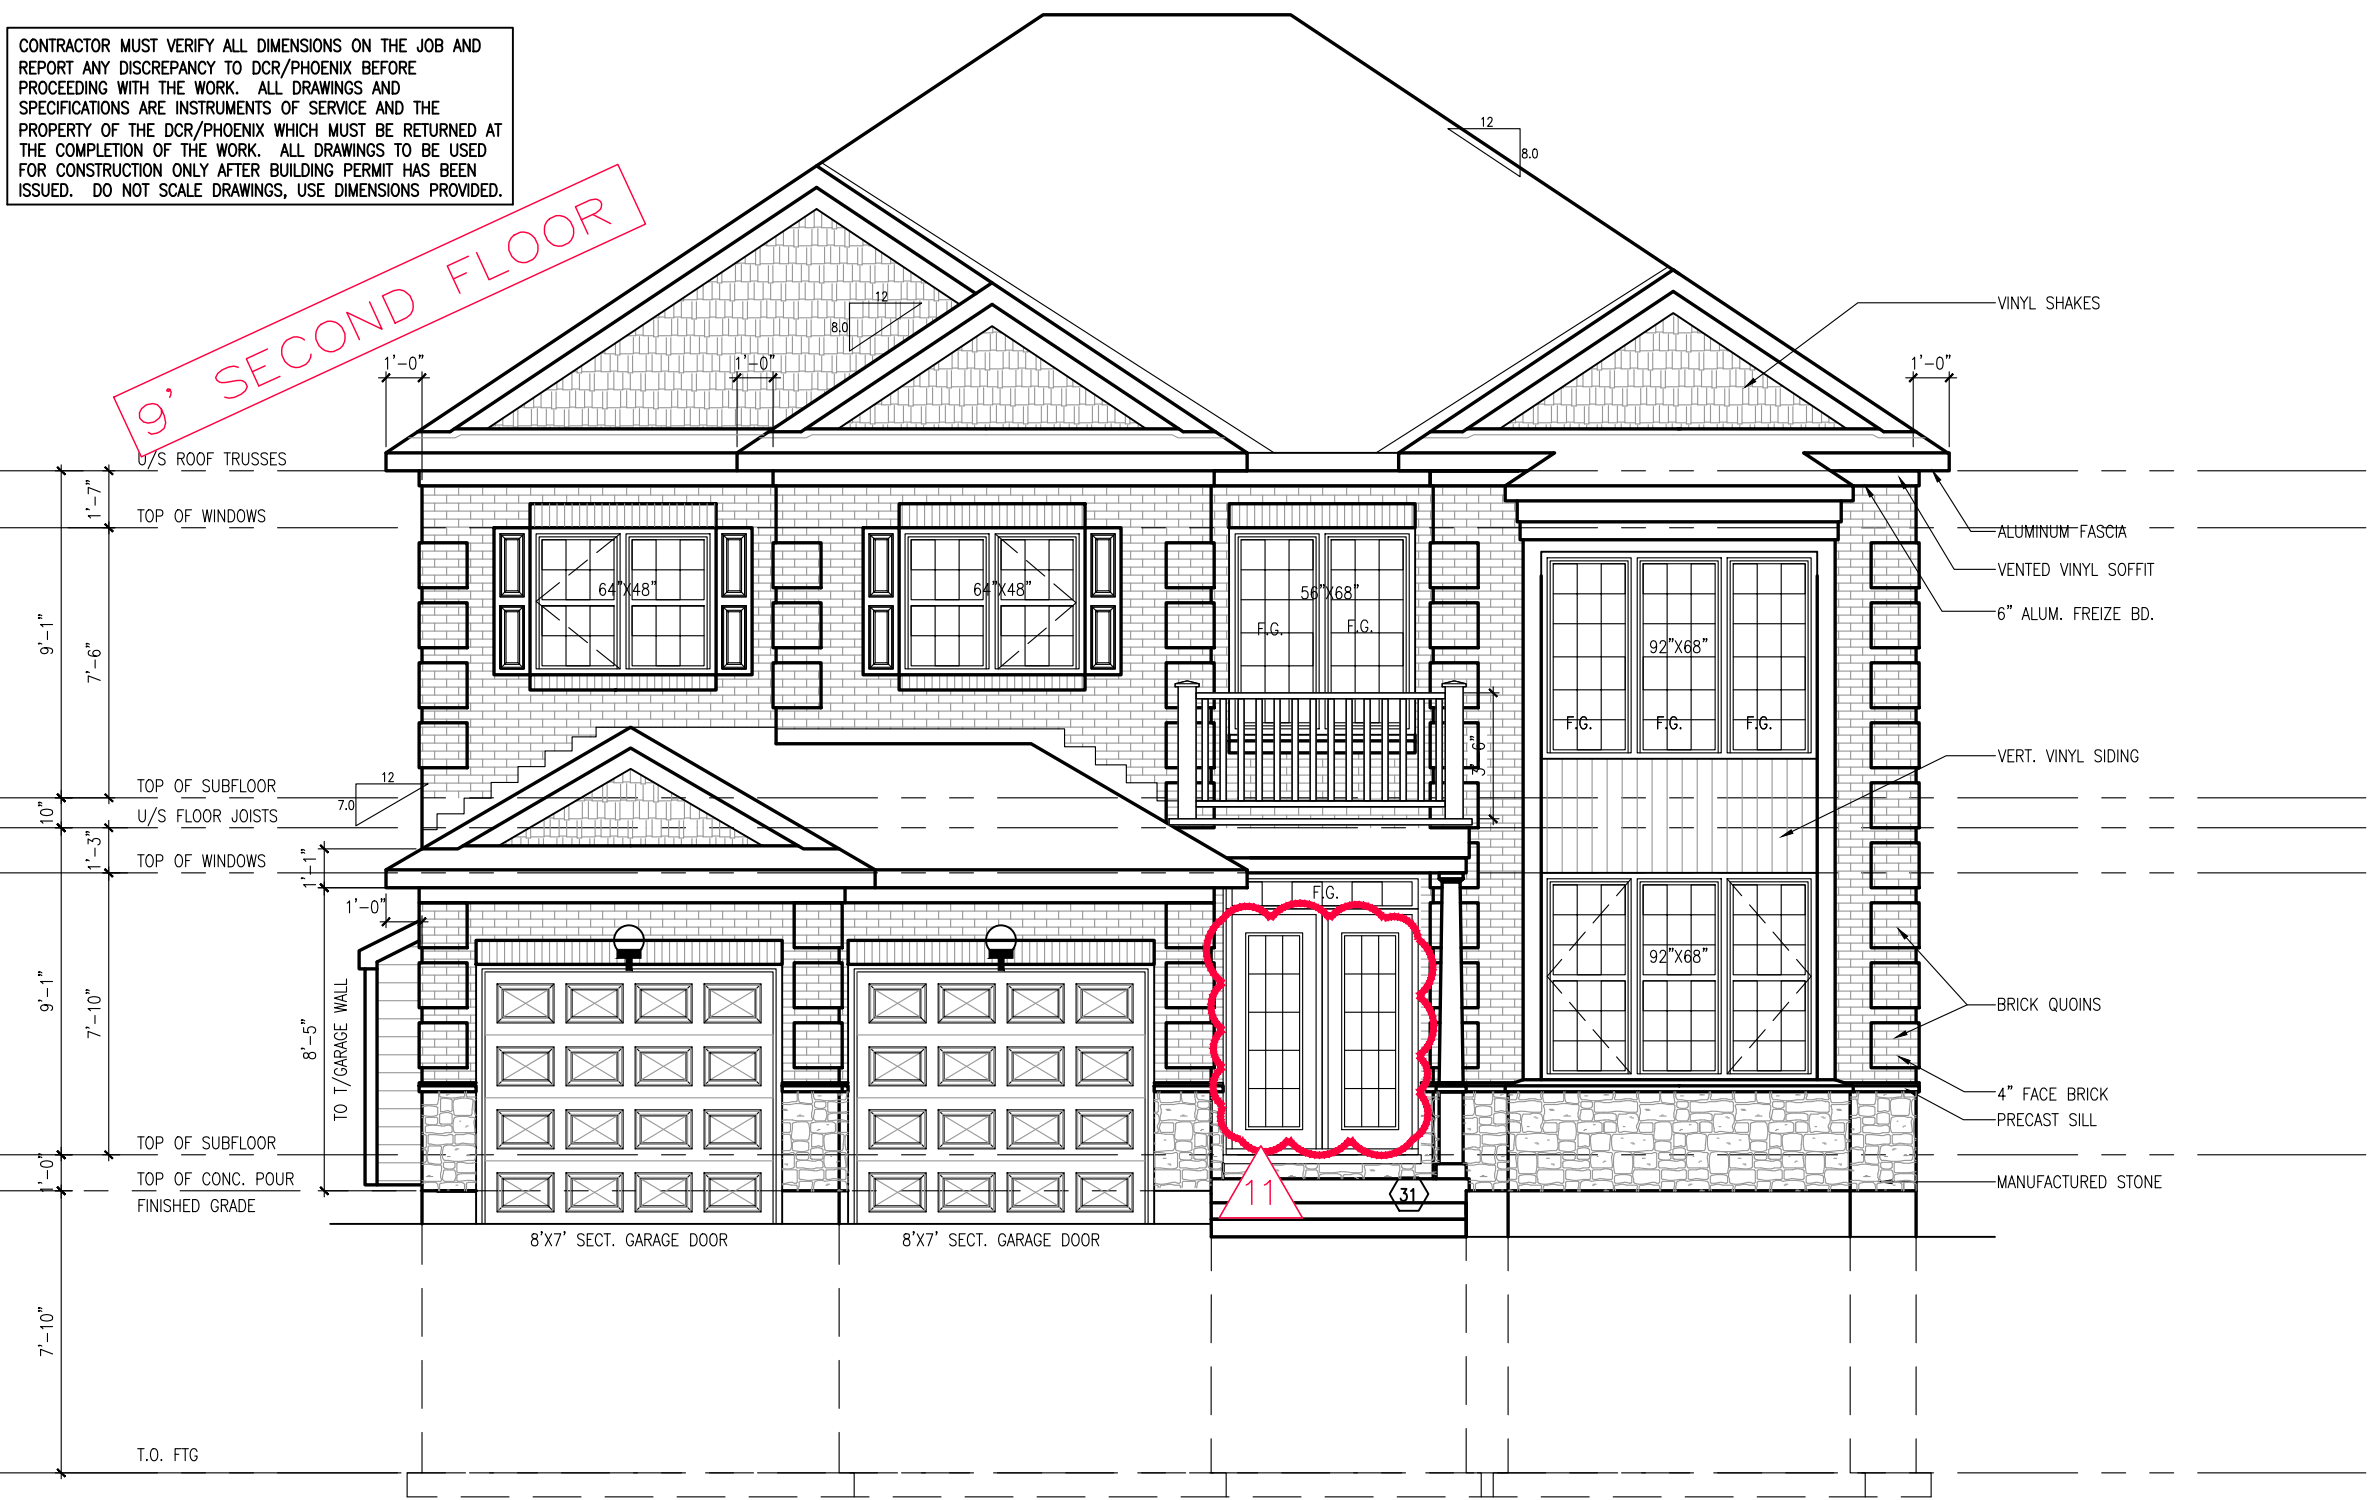

ROOF PLAN-B NTS

FRONT ELEVATION 'B'



ANNAPOLIS-2019-B

SITE:PATHWAYS PH2

LOT NUMBER:

309

CIVIC ADDRESS:
29 DUN SKIPPER DRIVE

11	FRONT DOOR WINDOW GRILL REVISION	JUN-11-22	SP
10	WINDOW REVISION	JUN-11-22	SP
9	FINAL FOR CONSTRUCTION	MAY-18-22	SP
8	FINAL BLACKLINES	JAN-07-22	GK
7	BEP FOR BLACKLINES	OCT-25-21	KE
6	STRUCTURAL REVIEW	JUN-25-19	SP
No.	Description	Date	By
REVISIONS			

file number: 509
drawn by: T.L.
date: DEC. 2012
scale: 3/16"=1'
DCL-192 sheet no:
12
5B 9

CONTRACTOR MUST VERIFY ALL DIMENSIONS ON THE JOB AND REPORT ANY DISCREPANCY TO DCR/PHOENIX BEFORE PROCEEDING WITH THE WORK. ALL DRAWINGS AND SPECIFICATIONS ARE INSTRUMENTS OF SERVICE AND THE PROPERTY OF THE DCR/PHOENIX WHICH MUST BE RETURNED AT THE COMPLETION OF THE WORK. ALL DRAWINGS TO BE USED FOR CONSTRUCTION ONLY AFTER BUILDING PERMIT HAS BEEN ISSUED. DO NOT SCALE DRAWINGS, USE DIMENSIONS PROVIDED.



RIGHT SIDE ELEVATION 'B'



ANNAPOLIS-2019-B

SITE:PATHWAYS PH2

LOT NUMBER:


CIVIC ADDRESS:
29 DUN SKIPPER DRIVE

309


11	FRONT DOOR WINDOW GRILL REVISION	JUN-11-22	SP
10	WINDOW REVISION	JUN-11-22	SP
9	FINAL FOR CONSTRUCTION	MAY-18-22	SP
8	FINAL BLACKLINES	JAN-07-22	GK
7	BEP FOR BLACKLINES	OCT-25-21	KE
6	STRUCTURAL REVIEW	JUN-25-19	SP
No.	Description	Date	By
REVISIONS			

file number: 509
drawn by: T.L.
date: DEC. 2012
scale: 3/16"=1'
DCL-192 sheet no:
13
6B 9

CONTRACTOR MUST VERIFY ALL DIMENSIONS ON THE JOB AND REPORT ANY DISCREPANCY TO DCR/PHOENIX BEFORE PROCEEDING WITH THE WORK. ALL DRAWINGS AND SPECIFICATIONS ARE INSTRUMENTS OF SERVICE AND THE PROPERTY OF THE DCR/PHOENIX WHICH MUST BE RETURNED AT THE COMPLETION OF THE WORK. ALL DRAWINGS TO BE USED FOR CONSTRUCTION ONLY AFTER BUILDING PERMIT HAS BEEN ISSUED. DO NOT SCALE DRAWINGS, USE DIMENSIONS PROVIDED.

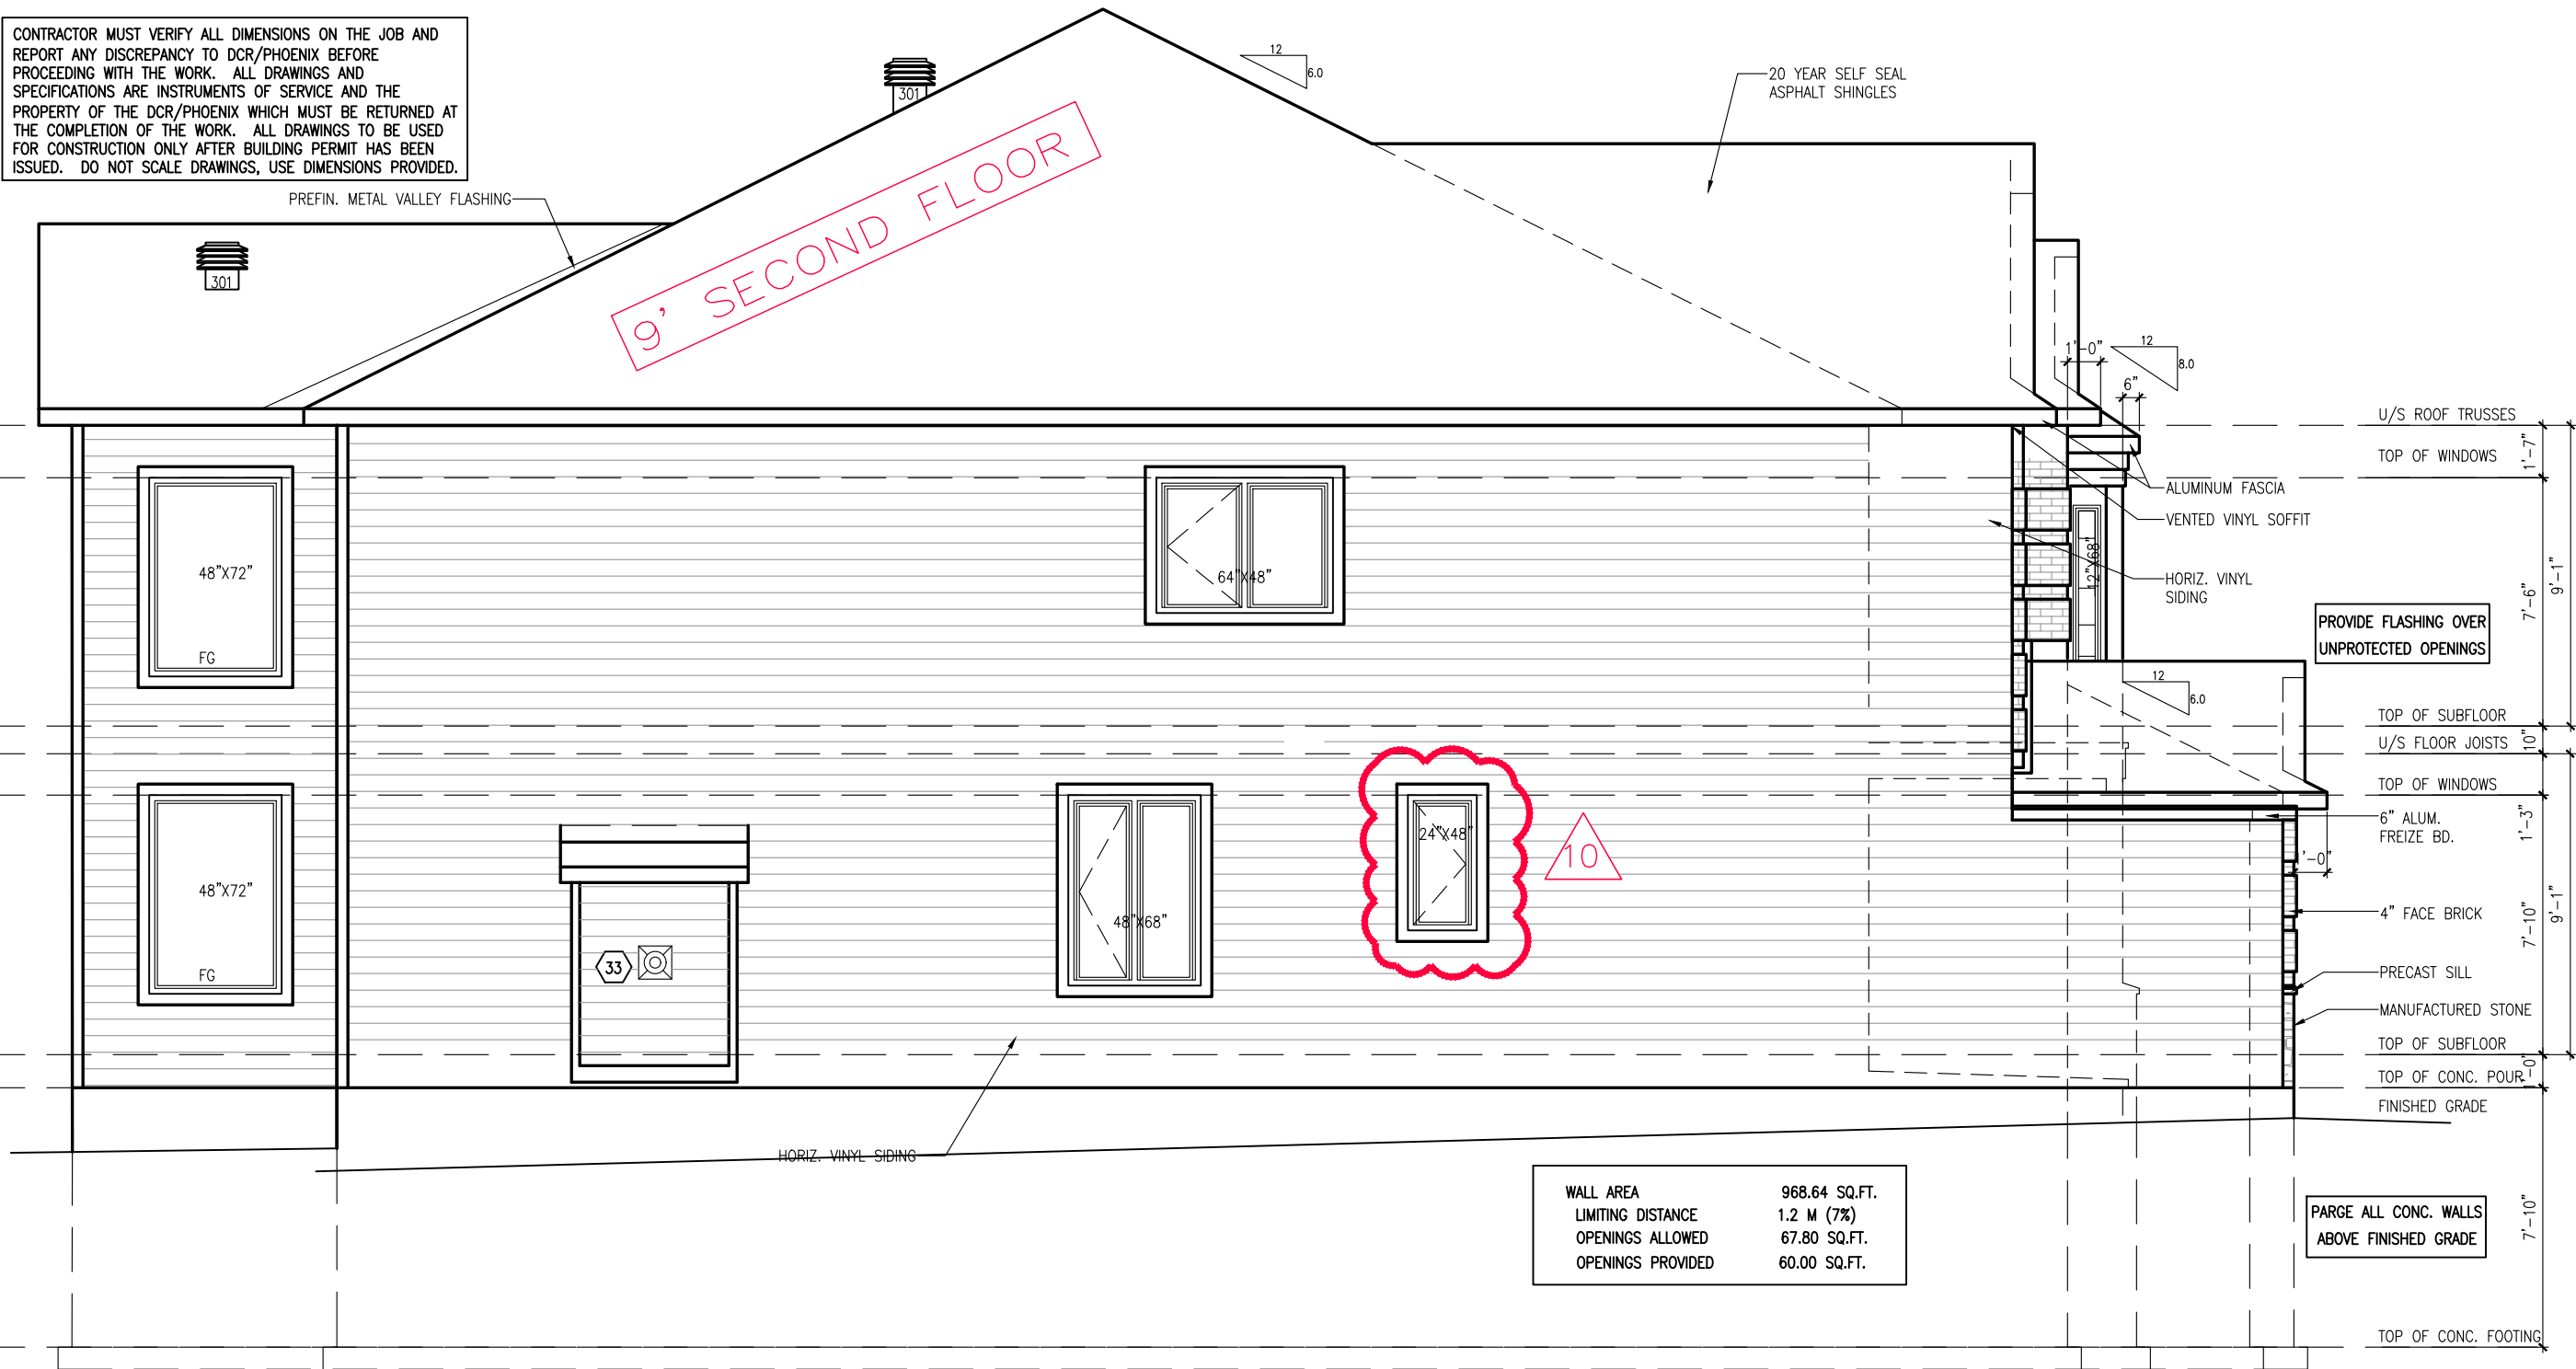

LEFT SIDE ELEVATION 'B'

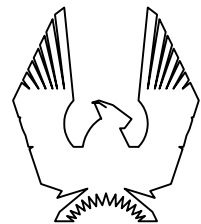

PHOENIX HOMES

ANNAPOLIS-2019-B

SITE:PATHWAYS PH2

LOT NUMBER:

309



CIVIC ADDRESS:
29 DUN SKIPPER DRIVE

11	FRONT DOOR WINDOW GRILL REVISION	JUN-11-22	SP
10	WINDOW REVISION	JUN-11-22	SP
9	FINAL FOR CONSTRUCTION	MAY-18-22	SP
8	FINAL BLACKLINES	JAN-07-22	GK
7	BEP FOR BLACKLINES	OCT-25-21	KE
6	STRUCTURAL REVIEW	JUN-25-19	SP
No.	Description	Date	By
REVISIONS			

file number: 509
drawn by: T.L.
date: DEC. 2012
scale: 3/16"=1'
DCL-192 sheet no:
14
7B 9

CONTRACTOR MUST VERIFY ALL DIMENSIONS ON THE JOB AND REPORT ANY DISCREPANCY TO DCR/PHOENIX BEFORE PROCEEDING WITH THE WORK. ALL DRAWINGS AND SPECIFICATIONS ARE INSTRUMENTS OF SERVICE AND THE PROPERTY OF THE DCR/PHOENIX WHICH MUST BE RETURNED AT THE COMPLETION OF THE WORK. ALL DRAWINGS TO BE USED FOR CONSTRUCTION ONLY AFTER BUILDING PERMIT HAS BEEN ISSUED. DO NOT SCALE DRAWINGS, USE DIMENSIONS PROVIDED.

MAXI VENT #301,
TWO REQ'D AT UPPER ROOF NOTE: LOCATIONS SHOWN ARE APPROXIMATION ONLY AND WILL BE LOCATED ON SITE BY QUALIFIED INSTALLER.

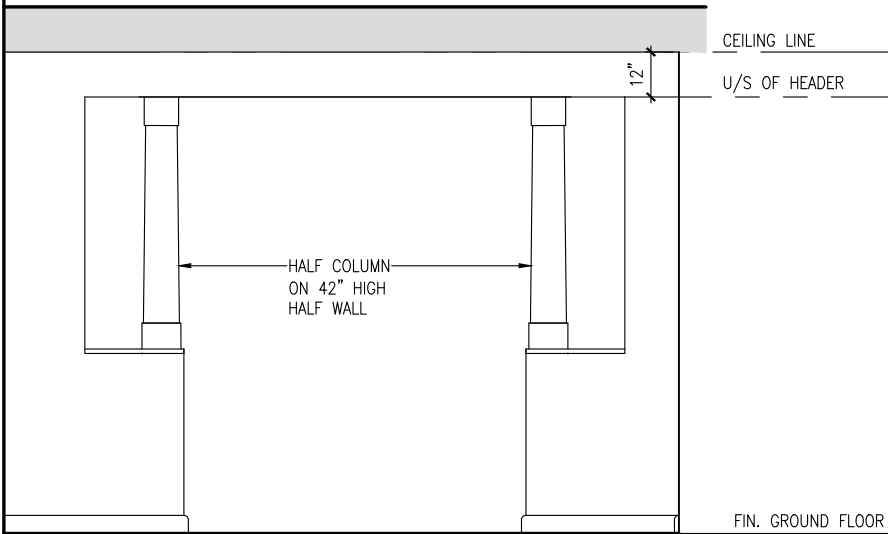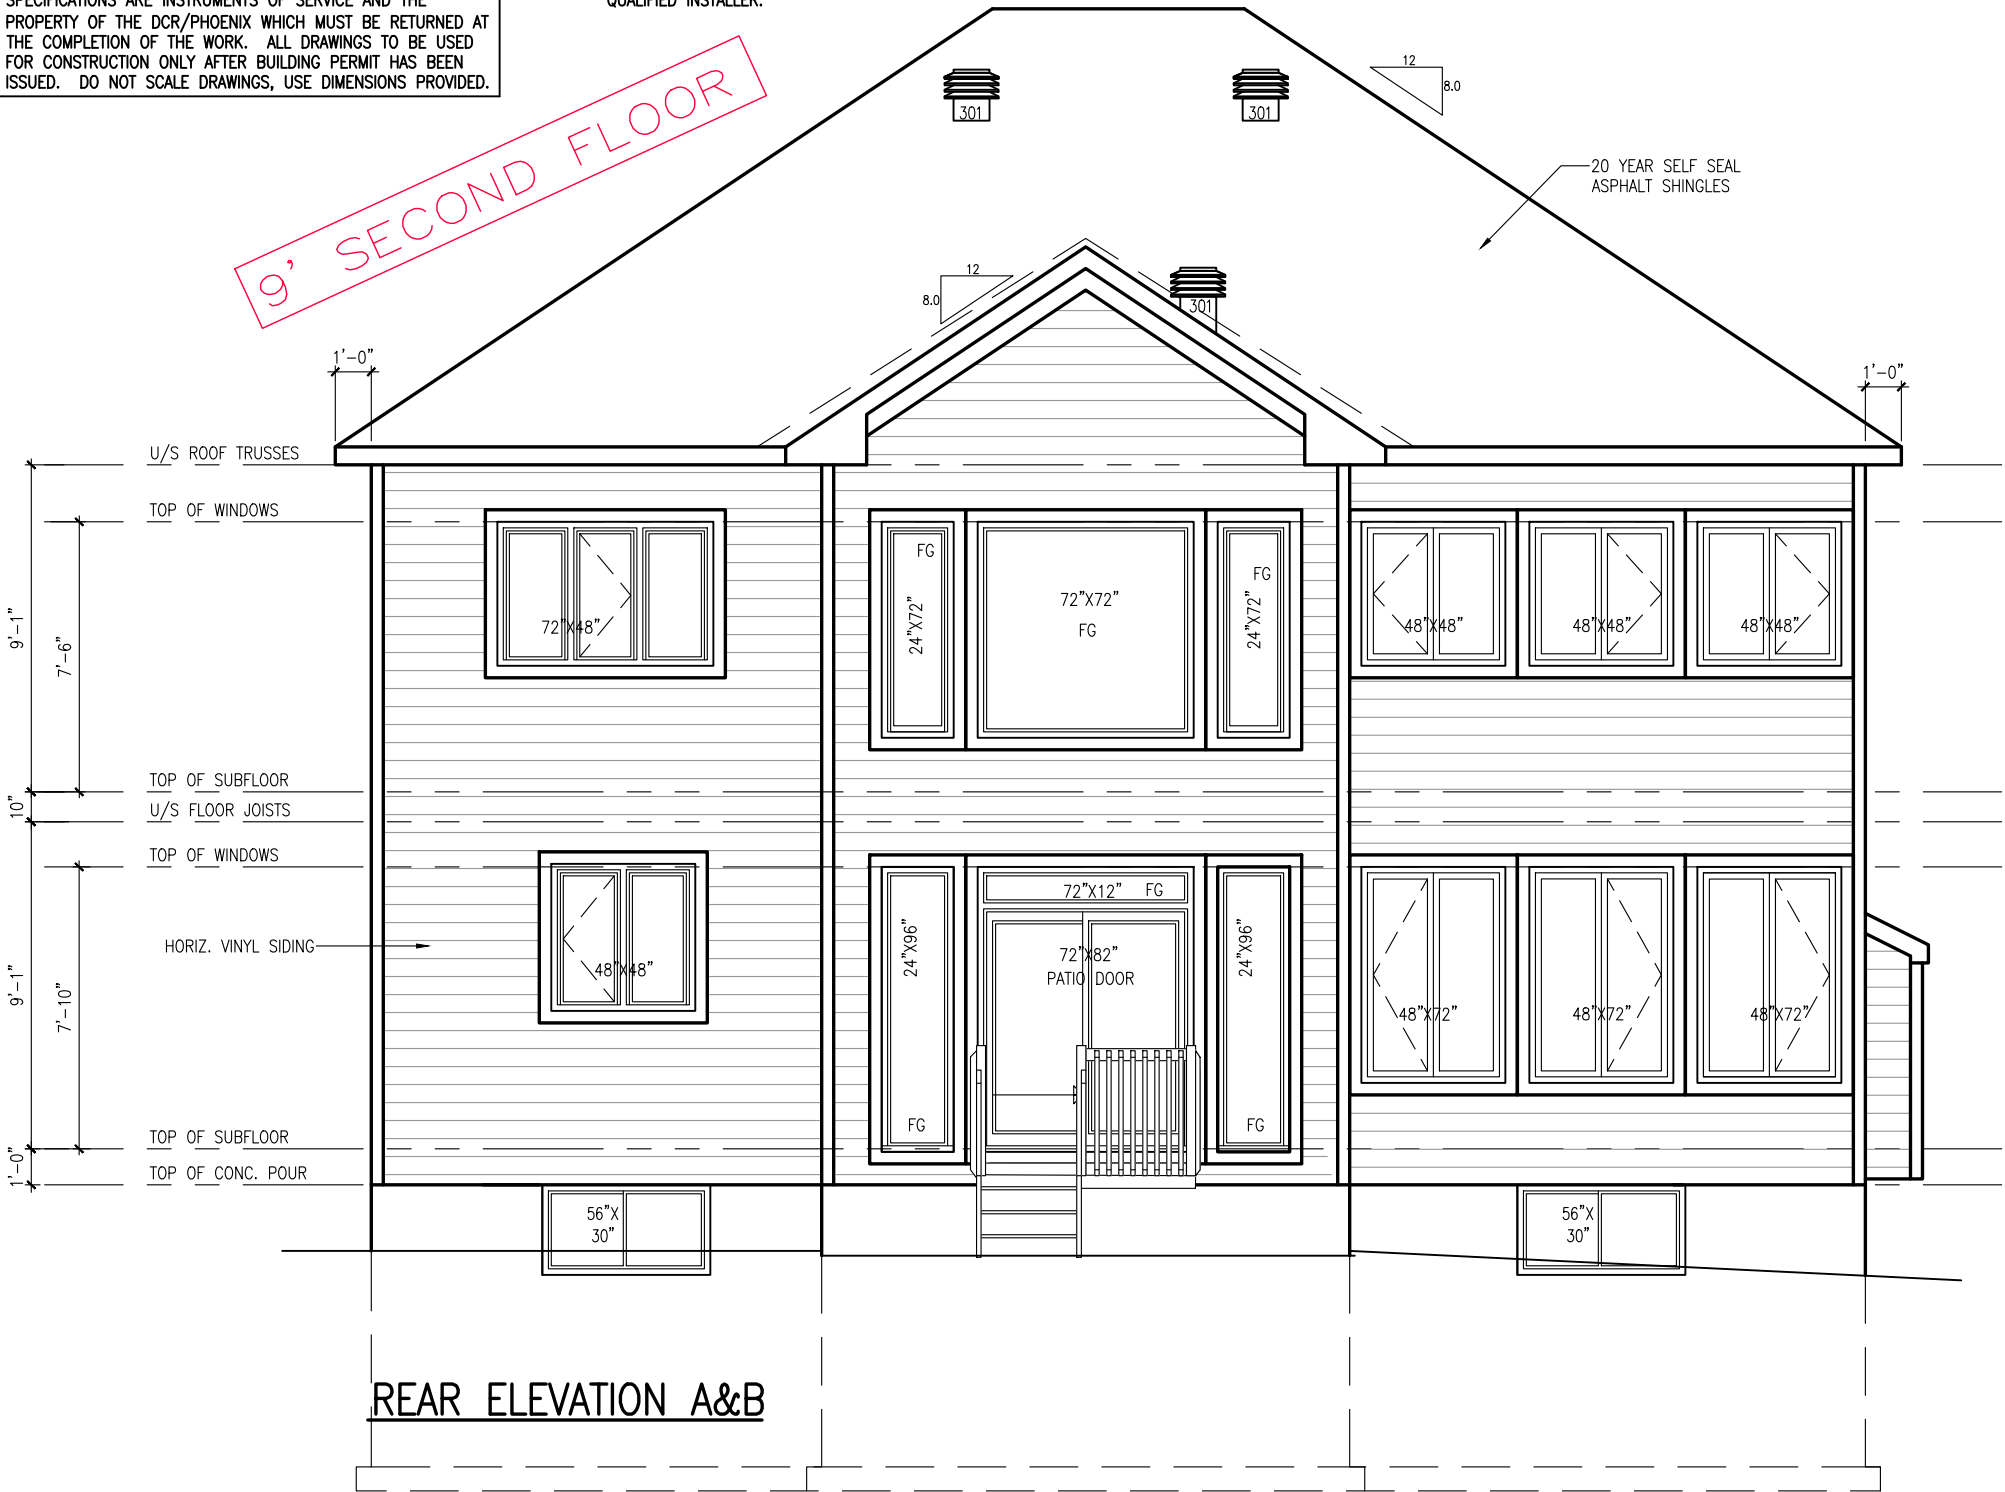

ELEVATION-1

LIVING-DINING ROOM



ANNAPOLIS-2019-A/B

SITE:PATHWAYS PH2

LOT NUMBER:

309

CIVIC ADDRESS:
29 DUN SKIPPER DRIVE


11	FRONT DOOR WINDOW GRILL REVISION	JUN-11-22	SP
10	WINDOW REVISION	JUN-11-22	SP
9	FINAL FOR CONSTRUCTION	MAY-18-22	SP
8	FINAL BLACKLINES	JAN-07-22	GK
7	BEP FOR BLACKLINES	OCT-25-21	KE
6	STRUCTURAL REVIEW	JUN-25-19	SP
No.	Description	Date	By
REVISIONS			

file number: 509
drawn by: T.L.
date: DEC. 2012
scale: 3/16"=1'
DCL-192 sheet no:
8
8AB 9


CONTRACTOR MUST VERIFY ALL DIMENSIONS ON THE JOB AND REPORT ANY DISCREPANCY TO DCR/PHOENIX BEFORE PROCEEDING WITH THE WORK. ALL DRAWINGS AND SPECIFICATIONS ARE INSTRUMENTS OF SERVICE AND THE PROPERTY OF THE DCR/PHOENIX WHICH MUST BE RETURNED AT THE COMPLETION OF THE WORK. ALL DRAWINGS TO BE USED FOR CONSTRUCTION ONLY AFTER BUILDING PERMIT HAS BEEN ISSUED. DO NOT SCALE DRAWINGS, USE DIMENSIONS PROVIDED.

PREFIN. METAL VALLEY FLASHING

9' SECOND FLOOR

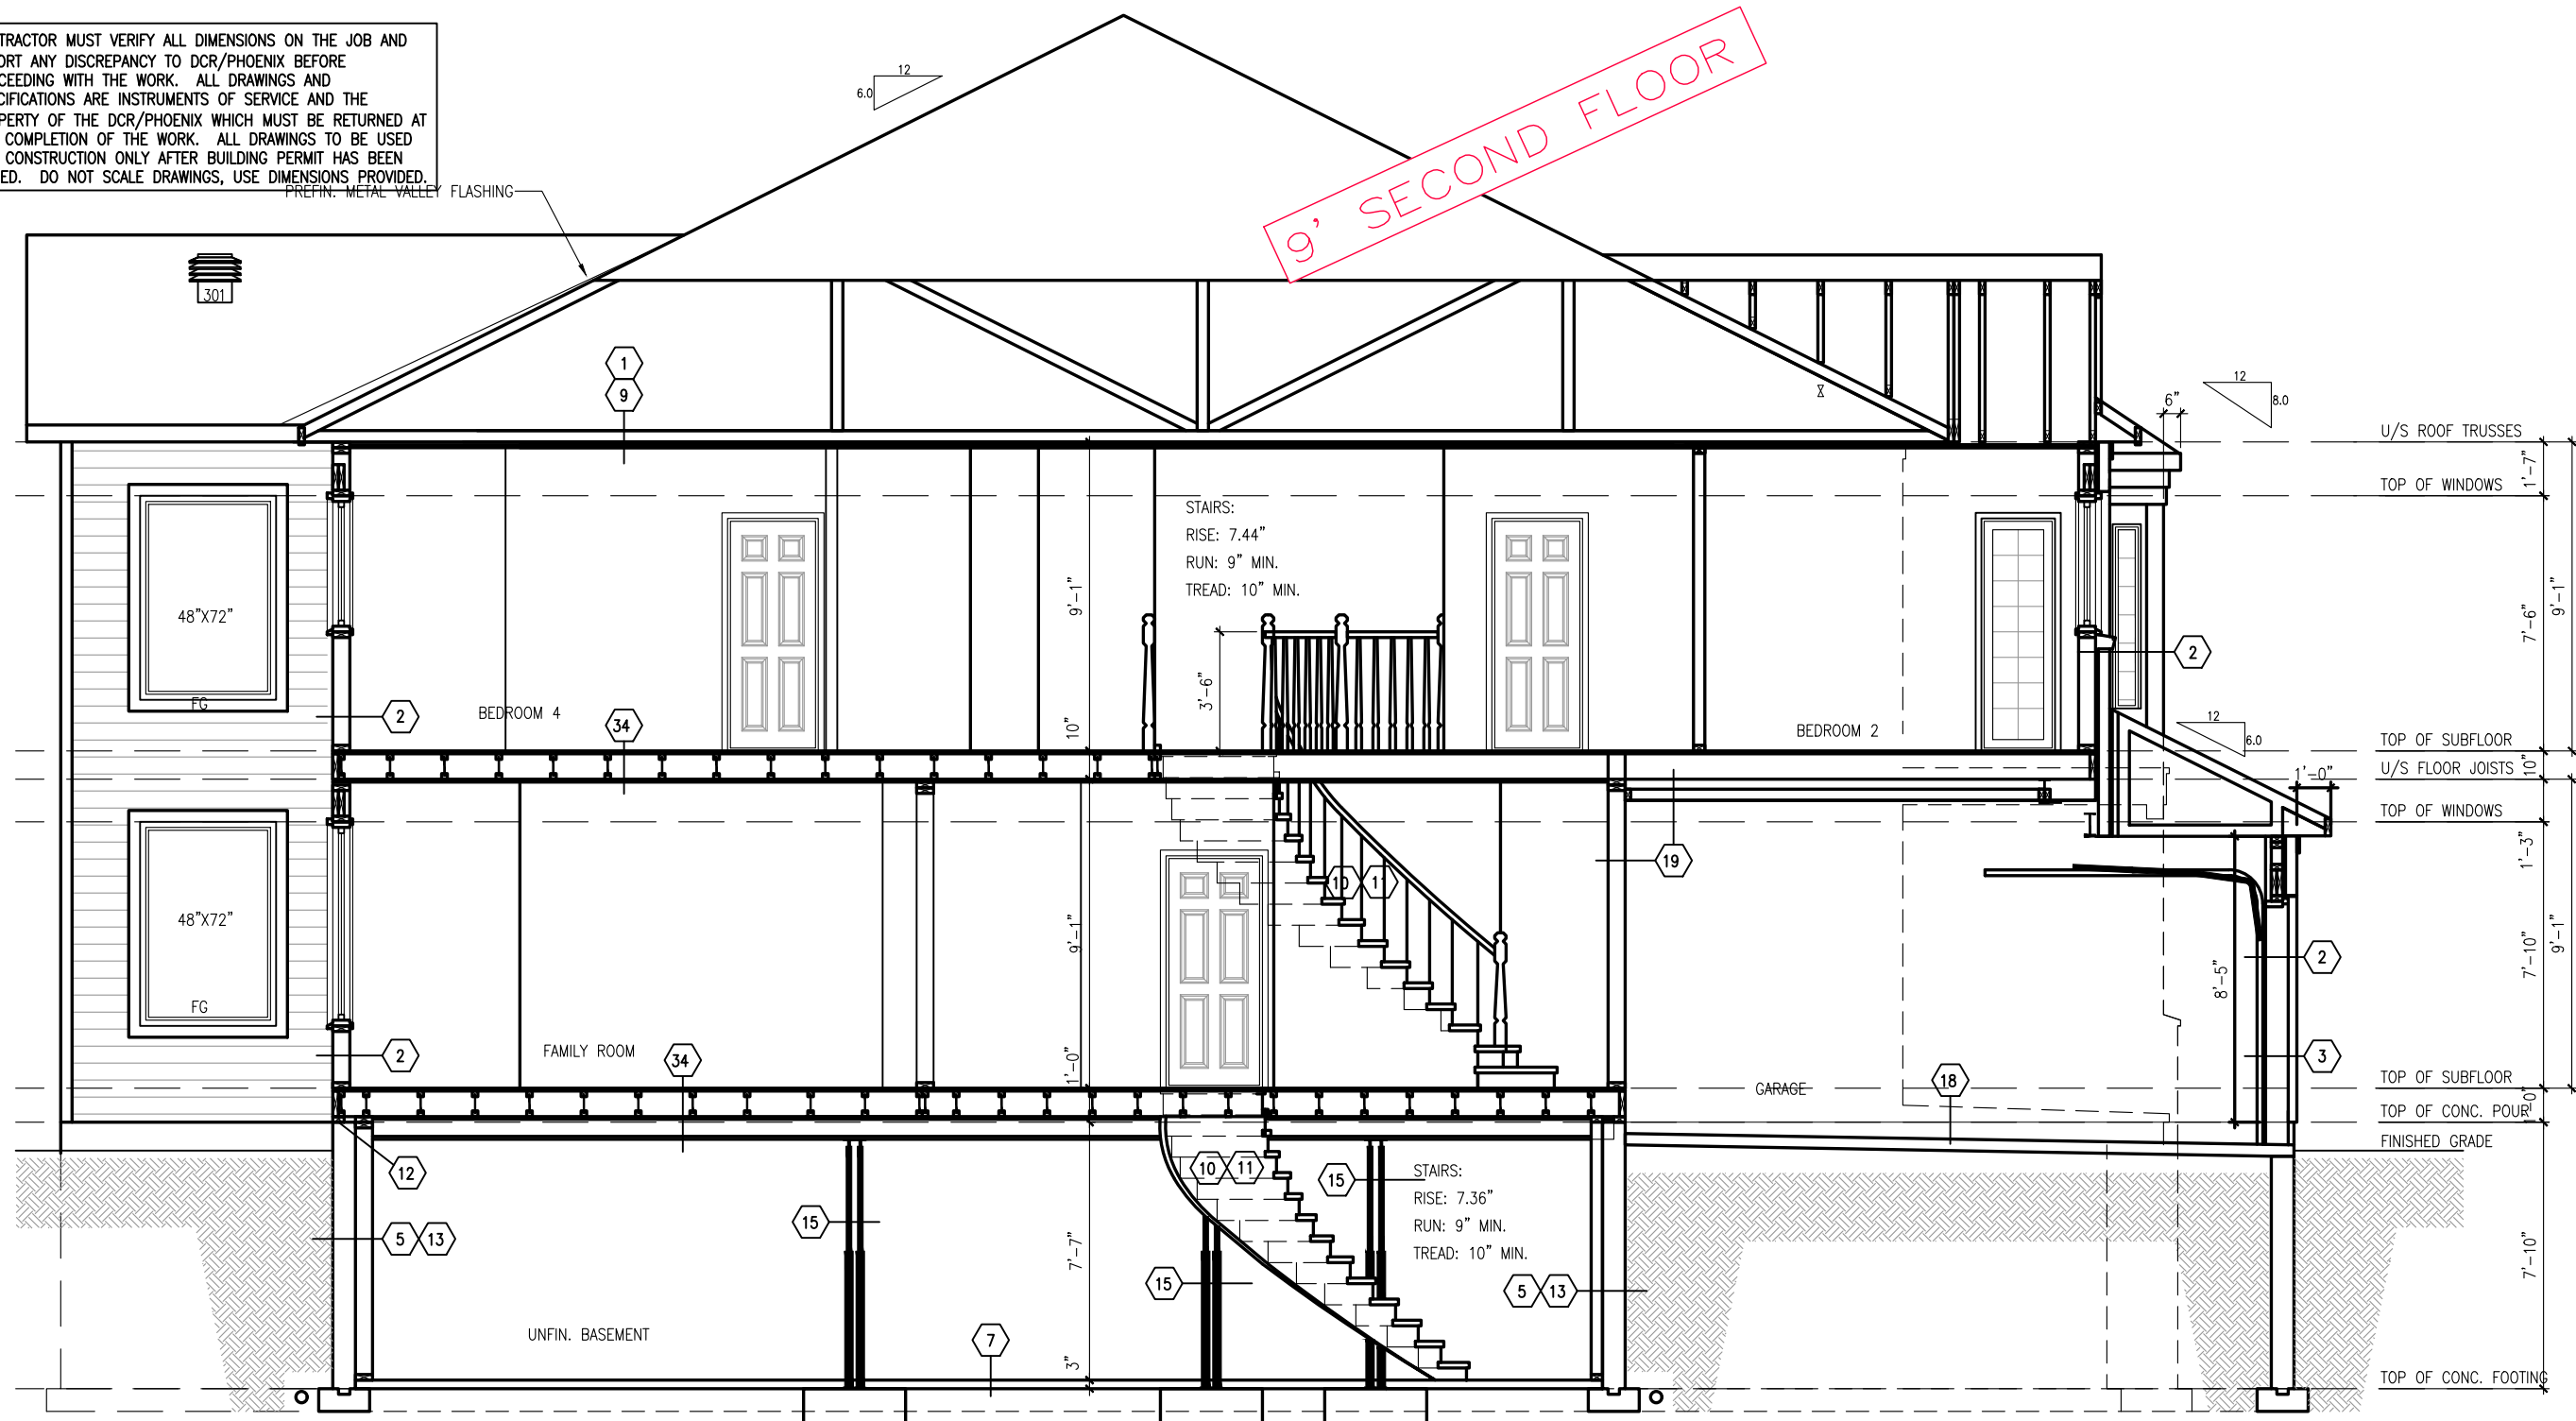

SECTION @ STAIRS

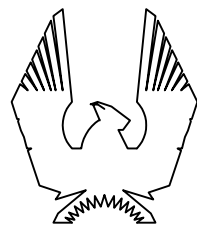

PHOENIX HOMES

ANNAPOLIS-2019-B

SITE: PATHWAYS PH2

LOT NUMBER:

309

CIVIC ADDRESS:
29 DUN SKIPPER DRIVE

11	FRONT DOOR WINDOW GRILL REVISION	JUN-11-22	SP
10	WINDOW REVISION	JUN-11-22	SP
9	FINAL FOR CONSTRUCTION	MAY-18-22	SP
8	FINAL BLACKLINES	JAN-07-22	GK
7	BEP FOR BLACKLINES	OCT-25-21	KE
6	STRUCTURAL REVIEW	JUN-25-19	SP
No.	Description	Date	By
REVISIONS			

file number: 509

drawn by: T.L.

date: DEC. 2012

scale: 3/16"=1'

DCL-192
sheet no:

9B
9