


DCR PHOENIX HOMES




LOT #3-157  
WHITE TAIL RIDGE 3  
NEWINGTON  
OPTIONAL CHEF'S KITCHEN


REVISED: MAY 24-22

- KITCHEN  
CABINETS -  
HARDWARE -  
STANDARD WHITE INTERIOR  
SOFT CLOSE DOORS & DRAWERS  
4 PCS - 5/8" KICK - FIN. BOTH ENDS  
4 PCS - FURRING - 6 x 96  
2 PCS - 90 DEG. CORNER MOULD  
5 PCS - FLAT MOULDING

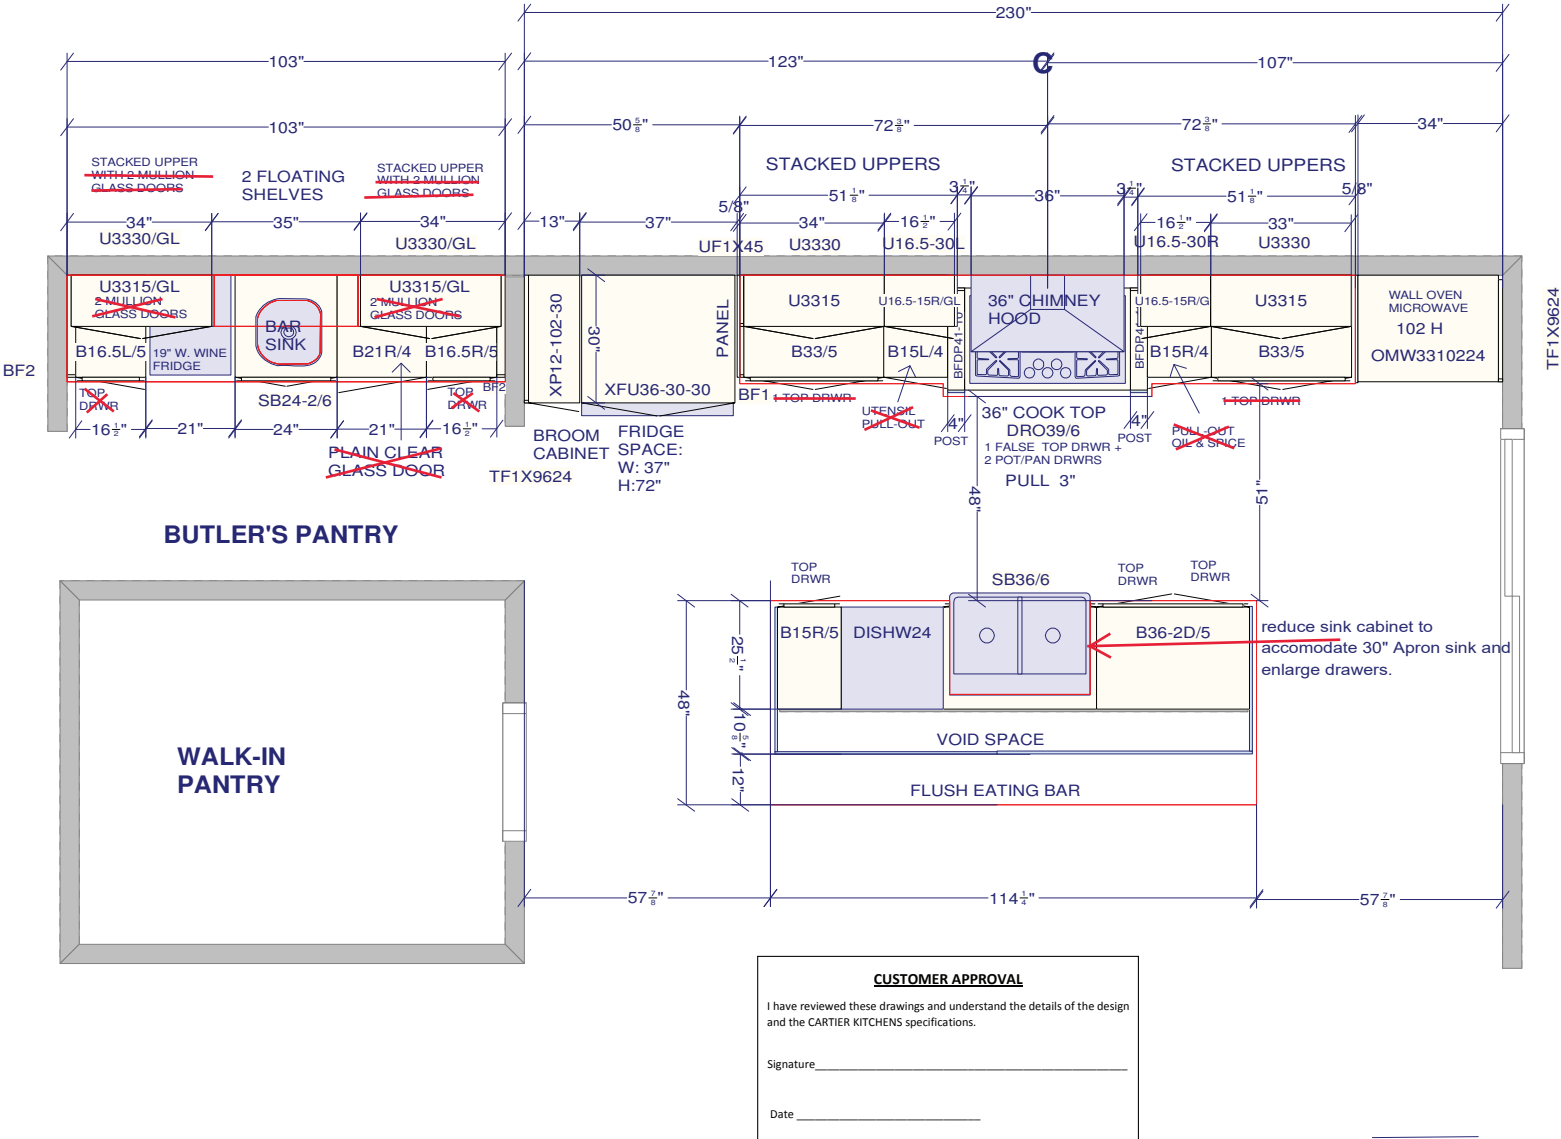MOUNTING HEIGHT: 102  
30"H UPPERS @ 21" ABOVE COUNTER  
+ 15"H UPPERS STACKED ABOVE  
FILL TO CEILING WITH  
FURRING PANEL +  
CEILING CROWN (APPROX. 6"H TOTAL)



All dimensions _size designations given are subject to verification on job site and adjustment to fit job conditions.		This is an original design and must not be released or copied unless applicable fee has been paid or job order placed.	Designed: 2022-05-23 Printed: 2022-05-24		
					
DCR #3-157 White Tail Ridge 3 - Kitchen - revised May 23-22.kit			All	Drawing #: 1	No Scale.

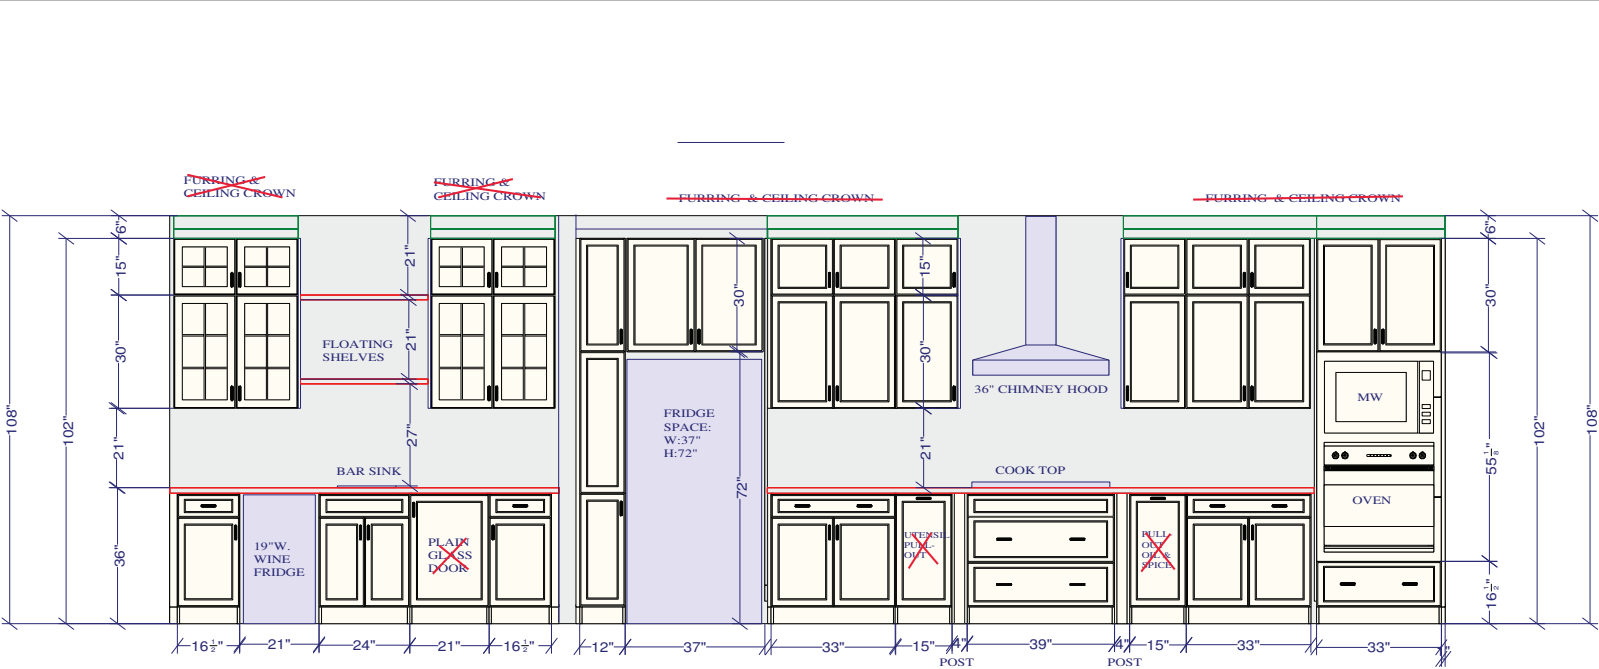

BUTLER'S PANTRY ELEVATION

FRIDGE / COOKTOP/ OVEN WALL ELEVATION

REVISED: MAY 24-22


CUSTOMER APPROVAL

I have reviewed these drawings and understand the details of the design and the CARTIER KITCHENS specifications.

Signature\_\_\_\_\_

Date\_\_\_\_\_

All dimensions ,size designations given are subject to verification on job site and adjustment to fit job conditions.		This is an original design and must not be released or copied unless applicable fee has been paid or job order placed.	Designed: 2022-05-23 Printed: 2022-05-24	

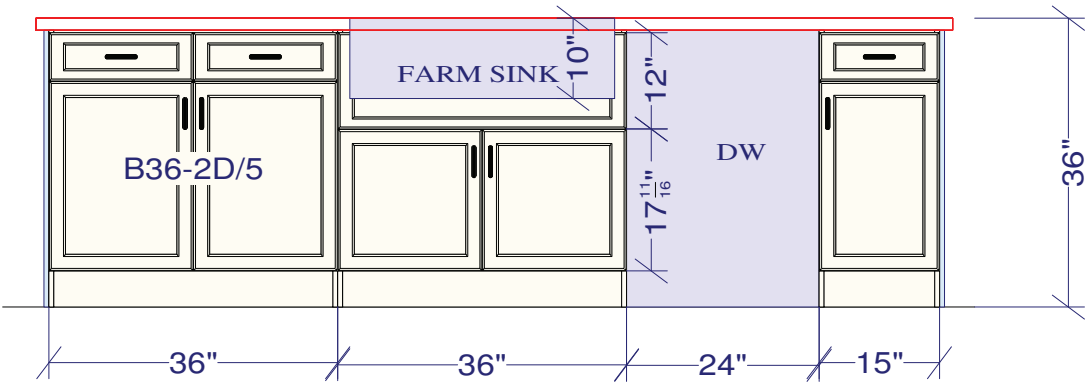

ISLAND ELEVATION

**CUSTOMER APPROVAL**


I have reviewed these drawings and understand the details of the design and the CARTIER KITCHENS specifications.

Signature\_\_\_\_\_

Date \_\_\_\_\_

REVISED: MAY 24-22

All dimensions ,size designations given are subject to verification on job site and adjustment to fit job conditions.		This is an original design and must not be released or copied unless applicable fee has been paid or job order placed.	Designed: 2022-05-23 Printed: 2022-05-24		
					
DCR #3-157 White Tail Ridge 3 - Kitchen - revised May 23-22.kit			EI 4	Drawing #: 1	No Scale.

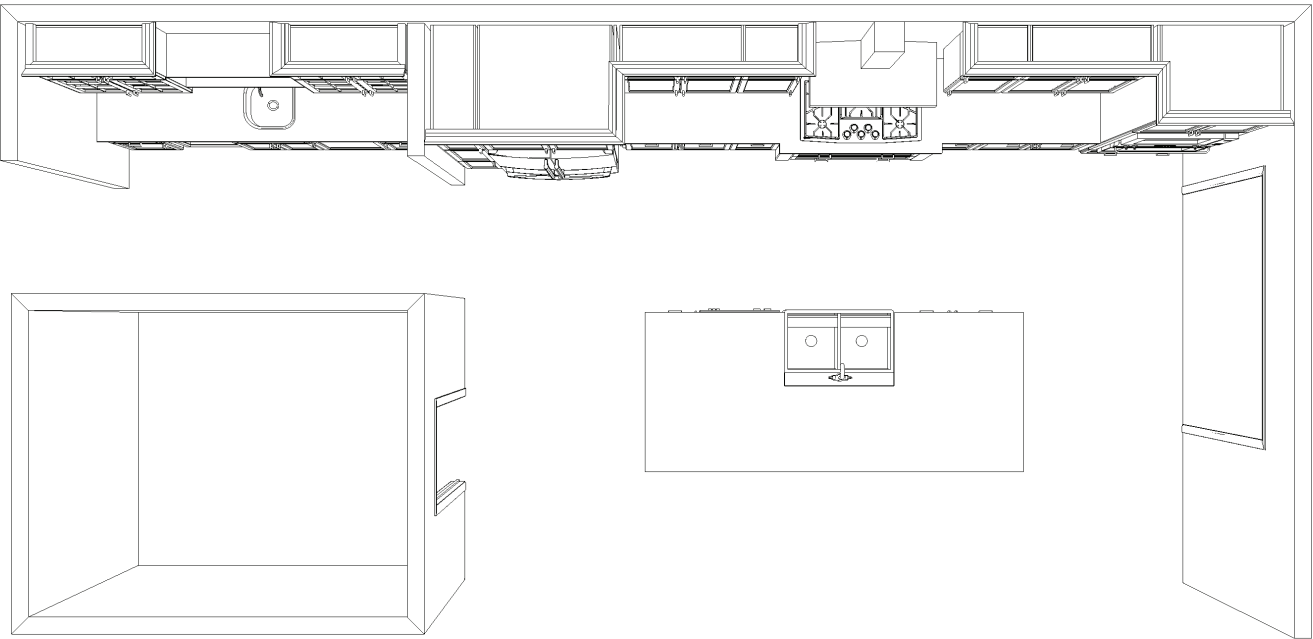

KITCHEN - TOP VIEW

REVISED: MAY 24-22


**CUSTOMER APPROVAL**

I have reviewed these drawings and understand the details of the design and the CARTIER KITCHENS specifications.

Signature \_\_\_\_\_

Date \_\_\_\_\_

Note: This drawing is an artistic interpretation of the general appearance of the design. It is not meant to be an exact rendition.		Designed: 2022-05-23	
		Printed: 2022-05-24	
			
DCR #3-157 White Tail Ridge 3 - Kitchen - revised	All	Drawing #: 1	

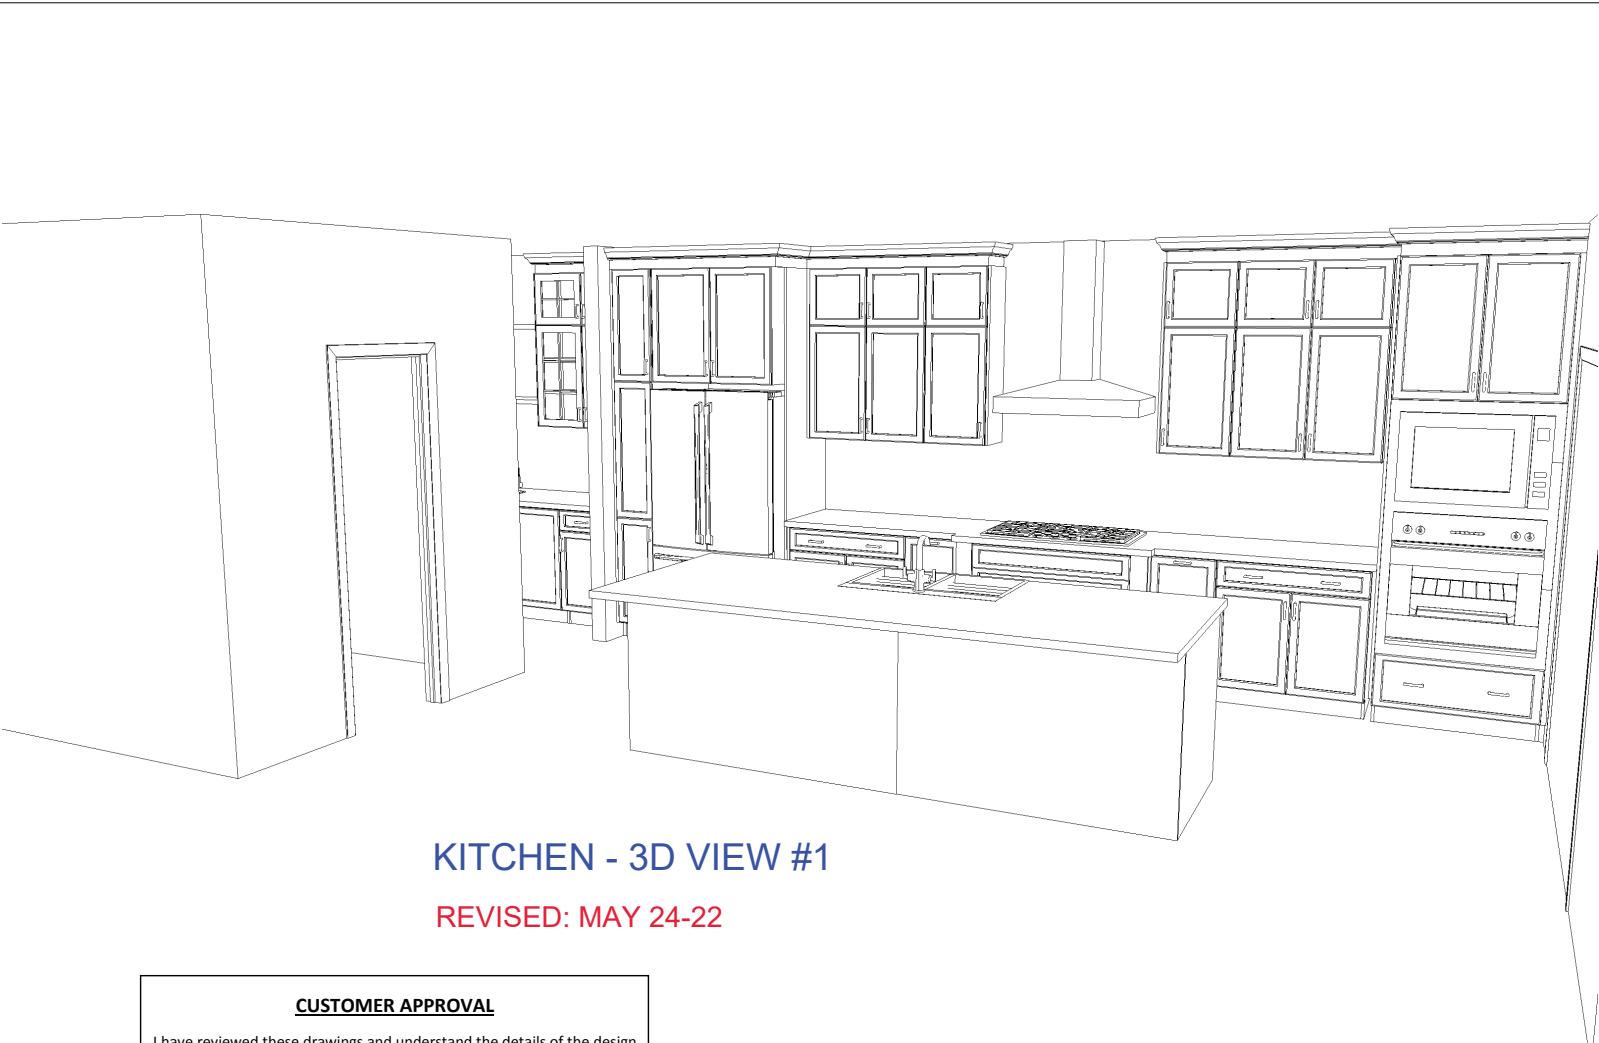

KITCHEN - 3D VIEW #1  
REVISED: MAY 24-22

<p><b>CUSTOMER APPROVAL</b></p> <p>I have reviewed these drawings and understand the details of the design and the CARTIER KITCHENS specifications.</p> <p>Signature_____</p> <p>Date _____</p>
---

<p>Note: This drawing is an artistic interpretation of the general appearance of the design. It is not meant to be an exact rendition.</p>		Designed: 2022-05-23
		Printed: 2022-05-24
		 
DCR #3-157 White Tail Ridge 3 - Kitchen - revised		Drawing #: 1




KITCHEN - 3D VIEW #2

REVISED: MAY 24-22

<b>CUSTOMER APPROVAL</b>
I have reviewed these drawings and understand the details of the design and the CARTIER KITCHENS specifications.
Signature_____
Date _____

Note: This drawing is an artistic interpretation of the general appearance of the design. It is not meant to be an exact rendition.		Designed: 2022-05-23
		Printed: 2022-05-24
		 
DCR #3-157 White Tail Ridge 3 - Kitchen - revised	All	Drawing #: 1

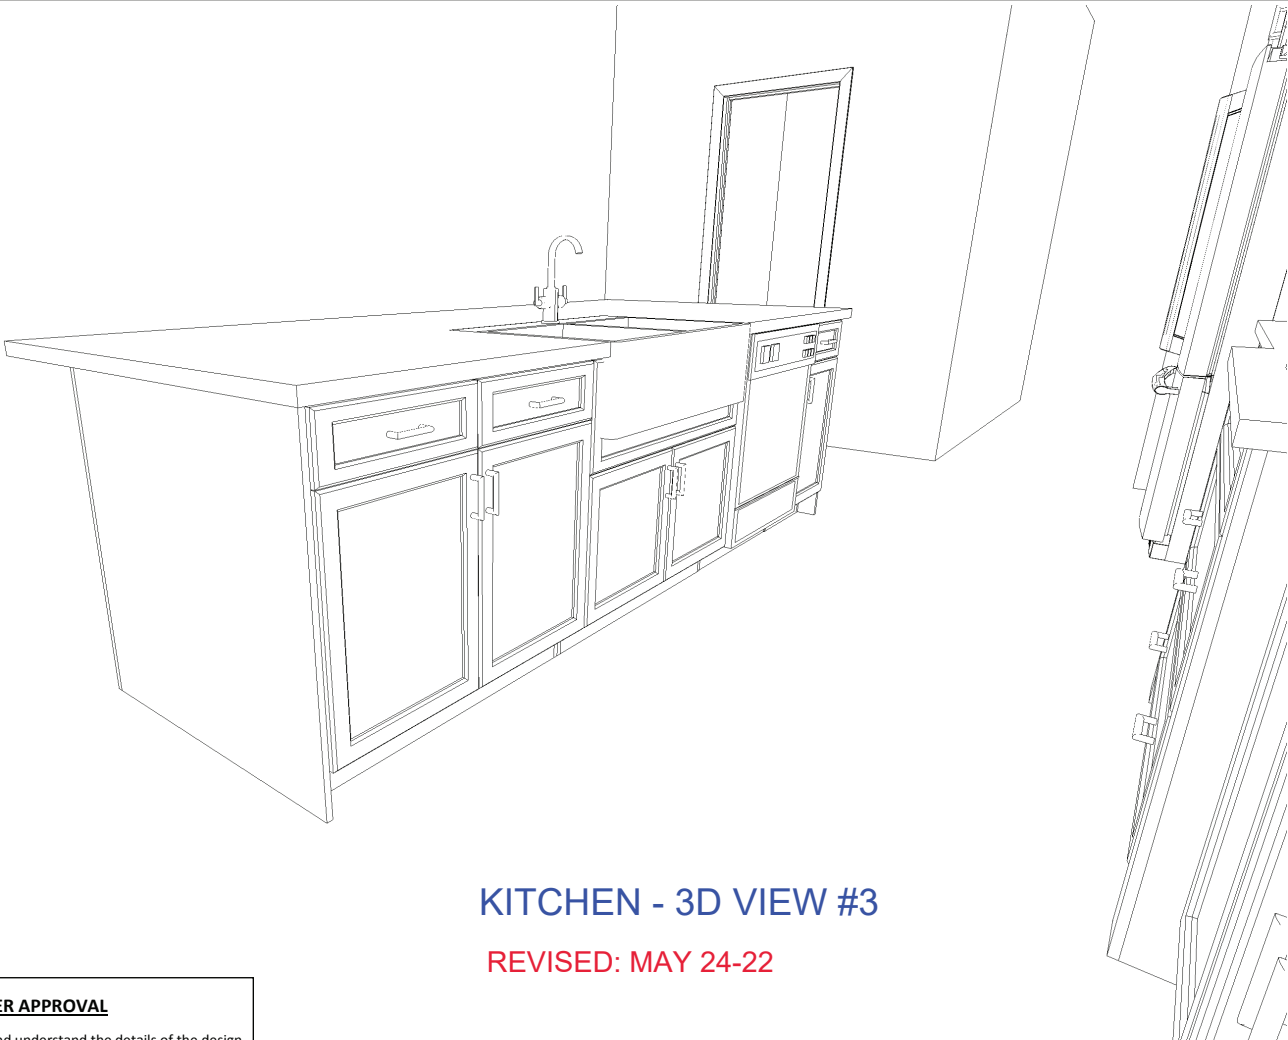

KITCHEN - 3D VIEW #3

REVISED: MAY 24-22

CUSTOMER APPROVAL

I have reviewed these drawings and understand the details of the design and the CARTIER KITCHENS specifications.

Signature \_\_\_\_\_

Date \_\_\_\_\_

Note: This drawing is an artistic interpretation of the general appearance of the design. It is not meant to be an exact rendition.



Designed: 2022-05-23  
Printed: 2022-05-24

DS  
SU

DS  
PM



KITCHEN - 3D VIEW #4

REVISED: MAY 24-22

CUSTOMER APPROVAL

I have reviewed these drawings and understand the details of the design and the CARTIER KITCHENS specifications.

Signature \_\_\_\_\_

Date \_\_\_\_\_

Note: This drawing is an artistic interpretation of the general appearance of the design. It is not meant to be an exact rendition.



Designed: 2022-05-23  
Printed: 2022-05-24

DS  
SU

DS  
PM