



DCR PHOENIX HOMES

LOT #35
DIAMONDVIEW ESTATES - PHASE 2
NEWINGTON
OPTIONAL CHEF'S KITCHEN
MOUNTING HEIGHT: 96

FILL TO CEILING WITH
1"MOULDING, FURRING PANEL &
CEILING CORWN



- CABINETS -
HARDWARE -
STANDARD WHITE INTERIOR
METAL DRAWER BOX
3 PCS - 5/8" KICK - FIN. BOTH ENDS
3 PCS - LOOSE FILLER - 3 x 96
2 PCS - 90 DEG. CORNER MOULD
1 PCS - T-MOULD
1 PCS - FLAT MOULDING

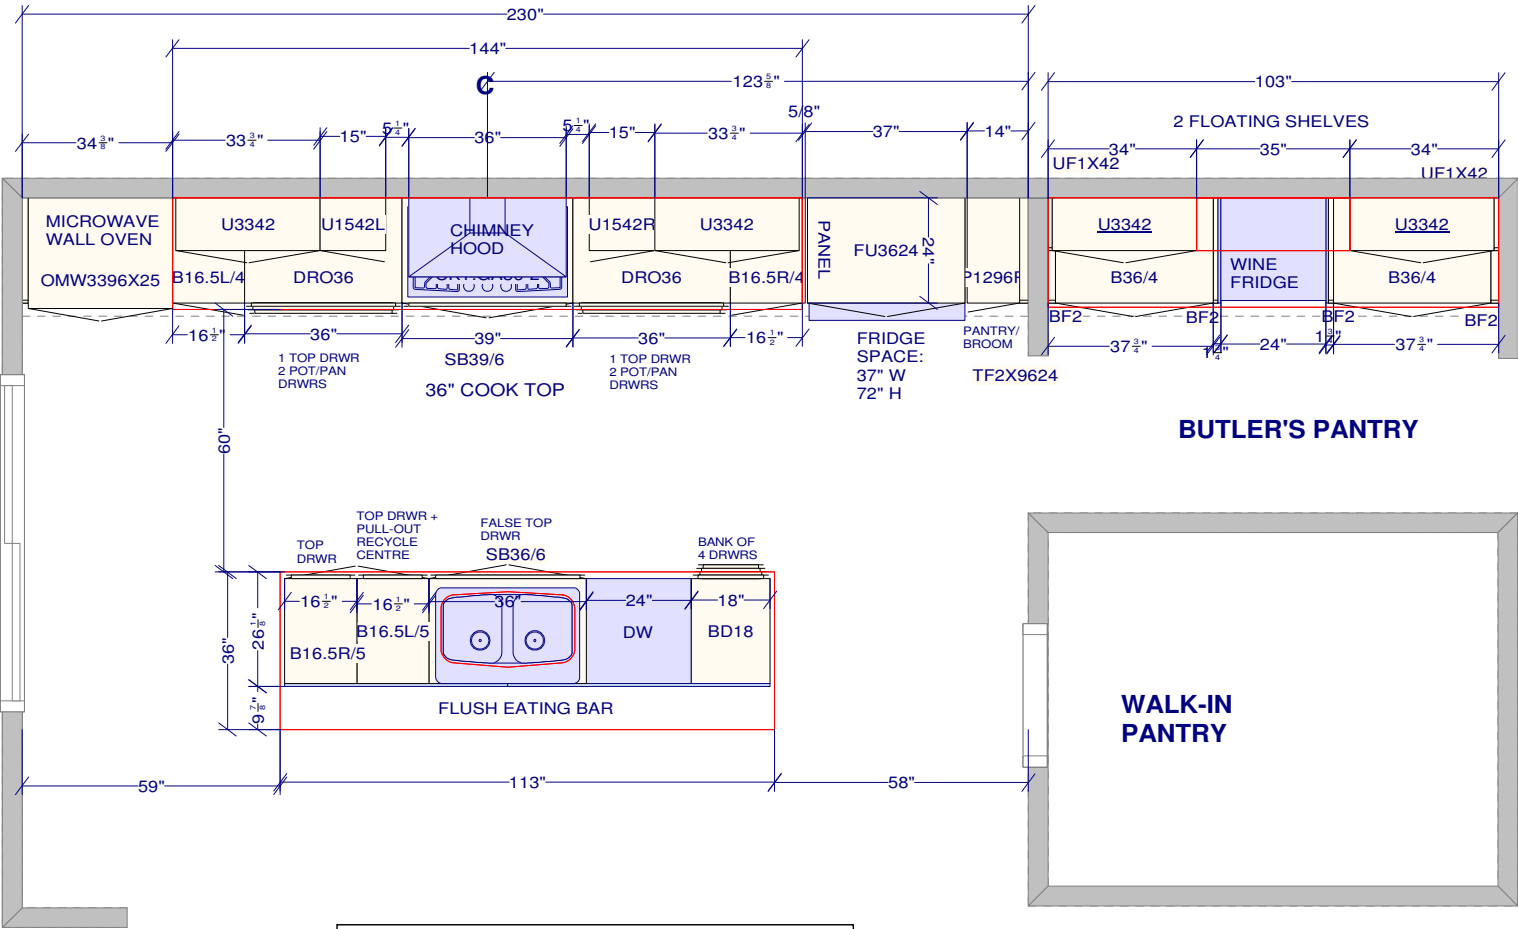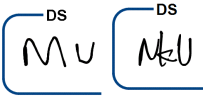

BUTLER'S PANTRY

WALK-IN
PANTRY

CUSTOMER APPROVAL

I have reviewed these drawings and understand the details of the design and the CARTIER KITCHENS specifications.

Signature _____

Date _____

All dimensions size designations given are subject to verification on job site and adjustment to fit job conditions.


SPECTRUM KITCHEN and BATH DESIGN



This is an original design and must not be released or copied unless applicable fee has been paid or job order placed.

DRAWN BY: LORI DISAVERIO, B.I.D

Designed: 2021-09-17
Printed: 2021-09-17

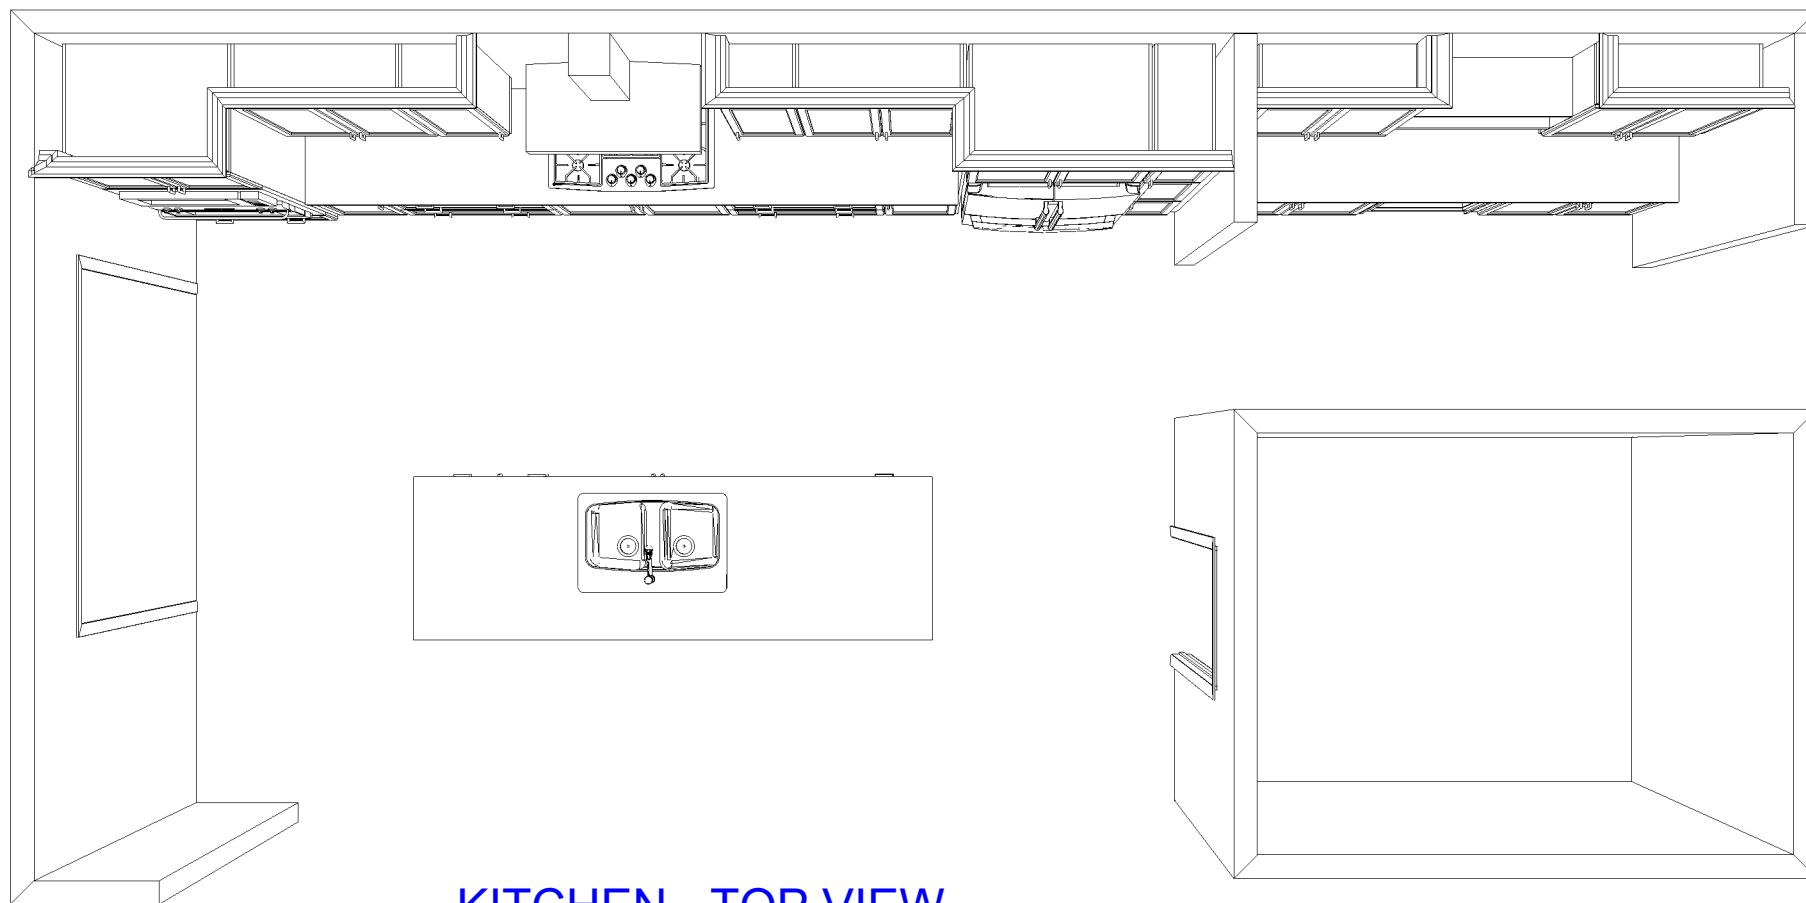

KITCHEN - TOP VIEW

CUSTOMER APPROVAL

I have reviewed these drawings and understand the details of the design and the CARTIER KITCHENS specifications.

Signature _____

Date _____

DS
MU

DS
MKU

Note: This drawing is an artistic interpretation of the general appearance of the design. It is not meant to be an exact rendition.

SPECTRUM KITCHEN and BATH DESIGN





Designed: 2021-09-17
Printed: 2021-09-17

DCR #35 DV 2- NEWINGTON - CHEF'S KITCHEN

All

Drawing #: 1

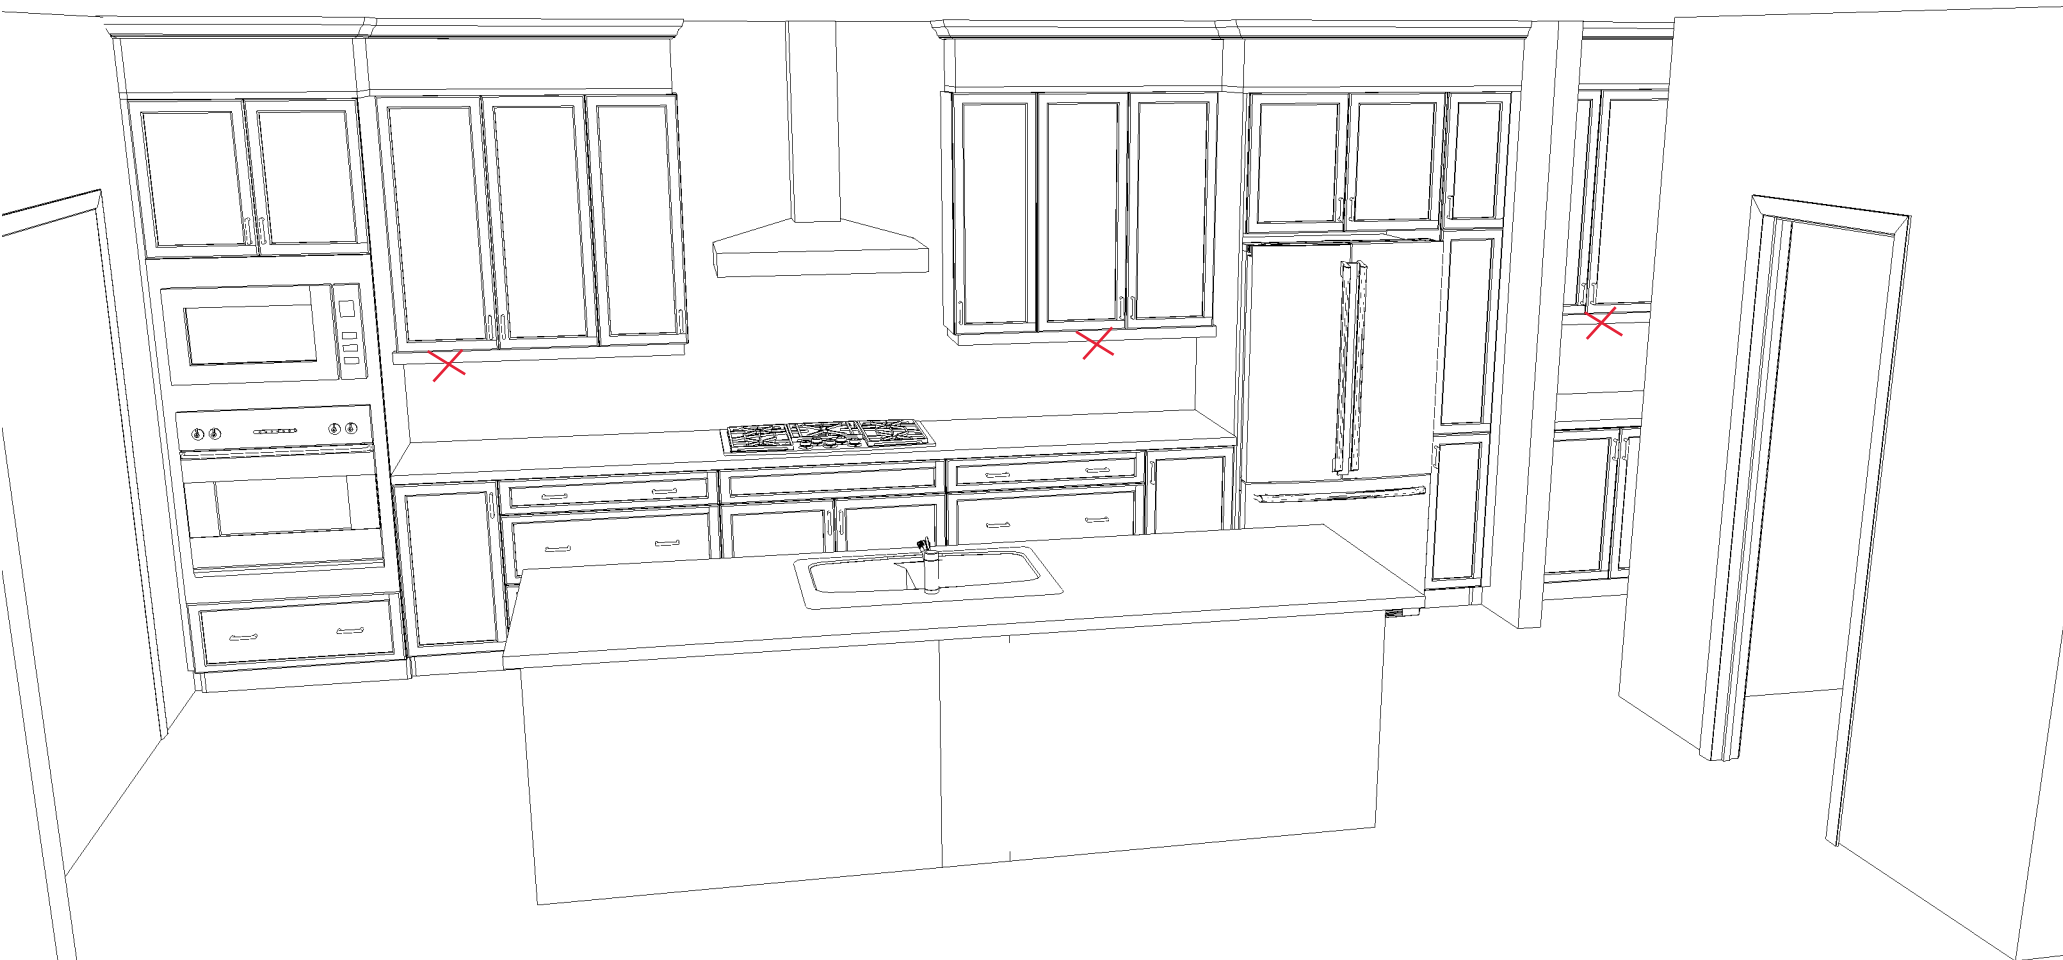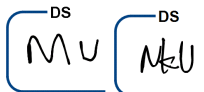

KITCHEN - 3D VIEW #1

CUSTOMER APPROVAL

I have reviewed these drawings and understand the details of the design and the CARTIER KITCHENS specifications.

Signature _____

Date _____

Note: This drawing is an artistic interpretation of the general appearance of the design. It is not meant to be an exact rendition.


SPECTRUM KITCHEN and BATH
DESIGN



Designed: 2021-09-17
Printed: 2021-09-17

DCR #35 DV 2- NEWINGTON - CHEF'S KITCHEN All

Drawing #: 1

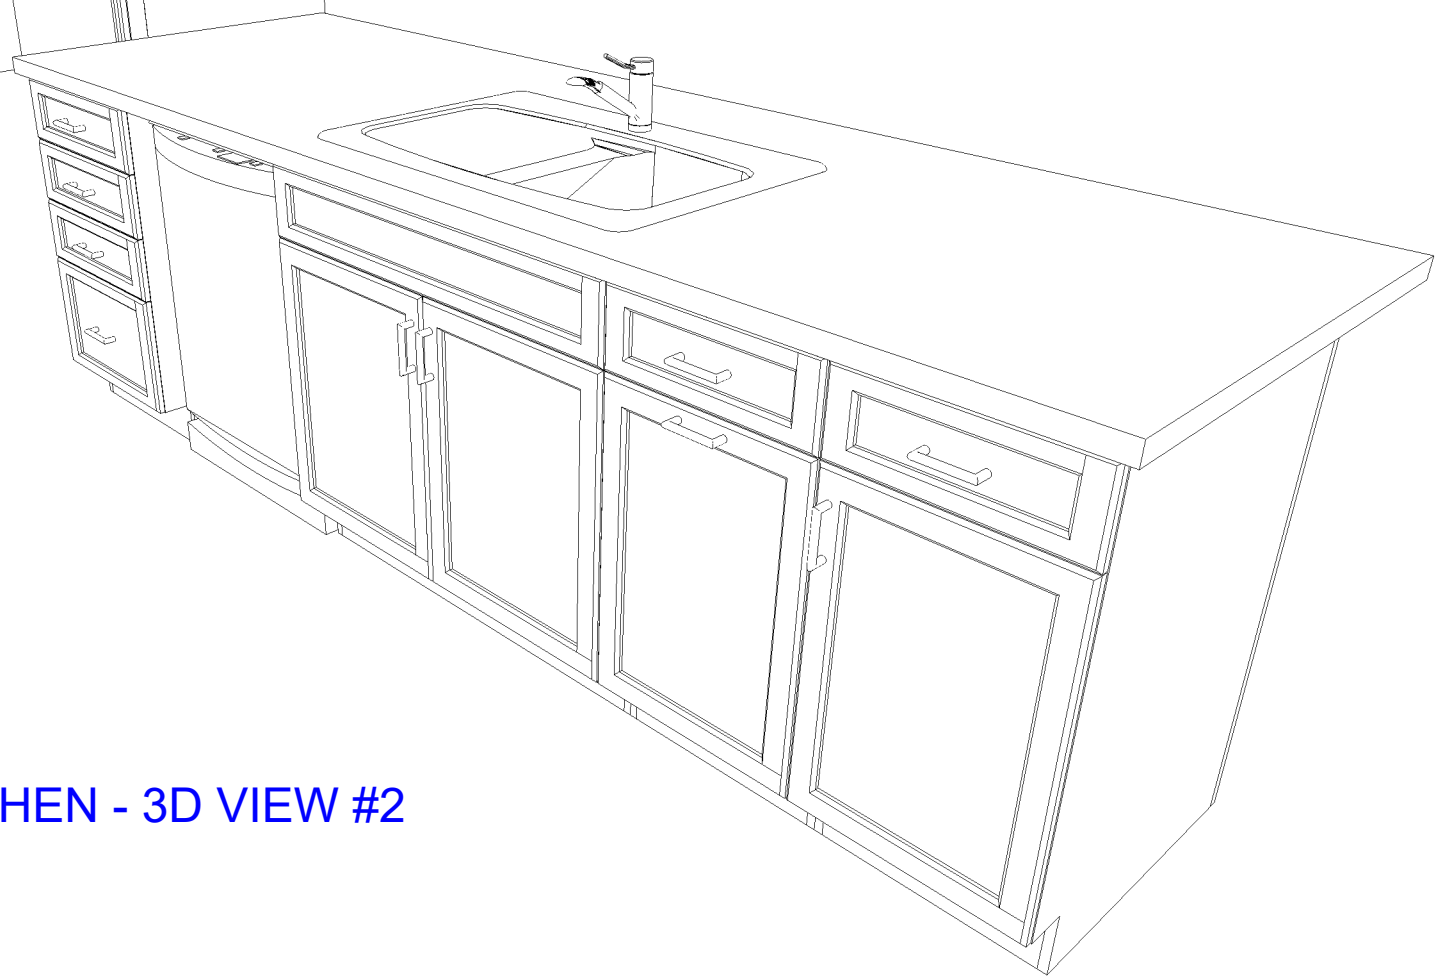

KITCHEN - 3D VIEW #2

CUSTOMER APPROVAL

I have reviewed these drawings and understand the details of the design and the CARTIER KITCHENS specifications.

Signature _____

Date _____

DS
MU

DS
MU

Note: This drawing is an artistic interpretation of the general appearance of the design. It is not meant to be an exact rendition.

SPECTRUM KITCHEN and BATH
DESIGN




Designed: 2021-09-17
Printed: 2021-09-17

DCR #35 DV 2- NEWINGTON - CHEF'S KITCHEN

All

Drawing #: 1

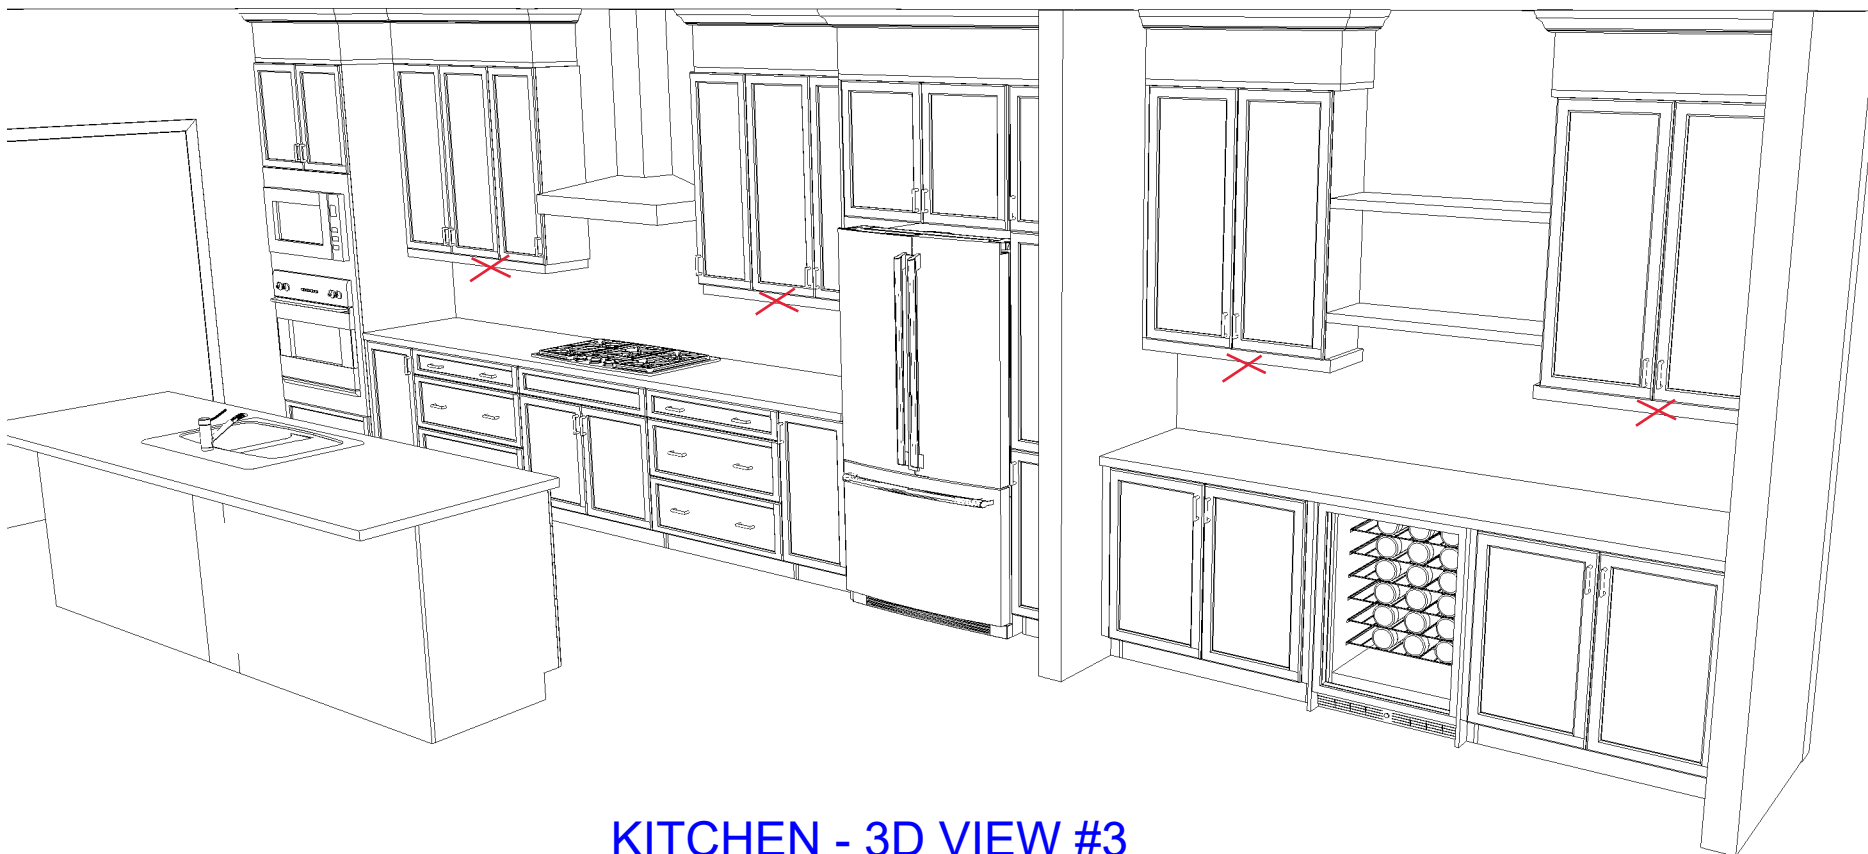

KITCHEN - 3D VIEW #3

CUSTOMER APPROVAL

I have reviewed these drawings and understand the details of the design and the CARTIER KITCHENS specifications.

Signature _____

Date _____

DS
M U

Note: This drawing is an artistic interpretation of the general appearance of the design. It is not meant to be an exact rendition.

SPECTRUM KITCHEN and BATH
DESIGN




Designed: 2021-09-17
Printed: 2021-09-17

DCR #35 DV 2- NEWINGTON - CHEF'S KITCHEN All

Drawing #: 1

FILL TO CEILING WITH
1" SQUARE MOULDING,
PANEL TO CEILING & CEILING CROWN

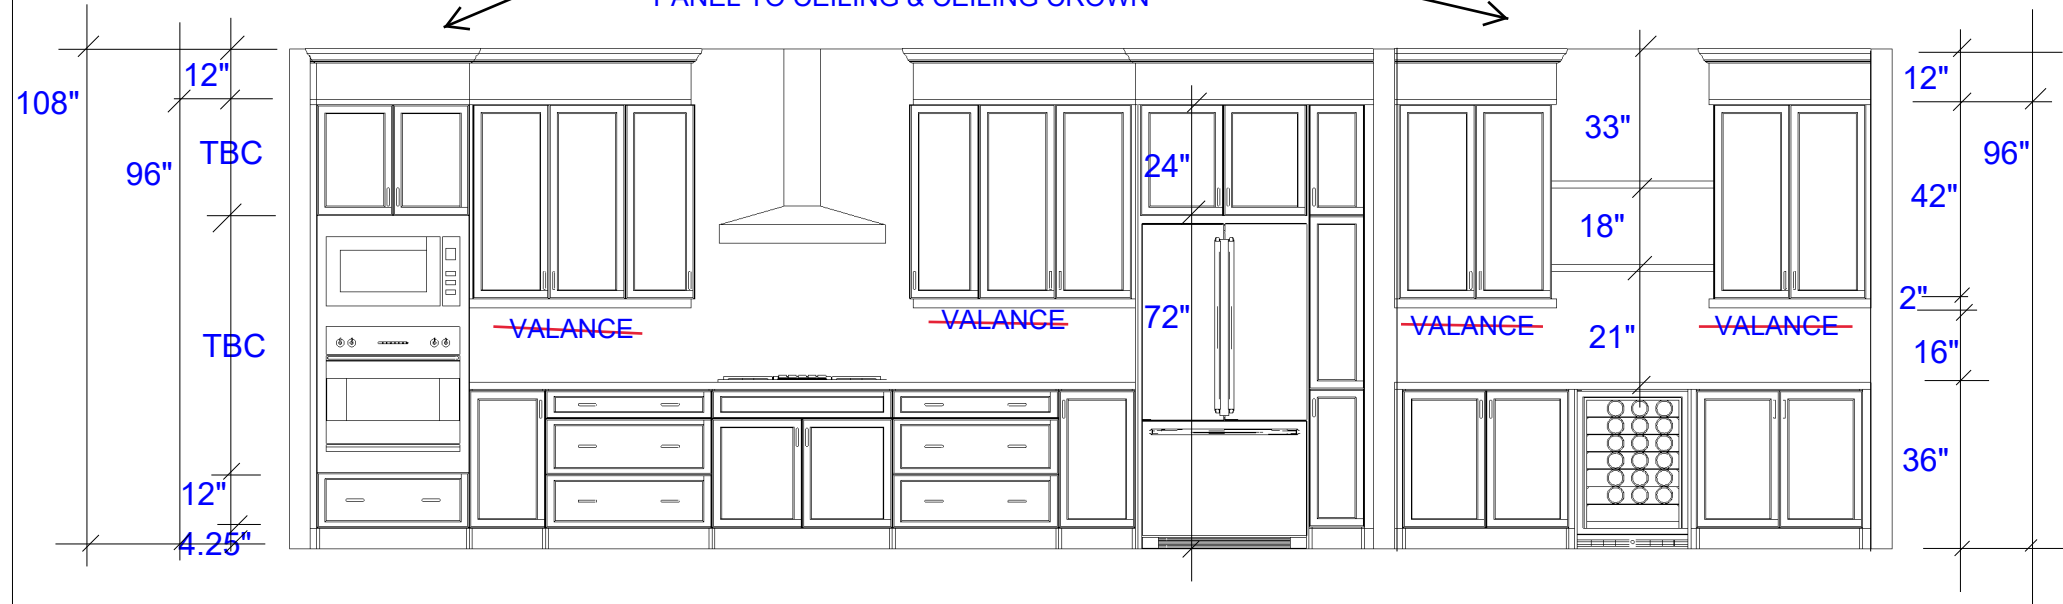

OVEN / COOKTOP / FRIDGE WALL ELEVATION

CUSTOMER APPROVAL

I have reviewed these drawings and understand the details of the design and the CARTIER KITCHENS specifications.

Signature _____

Date _____

DS
MU DS
MKU

Note: This drawing is an artistic interpretation of the general appearance of the design. It is not meant to be an exact rendition.

SPECTRUM KITCHEN and BATH DESIGN



Designed: 2021-09-17
Printed: 2021-09-17

DCR #35 DV 2- NEWINGTON - CHEF'S KITCHEN All

Drawing #: 1