
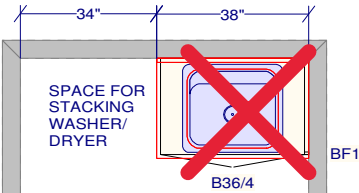
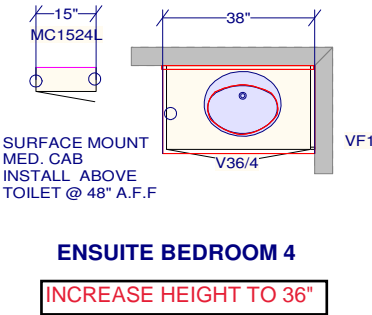
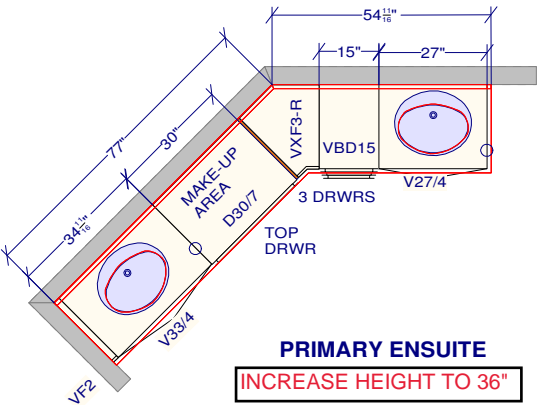


LOT #70
DIAMONDDVIEW ESTATES 1
NEWINGTON (RIGHT)
VANITIES / LAUNDRY

- CABINETS - CARTIER LINE 1 & 2
- HARDWARE - STD & 1ST UPGRADE
- STANDARD WHITE INTERIOR
- METAL DRAWER BOX
- 6 PCS - 5/8" KICK - FIN. BOTH ENDS
- 6 PCS - FLAT MOULDING

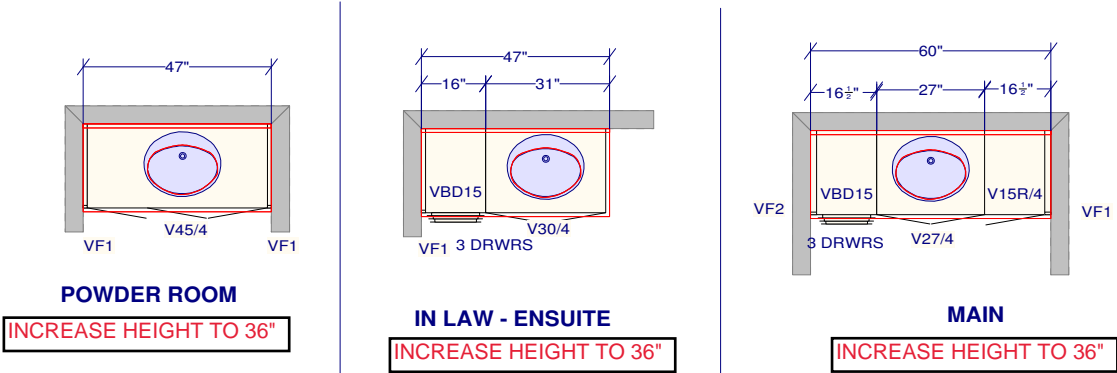

CUSTOMER APPROVAL

I have reviewed these drawings and understand the details of the design and the CARTIER KITCHEN & BATH specifications.

Signature _____

Date **6/29/2022 | 1:46 PM EDT**

LAUNDRY ROOM

BASE CABINET & LAMINATE COUNTERTOP FOR DROP-IN LAUNDRY SINK

All dimensions size designations given are subject to verification on job site and adjustment to fit job conditions.



This is an original design and must not be released or copied unless applicable fee has been paid or job order placed.

Designed: 2022-02-08
Printed: 2022-02-08