

DCR PHOENIX HOMES

LOT #258
PATHWAYS - PHASE 2
MODEL: MIRAPOSA PLUS
KITCHEN & VANITIES

GROUND FLOOR KITCHEN

MOUNTING HEIGHT 96"
42" H UPPIERS @ 18" ABOVE COUNTER
LIGHT VALANCE


CABINETS -
HARDWARE -
STANDARD WHITE INTERIORS
METAL DRAWER BOX
1 PCS - 90 DEG. CORNER MOULD
1 PCS - T MOULD
8 PCS - FLAT MOULDINGS

CUSTOMER APPROVAL


I have reviewed these drawings and understand the details of the design and the CARTIER KITCHENS specifications.

Signature _____
Date _____

REVISED: DEC. 14/21

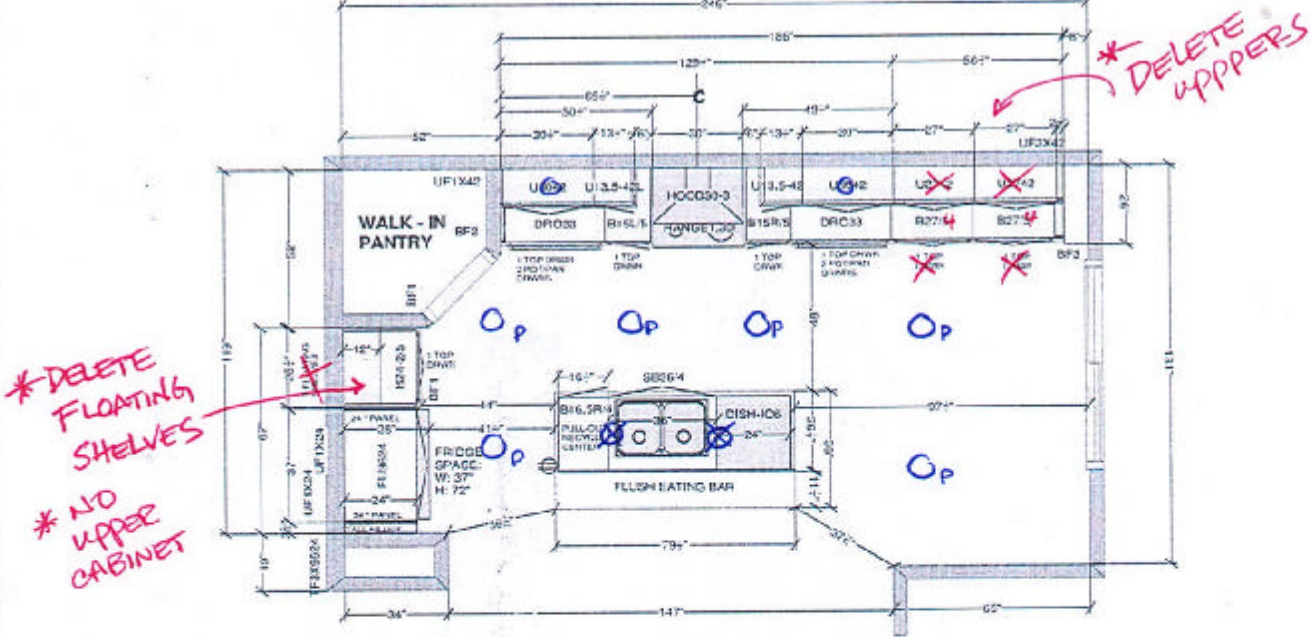

VANITIES

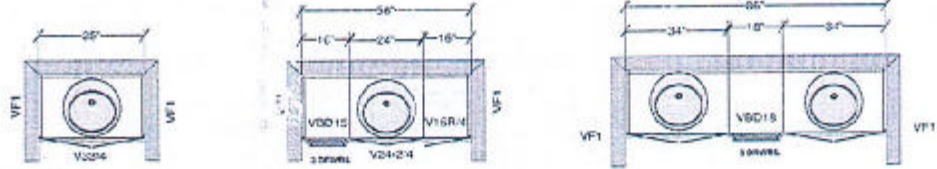

POWDER ROOM

MAIN BATH

OPTIONAL LUXURY ENSUITE

All dimensions, size designations given are subject to verification on job site and adjustment to fit job conditions.



This is an original design and must not be released or copied unless applicable fee has been paid or job order placed.


Designed: 2021-12-09
Printed: 2021-12-10

DCR # 258 Pwys 2 - MIRAPOSA (right) - Kit

All

Drawing #: 1 No Scale.

DS
1/5
DS

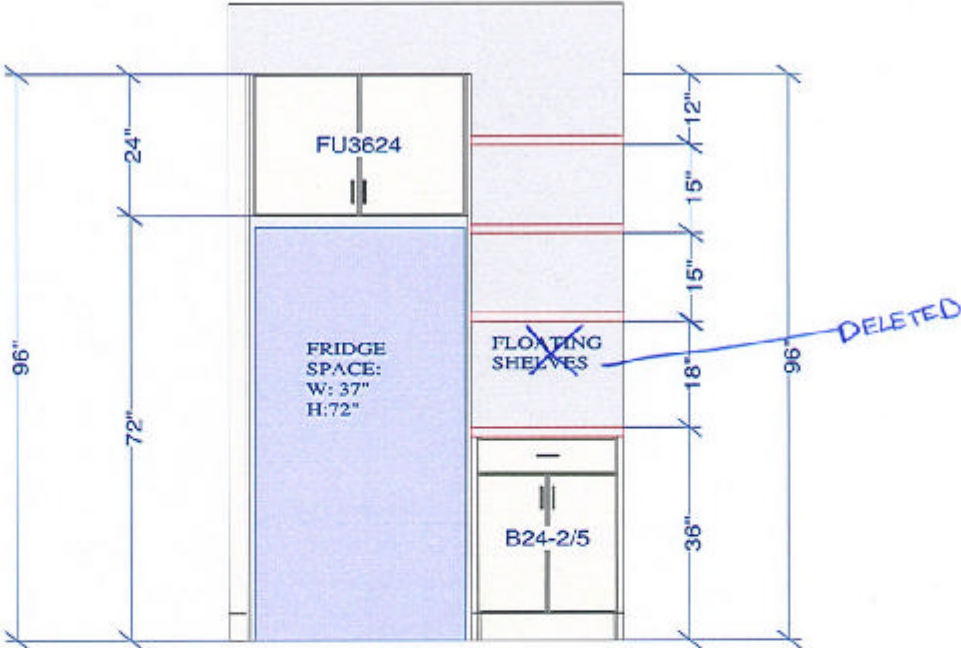

CUSTOMER APPROVAL

I have reviewed these drawings and understand the details of the design and the CARTIER KITCHENS conditions.


Signature: _____


Date: _____

FRIDGE WALL ELEVATION

All dimensions & size designations given are subject to verification on job site and adjustment to fit job conditions.		This is an original design and must not be released or copied unless applicable fee has been paid or job order placed.	Designed: 2021-12-09
			Printed: 2021-12-09
DCR # 258 Pwys 2 - MIRAPOSA (right)- .kit		El 2	Drawing #: 1 No Scale.

DS DS
15 JN

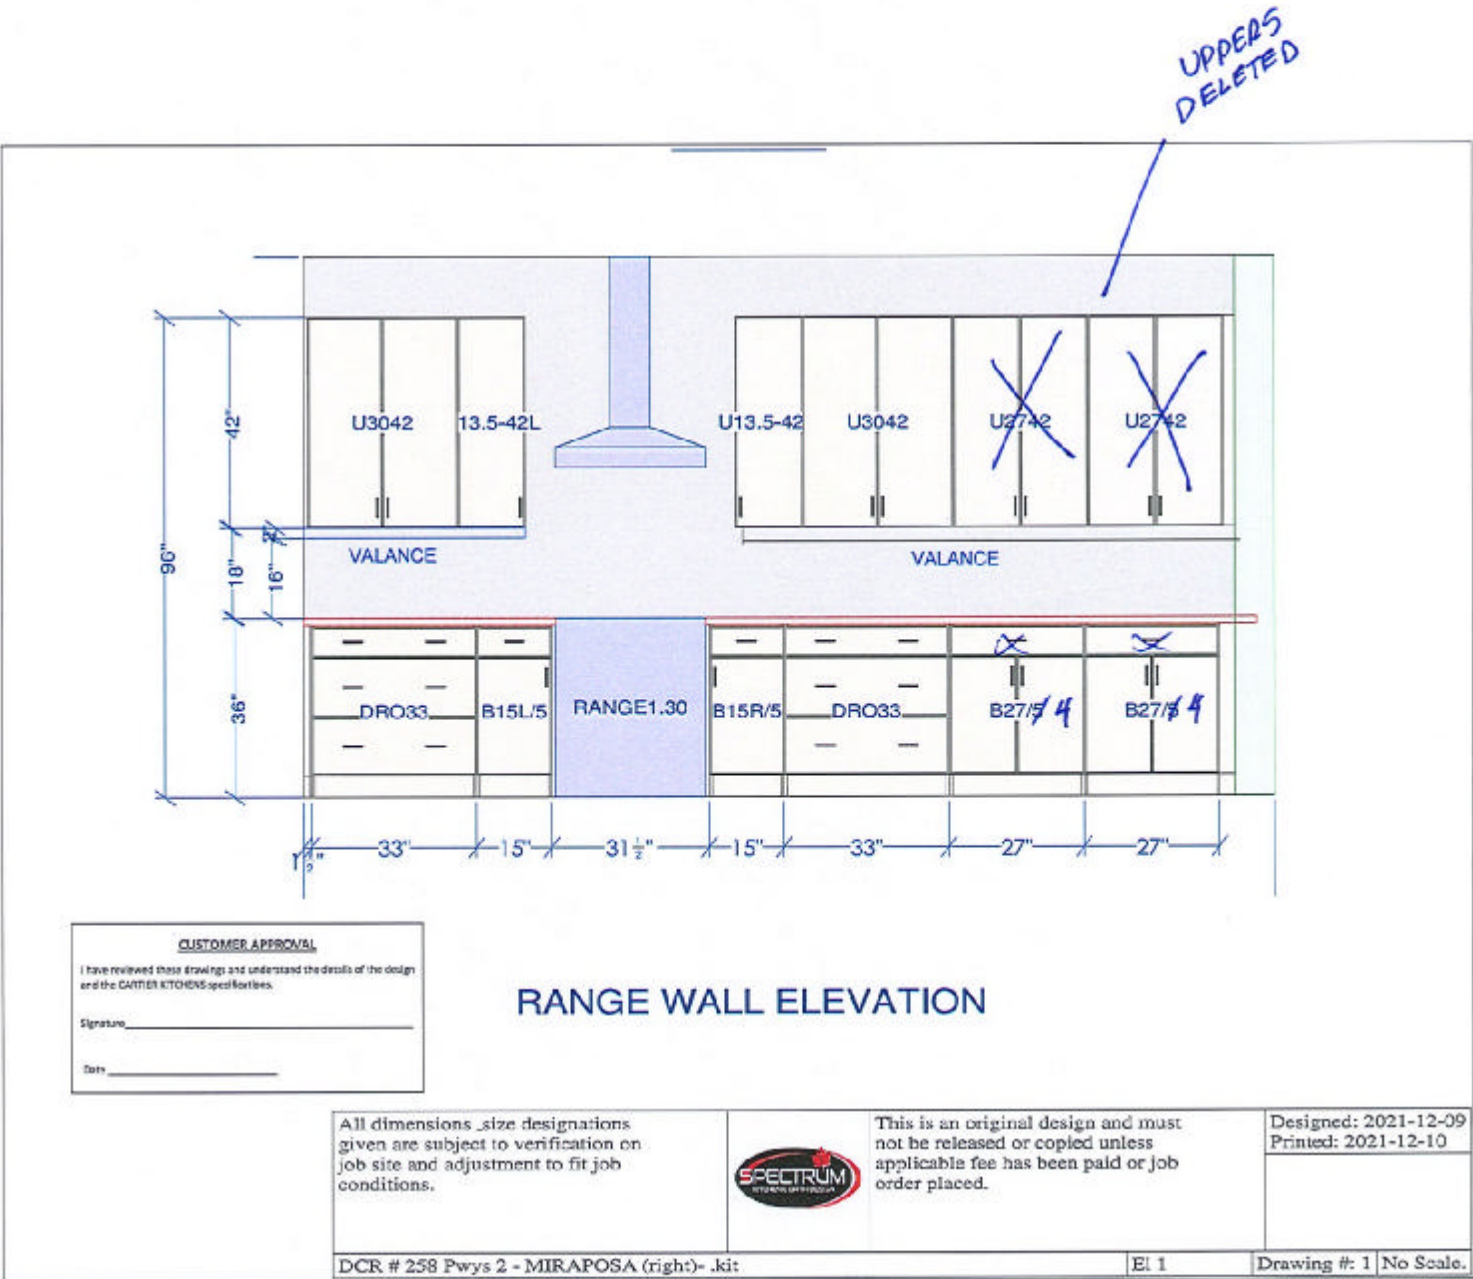

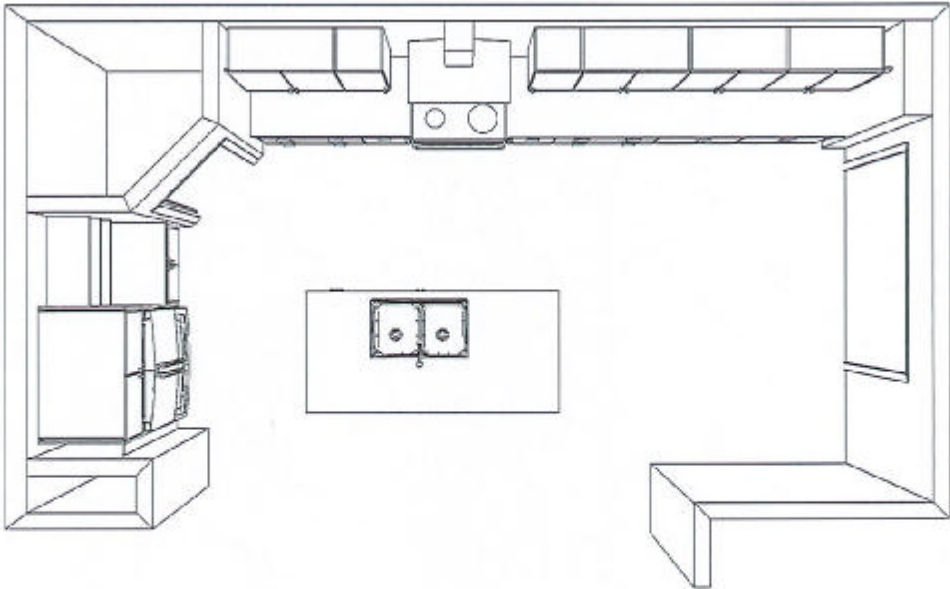


KITCHEN - TOP VIEW

CUSTOMER APPROVAL	
I have reviewed these drawings and understand the details of the design and the CARTIER KITCHENS specifications.	
Signature _____	
Date _____	

Note: This drawing is an artistic interpretation of the general appearance of the design. It is not meant to be an exact rendition.		Designed: 2021-12-09
		Printed: 2021-12-10
DCR # 258 Pwys 2 - MIRAPOSA (right)- .kit	All	Drawing #: 1


DS DS
15 JN

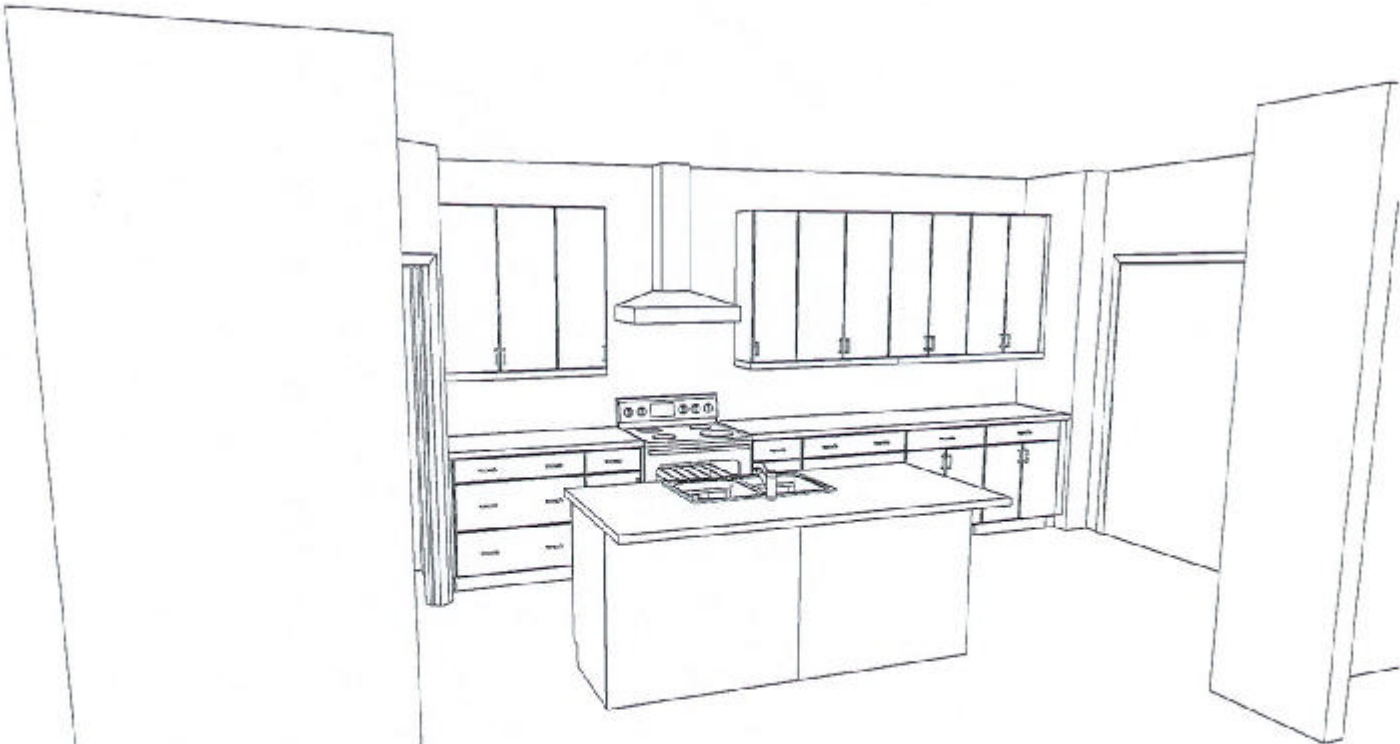

KITCHEN - 3D VIEW #1

CUSTOMER APPROVAL	
I have reviewed these drawings and understand the details of the design and the CARTIER KITCHENS specifications.	
Signature _____	
Date _____	

Note: This drawing is an artistic interpretation of the general appearance of the design. It is not meant to be an exact rendition.		Designed: 2021-12-09
		Printed: 2021-12-10
DCR # 258 Pwys 2 - MIRAPOSA (right)- .kit	All	Drawing #: 1

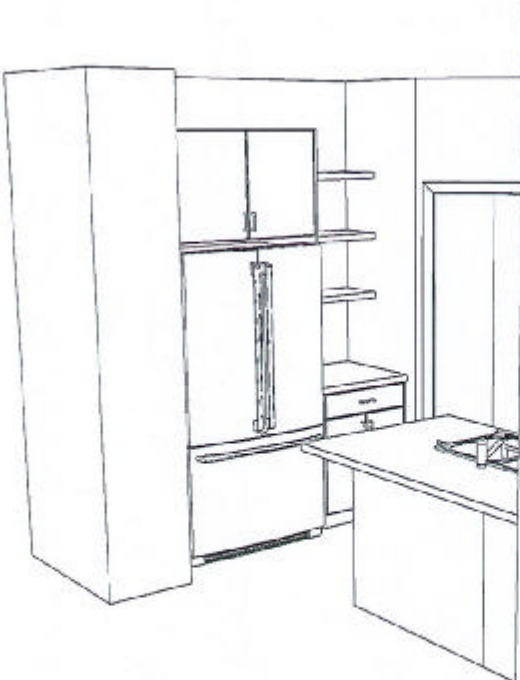

KITCHEN - 3D VIEW #2

CUSTOMER APPROVAL	
I have reviewed these drawings and understand the details of the design and the CARTER KITCHENS specifications.	
Signature _____	
Date _____	

Note: This drawing is an artistic interpretation of the general appearance of the design. It is not meant to be an exact rendition.		Designed: 2021-12-09
		Printed: 2021-12-09
DCR # 258 Pwys 2 - MIRAFOSA (right)- .kit	All	Drawing #: 1

DS DS
15 JN



KITCHEN - 3D VIEW #3

CUSTOMER APPROVAL

I have reviewed these drawings and understand the details of the design and the CARTIER KITCHENS specifications.

Signature: _____

Date: _____


Note: This drawing is an artistic interpretation of the general appearance of the design. It is not meant to be an exact rendition.




Designed: 2021-12-09
Printed: 2021-12-09

DCR # 258 Pwys 2 - MIRAPOSA (right)- .kit	All	Drawing #: 1
---	-----	--------------


VANITIES

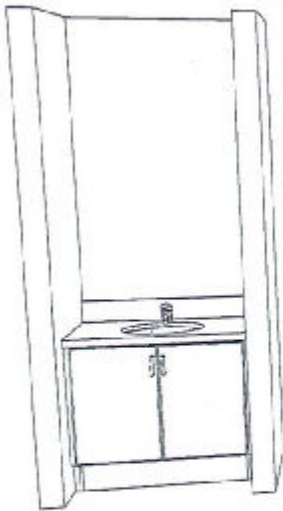

POWDER ROOM

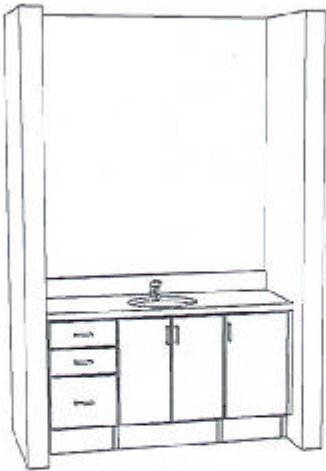

MAIN BATH

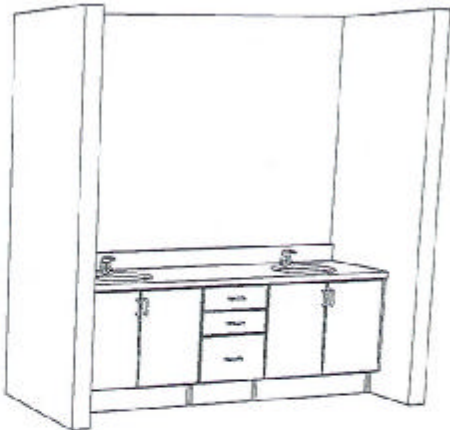

ENSUITE

CUSTOMER APPROVAL

I have reviewed these drawings and understand the details of the design and the CARTIER KITCHENS specifications.

Signature _____

Date _____

Note: This drawing is an artistic interpretation of the general appearance of the design. It is not meant to be an exact rendition.



Designed: 2021-12-09
Printed: 2021-12-10

DCR # 258 Pwys 2 - MIRAPOSA (right)- .kit

All

Drawing #: 1