

LOT #3-43
WHITE TAIL RIDGE 3
PLATINA (512) - GARAGE RIGHT
KITCHEN
WITH WALK-IN PANTRY


MOUNTING HT: 96"

42"H UPPERS @ 18" ABOVE COUNTER
EACH SIDE OF COOKTOP - 39"H UPPERS @
21" ABOVE COUNTER.

LIGHT VALANCE

FILL TO CEILING WITH 1" MOULDING,
FURRING PANEL & CEILING CROWN

- CABINETS -:
- HARDWARE -
- STD WHITE INTERIORS
- STD METAL DRAWER BOXES
- STD HINGES
- 4 - PCS - TOE KICK
- 5 PCS - FLAT SHOE MOULDING
- 2 - PCS. 90 DEG. CORNER MOULD.
- 1 PC - T MOULD

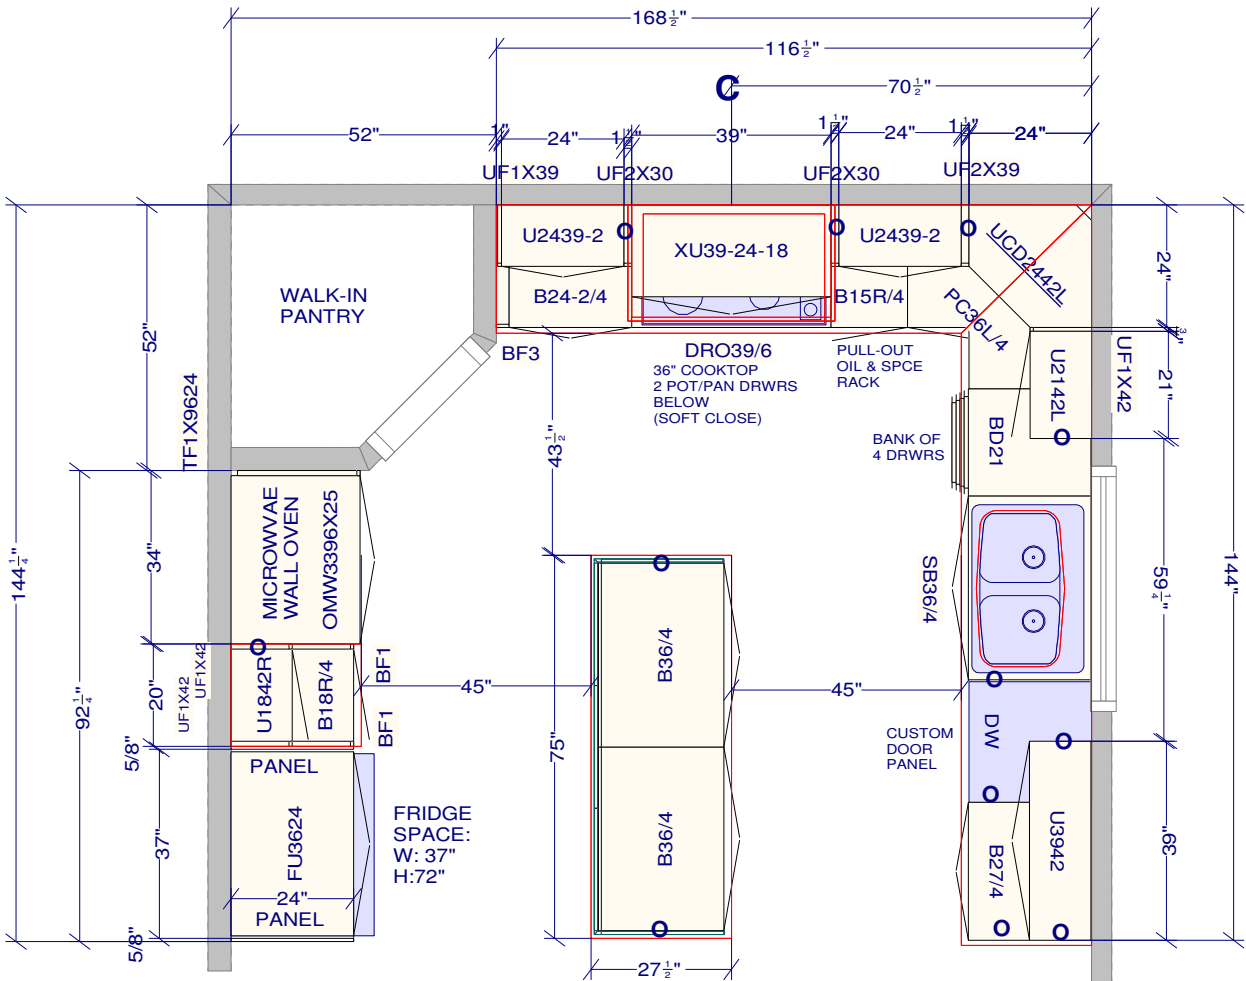

CUSTOMER APPROVAL

I have reviewed these drawings and understand the details of the design and the CARTIER KITCHENS specifications.

Signature _____

Date _____

NOTE:
EXTENDED EATING
COUNTR DELETED

~~Dummy doors & drawers~~
ON BACK & SIDES OF ISLAND


DS
FZ
DS

All dimensions size designations given are subject to verification on job site and adjustment to fit job conditions.



This is an original design and must not be released or copied unless applicable fee has been paid or job order placed.

Designed: 2021-11-26
Printed: 2021-11-26

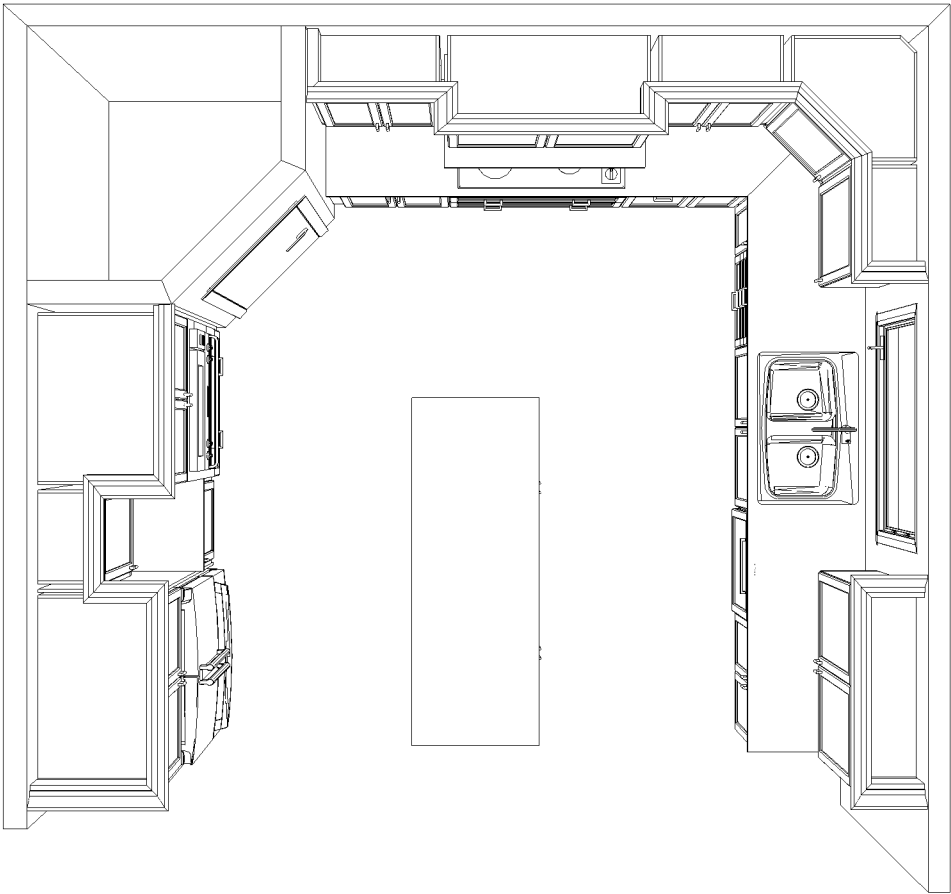

KITCHEN - TOP VIEW

CUSTOMER APPROVAL

I have reviewed these drawings and understand the details of the design and the CARTIER KITCHENS specifications.

Signature _____

Date _____

DS DS
F K [Signature]

Note: This drawing is an artistic interpretation of the general appearance of the design. It is not meant to be an exact rendition.



Designed: 2021-11-26
Printed: 2021-11-26



Deleted dummy doors on back
and side of island

KITCHEN - 3D VIEW #1

CUSTOMER APPROVAL

I have reviewed these drawings and understand the details of the design and the CARTIER KITCHENS specifications.

Signature _____

Date _____

Note: This drawing is an artistic interpretation of the general appearance of the design. It is not meant to be an exact rendition.



Designed: 2021-11-26
Printed: 2021-11-26

DS
FK
DS



Deleted dummy doors on back
and side of island

KITCHEN - 3D VIEW #2

DS DS
FX [Signature]

CUSTOMER APPROVAL

I have reviewed these drawings and understand the details of the design and the CARTIER KITCHENS specifications.


Signature _____

Date _____

Note: This drawing is an artistic interpretation of the general appearance of the design. It is not meant to be an exact rendition.



Designed: 2021-11-26
Printed: 2021-11-26

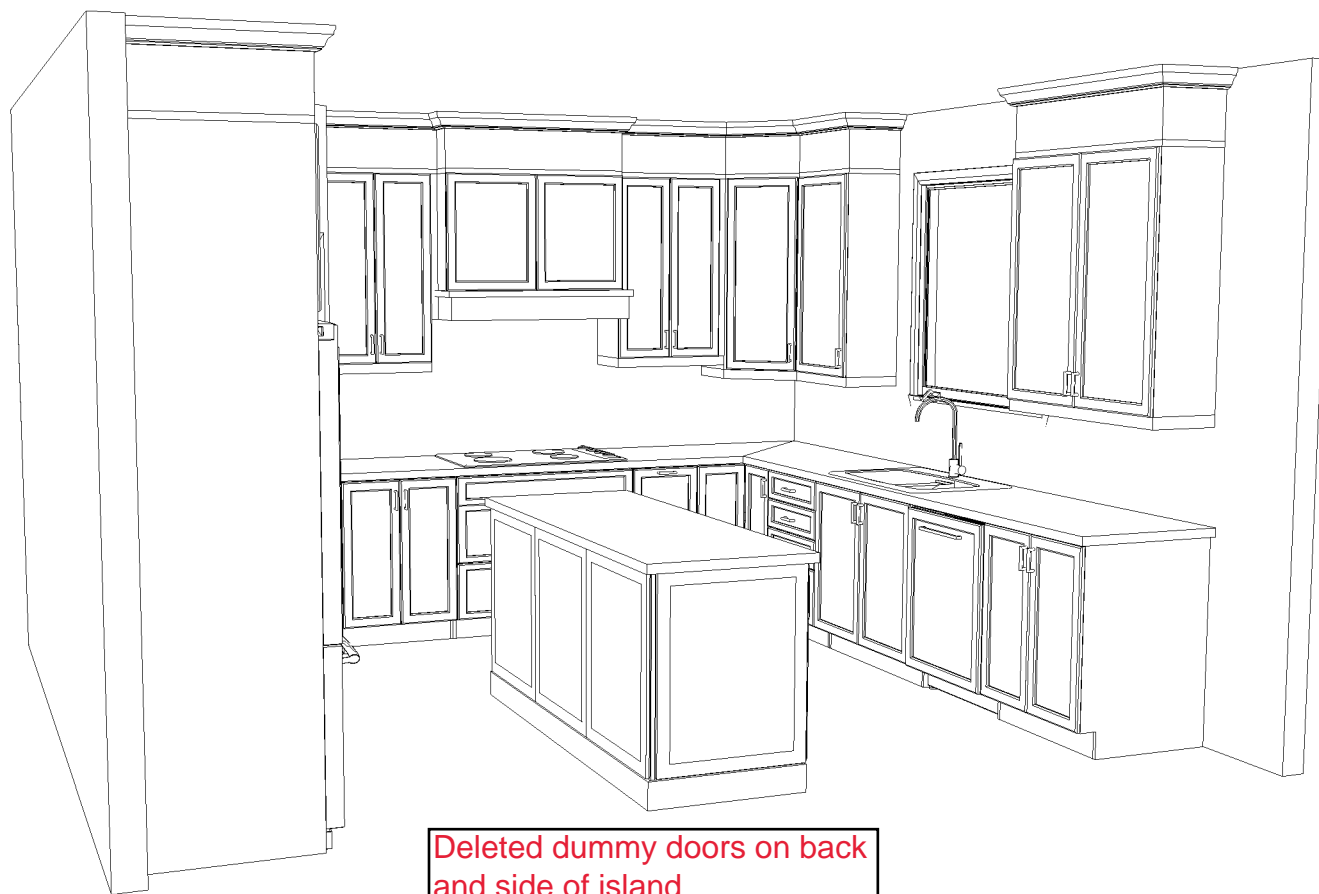

Deleted dummy doors on back
and side of island

KITCHEN - 3D VIEW #3

CUSTOMER APPROVAL

I have reviewed these drawings and understand the details of the design and the CARTIER KITCHENS specifications.

Signature _____


Date _____

DS DS
FX [Signature]

Note: This drawing is an artistic interpretation of the general appearance of the design. It is not meant to be an exact rendition.



Designed: 2021-11-26
Printed: 2021-11-26

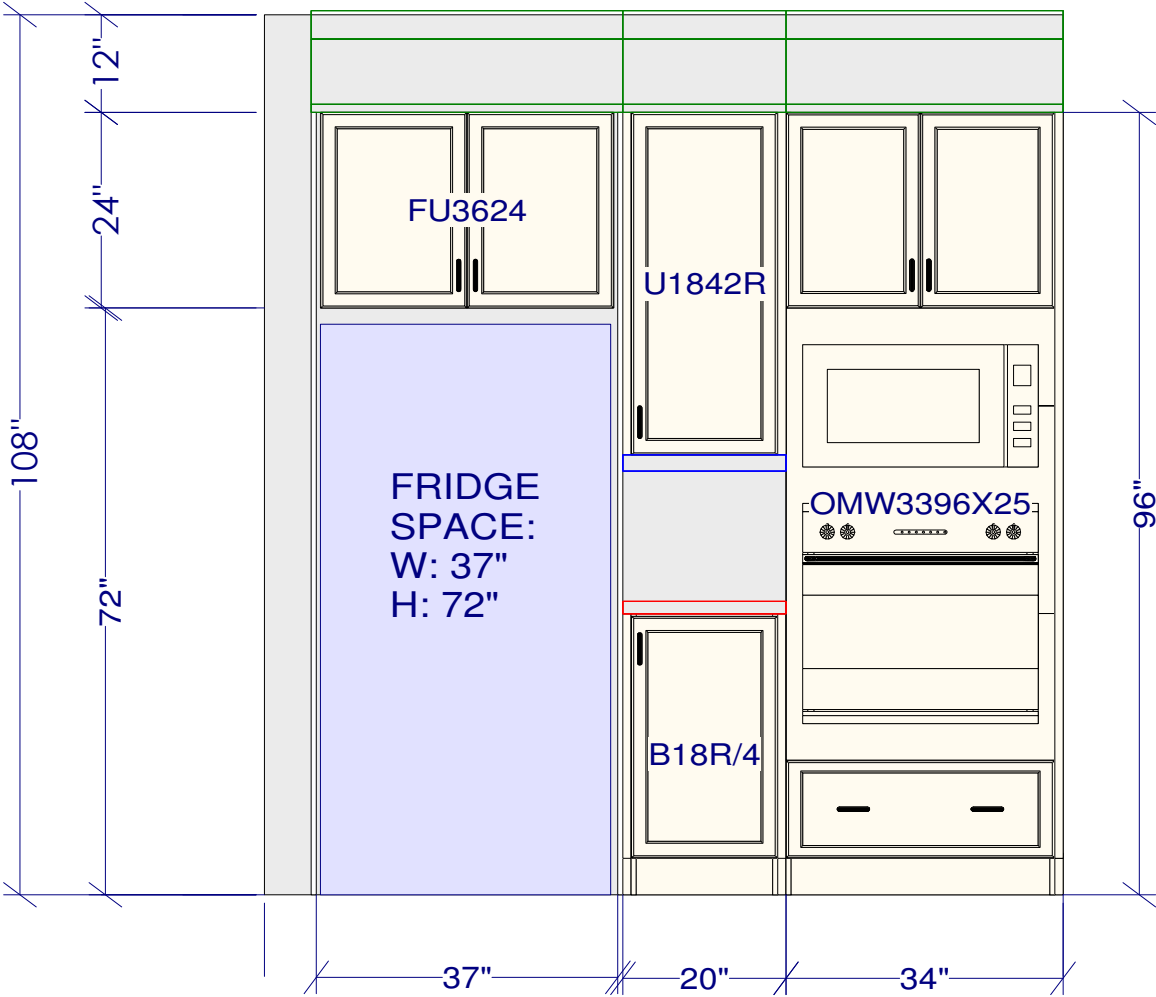

FRIDGE/ OVEN WALL ELEVATION

DS
FK
DS

CUSTOMER APPROVAL
I have reviewed these drawings and understand the details of the design and the CARTIER KITCHENS specifications.

Signature _____


Date _____

All dimensions _size designations given are subject to verification on job site and adjustment to fit job conditions.



This is an original design and must not be released or copied unless applicable fee has been paid or job order placed.

Designed: 2021-11-26
Printed: 2021-11-26

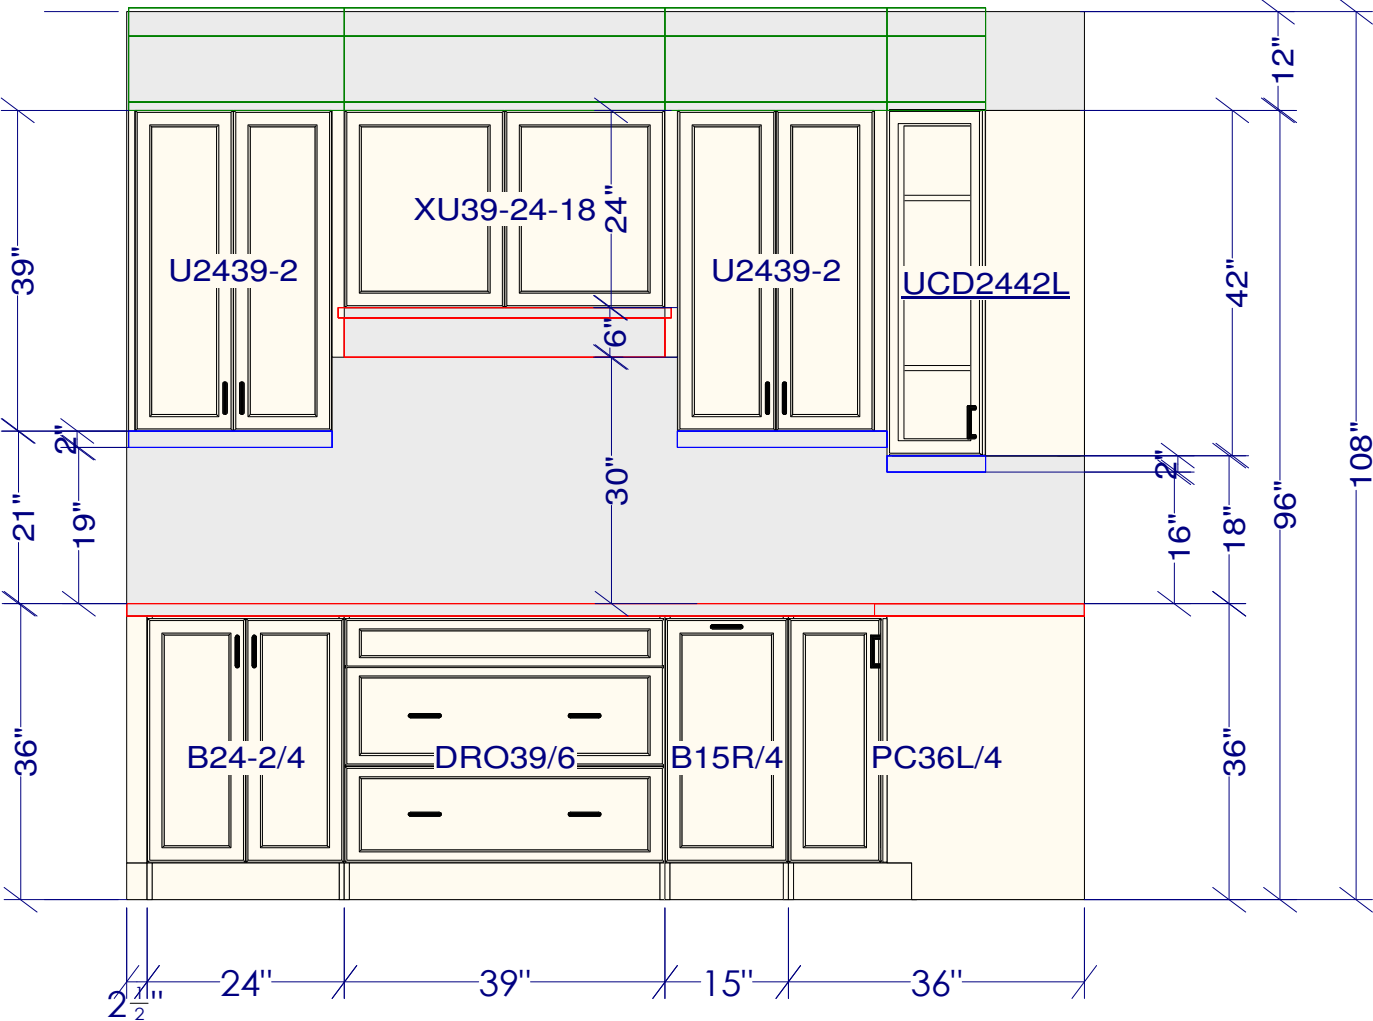

COOKTOP WALL ELEVATION

DS
FX
DS
log

CUSTOMER APPROVAL

I have reviewed these drawings and understand the details of the design and the CARTIER KITCHENS specifications.

Signature _____


Date _____

All dimensions _size designations given are subject to verification on job site and adjustment to fit job conditions.



This is an original design and must not be released or copied unless applicable fee has been paid or job order placed.

Designed: 2021-11-26
Printed: 2021-11-26

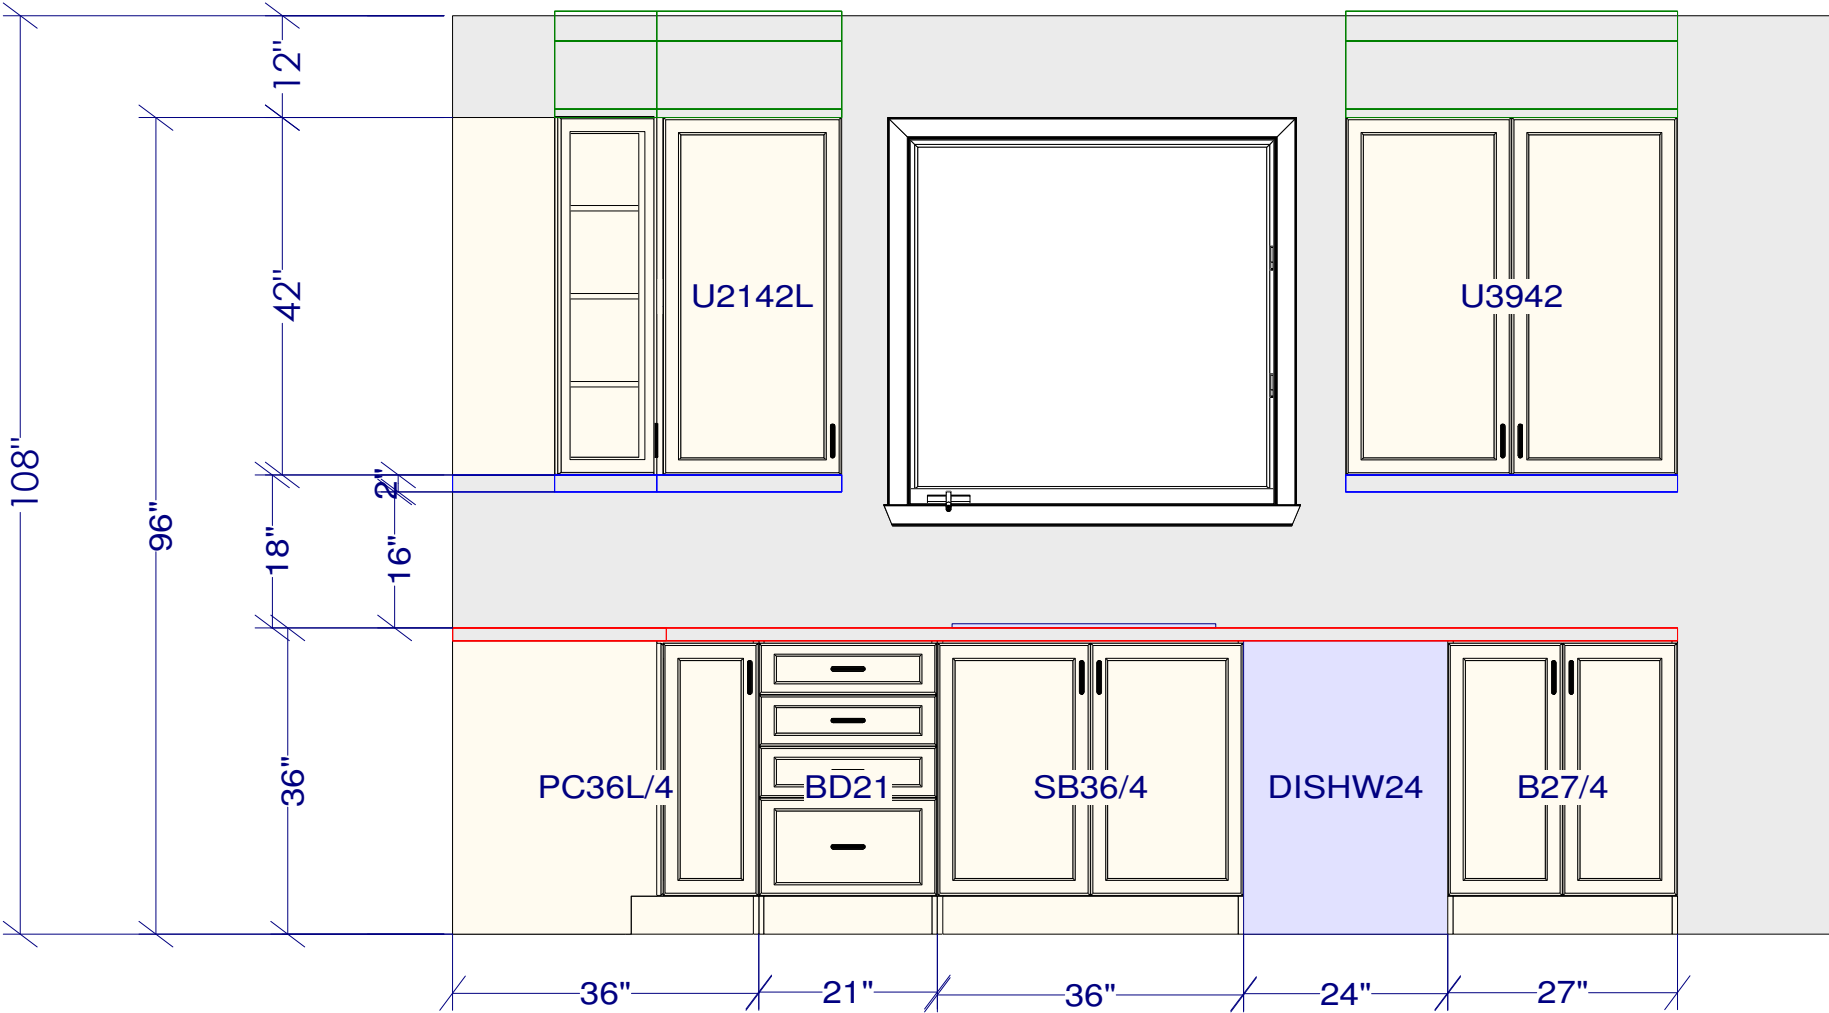

SINK WALL ELEVATION

DS DS
F K W

CUSTOMER APPROVAL

I have reviewed these drawings and understand the details of the design and the CARTIER KITCHENS specifications.

Signature _____

Date _____

All dimensions _size designations given are subject to verification on job site and adjustment to fit job conditions.



This is an original design and must not be released or copied unless applicable fee has been paid or job order placed.

Designed: 2021-11-26
Printed: 2021-11-26