

LOT #3- 62
WHITE TAIL RIDGE 3
NEWINGTON
OPTIONAL CHEF'S KITCHEN (LEFT)

MOUNTING HEIGHT: 105 1/2"


33"H UPPERS @ 18" ABOVE COUNTER +
18"H UPPERS SATCKED ABOVE

FILLER TO CEILING (APPROX. 3"H)

~~LIGHT VALANACE~~

- KITCHEN
CABINETS -
HARDWARE -
STANDARD WHITE INTERIOR
SOFT CLOSE DOORS & DRAWERS
4 PCS - 5/8" KICK - FIN. BOTH ENDS
4 PCS - FURRING - 6 x 96
2 PCS - 90 DEG. CORNER MOULD
5 PCS - FLAT MOULDING

REVISED: JUNE 21-22

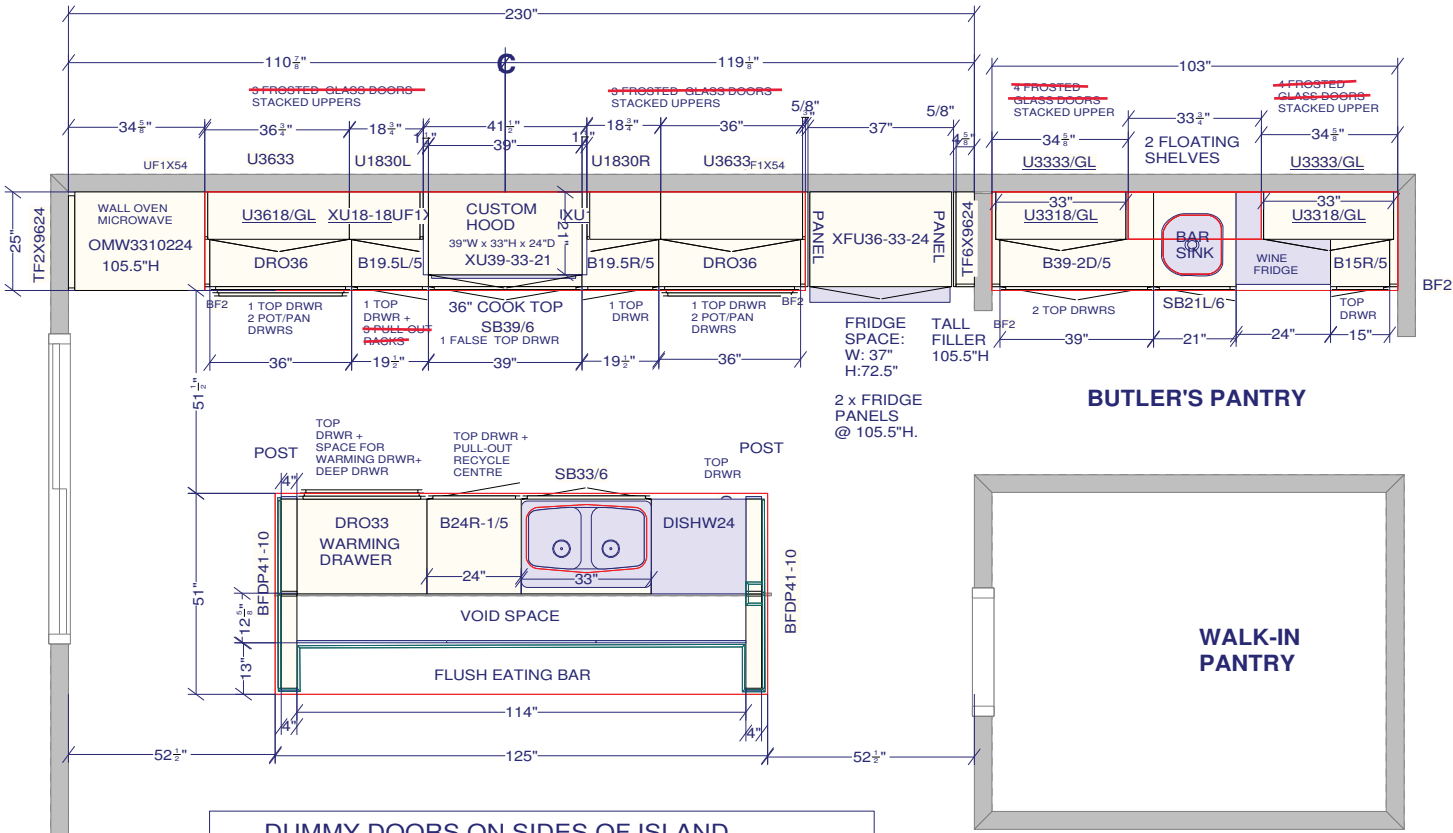

DUMMY DOORS ON SIDES OF ISLAND
FLUSH KICK ON BACK AND SIDES OF ISLAND

CUSTOMER APPROVAL

I have reviewed these drawings and understand the details of the design
and the CARTIER KITCHENS specifications.

Signature _____

Date _____


All dimensions _size designations
given are subject to verification on
job site and adjustment to fit job
conditions.



This is an original design and must
not be released or copied unless
applicable fee has been paid or job
order placed.

Designed: 2022-06-21
Printed: 2022-06-21

DS
MJC
DS

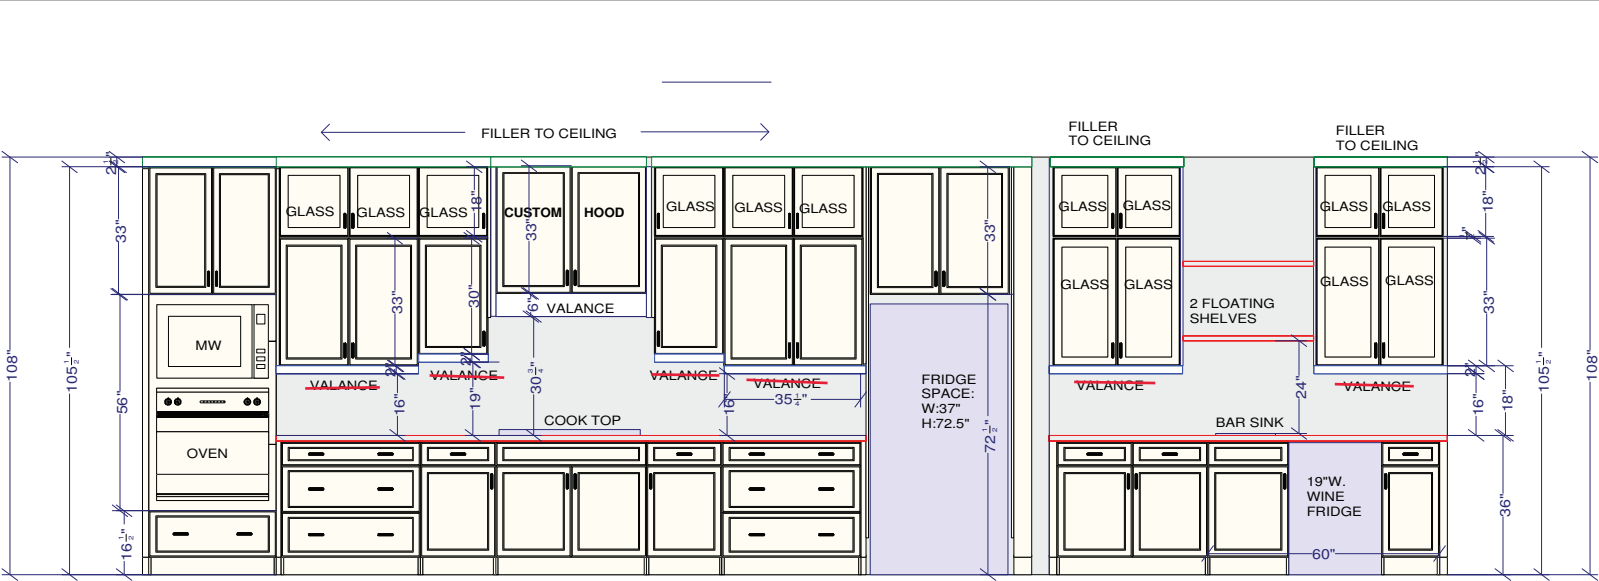

FRIDGE / COOKTOP/ OVEN WALL ELEVATION

BUTLER'S PANTRY ELEVATION

REVISED: JUNE 21-22


CUSTOMER APPROVAL

I have reviewed these drawings and understand the details of the design and the CARTIER KITCHENS specifications.

Signature_____

Date_____

All dimensions ,size designations given are subject to verification on job site and adjustment to fit job conditions.		This is an original design and must not be released or copied unless applicable fee has been paid or job order placed.	Designed: 2022-06-21 Printed: 2022-06-21	
				

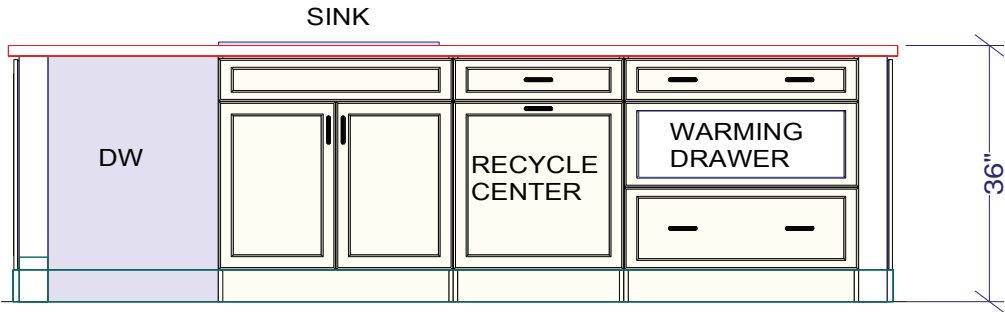

ISLAND ELEVATION

REVISED: JUNE 21-22


CUSTOMER APPROVAL

I have reviewed these drawings and understand the details of the design and the CARTIER KITCHENS specifications.

Signature_____

Date _____

All dimensions _size designations given are subject to verification on job site and adjustment to fit job conditions.		This is an original design and must not be released or copied unless applicable fee has been paid or job order placed.	Designed: 2022-06-21 Printed: 2022-06-21	
				
DCR #3-62 White Tail Ridge 3 - Newington Chef's Kitchen 2.kit			EI 4	Drawing #: 1 No Scale.

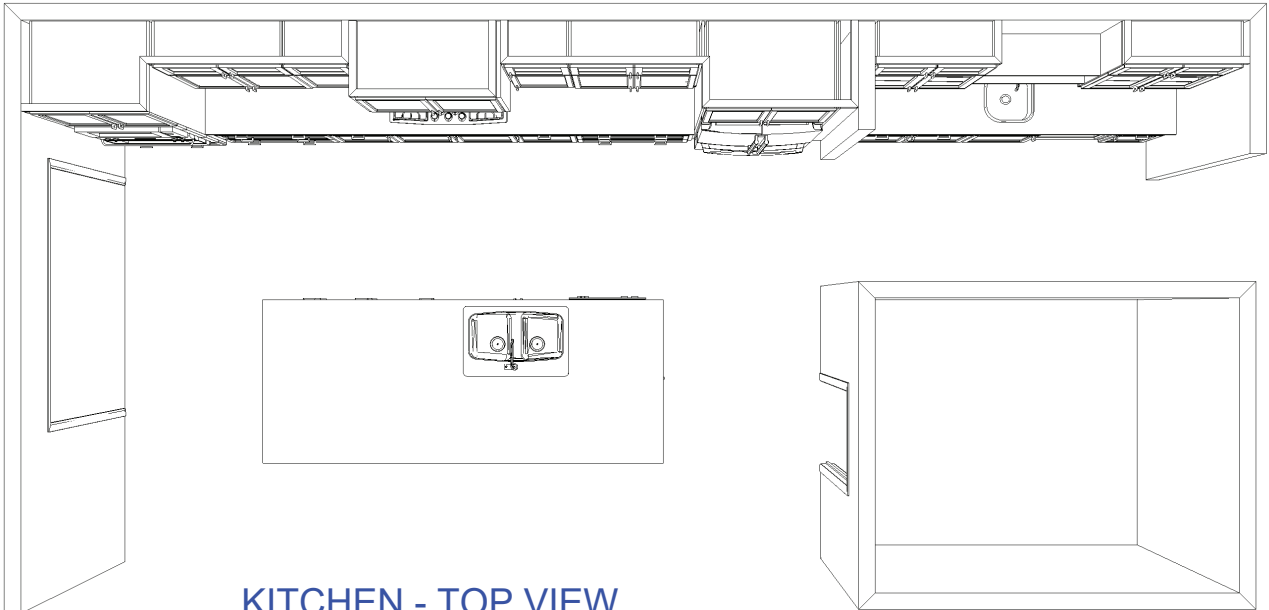

KITCHEN - TOP VIEW

REVISED: JUNE 21-22

CUSTOMER APPROVAL

I have reviewed these drawings and understand the details of the design and the CARTIER KITCHENS specifications.


Signature_____


Date_____

Note: This drawing is an artistic interpretation of the general appearance of the design. It is not meant to be an exact rendition.



Designed: 2022-06-21
Printed: 2022-06-21

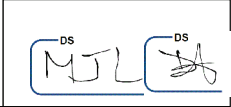

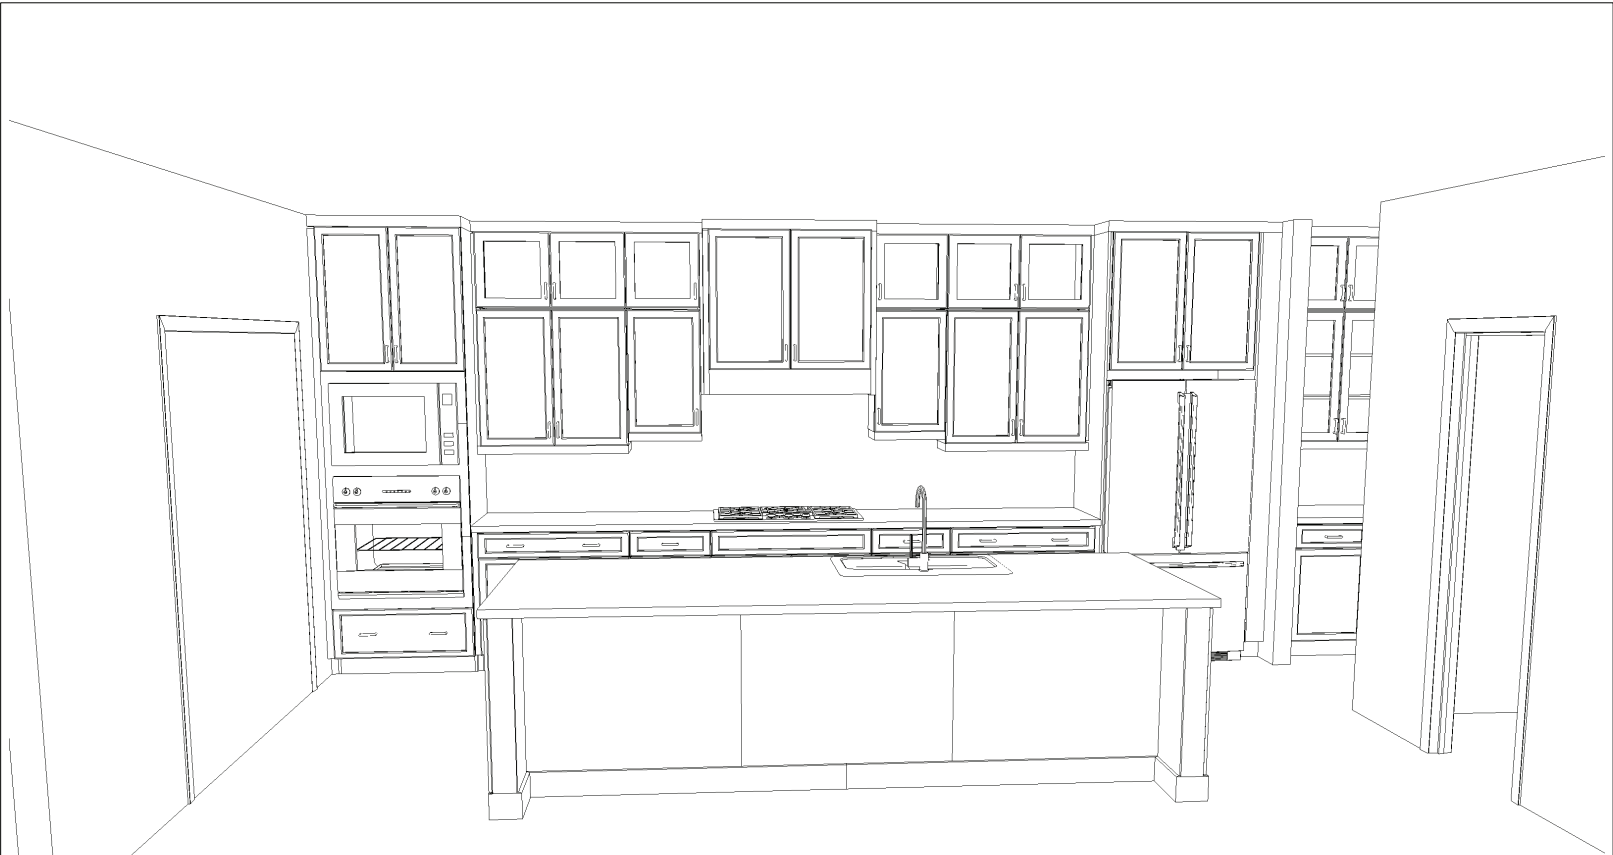

KITCHEN - 3D VIEW #1

REVISED: JUNE 21-22

CUSTOMER APPROVAL

I have reviewed these drawings and understand the details of the design and the CARTIER KITCHENS specifications.


Signature _____

Date _____

Note: This drawing is an artistic interpretation of the general appearance of the design. It is not meant to be an exact rendition.



Designed: 2022-06-21
Printed: 2022-06-21
DS [Signature] DS [Signature]

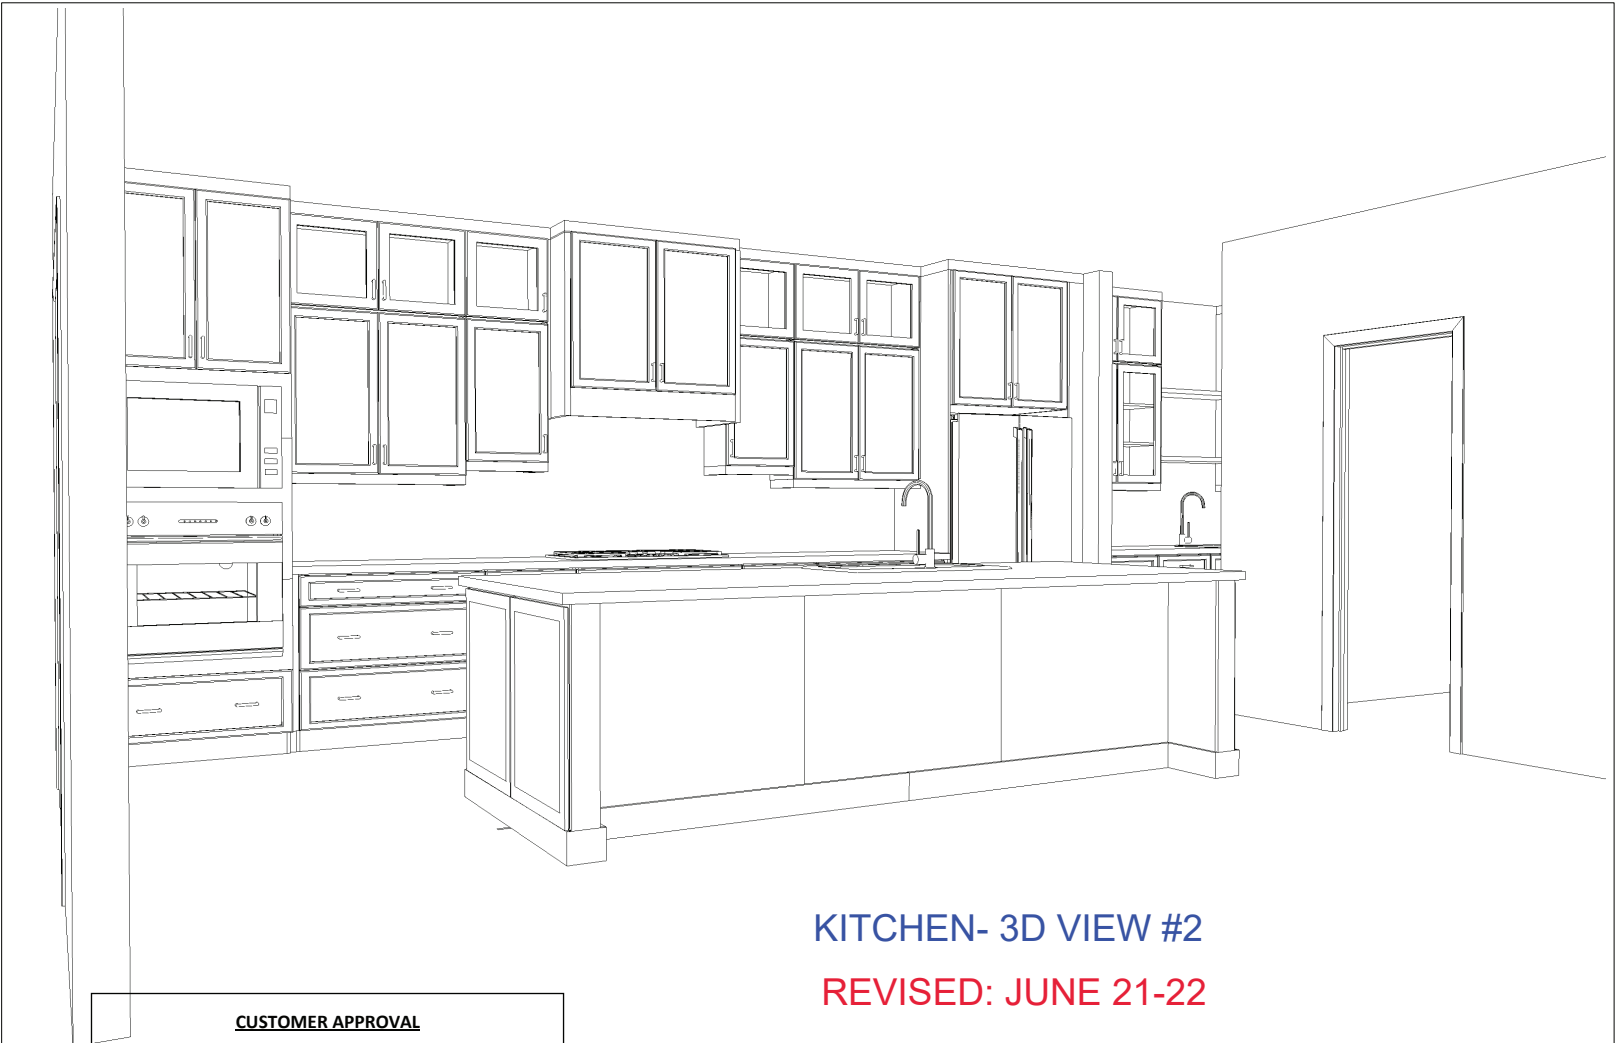

KITCHEN- 3D VIEW #2

REVISED: JUNE 21-22

CUSTOMER APPROVAL

I have reviewed these drawings and understand the details of the design and the CARTIER KITCHENS specifications.

Signature _____


Date _____

Note: This drawing is an artistic interpretation of the general appearance of the design. It is not meant to be an exact rendition.



Designed: 2022-06-21
Printed: 2022-06-21

DS
MJC
DS

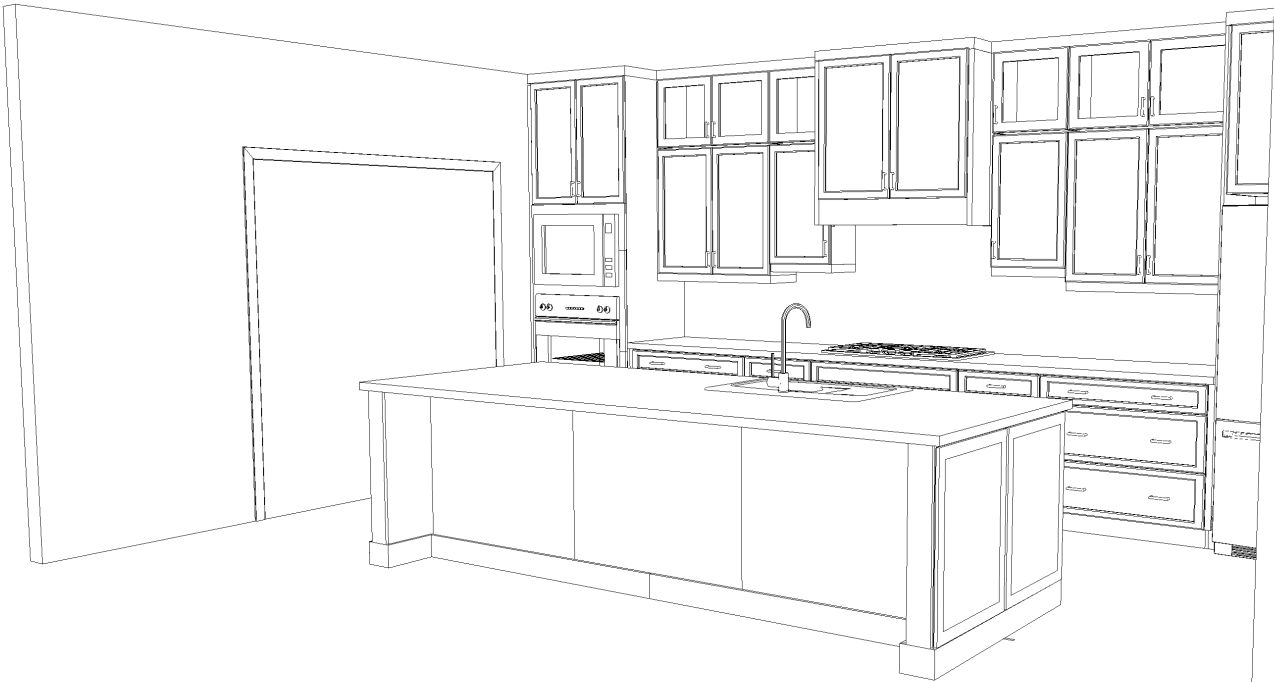

KITCHEN -3D VIEW #3
REVISED: JUNE 21-22

CUSTOMER APPROVAL

I have reviewed these drawings and understand the details of the design and the CARTIER KITCHENS specifications.

Signature _____


Date _____

Note: This drawing is an artistic interpretation of the general appearance of the design. It is not meant to be an exact rendition.



Designed: 2022-06-21
Printed: 2022-06-21

DS
MUL
DS

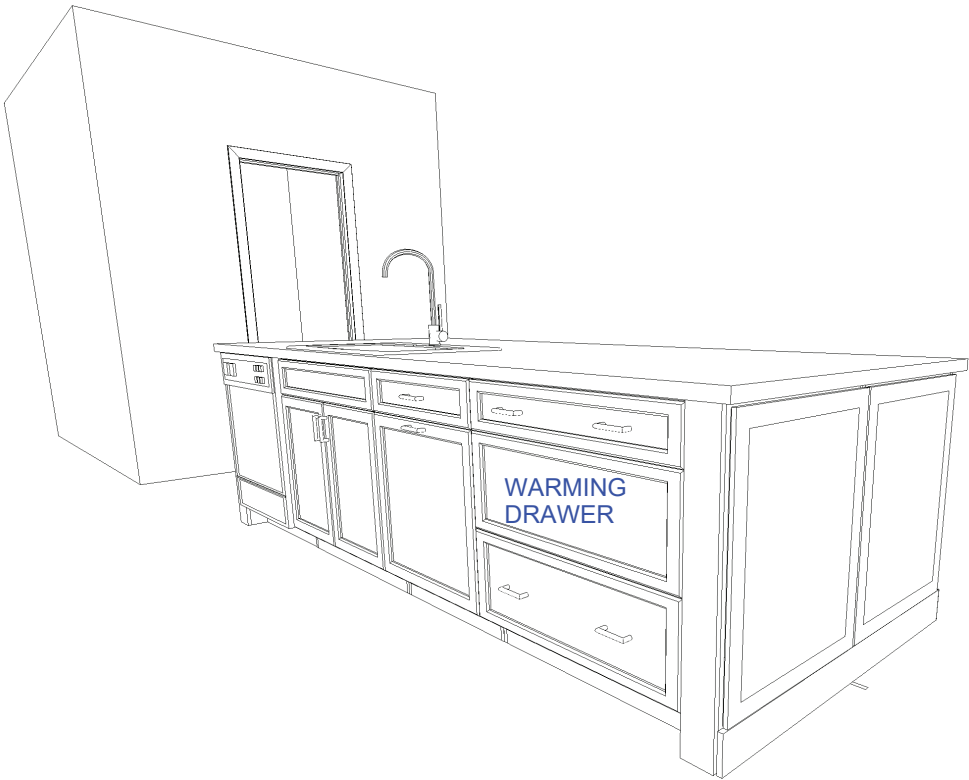

KITCHEN - 3D VIEW #4
REVISED: JUNE 21-22


CUSTOMER APPROVAL

I have reviewed these drawings and understand the details of the design and the CARTIER KITCHENS specifications.

Signature _____


Date _____


Note: This drawing is an artistic interpretation of the general appearance of the design. It is not meant to be an exact rendition.



Designed: 2022-06-21
Printed: 2022-06-21

DS
MJC

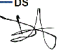DS

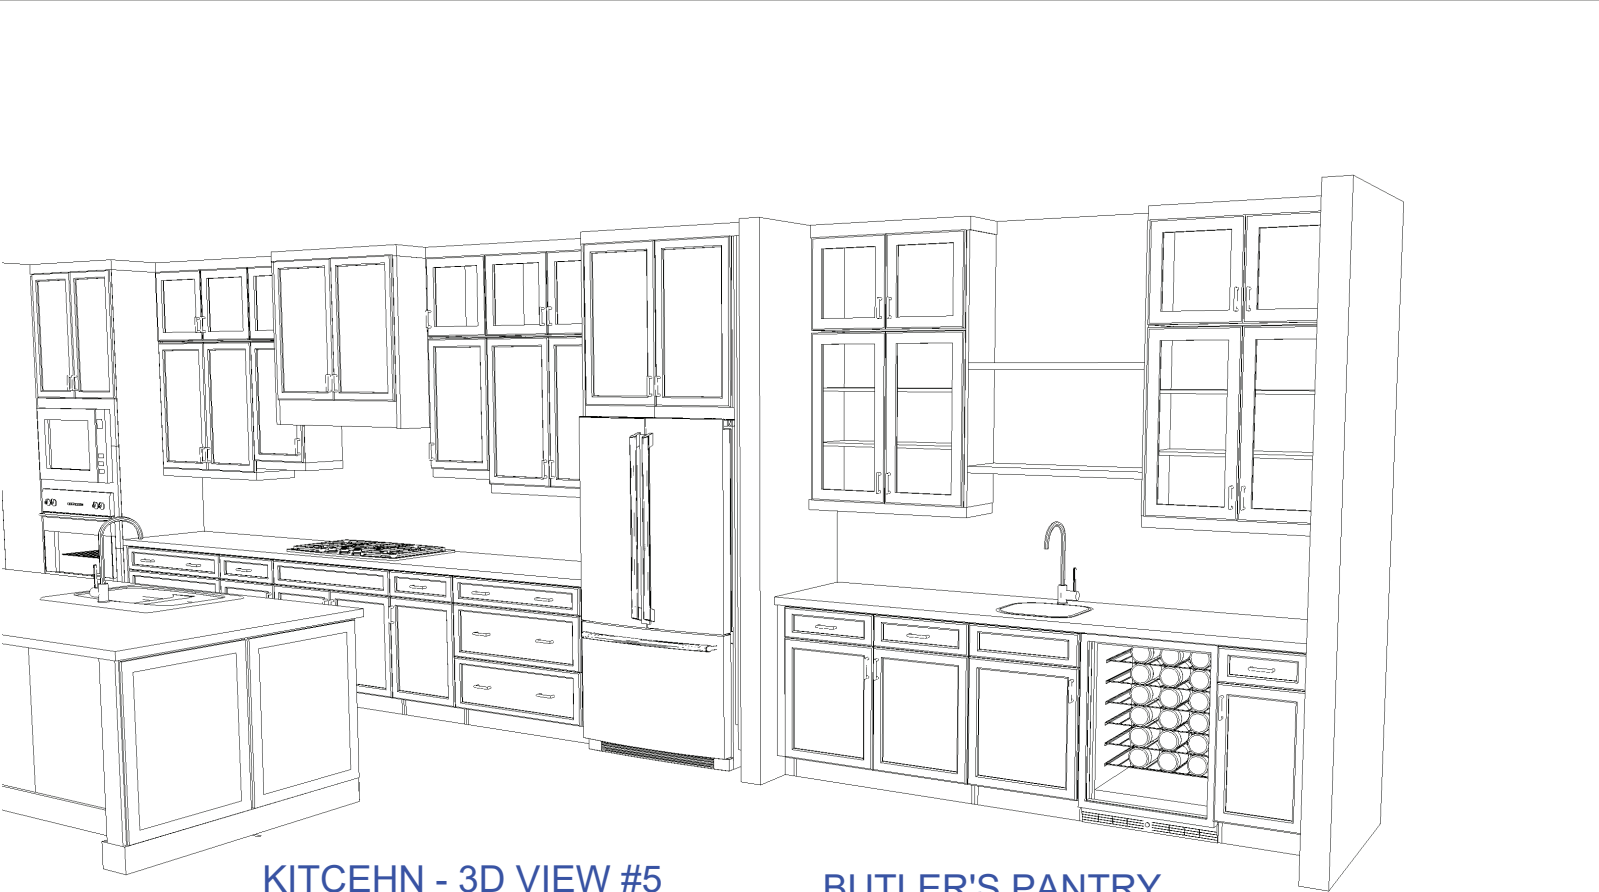


KITCEHN - 3D VIEW #5

BUTLER'S PANTRY

REVISED: JUNE 21-22

CUSTOMER APPROVAL
I have reviewed these drawings and understand the details of the design and the CARTIER KITCHENS specifications.
Signature _____
Date _____

Note: This drawing is an artistic interpretation of the general appearance of the design. It is not meant to be an exact rendition.		Designed: 2022-06-21
		Printed: 2022-06-21
		
DCR #3-62 White Tail Ridge 3 - Newington Chef's	All	Drawing #: 1