



DCR PHOENIX HOMES

CHESAPEAKE (508)
4 BDRM
VANITIES


LINE - 1 & 2
HARDWARE - STD & 1ST UPGRADE
STD WHITE INTERIORS
METAL DRWR BOX
5/8" KICK

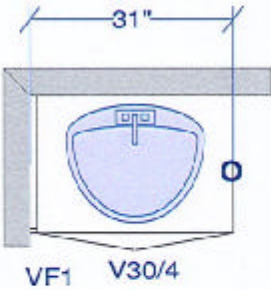

POWDER

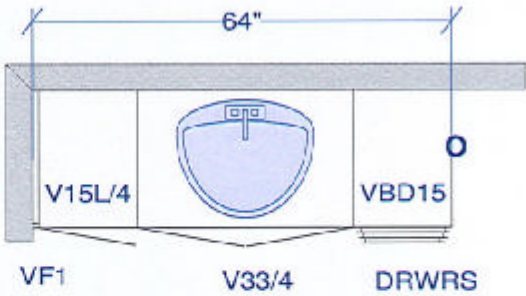

MAIN BATH

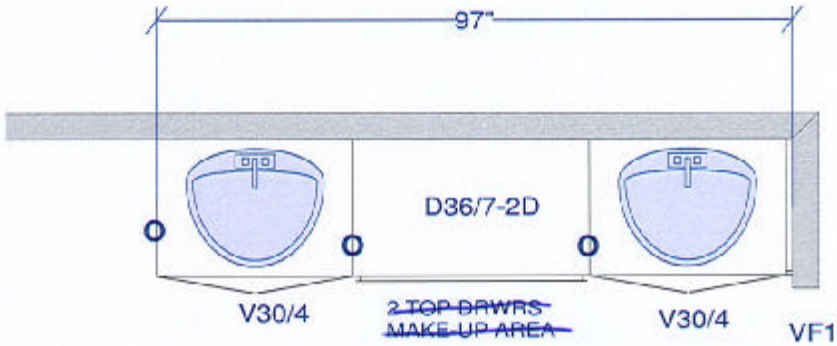

MASTER ENSUITE

All dimensions & size designations given are subject to verification on job site and adjustment to fit job conditions.

Cartier Kitchens Ottawa



This is an original design and must not be released or copied unless applicable fee has been paid or job order placed.

Drawn by: Lori Di Saverio, B.I.D.
Cartier Kitchens Ottawa


Designed: 17/07/2013
Printed: 09/12/2013

DCR - 508 CHESAPEAKE - 4 BDRM VANITIES.kit


All

Drawing #: 1 No Scale.


DS
ET
DS
AT

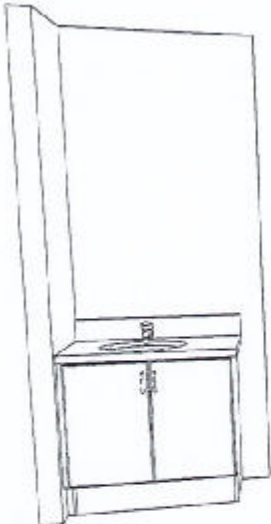

POWDER ROOM
VANITY

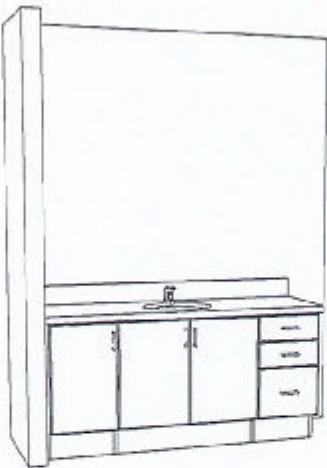

MAIN BATH VANITY

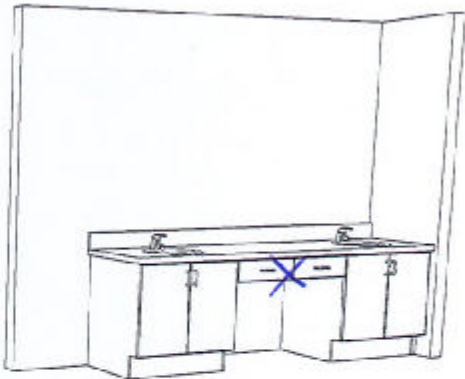

MASTER ENSUITE VANITY

CUSTOMER APPROVAL

I have reviewed these drawings and understand the details of the design and the CARTIER KITCHENS specifications.

Signature _____

Date _____

Note: This drawing is an artistic interpretation of the general appearance of the design. It is not meant to be an exact rendition.

SPECTRUM KITCHEN and BATH
DESIGN

DCR - 508 CHESAPEAKE - 4 BDRM VANITIES.kit

All

Designed: 2019-09-04
Printed: 2021-05-20



Drawing #: 1

DS DS
ET AT