

DCR PHOENIX HOMES

LOT # 256

SITE - PATHWAYS 2

MODEL - ANNAPOLIS (509)

KITCHEN

MOUNTING HEIGHT - 96

42"H UPPERS @ 18" ABOVE COUNTER


~~CROWN MOULDING~~

~~LIGHT VALANCE~~

COMPLETE.

REVISÉ: JAN 9-22

9-22
KEEP STANDARD
UPPER + HOOD.

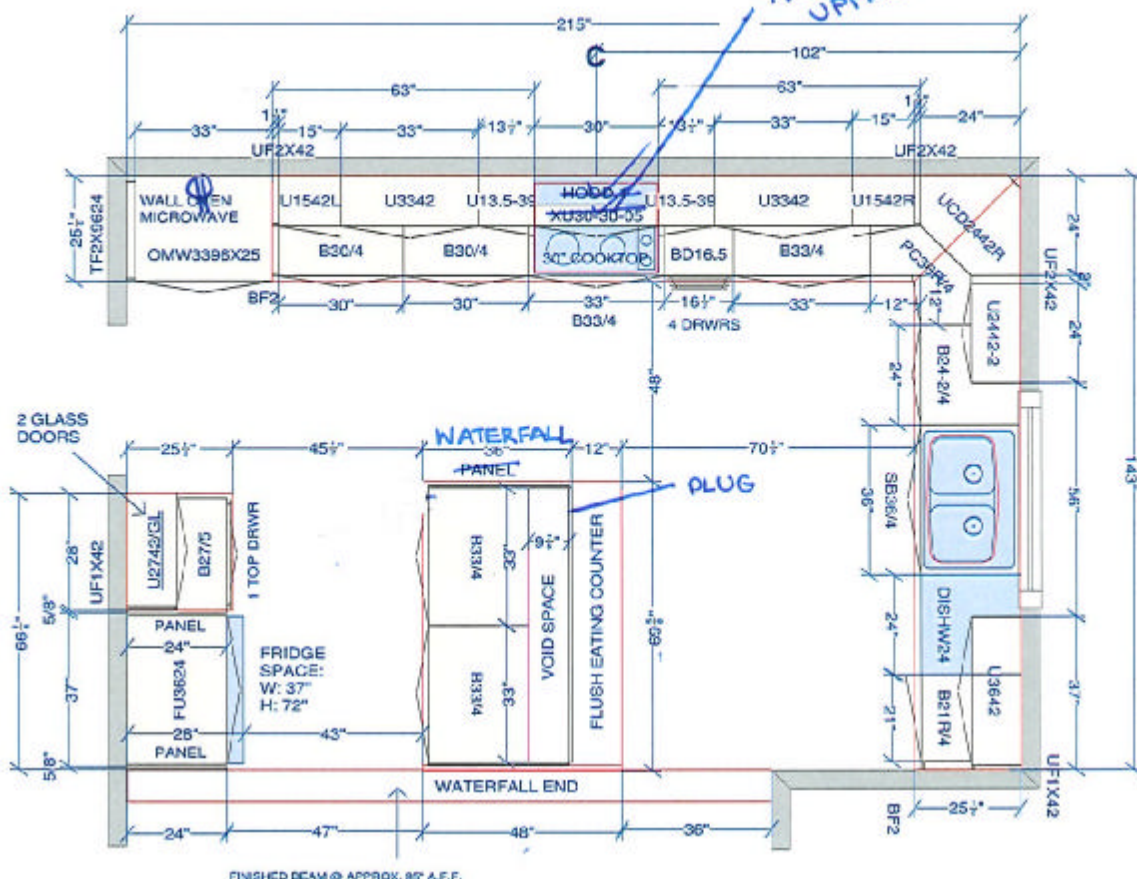

CUSTOMER APPROVAL

I have reviewed these drawings and understand the details of the design and the CARTIER KITCHENS specifications.

Signature_____

Date _____

All dimensions & size designations given are subject to verification on job site and adjustment to fit job conditions.



This is an original design and must not be released or copied unless applicable fee has been paid or job order placed.

Designed: 2022-01-09
Printed: 2022-01-09

Printed: 2022-01-09

DCR - 256 PWYS 2 - Kitchen 3 .kit

All

Drawing #: 1


No Scale.

—DS
AS

45

DS

HK

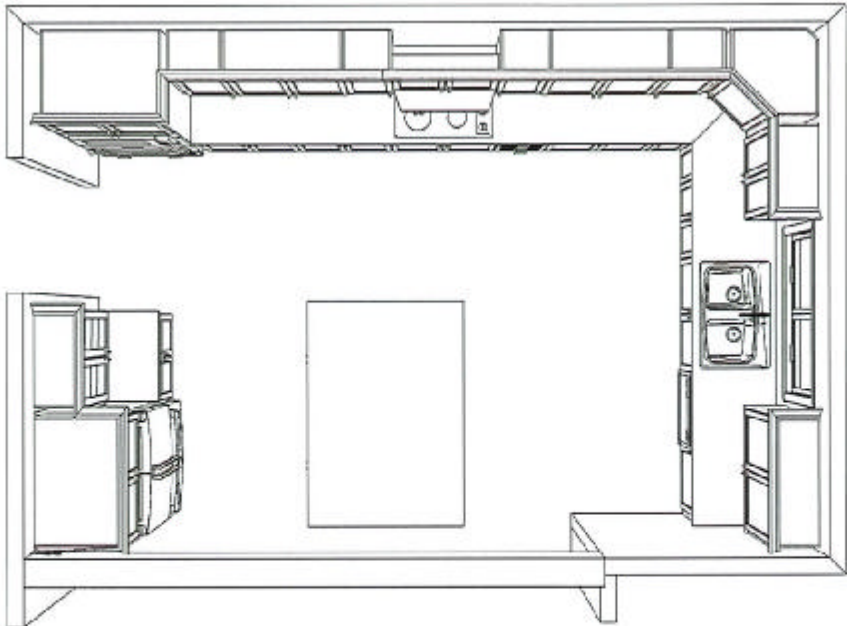

KITCHEN - TOP VIEW

REVISED: JAN 9-22


CUSTOMER APPROVAL I have reviewed these drawings and understand the details of the design and the CARTIER KITCHENS specifications. Signature _____ Date _____
--

Note: This drawing is an artistic interpretation of the general appearance of the design. It is not meant to be an exact rendition.



Designed: 2022-01-09
Printed: 2022-01-09

DS HSR	DS JK
-----------	----------

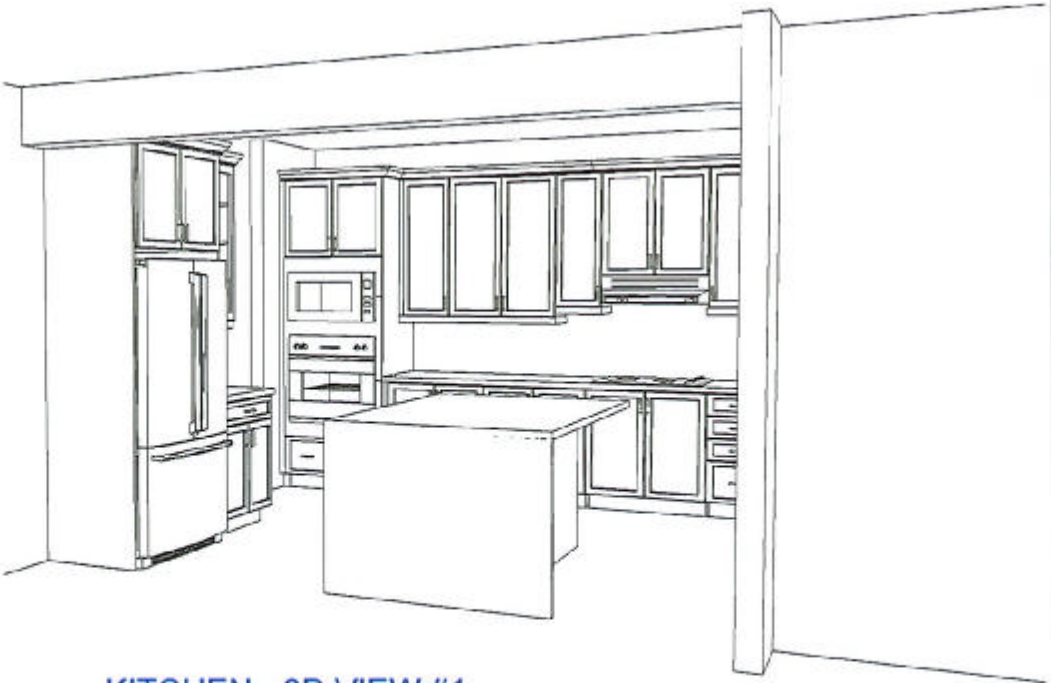

KITCHEN - 3D VIEW #1

REVISED: JAN 9-22

CUSTOMER APPROVAL I have reviewed these drawings and understand the details of the design and the CARTIER KITCHENS specifications. Signature: _____ Date: _____
--

Note: This drawing is an artistic interpretation of the general appearance of the design. It is not meant to be an exact rendition.



Designed: 2022-01-09
Printed: 2022-01-09

DS HSR	DS JK
-----------	----------



KITCHEN - 3D VIEW #2

REVISED: JAN 9-22

CUSTOMER APPROVAL I have reviewed these drawings and understand the details of the design and the CARTIER KITCHENS specifications. Signature _____ Date _____
--


Note: This drawing is an artistic interpretation of the general appearance of the design. It is not meant to be an exact rendition.		Designed: 2022-01-09
		Printed: 2022-01-09
DCR - 256 PWYS 2 - Kitchen 3 .kit		Drawing #: 1

DS

HSR

DS

JK

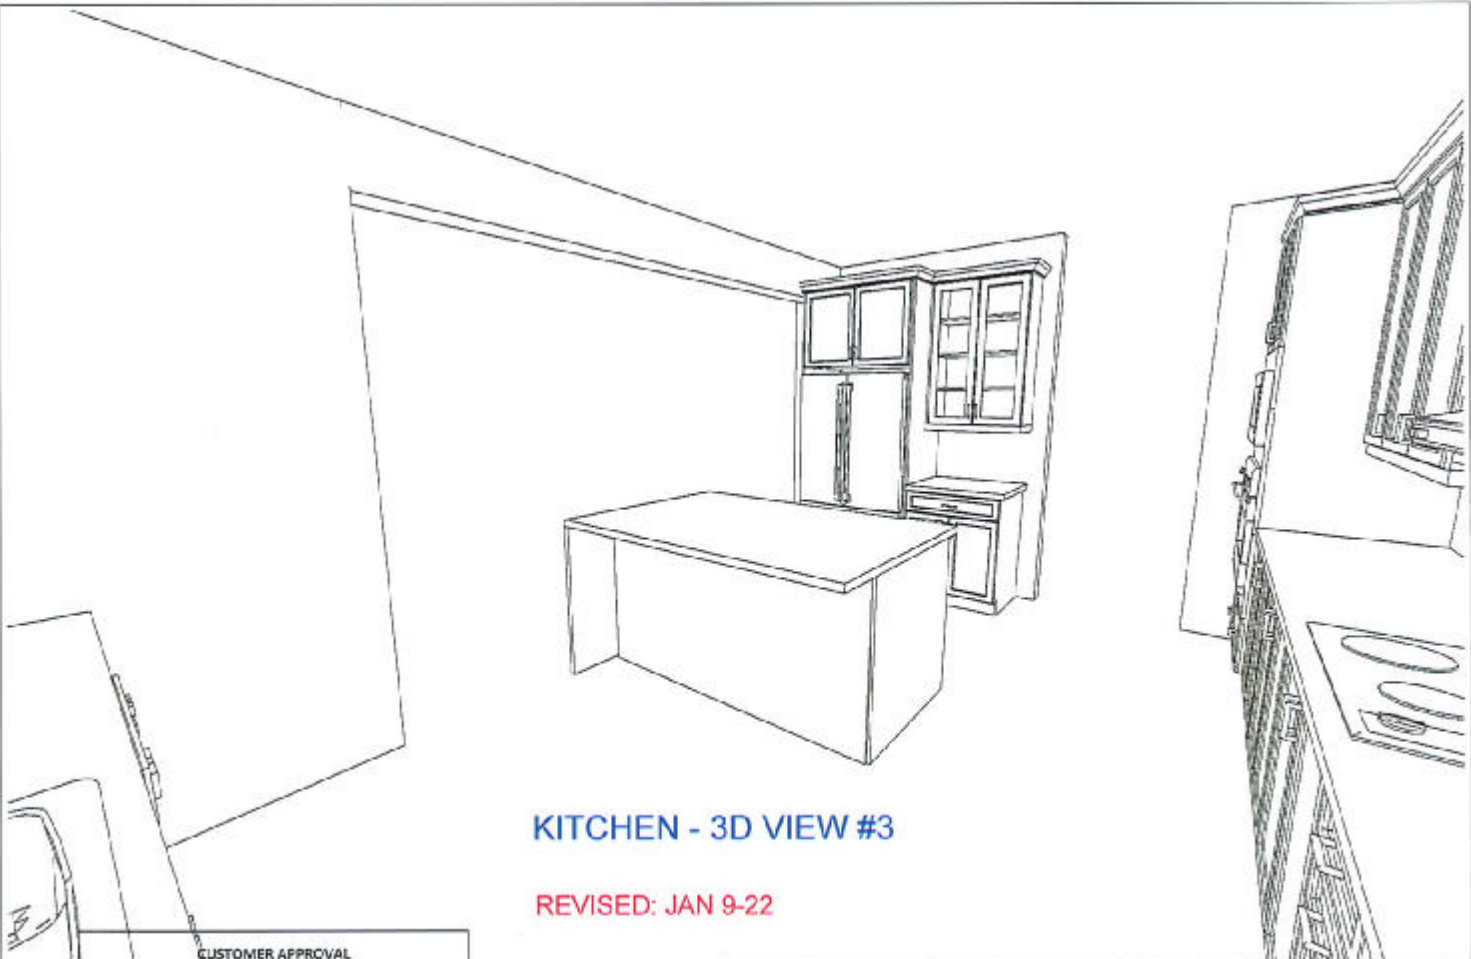

A 3D line drawing of a kitchen interior. In the center is a large rectangular kitchen island. To the right of the island is a set of kitchen cabinets with upper and lower doors and a small countertop area. To the left of the island, a portion of another kitchen element is visible. The drawing is a simple line sketch without shading.

KITCHEN - 3D VIEW #3

REVISED: JAN 9-22

CUSTOMER APPROVAL

I have reviewed these drawings and understand the details of the design and the CAMTIER KITCHENS specifications.

Signature _____

Date _____

Note: This drawing is an artistic interpretation of the general appearance of the design. It is not meant to be an exact rendition.



Designed: 2022-01-09
Printed: 2022-01-09

DCR - 256 PWYS 2 - Kitchen 3 .kit

All

Drawing #: 1

DS

HSR

DS

JK



KITCHEN - 3D VIEW #4
REVISED: JAN 9-22

CUSTOMER APPROVAL	
I have reviewed these drawings and understand the details of the design and the CARTIER KITCHENS specifications.	
Signature _____	
Date _____	


Note: This drawing is an artistic interpretation of the general appearance of the design. It is not meant to be an exact rendition.		Designed: 2022-01-09
		Printed: 2022-01-09
DCR - 256 PWYS 2 - Kitchen 3 .kit		Drawing #: 1

DS

HSR

DS

JK

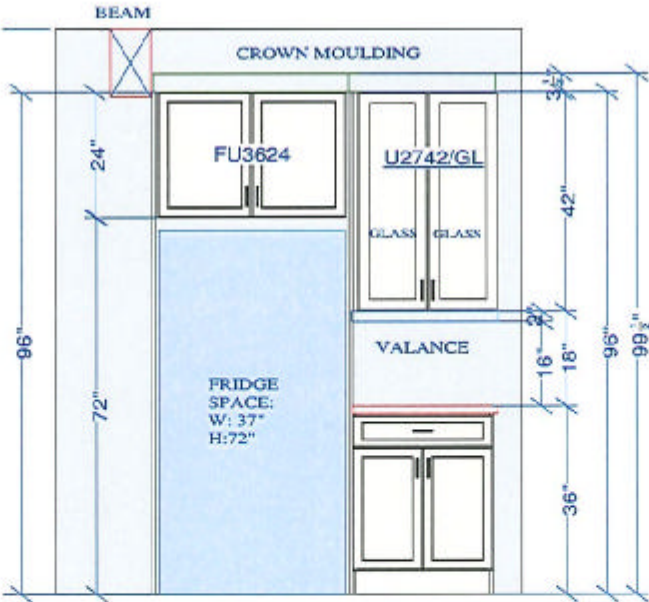

FRIDGE WALL ELEVATION

REVISED: JAN 9-22

CUSTOMER APPROVAL

I have reviewed these drawings and understand the details of the design and the CARTIER KITCHENS specifications.

Signature _____

Date _____


All dimensions ,size designations given are subject to verification on job site and adjustment to fit job conditions.		This is an original design and must not be released or copied unless applicable fee has been paid or job order placed.	Designed: 2022-01-09 Printed: 2022-01-09	
DCR - 256 PWYS 2 - Kitchen 3 .kit		El 1	Drawing #: 1	No Scale.

DS

HSR

DS

JK

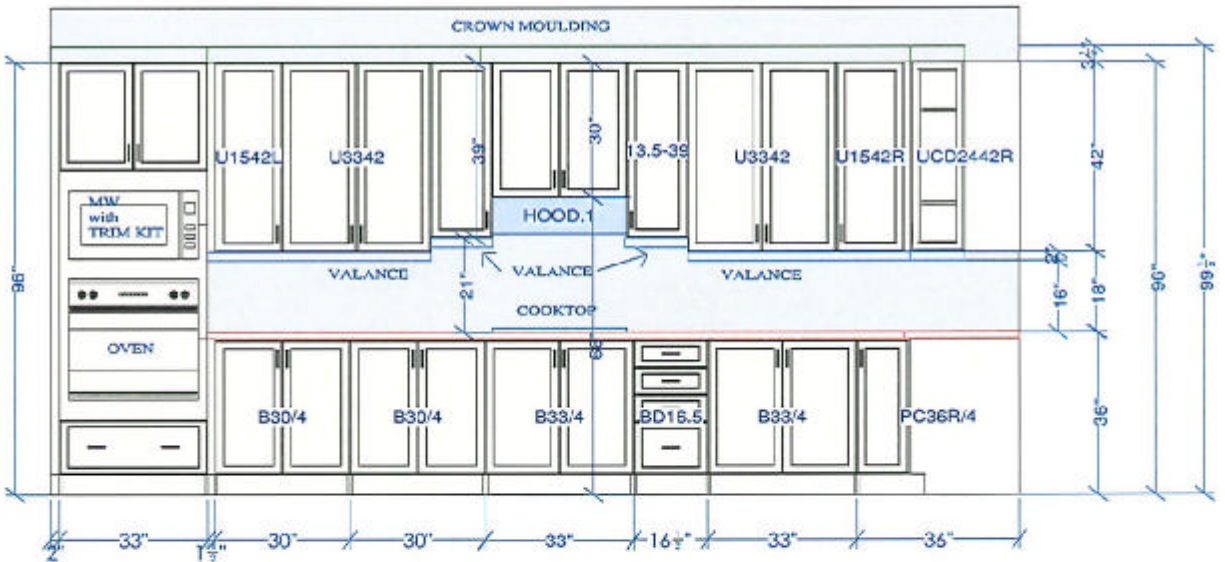

OVEN / COOKTOP WALL ELEVATION REVISED: JAN 9-22

CUSTOMER APPROVAL

I have reviewed these drawings and understand the details of the design and the CARTIER KITCHENS specifications.

Signature: _____

Date: _____


All dimensions, size designations given are subject to verification on job site and adjustment to fit job conditions.



This is an original design and must not be released or copied unless applicable fee has been paid or job order placed.

Designed: 2022-01-09
Printed: 2022-01-09

DS DS
ASR JK

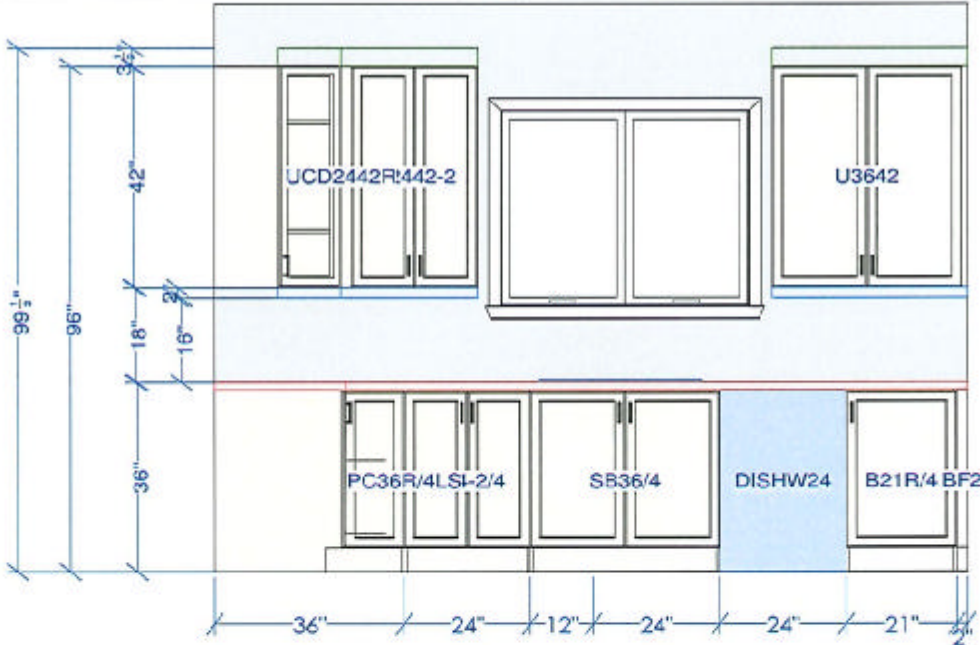

SINK WALL ELEVATION

CUSTOMER APPROVAL

I have reviewed these drawings and understand the details of the design and the CARTER KITCHENS specifications.

Signature _____

Date _____

All dimensions, size designations given are subject to verification on job site and adjustment to fit job conditions.		This is an original design and must not be released or copied unless applicable fee has been paid or job order placed.	Designed: 2021-12-03 Printed: 2021-12-14	
			DCR - 256 PWYS 2 - Annapolis .kit	El 3 Drawing #: 1 No Scale.

DS

HSR

DS

JK