

DCR PHOENIX HOMES

LOT # 256

SITE - PATHWAYS 2

MODEL - ANNAPOLIS (509)

KITCHEN

MOUNTING HEIGHT - 96

42"H UPPERS @ 18" ABOVE COUNTER

~~CROWN MOULDING~~

~~LIGHT VALANCE~~ DELETE.

REVISÉD: JAN 9-22

CABINETS -

HARDWARE -

STANDARD WHITE INTERIOR


METAL DRAWER BOX

4 PCS - 5/8" KICK - FIN. BOTH ENDS

5 PCS- FLAT MOULDING

2 PCS - 90 DEG. CORNER MOULD

1 PCS - T-MOULD

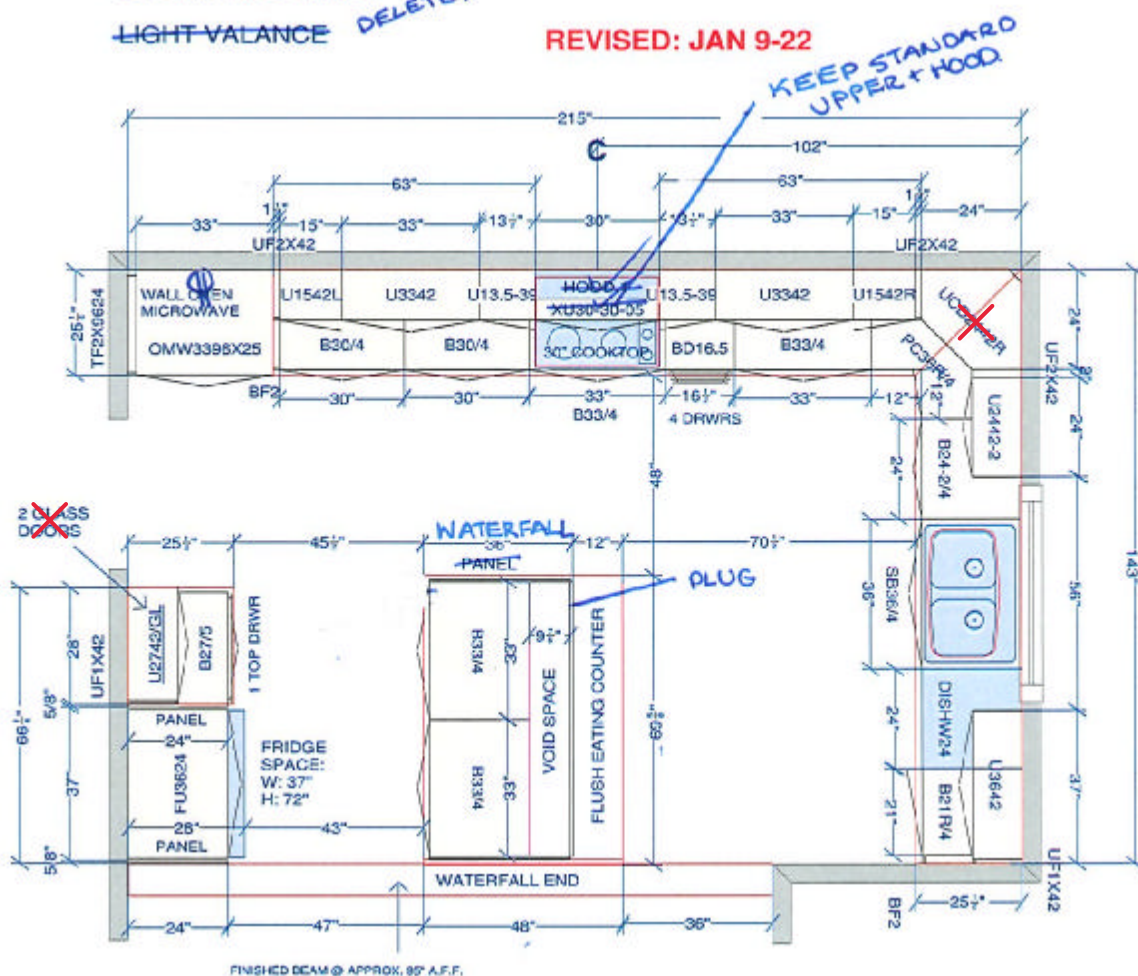

DELETE (2) SETS GLASS CABINET
DOORS - REVERTS TO STANDARD
UPPERS

CUSTOMER APPROVAL

I have reviewed these drawings and understand the details of the design and the CARTIER KITCHENS specifications.

Signature_____

Date: _____

All dimensions & size designations given are subject to verification on job site and adjustment to fit job conditions.



This is an original design and must not be released or copied unless applicable fee has been paid or job order placed.

Designed: 2022-01-09
Printed: 2022-01-09


DCR - 256 PWYS 2 - Kitchen 3 .kit

All

Drawing #: 1

No Scale.

DS HSR DS JK

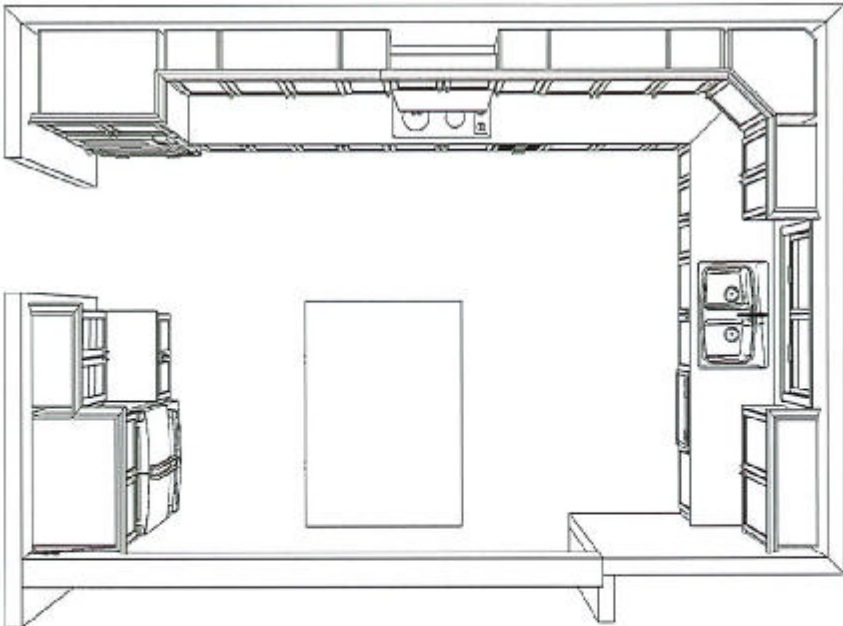

KITCHEN - TOP VIEW

REVISED: JAN 9-22


<p>CUSTOMER APPROVAL</p> <p>I have reviewed these drawings and understand the details of the design and the CARTIER KITCHENS specifications.</p> <p>Signature _____</p> <p>Date _____</p>
--

Note: This drawing is an artistic interpretation of the general appearance of the design. It is not meant to be an exact rendition.



Designed: 2022-01-09 Printed: 2022-01-09

DS HSR	DS JK
-----------	----------

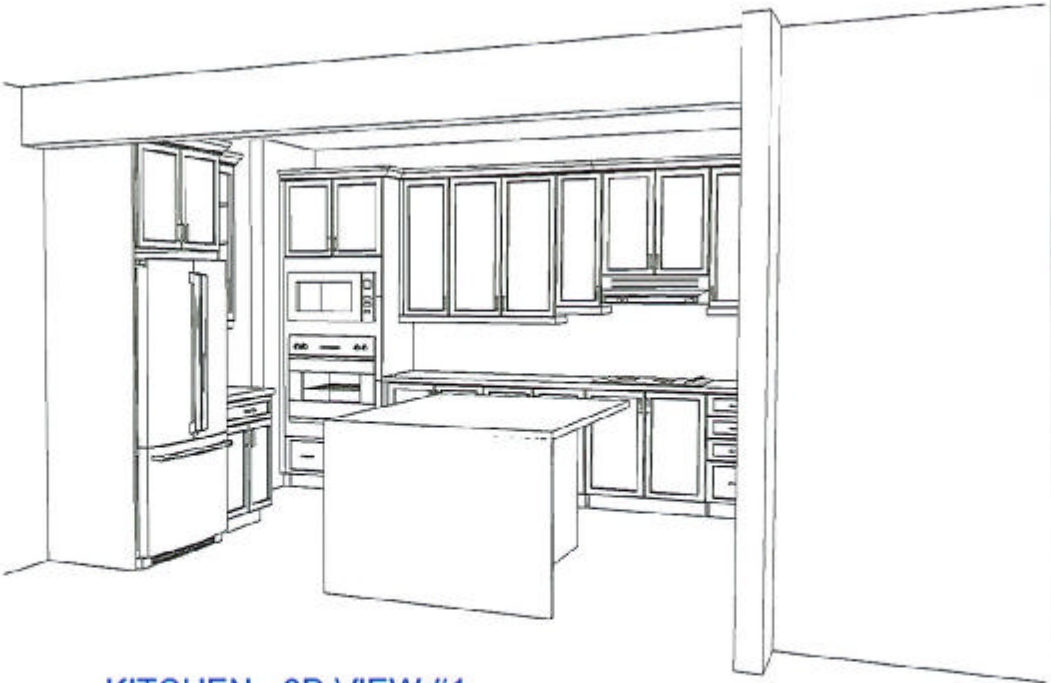

KITCHEN - 3D VIEW #1

REVISED: JAN 9-22


CUSTOMER APPROVAL	
I have reviewed these drawings and understand the details of the design and the CARTIER KITCHENS specifications.	
Signature	_____
Date	_____

Note: This drawing is an artistic interpretation of the general appearance of the design. It is not meant to be an exact rendition.



Designed: 2022-01-09
Printed: 2022-01-09

DS HSR	DS JK
-----------	----------

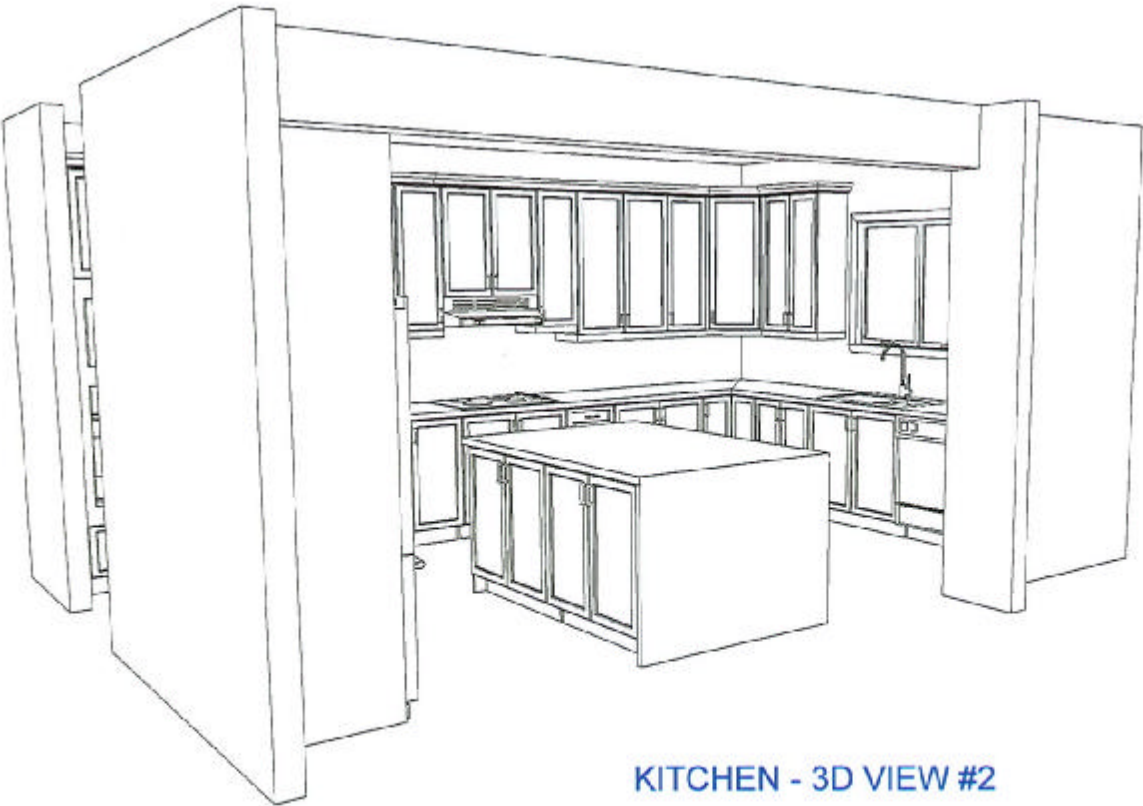


KITCHEN - 3D VIEW #2

REVISED: JAN 9-22

CUSTOMER APPROVAL	
I have reviewed these drawings and understand the details of the design and the CARTIER KITCHENS specifications.	
Signature _____	
Date _____	

Note: This drawing is an artistic interpretation of the general appearance of the design. It is not meant to be an exact rendition.		Designed: 2022-01-09
		Printed: 2022-01-09
DCR - 256 PWYS 2 - Kitchen 3 .kit		All Drawing #: 1

DS HSR	DS JK
-----------	----------

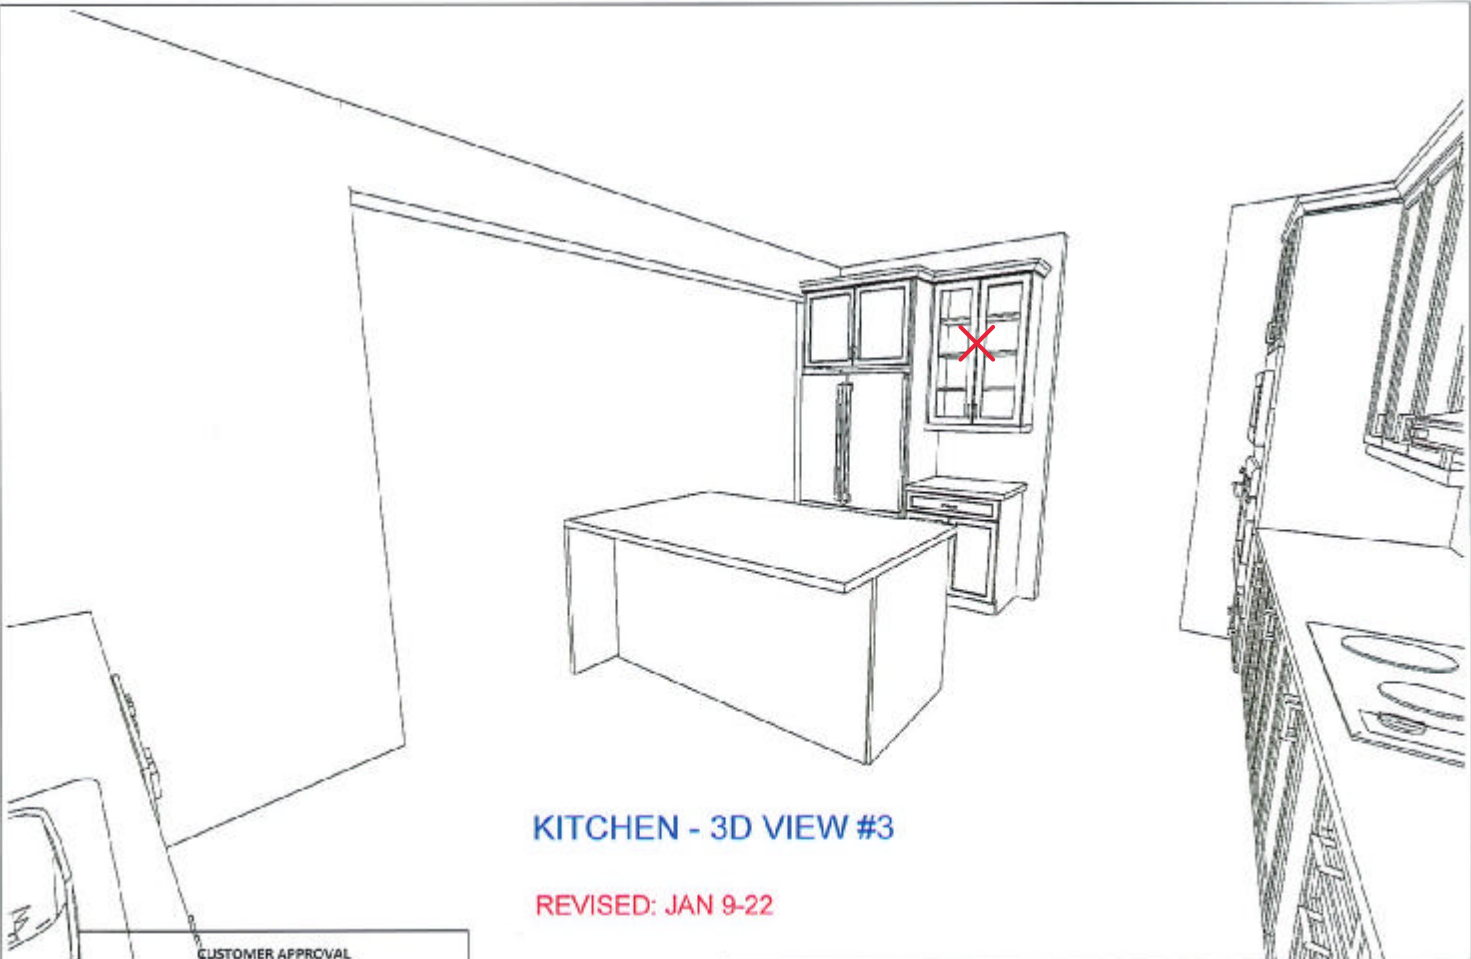

KITCHEN - 3D VIEW #3

REVISED: JAN 9-22


CUSTOMER APPROVAL

I have reviewed these drawings and understand the details of the design and the CANTIER KITCHENS specifications.

Signature _____

Date _____

Note: This drawing is an artistic interpretation of the general appearance of the design. It is not meant to be an exact rendition.



Designed: 2022-01-09
Printed: 2022-01-09

DCR - 256 PWYS 2 - Kitchen 3 .kit

All

Drawing #: 1

DS

HSR

DS

JK



KITCHEN - 3D VIEW #4
REVISED: JAN 9-22


CUSTOMER APPROVAL	
I have reviewed these drawings and understand the details of the design and the CARTIER KITCHENS specifications.	
Signature _____	
Date _____	

Note: This drawing is an artistic interpretation of the general appearance of the design. It is not meant to be an exact rendition.



Designed: 2022-01-09
Printed: 2022-01-09

DS HSR	DS JK
-----------	----------

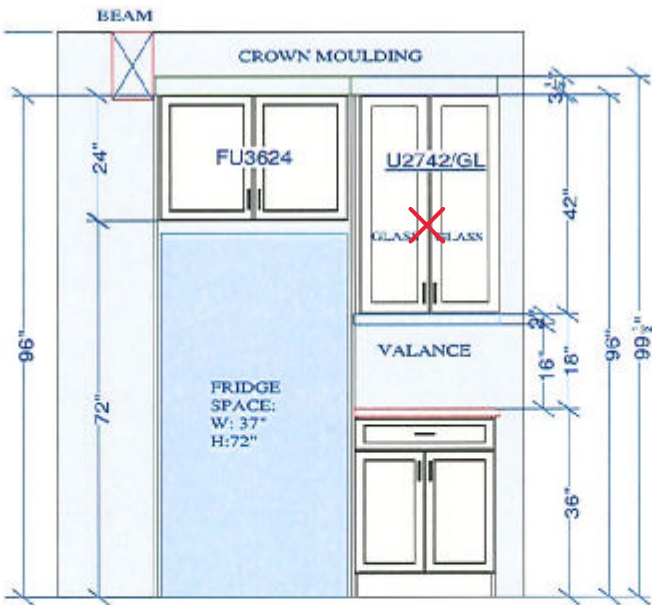

FRIDGE WALL ELEVATION

REVISED: JAN 9-22

CUSTOMER APPROVAL

I have reviewed these drawings and understand the details of the design and the CARTIER KITCHENS specifications.


Signature _____

Date _____

All dimensions, size designations given are subject to verification on job site and adjustment to fit job conditions.		This is an original design and must not be released or copied unless applicable fee has been paid or job order placed.	Designed: 2022-01-09 Printed: 2022-01-09	
DCR - 256 PWYS 2 - Kitchen 3 .kit			El 1	Drawing #: 1 No Scale.

DS
HSR

DS
JK

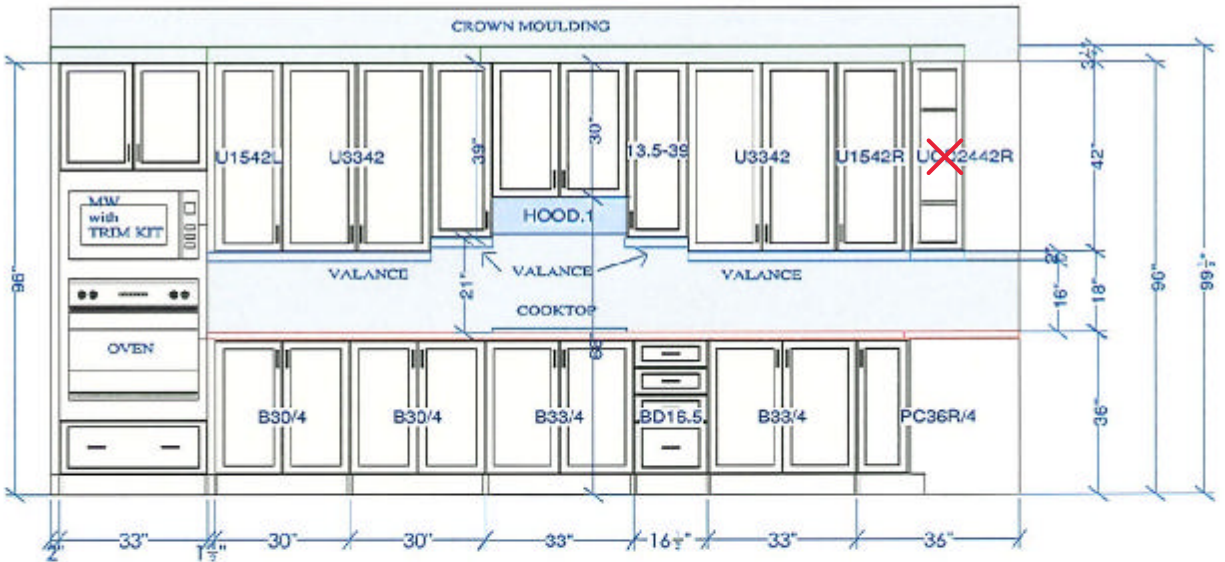

OVEN / COOKTOP WALL ELEVATION REVISED: JAN 9-22

CUSTOMER APPROVAL


I have reviewed these drawings and understand the details of the design and the CARTIER KITCHENS specifications.

Signature: _____

Date: _____

All dimensions, size designations given are subject to verification on job site and adjustment to fit job conditions.		This is an original design and must not be released or copied unless applicable fee has been paid or job order placed.	Designed: 2022-01-09	
			Printed: 2022-01-09	
DCR - 256 PWYS 2 - Kitchen 3 .kit			EI 2	Drawing #: 1 No Scale.

DS DS
ASR JK

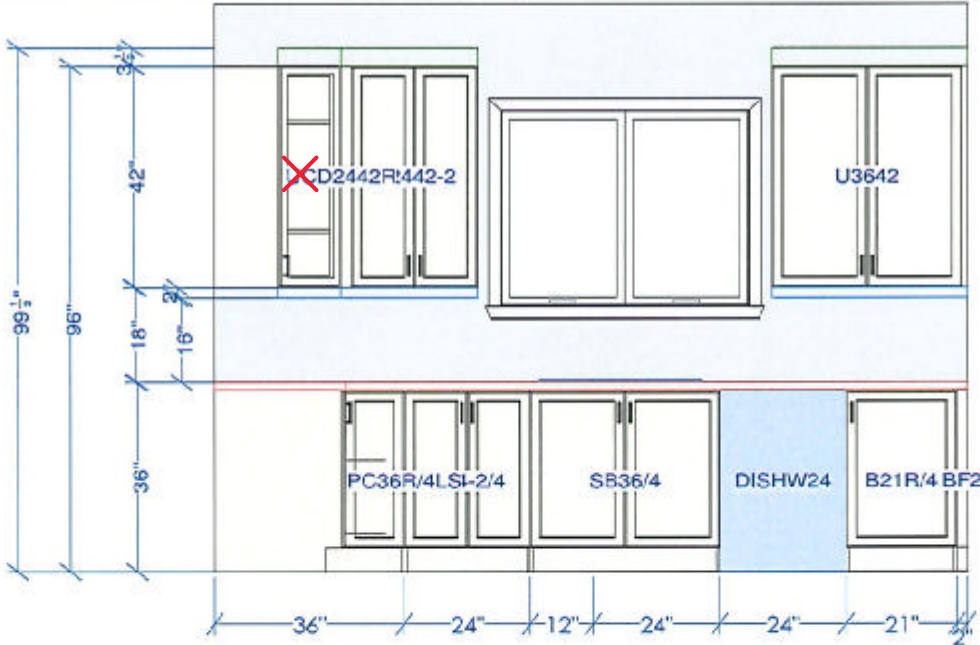

SINK WALL ELEVATION

CUSTOMER APPROVAL

I have reviewed these drawings and understand the details of the design and the CARTER KITCHENS specifications.

Signature _____

Date _____

All dimensions, size designations given are subject to verification on job site and adjustment to fit job conditions.		This is an original design and must not be released or copied unless applicable fee has been paid or job order placed.	Designed: 2021-12-03 Printed: 2021-12-14	
DCR - 256 PWYS 2 - Annapolis .kit		El 3	Drawing #: 1	No Scale.

DS

HSR

DS

JK