


DCR PHOENIX HOMES

LOT #257
PATHWAYS 2
KLONDIKE (520)


MAIN FLOOR KITCHEN

MOUNTING HT : 96
42"U UPPERS @ 18" ABOVE COUNTER

- CABINETS -
HARDWARE -
STANDARD WHITE INTERIOR
METAL DRAWER BOX
4 PCS - 5/8" KICK - FIN. BOTH ENDS
1 PCS - 90 DEG. CORNER MOULD
1 PCS - T-MOULD
7 PCS - FLAT MOULD

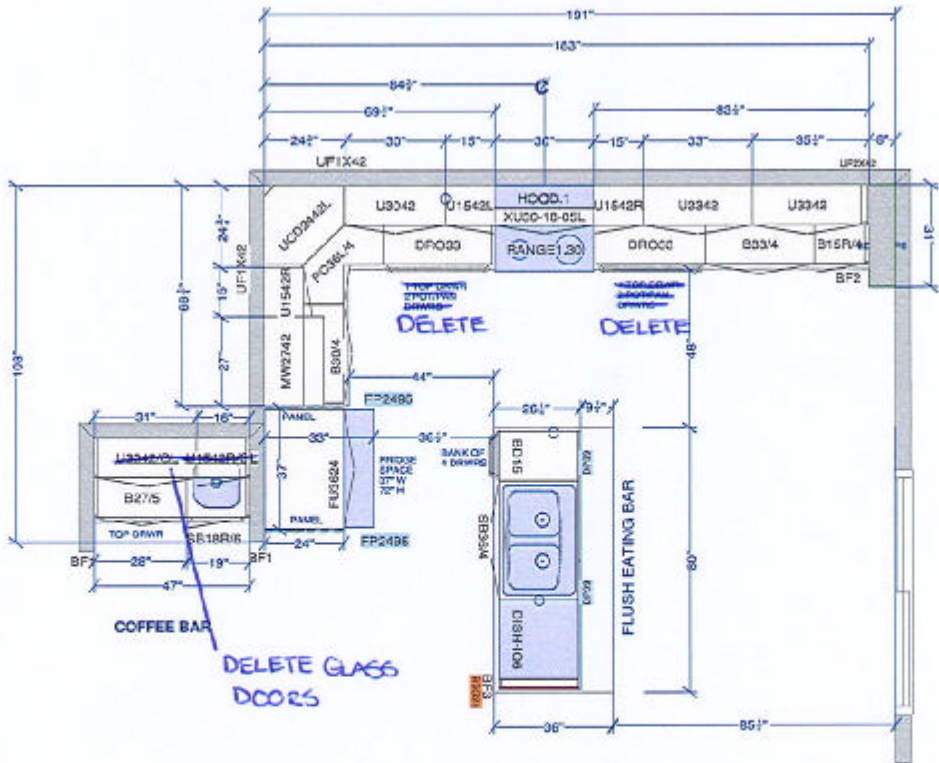

2ND FLOOR VANITIES

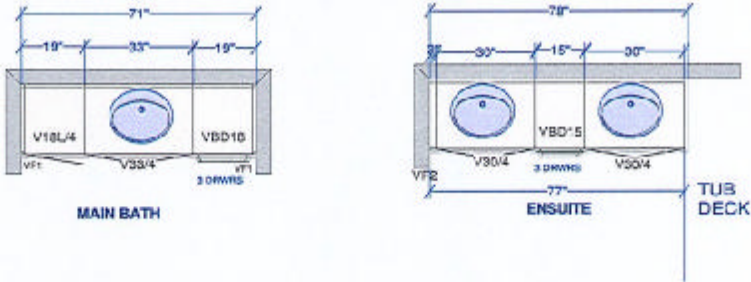

CUSTOMER APPROVAL
I have reviewed these drawings and understand the details of the design and the CONTRACTOR'S specifications.
Signature: _____
Date: _____

All dimensions, size designations given are subject to verification on job site and adjustment to fit job conditions.



This is an original design and must not be released or copied unless applicable fee has been paid or job order placed.


Designed: 2022-04-20
Printed: 2022-04-20

DCR #257 PWYS 2 - Klondike Main Floor.kit

All

Drawing #: 1 No Scale.

DS
DS
EJC

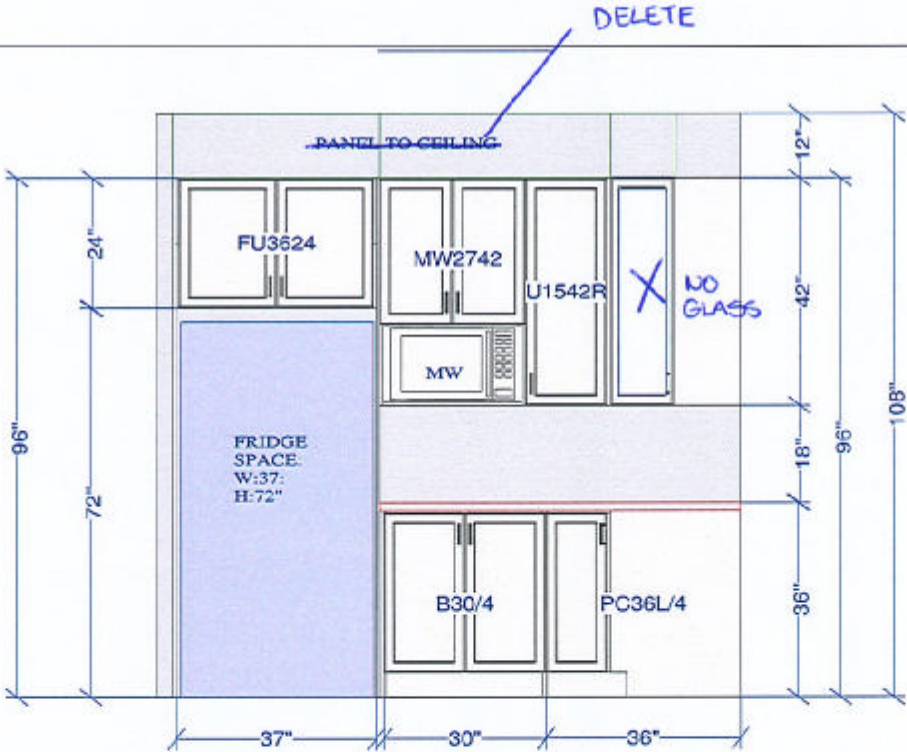

FRIDGE WALL ELEVATION

CUSTOMER APPROVAL

I have reviewed these drawings and understand the details of the design and the CARTER KTO-ENS specifications.

Signature _____

Date _____


All dimensions ,size designations given are subject to verification on job site and adjustment to fit job conditions.




This is an original design and must not be released or copied unless applicable fee has been paid or job order placed.


Designed: 2022-04-20
Printed: 2022-04-20

DS DS
[Signature]

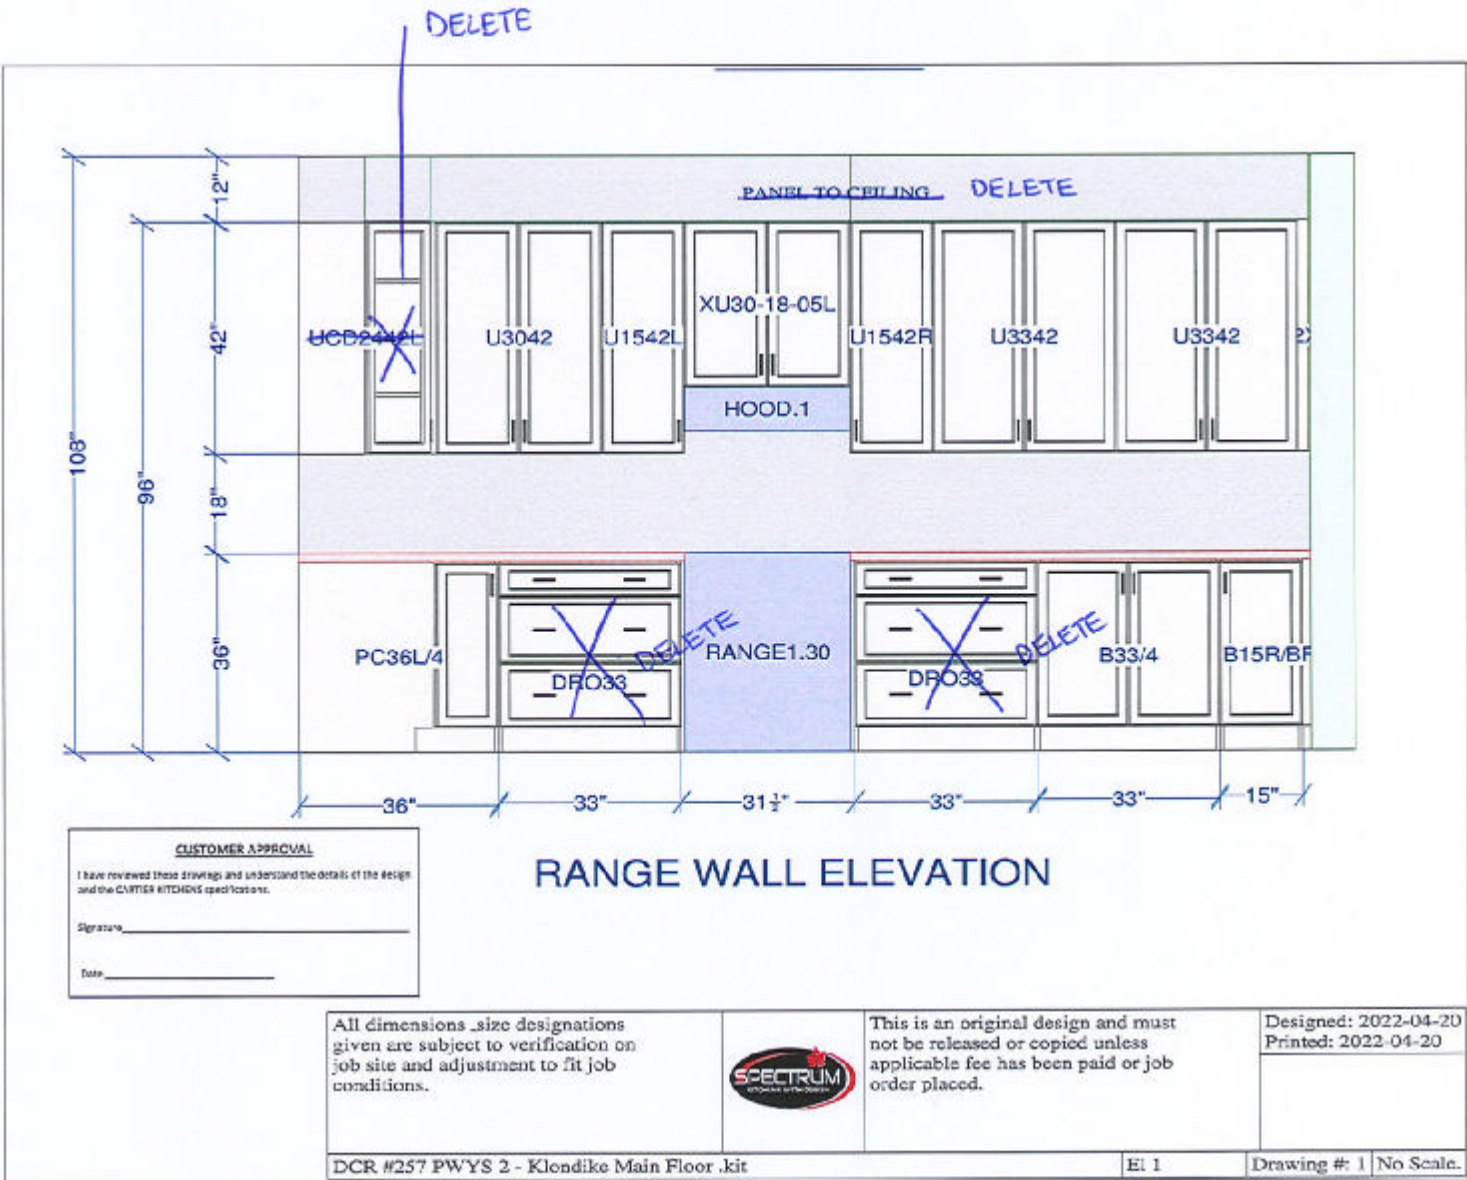

DS DS

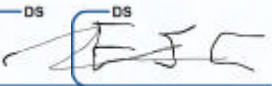

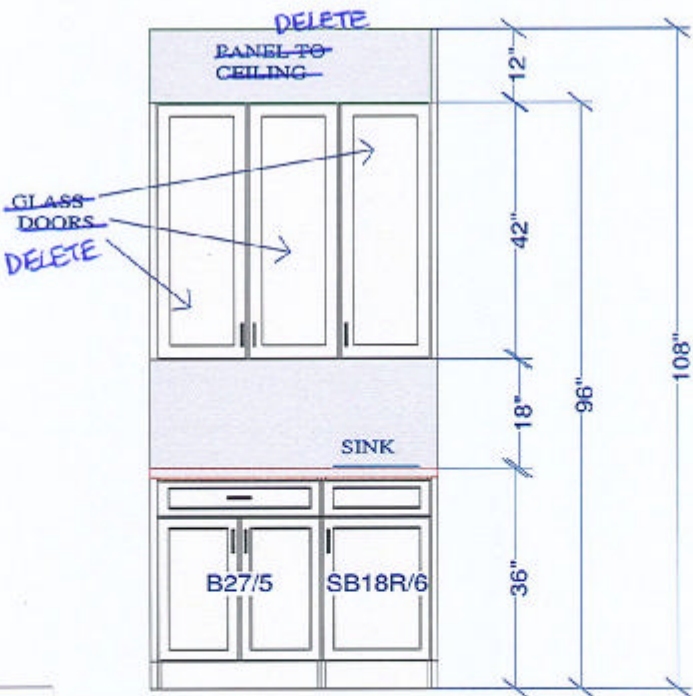

BAR AREA ELEVATION

CUSTOMER APPROVAL


I have reviewed these drawings and understand the details of the design and the CARTIER KITCHENS specifications.

Signature _____

Date _____

All dimensions ,size designations given are subject to verification on job site and adjustment to fit job conditions.		This is an original design and must not be released or copied unless applicable fee has been paid or job order placed.	Designed: 2022-04-20 Printed: 2022-04-20		
DCR #257 PWYS 2 - Klondike Main Floor .kit			E1 3	Drawing #: 1	No Scale.

DS DS

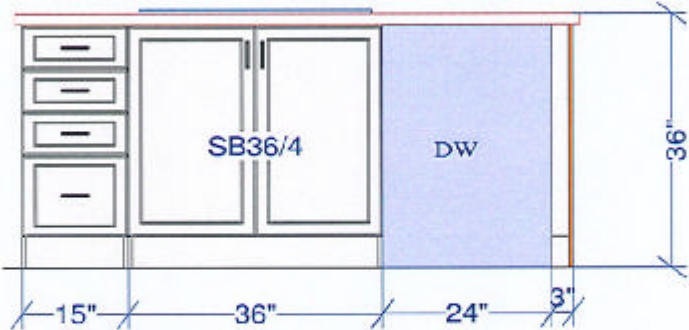ISLAND ELEVATION

CUSTOMER APPROVAL
I have reviewed these drawings and understand the details of the design and the CARTER KITCHENS specifications.
Signature: _____
Date: _____


All dimensions, size designations given are subject to verification on job site and adjustment to fit job conditions.



This is an original design and must not be released or copied unless applicable fee has been paid or job order placed.

Designed: 2022-04-20
Printed: 2022-04-20

DS DS
[Signature]

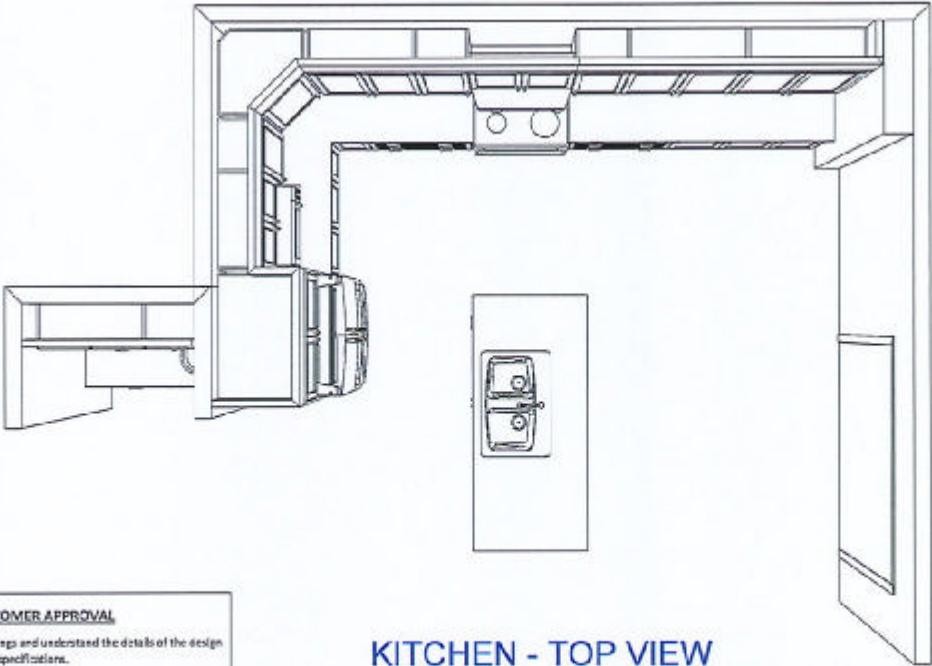

KITCHEN - TOP VIEW

CUSTOMER APPROVAL

I have reviewed these drawings and understand the details of the design and the CARTIER KITCHENS specifications.

Signature _____

Date _____


Note: This drawing is an artistic interpretation of the general appearance of the design. It is not meant to be an exact rendition.



Designed: 2022-04-20
Printed: 2022-04-20

DS

DS

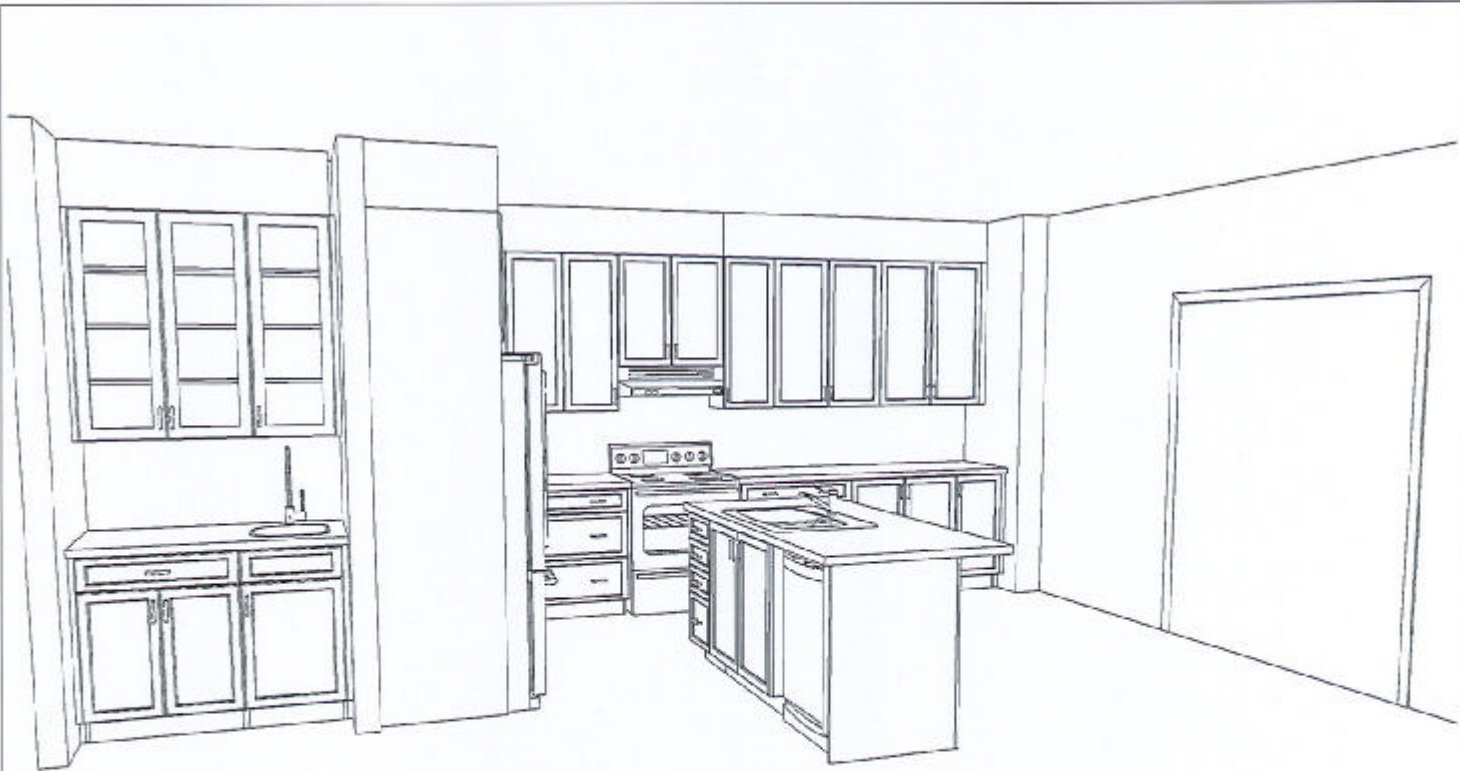

KITCHEN - 3D VIEW #1


CUSTOMER APPROVAL	
I have reviewed these drawings and understand the details of the design and the CAITIER KITCHENS specifications.	
Signature _____	
Date _____	

Note: This drawing is an artistic interpretation of the general appearance of the design. It is not meant to be an exact rendition.



Designed: 2022-04-20
Printed: 2022-04-20

DS DS
A handwritten signature in blue ink, appearing to be "ESC", is written over a blue rectangular box.

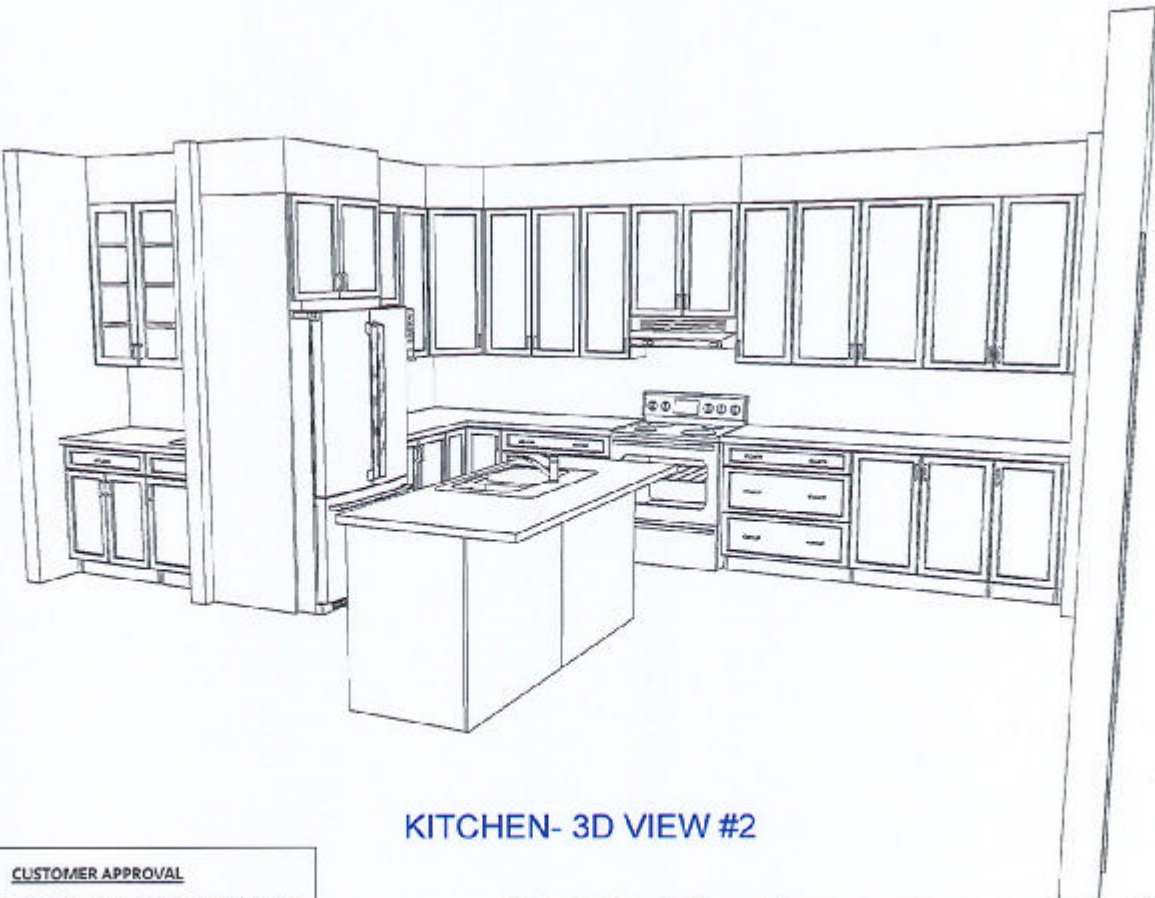


KITCHEN- 3D VIEW #2

CUSTOMER APPROVAL I have reviewed these drawings and understand the details of the design and the CARTIER KITCHENS specifications. Signature _____ Date: _____

Note: This drawing is an artistic interpretation of the general appearance of the design. It is not meant to be an exact rendition.		Designed: 2022-04-20 Printed: 2022-04-20
DCR #257 PWYS 2 - Klondike Main Floor .kit		All Drawing #: 1

DS DS

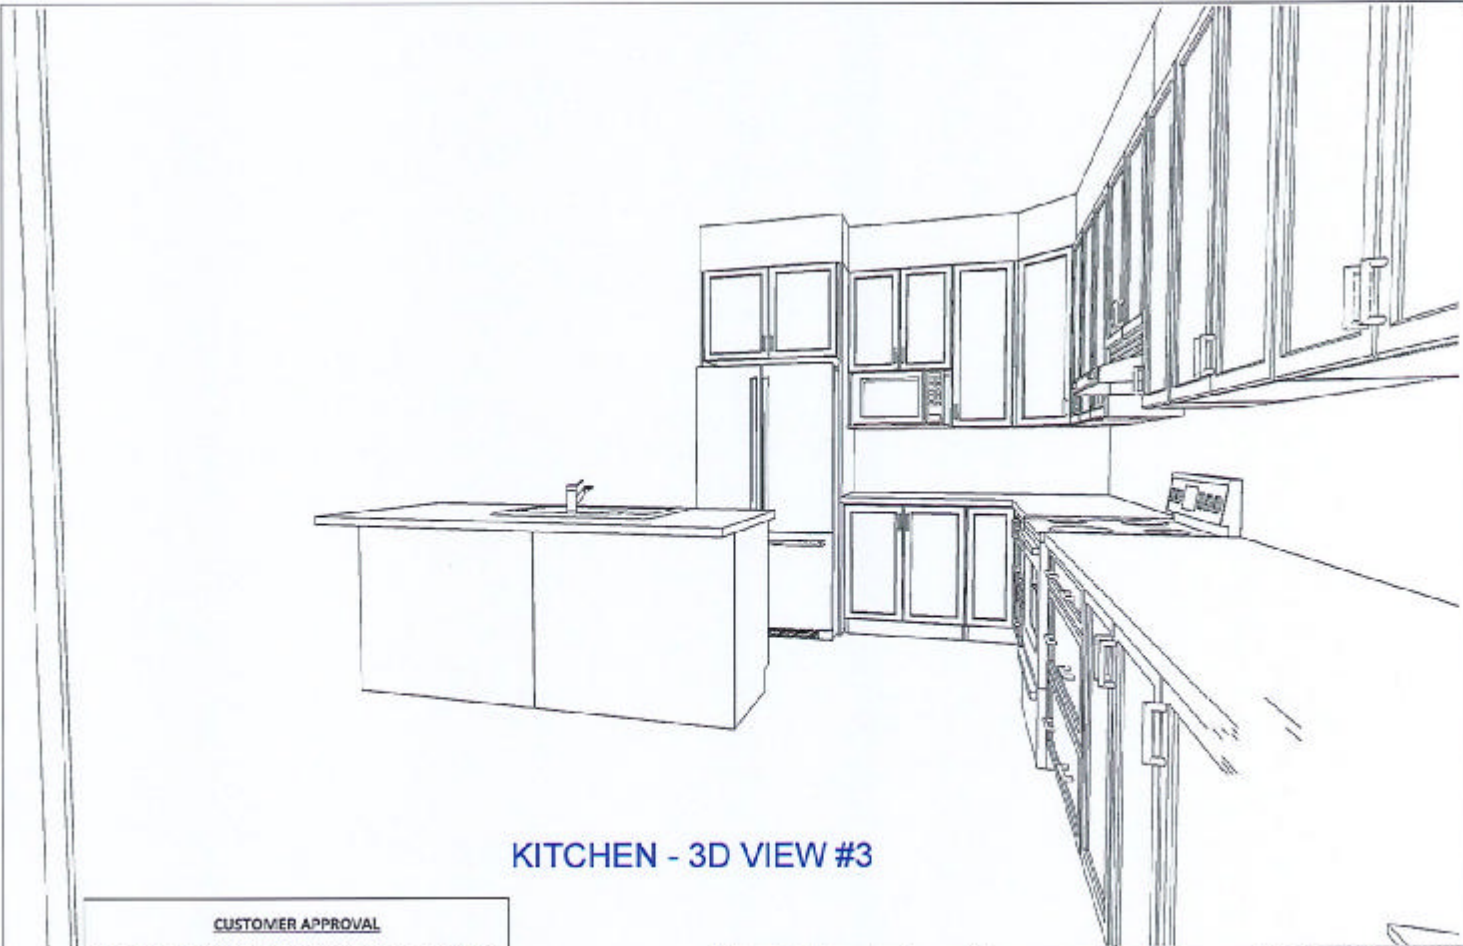KITCHEN - 3D VIEW #3

CUSTOMER APPROVAL

I have reviewed these drawings and understand the details of the design and the CARRIER KITCHENS specifications.

Signature _____

Date _____

Note: This drawing is an artistic interpretation of the general appearance of the design. It is not meant to be an exact rendition.




Designed: 2022-04-20
Printed: 2022-04-20

DCR #257 PWYS 2 - Klondike Main Floor .kit


All

Drawing #: 1

DS DS
[Signature]

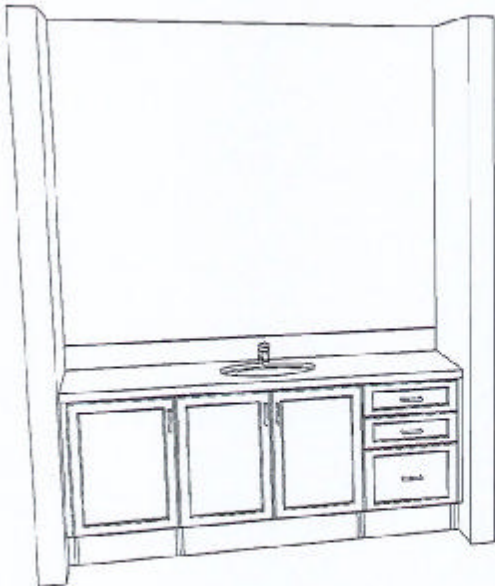

MAIN BATH VANITY

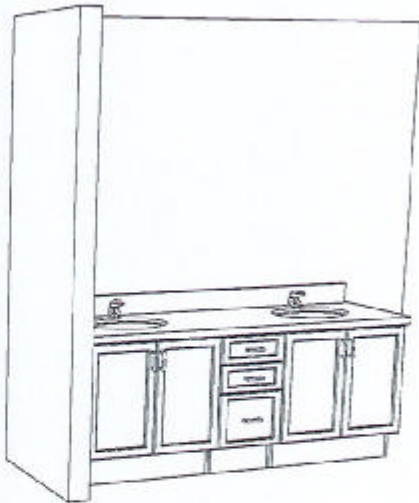

ENSUITE VANITY

CUSTOMER APPROVAL

I have reviewed these drawings and understand the details of the design and the CARTIER KITCHENS specifications.

Signature _____

Date _____

Note: This drawing is an artistic interpretation of the general appearance of the design. It is not meant to be an exact rendition.



Designed: 2022-04-20
Printed: 2022-04-20

DCR #257 PWYS 2 - Klondike Main Floor .kit

All

Drawing #: 1

DS DS
[Signature]