

DCR - PHOENIX HOMES


LOT #275
PATHWAYS 2
NEWINGTON - 5 BDRM

STANDARD KITCHEN
MOUNTING HEIGHT: 96

42" H. UPPERS @ 18" ABOVE COUNTER

- KITCHEN
CABINETS -
HARDWARE -
STANDARD WHITE INTERIOR
METAL DRAWER BOX
4 PCS - 5/8" KICK - FIN. BOTH ENDS
2 PCS - 90 DEG. CORNER MOULD
1 PCS - T-MOULD
5 PCS - FLAT MOULDING

Bulkhead layout

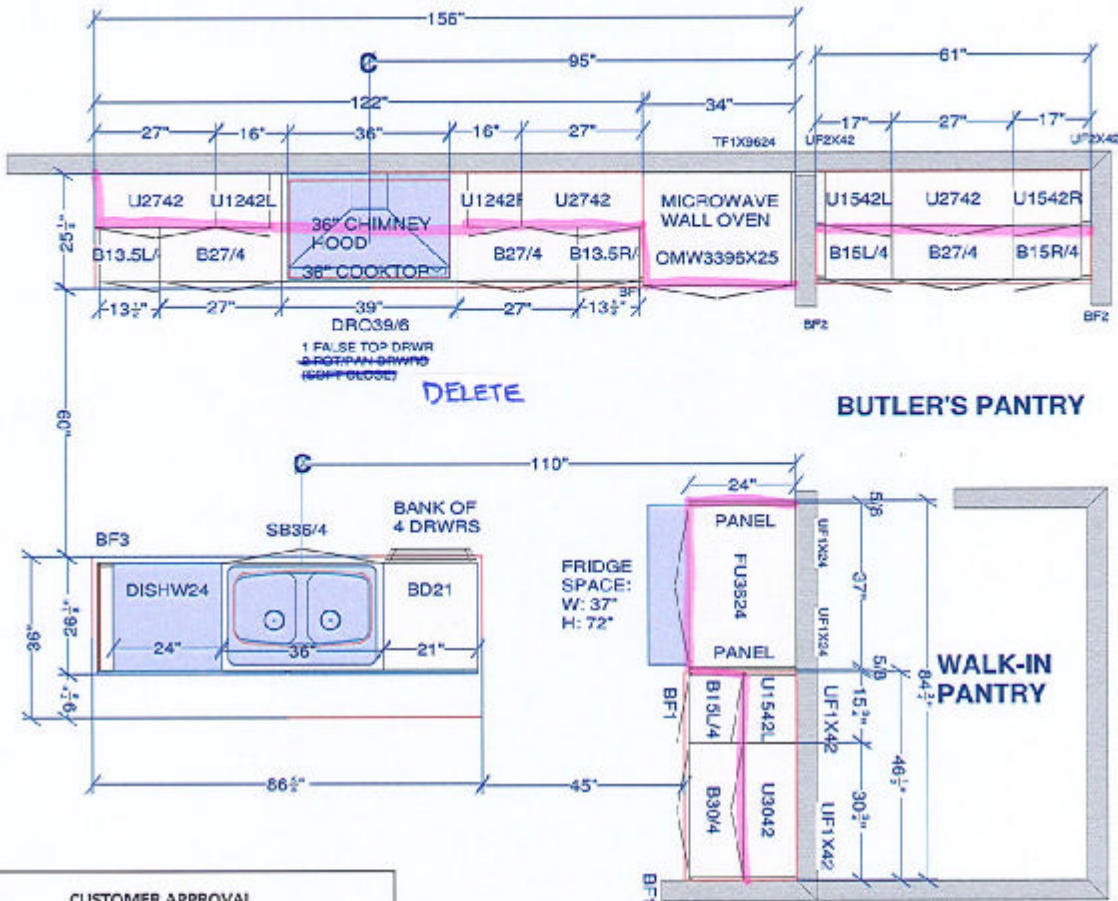

CUSTOMER APPROVAL
I have reviewed these drawings and understand the details of the design and the CARTIER KITCHENS specifications.
Signature _____
Date _____

DELETE CROWN MOULDING
DELETE FILL TO CEILING

All dimensions size designations given are subject to verification on job site and adjustment to fit job conditions.



This is an original design and must not be released or copied unless applicable fee has been paid or job order placed.


Designed: 2022-04-22
Printed: 2022-04-22

DCR #275 PWYS2 - Newington Kitchen.kit

All

Drawing #: 1 No Scale.

DS
CP

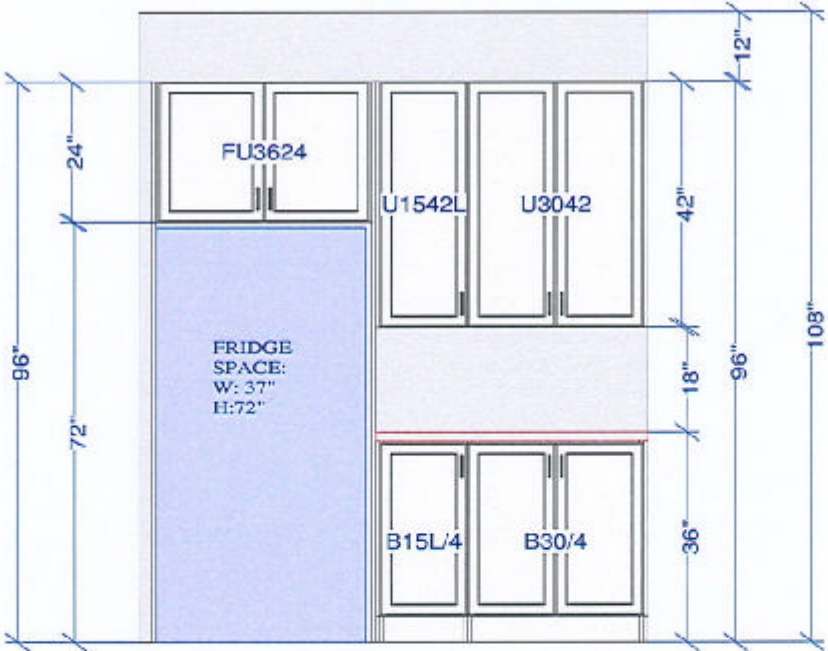

CUSTOMER APPROVAL

I have reviewed these drawings and understand the details of the design and the CARTIER KITCHENS specifications.

Signature _____

Date _____

FRIDGE WALL ELEVATION

All dimensions and size designations given are subject to verification on job site and adjustment to fit job conditions.



This is an original design and must not be released or copied unless applicable fee has been paid or job order placed.


Designed: 2022-04-22
Printed: 2022-04-22

DCR #275 PWYS2 - Newington Kitchen.kit

EI 3

Drawing #: 1 No Scale.

DS CP DS CP

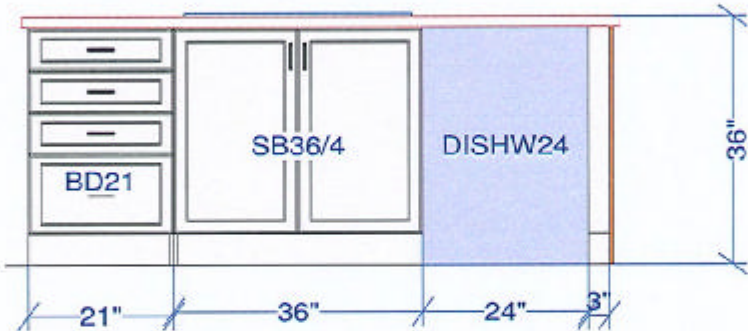

ISLAND ELEVATION

CUSTOMER APPROVAL I have reviewed these drawings and understand the details of the design and the CARTIER KITCHENS specifications. Signature _____ Date _____




All dimensions ,size designations given are subject to verification on job site and adjustment to fit job conditions.		This is an original design and must not be released or copied unless applicable fee has been paid or job order placed.	Designed: 2022-04-22	
			Printed: 2022-04-22	
DCR #275 PWYS2 - Newington Kitchen.kit		El 4	Drawing #: 1	No Scale.

DS

CP

DS

CP

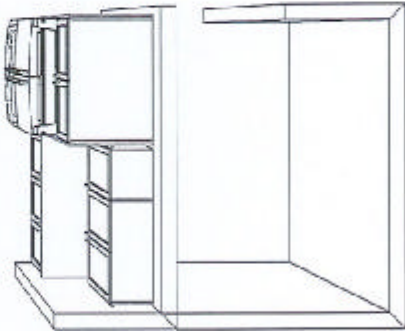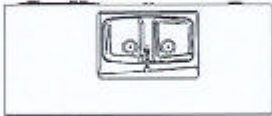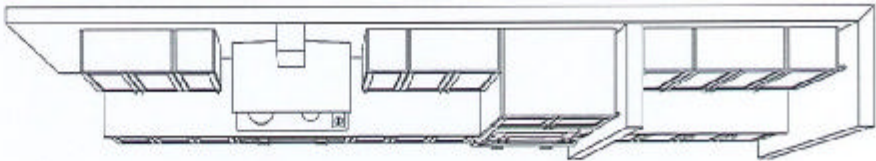

KITCHEN - TOP VIEW

CUSTOMER APPROVAL

I have reviewed these drawings and understand the details of the design and the CARTIER KITCHENS specifications.

Signature _____

Date _____

Note: This drawing is an artistic interpretation of the general appearance of the design. It is not meant to be an exact rendition.




Designed: 2022-04-22
Printed: 2022-04-22

DCR #275 PWYS2 - Newington Kitchen.kit

All

Drawing #: 1

DS CP DS CP

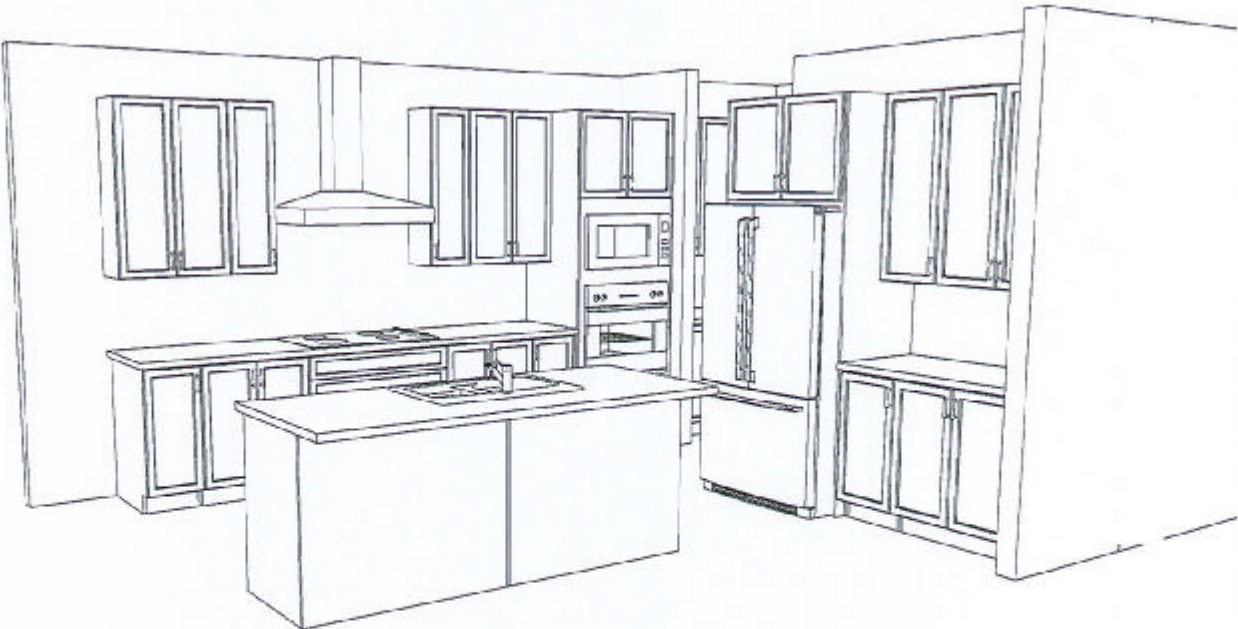

KITCHEN 3D VIEW #1

CUSTOMER APPROVAL	
I have reviewed these drawings and understand the details of the design and the CARTIER KITCHENS specifications.	
Signature _____	
Date _____	

Note: This drawing is an artistic interpretation of the general appearance of the design. It is not meant to be an exact rendition.		Designed: 2022-04-22
		Printed: 2022-04-22
DCR #275 PWYS2 - Newington Kitchen.kit		Drawing #: 1

DS

CP

DS

CP



KITCHEN - 3D VIEW #2

CUSTOMER APPROVAL

I have reviewed these drawings and understand the details of the design and the CARTIER KITCHENS specifications.

Signature _____

Date _____

Note: This drawing is an artistic interpretation of the general appearance of the design. It is not meant to be an exact rendition.		Designed: 2022-04-22 Printed: 2022-04-22
DCR #275 PWYS2 - Newington Kitchen.kit		All Drawing #: 1

DS

CP

DS

CP