


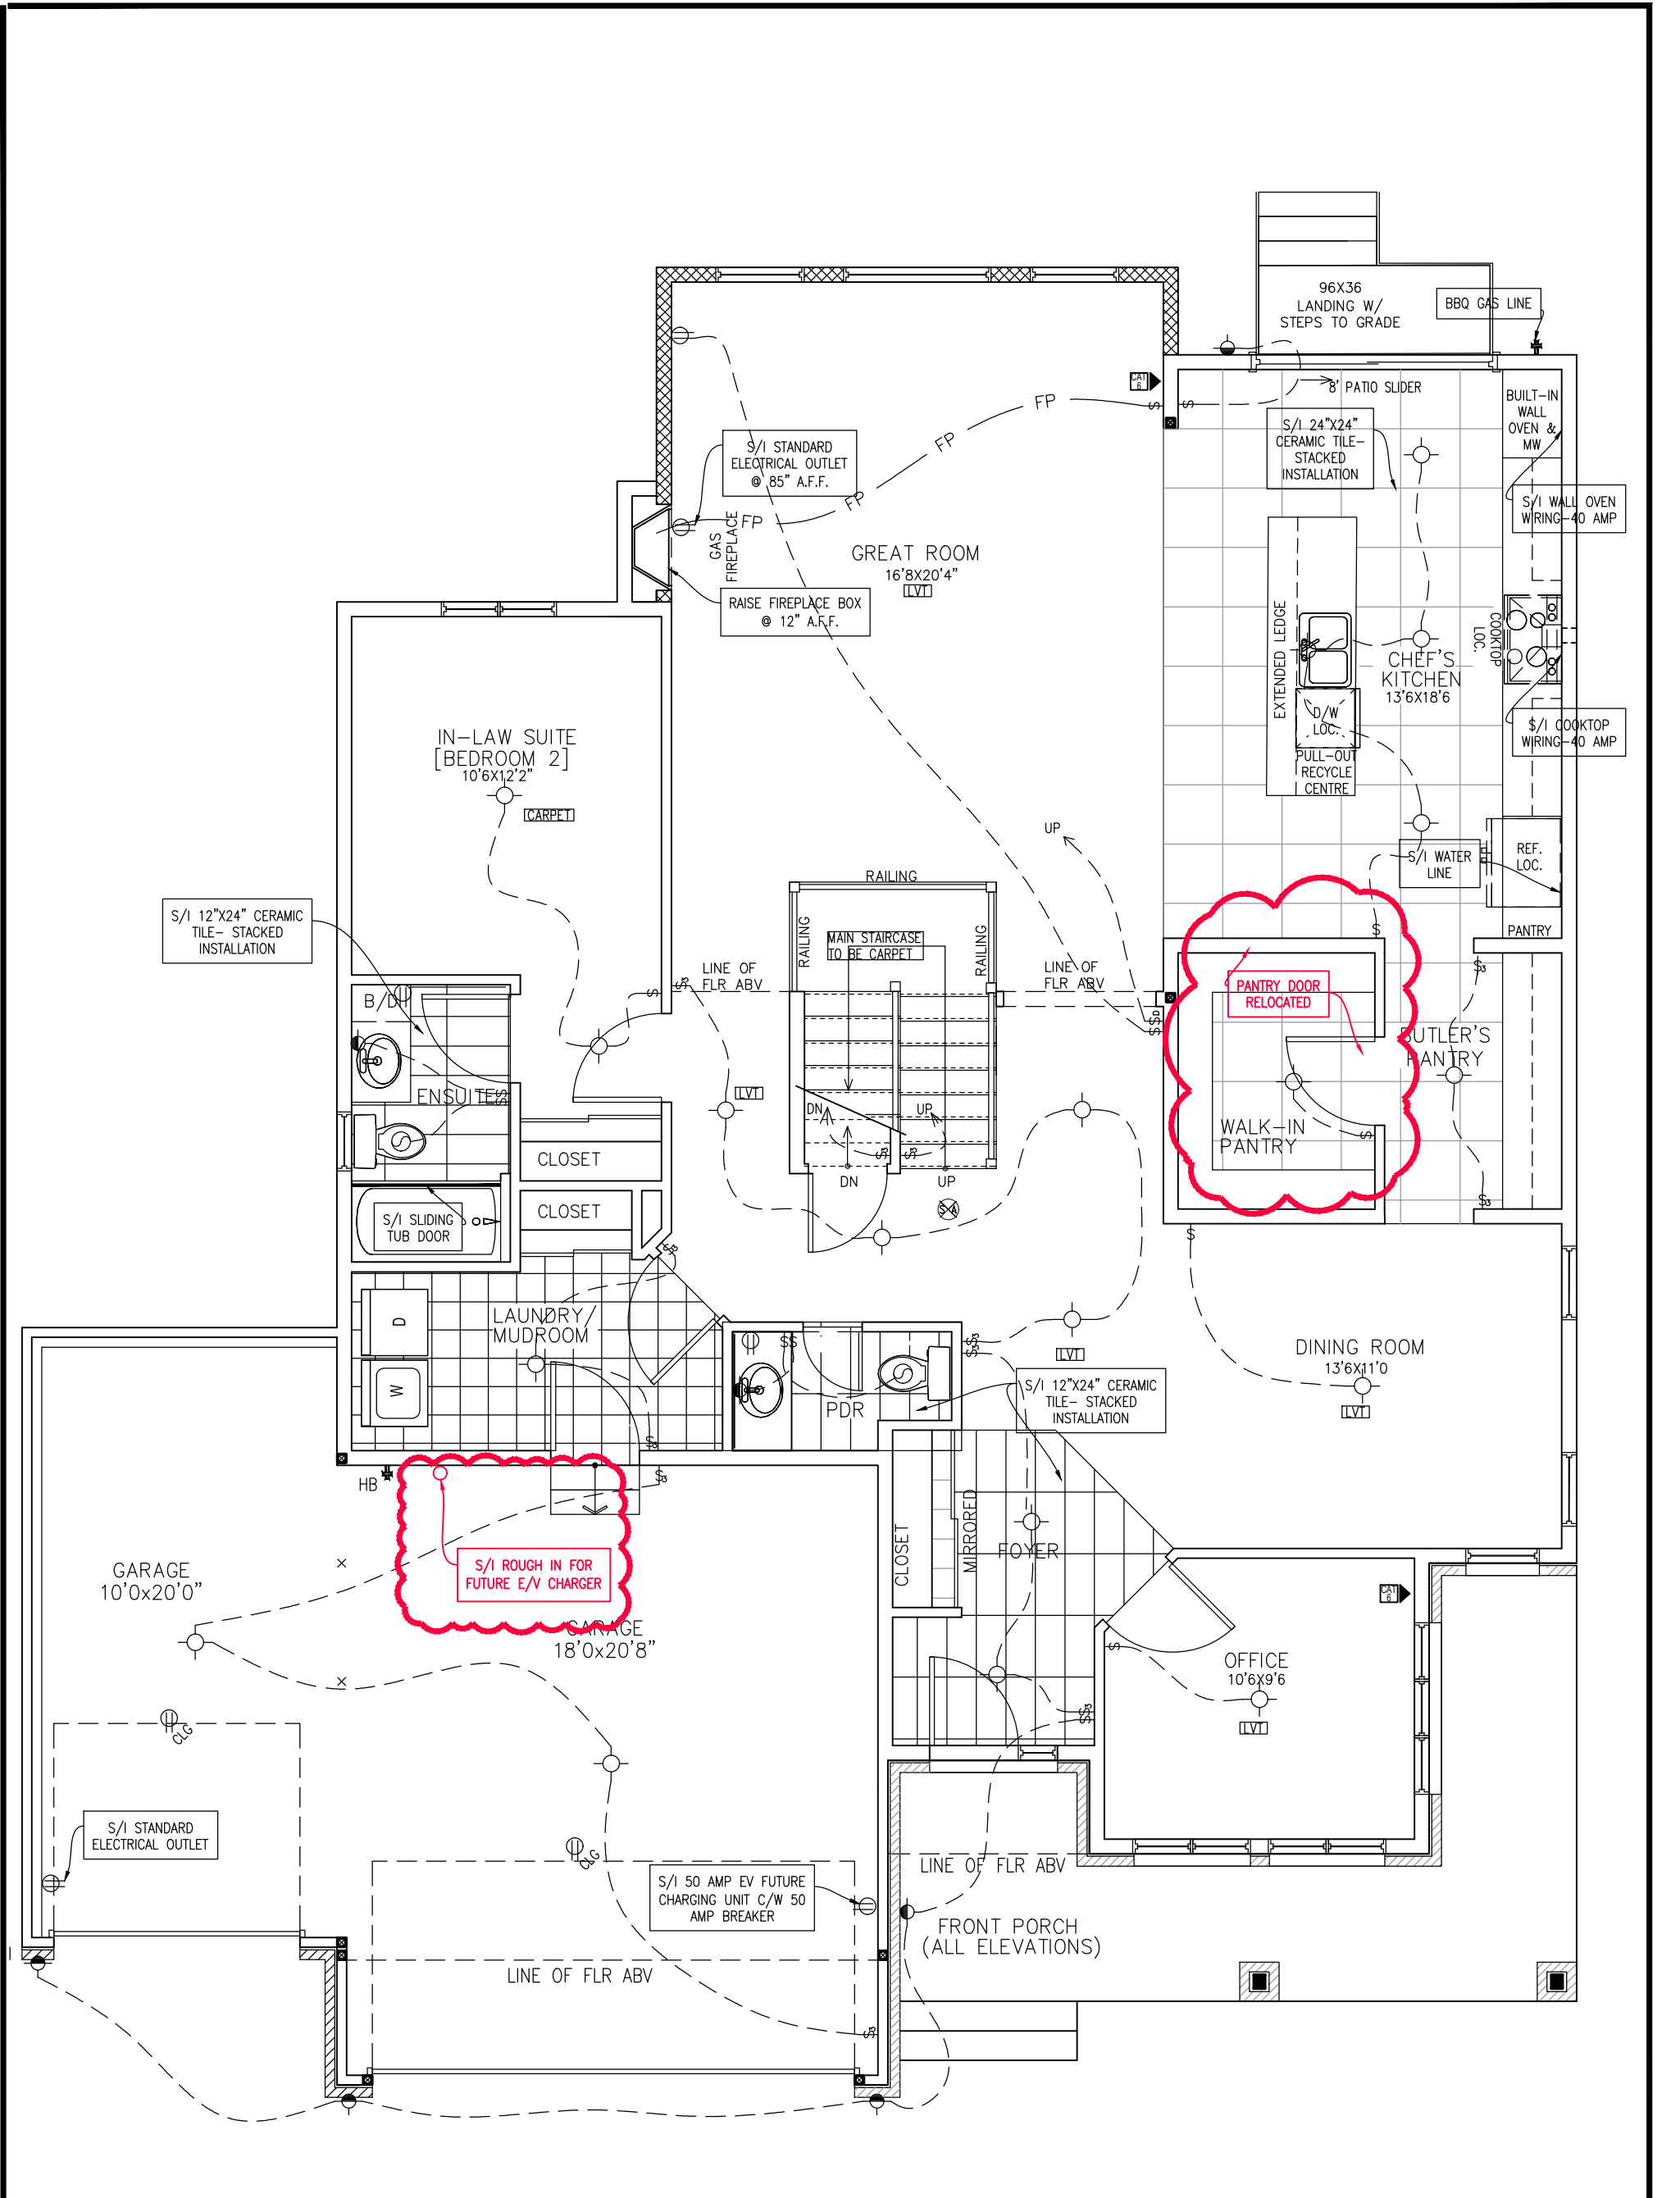

GROUND FLOOR PLAN (ELEVATIONS A,C,D,&F)



NEWINGTON – 2018

SITE: WHITE TAIL RIDGE PH3

LOT NUMBER: 155

CIVIC ADDRESS:
299 ANTLER COURT

10	FINAL BLACKLINES REVISED	01/02/23	CB
9	ISSUED FOR CONSTRUCTION – REVISED	01/02/23	CB
8	ISSUED FOR CONSTRUCTION – REVISED	11/08/22	SP
7	ISSUED FOR CONSTRUCTION	09/08/22	SP
6	FINAL BLACKLINES	11/05/22	KE
5	BEP BLACKLINES	23/02/22	KE
No. Description		dd/mm/yy	By
REVISIONS			

footprint:	518
drawn by:	SP
date:	JUN 12/16
scale:	3/16"=1'-0"
D.C.L. – 187	
sheet no:	3 of 9