

# DCR PHOENIX HOMES

LOT #13  
 DIAMONDVIEW ESTATES - PHASE 2  
 NEWINGTON  
 OPTIONAL CHEF'S KITCHEN  
 (GARAGE LEFT)

- CABINETS -
- HARDWARE -
- STANDARD WHITE INTERIOR
- METAL DRAWER BOX
- 3 PCS - 5/8" KICK - FIN. BOTH ENDS
- 2 PCS - 90 DEG. CORNER MOULD
- 1 PCS - T-MOULD
- 5 PCS - FLAT MOULDING

MOUNTING HEIGHT: 96


42"H UPPERS INSTALLED @ 18" ABOVE COUNTER

CROWN MOULDING

LIGHT VALANCE

Fill to ceiling with 1" moulding, furring panel and ceiling crown, 12" total

NOTE: BUILDER TO REDUCE BUTLER'S PANTRY TO MAKE DINING ROOM LARGER

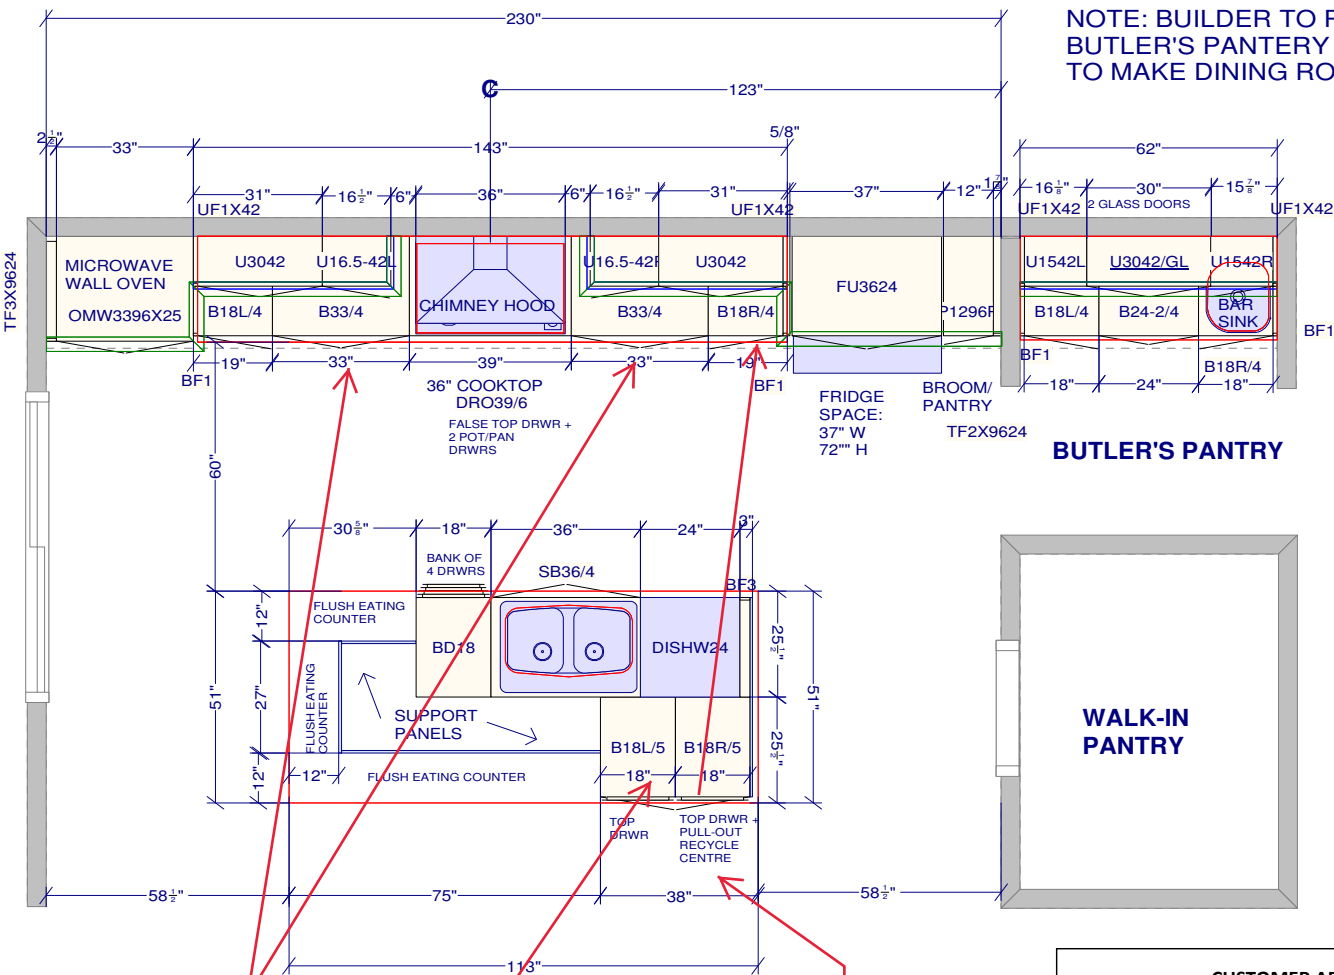

Replace these the two 18" cabinets with a single 36" cabinet with 2 full height doors - top drawers to be relocated to either side of the stove

Relocate recycling centre to the left of the fridge

DS  
 CR

**CUSTOMER APPROVAL**  
 I have reviewed these drawings and understand the details of the design and the CARTIER KITCHENS specifications.  
 Signature \_\_\_\_\_  
 Date \_\_\_\_\_

2/2/2023 | 1:42 PM EST


DS  
 CR

All dimensions size designations given are subject to verification on job site and adjustment to fit job conditions.  
 SPECTRUM KITCHEN and BATH DESIGN



This is an original design and must not be released or copied unless applicable fee has been paid or job order placed.  
 DRAWN BY: LORI DISAVERIO, B.I.D

Designed: 2021-08-27  
 Printed: 2021-08-27

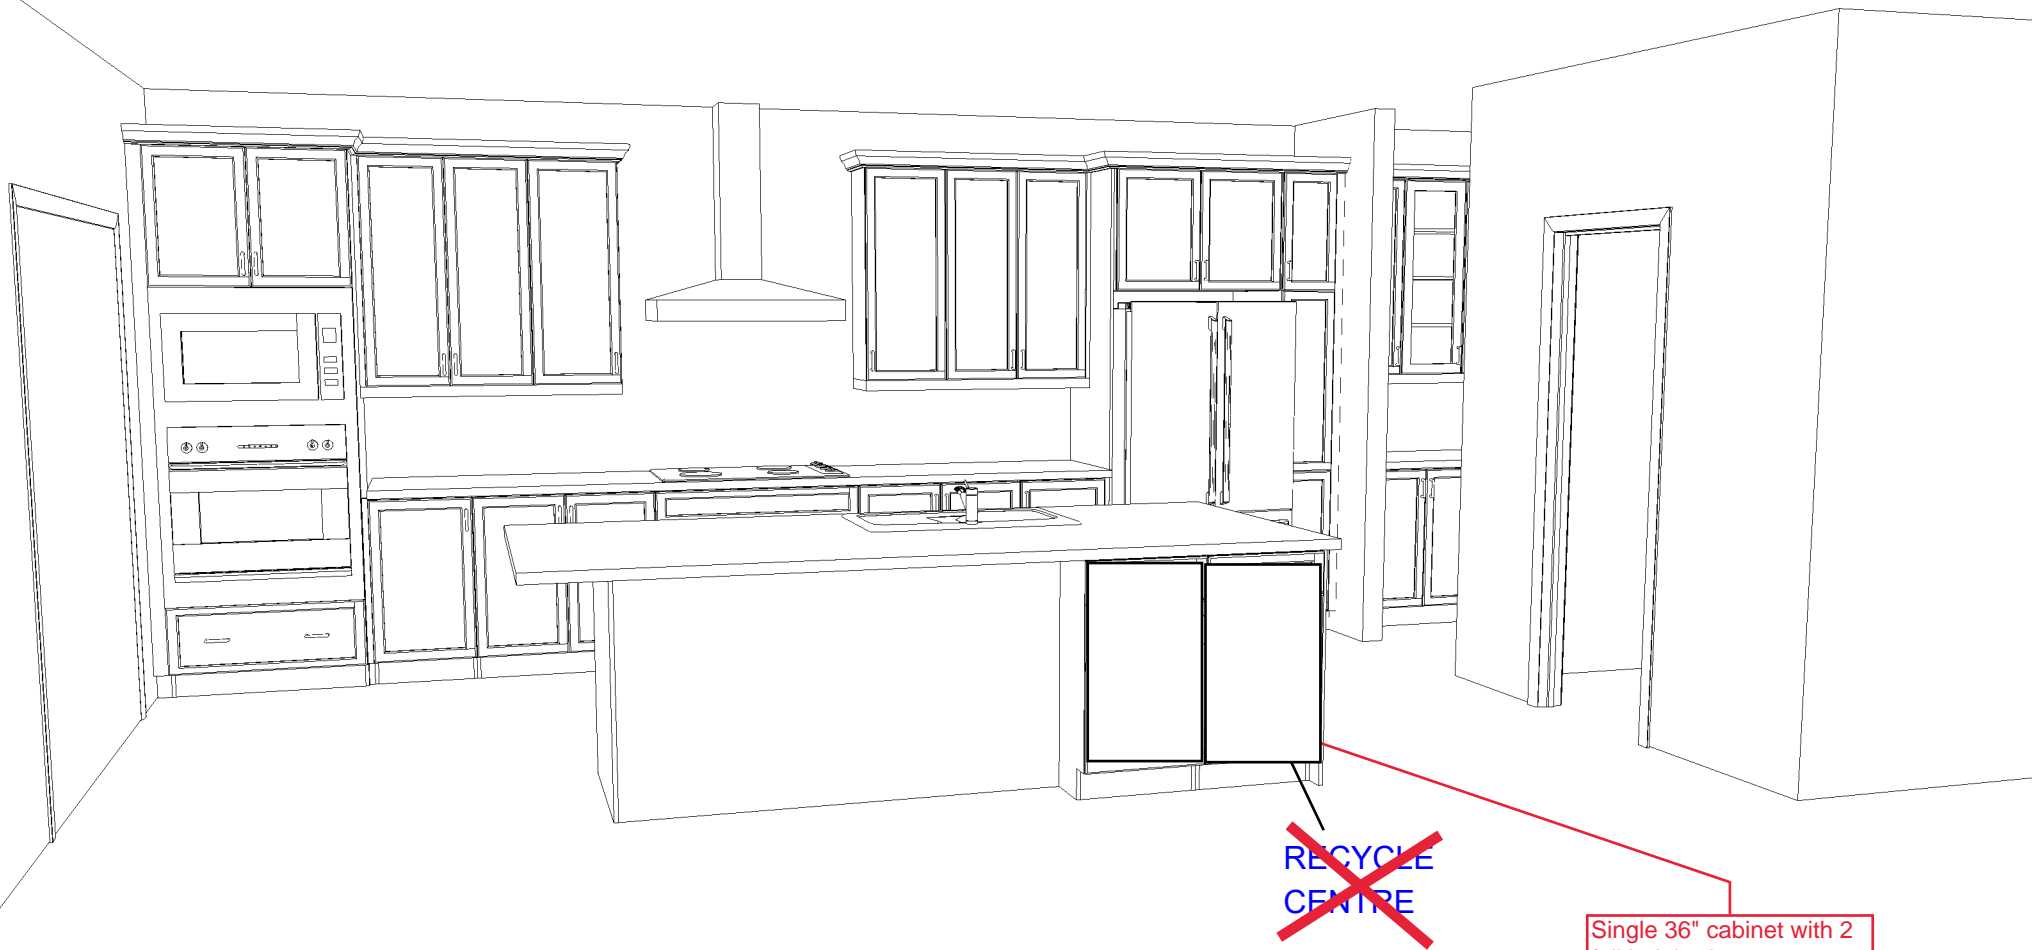

RECYCLE  
CENTRE

Single 36" cabinet with 2  
full height doors

### KITCHEN - 3D VIEW #1

DS  
CN

DS  
CR

2/2/2023 | 1:42 PM EST

#### CUSTOMER APPROVAL

I have reviewed these drawings and understand the details of the design and the CARTIER KITCHENS specifications.

Signature \_\_\_\_\_

Date \_\_\_\_\_

DS  
CR

DS  
CN

Note: This drawing is an artistic interpretation of the general appearance of the design. It is not meant to be an exact rendition.




Designed: 2021-08-27  
Printed: 2021-08-27

SPECTRUM KITCHEN and BATH  
DESIGN

DCR #13 Diamondview 2 - Newington Chef's

All

Drawing #: 1

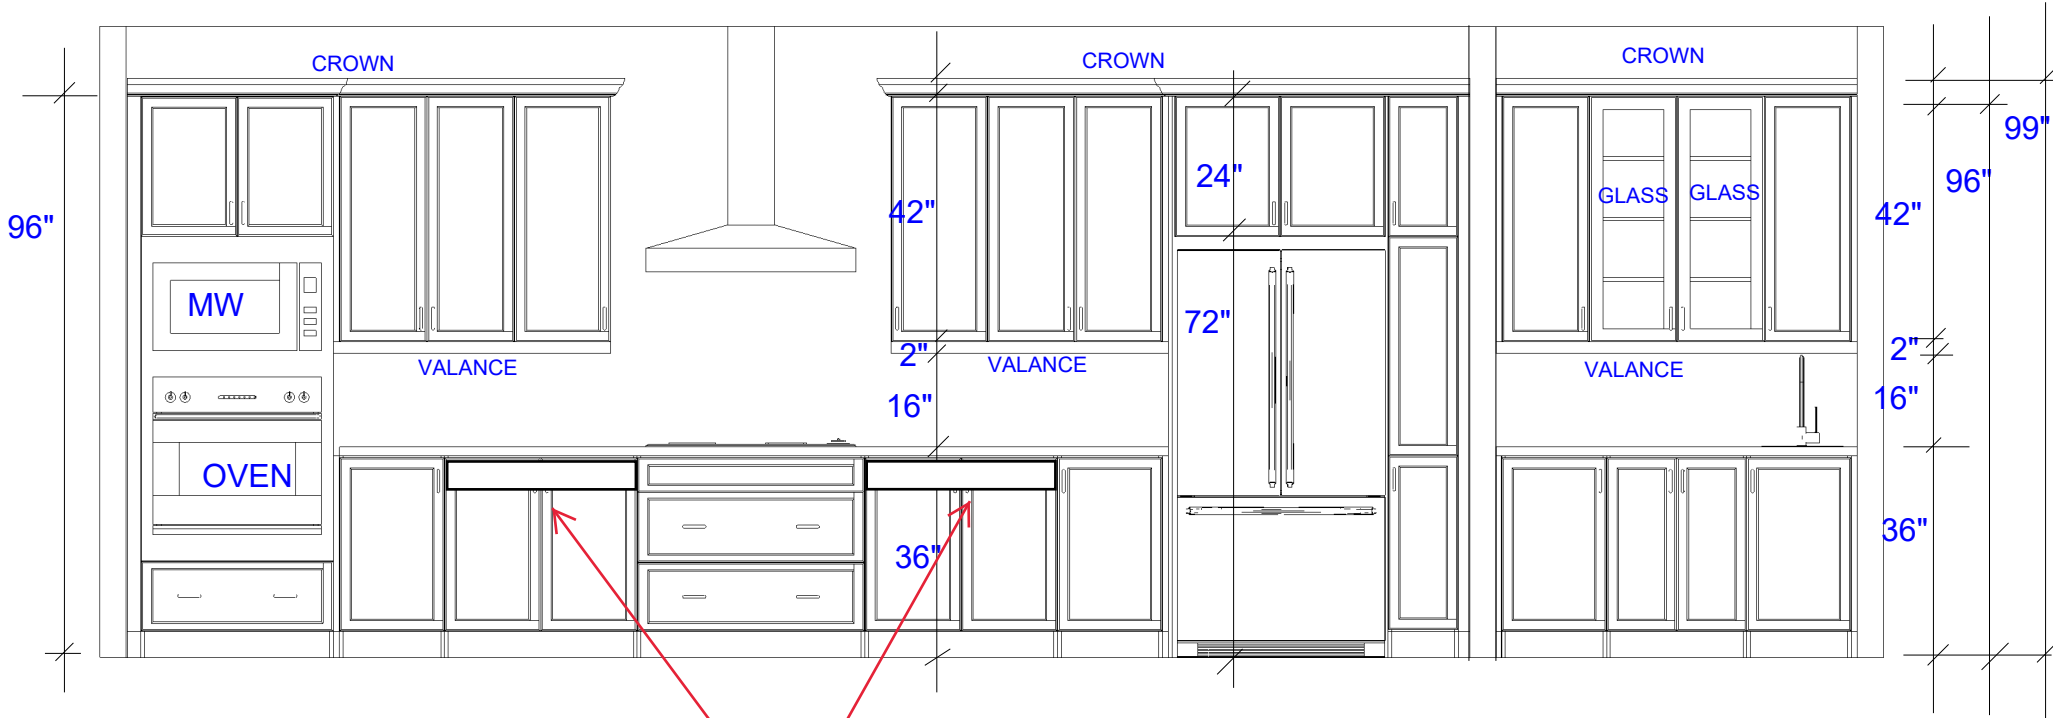

OVEN / COOKTOP/ FRIDGE WALL ELEVATION

BUTLER'S PANTRY

Relocate drawers from back side of island to either side of the cooktop. Drawers to be single top drawers.

DS  
CN

DS  
CR

2/2/2023 | 1:42 PM EST

**CUSTOMER APPROVAL**

I have reviewed these drawings and understand the details of the design and the CARTIER KITCHENS specifications.

Signature \_\_\_\_\_

Date \_\_\_\_\_

DS  
CR

DS  
CN

Note: This drawing is an artistic interpretation of the general appearance of the design. It is not meant to be an exact rendition.



Designed: 2021-08-27  
Printed: 2021-08-27

SPECTRUM KITCHEN and BATH DESIGN

DCR #13 Diamondview 2 - Newington Chef's

All

Drawing #: 1