


DCR PHOENIX HOMES

LOT #3-149  
WHITE TAIL RIDGE 3  
MODEL TYPE: BIRCHWOOD (LOFT)

NOTE:  
ALL UPPER CABINETS DELETED AND  
REPLACED WITH 2.5" THICK  
FLOATING SHELVES.  
HOLLOW IN CENTER TO  
ACCOMMODATE RECESSED PUCK LIGHTS  
AND WIRING.  
(LIGHT FIXTURES & ELECTRICAL BY BUILDER)  
BUILDER TO PROVIDE PLYWOOD BACKING  
IN WALLS WHERE FLOATING SHELVES ARE TO  
BE INSTALLED.

\* ISLAND IS FOR  
REFERENCE ONLY

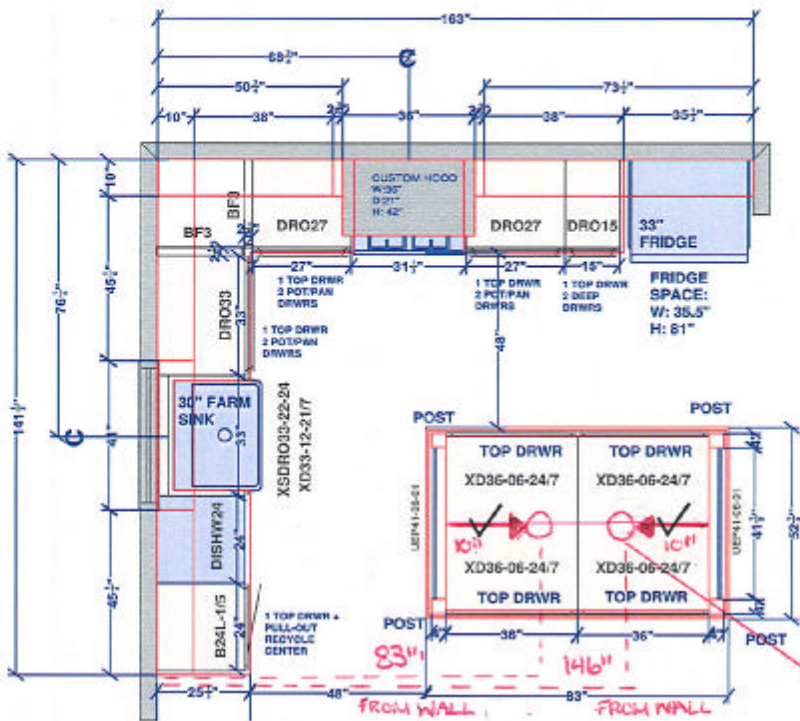

**CUSTOMER APPROVAL**

I have reviewed these drawings and understand the details of the design and the CARTIER KITCHENS specifications.

Signature \_\_\_\_\_

Date \_\_\_\_\_

ISLAND TABLE @ 36"H  
C/W TOP DRAWERS ON 2 SIDES  
OPEN UNDER  
4" x 4" HOLLOW POSTS - ONE EACH CORNER

NOTE: BUILDER TO SUPPLY ELECTRICAL  
IN EACH CORNER POST

All dimensions, size designations given are subject to verification on job site and adjustment to fit job conditions.		This is an original design and must not be released or copied unless applicable fee has been paid or job order placed.	Designed: 2022-01-11 Printed: 2022-01-14
DCR - White Tail Ridge 3 LOT# 3-149 Kitchen.kit		All	Drawing #: 1 No Scale.

DS  
OL

DS  
PS