


DCR PHOENIX HOMES

CHESAPEAKE (508) Left
KITCHEN
MOUNTING HT: 84

- LINE - 1 & 2
- HARDWARE - STD & 1ST UPGRADE
- STD WHITE INTERIORS
- METAL DRWR BOX
- 3 PCS - 5/8" KICK
- 2 PCS - LOOSE FILLER - 6 x 96
- 2 PCS - C MOULD
- 1 PC - T MOULD

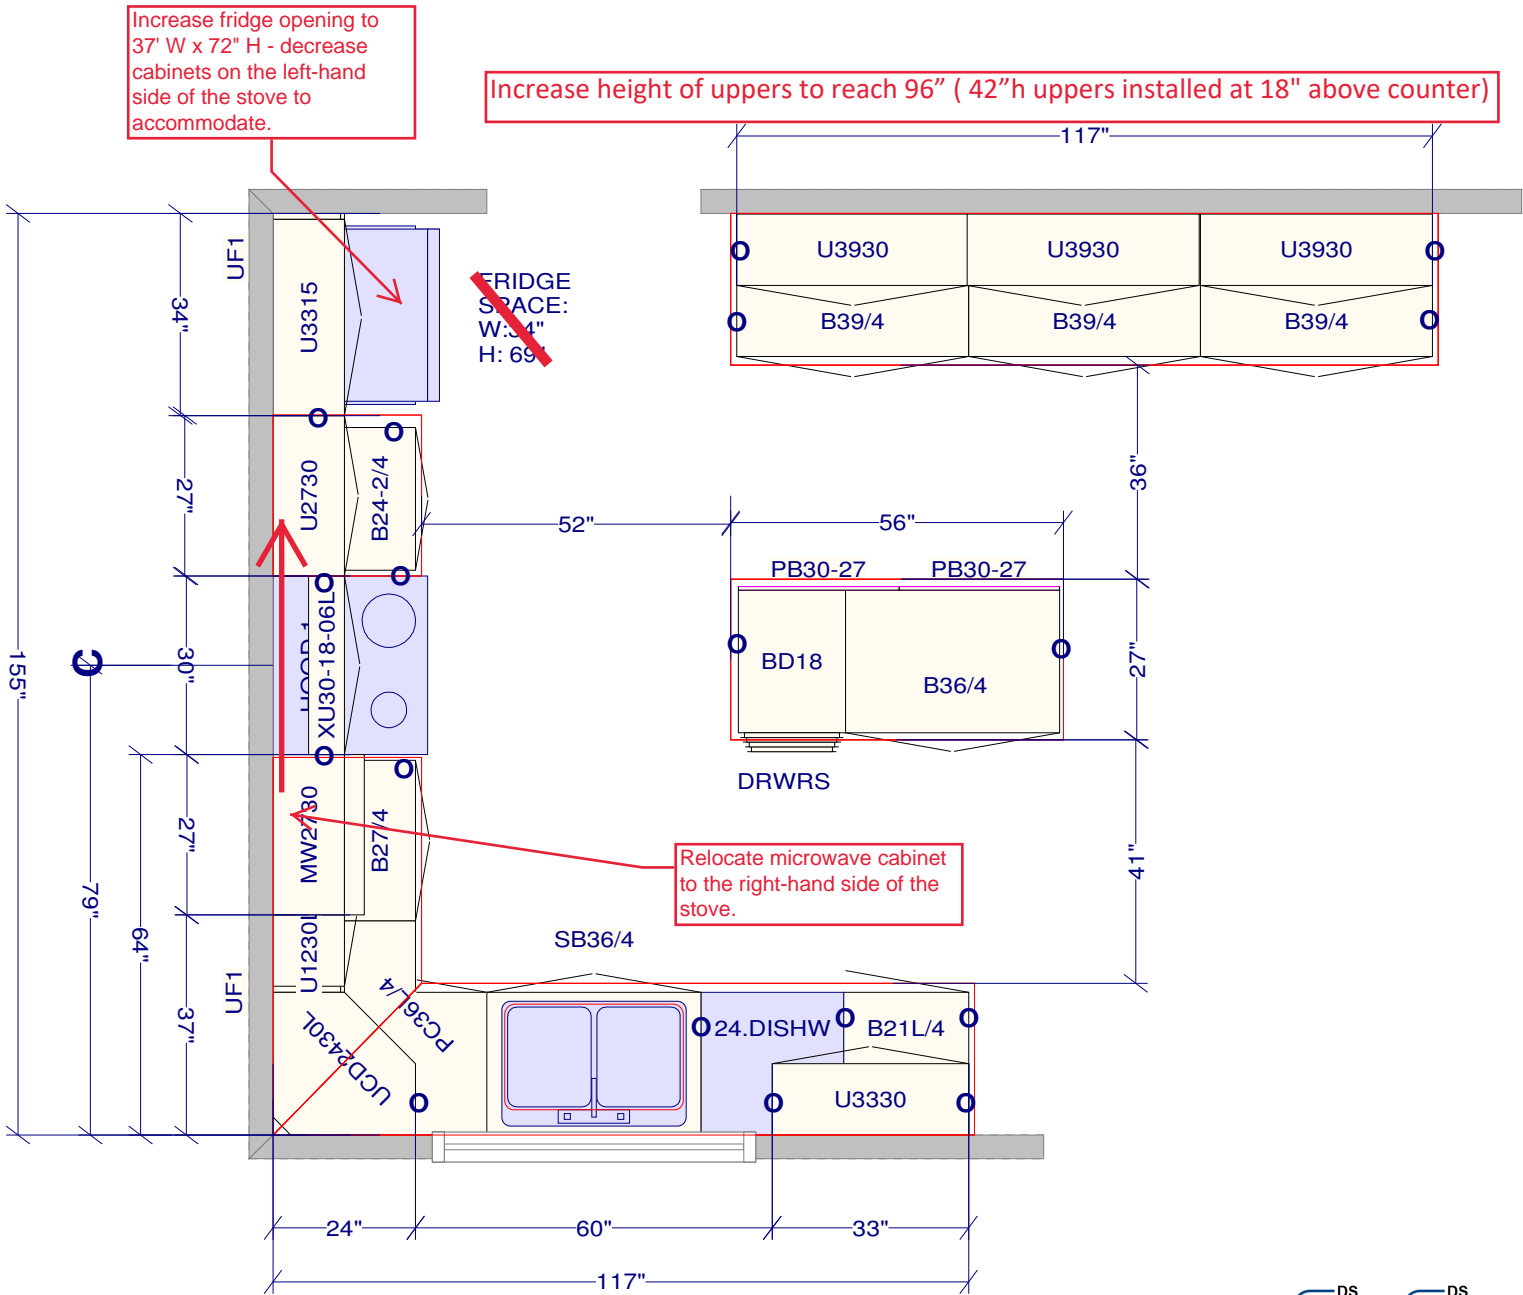

DS
42

DS
45

All dimensions and size designations given are subject to verification on job site and adjustment to fit job conditions.


Cartier Kitchens Ottawa



This is an original design and must not be released or copied unless applicable fee has been paid or job order placed.

Drawn by: Lori Di Saverio, B.I.D.
Cartier Kitchens Ottawa

Designed: 07/08/2013
Printed: 07/08/2013

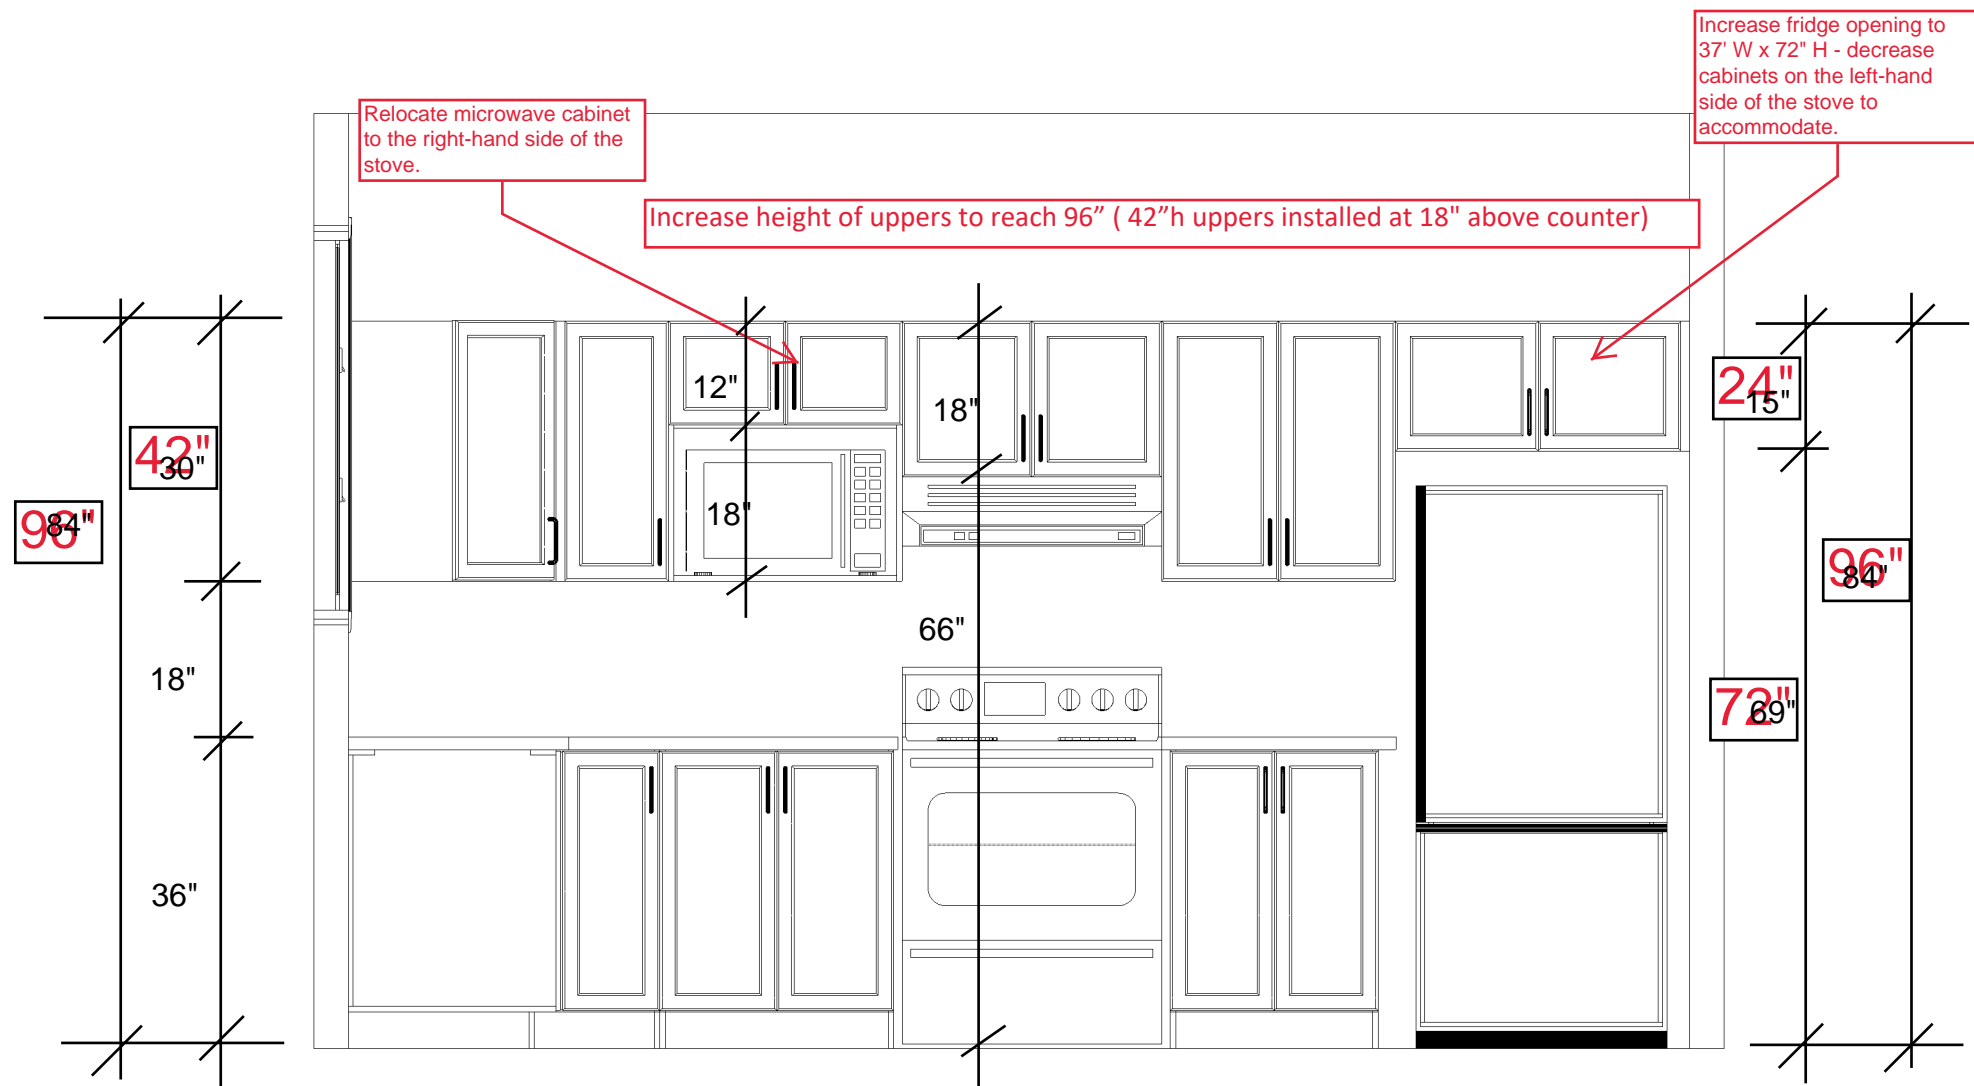

STOVE / FRIDGE WALL ELEVATION
CHESAPEAKE (508) - LEFT

DS
42 DS
45

Note: This drawing is an artistic interpretation of the general appearance of the design. It is not meant to be an exact rendition.

2020
TECHNOLOGIES


Designed: 17/07/2013
Printed: 07/08/2013

Drawn By: Lori D Saverio, B.I.D.
Cartier Kitchens Ottawa

DCR - 508 CHESAPEAKE - KITCHEN (Left).kit

All

Drawing #: 1

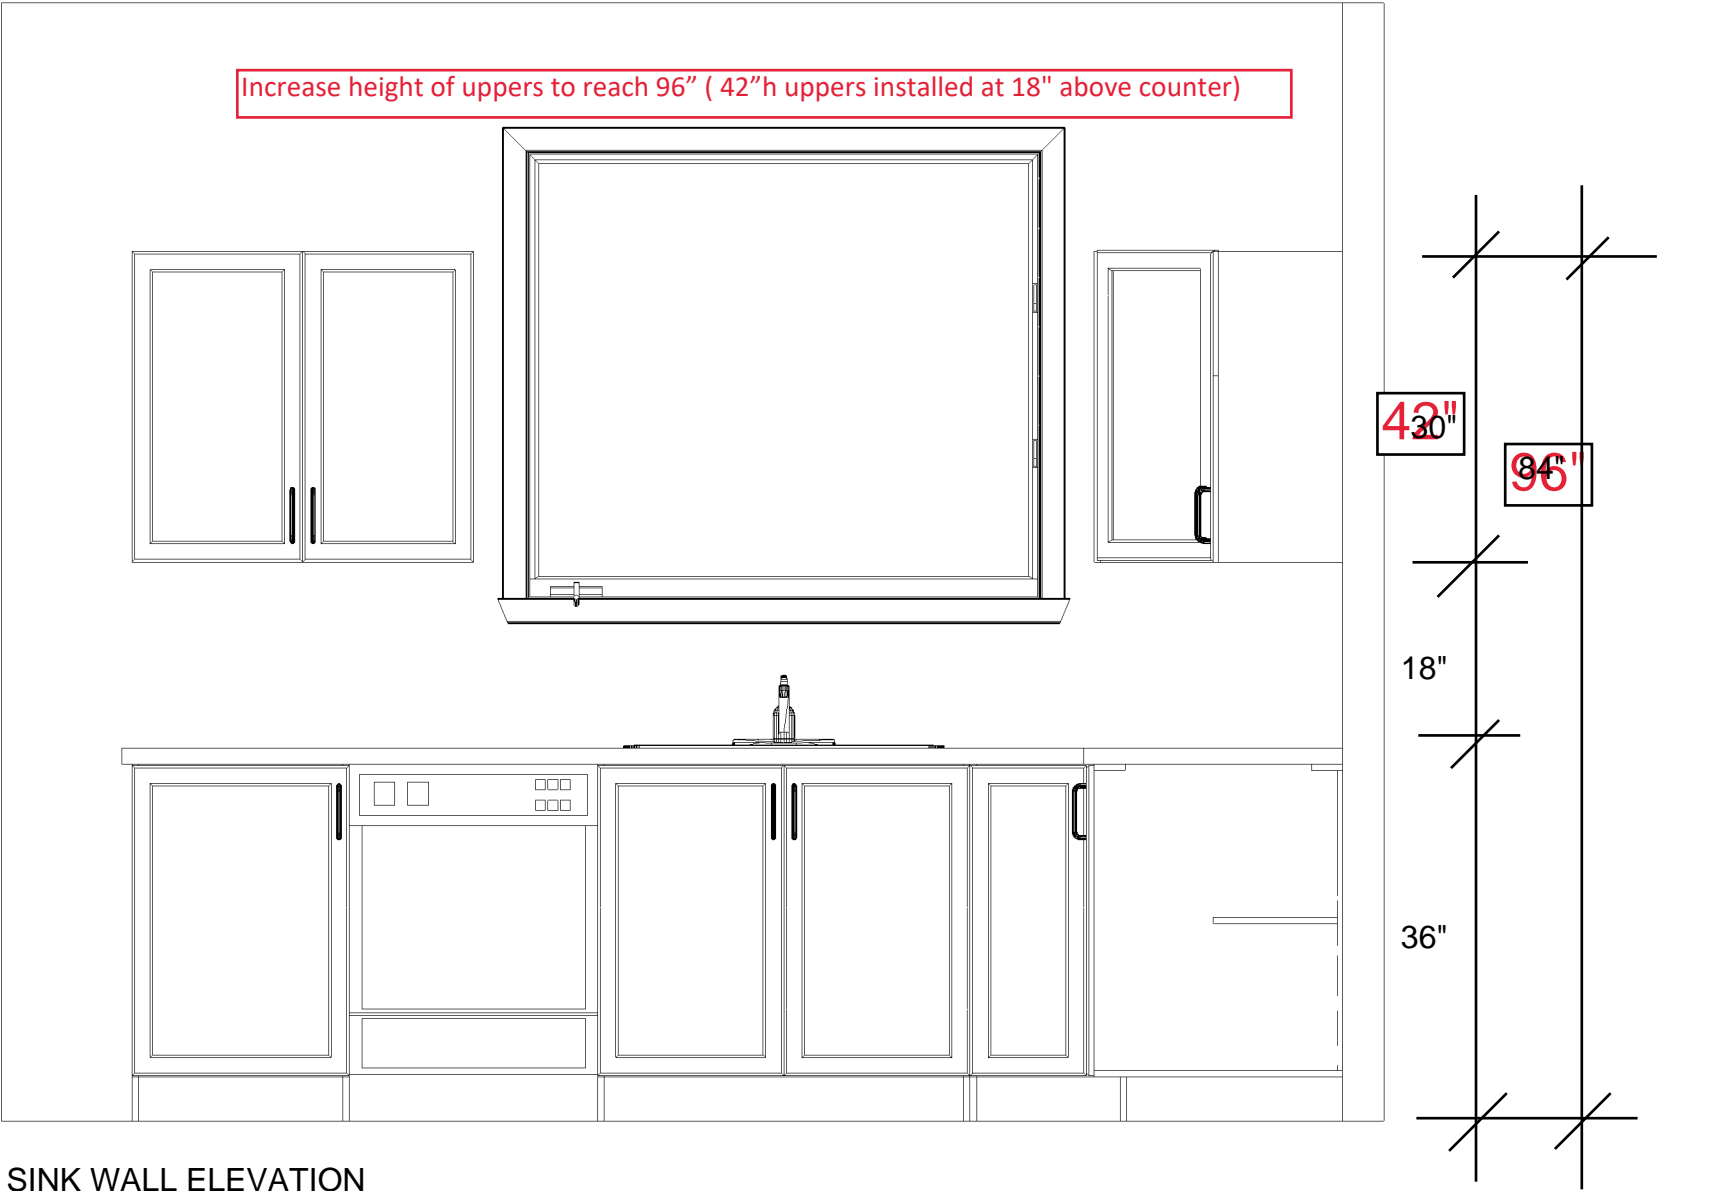

SINK WALL ELEVATION
CHESAPEAKE (508) - LEFT

DS
4E

DS
4S

Note: This drawing is an artistic interpretation of the general appearance of the design. It is not meant to be an exact rendition.




Designed: 17/07/2013
Printed: 07/08/2013

Drawn By: Lori D Saverio, B.I.D.
Cartier Kitchens Ottawa


DCR - 508 CHESAPEAKE - KITCHEN (Left).kit

All

Drawing #: 1

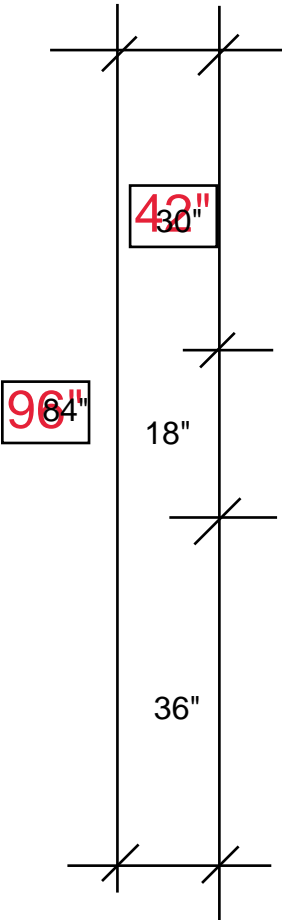

Increase height of uppers to reach 96" (42"h uppers installed at 18" above counter)

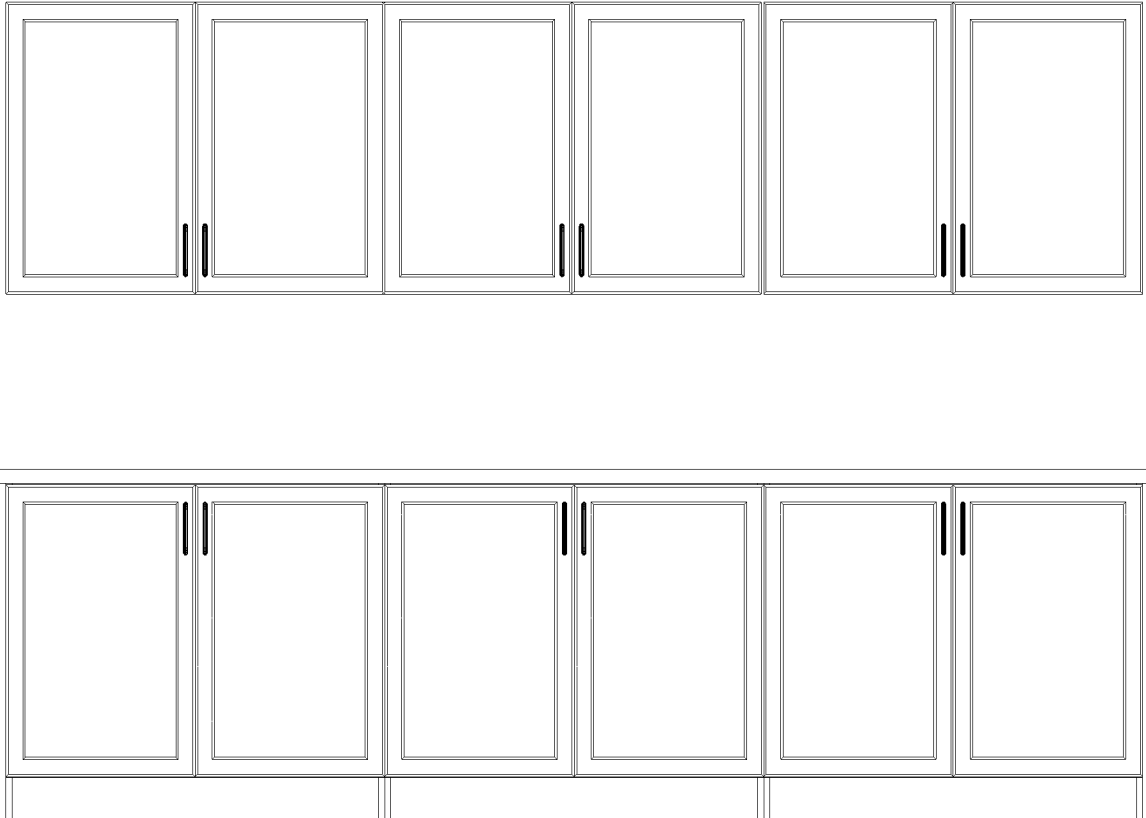

BUFFET WALL ELEVATION
CHESAPEAKE (508) LEFT

DS DS
42 45

Note: This drawing is an artistic interpretation of the general appearance of the design. It is not meant to be an exact rendition.




Designed: 17/07/2013
Printed: 07/08/2013

Drawn By: Lori D Saverio, B.I.D.
Cartier Kitchens Ottawa

DCR PHOENIX HOMES


CHESAPEAKE (508) - LEFT
ALT 4 BDRM / 2ND ENSUITE
VANITIES

LINE - 1 & 2
HARDWARE - STD & 1ST UPGRADE
STD WHITE INTERIORS
METAL DRWR BOX
5/8" KICK

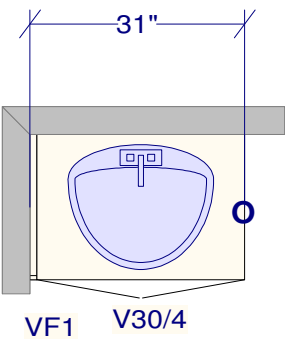


POWDER

Increase vanity height to 36" H

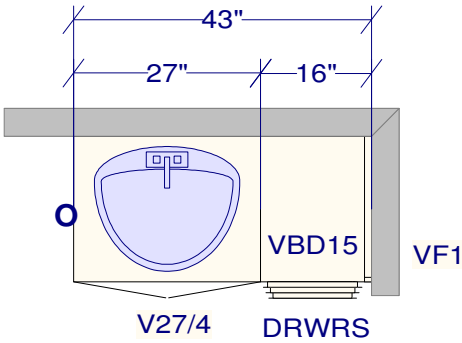


MAIN BATH

Increase vanity height to 36" H

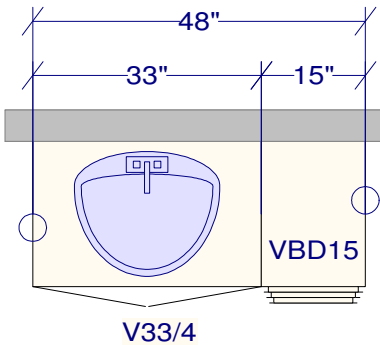

2ND ENSUITE

Increase vanity height to 36" H

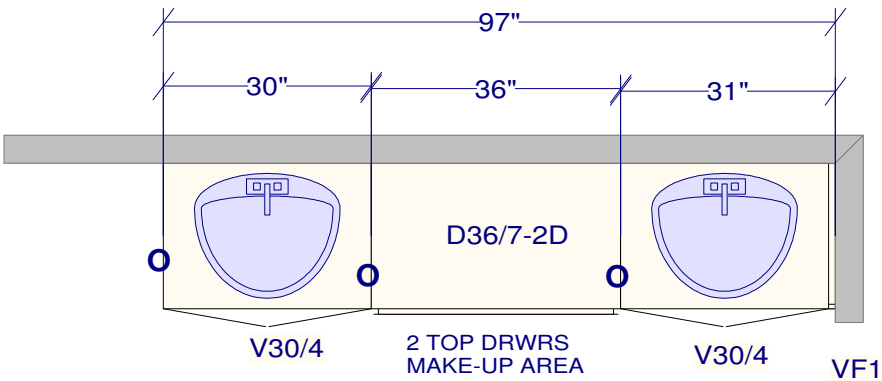

MASTER ENSUITE

Increase vanity height to 36" H

DS
42
DS
45

All dimensions ,size designations given are subject to verification on job site and adjustment to fit job conditions.

Cartier Kitchens Ottawa



This is an original design and must not be released or copied unless applicable fee has been paid or job order placed.

Drawn by: Lori Di Saverio, B.I.D.
Cartier Kitchens Ottawa

Designed: 17/07/2013
Printed: 09/12/2013