

KITCHEN - TOP VIEW

CUSTOMER APPROVAL

I have reviewed these drawings and understand the details of the design and the CARTIER KITCHENS specifications.


Signature _____

Date _____

Note: This drawing is an artistic interpretation of the general appearance of the design. It is not meant to be an exact rendition.



Designed: 2021-10-19
Printed: 2021-10-19

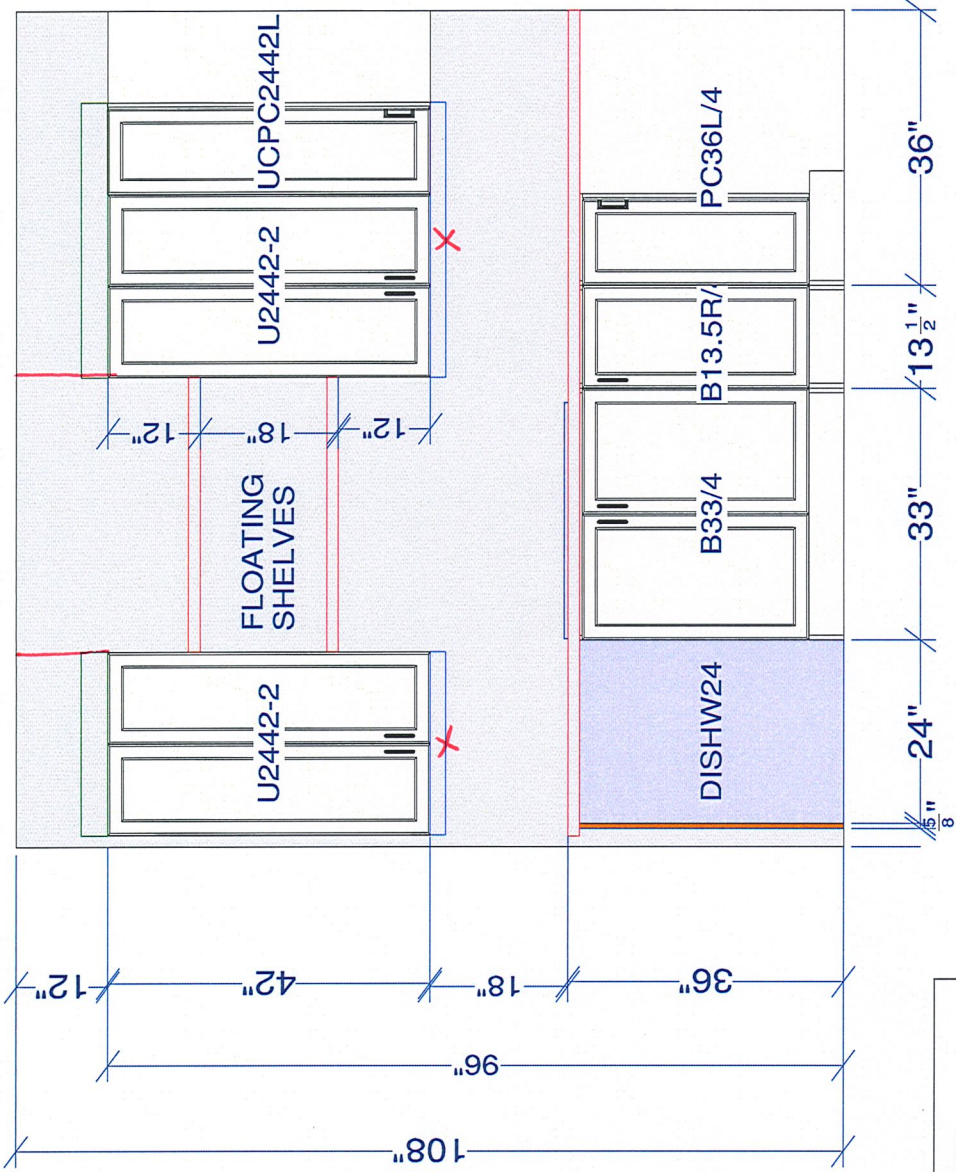


CUSTOMER APPROVAL


I have reviewed these drawings and understand the details of the design and the CARTIER KITCHENS specifications.

Signature _____

Date _____

SINK WALL ELEVATION

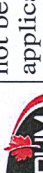All dimensions _size designations given are subject to verification on job site and adjustment to fit job conditions.		This is an original design and must not be released or copied unless applicable fee has been paid or job order placed.	Designed: 2021-10-19 Printed: 2021-10-19
DCR #311 Pathways 2 - Klondike Main Floor Kitchen, 2nd floor vanities.kit			EI 1
			Drawing #: 1
			No Scale.

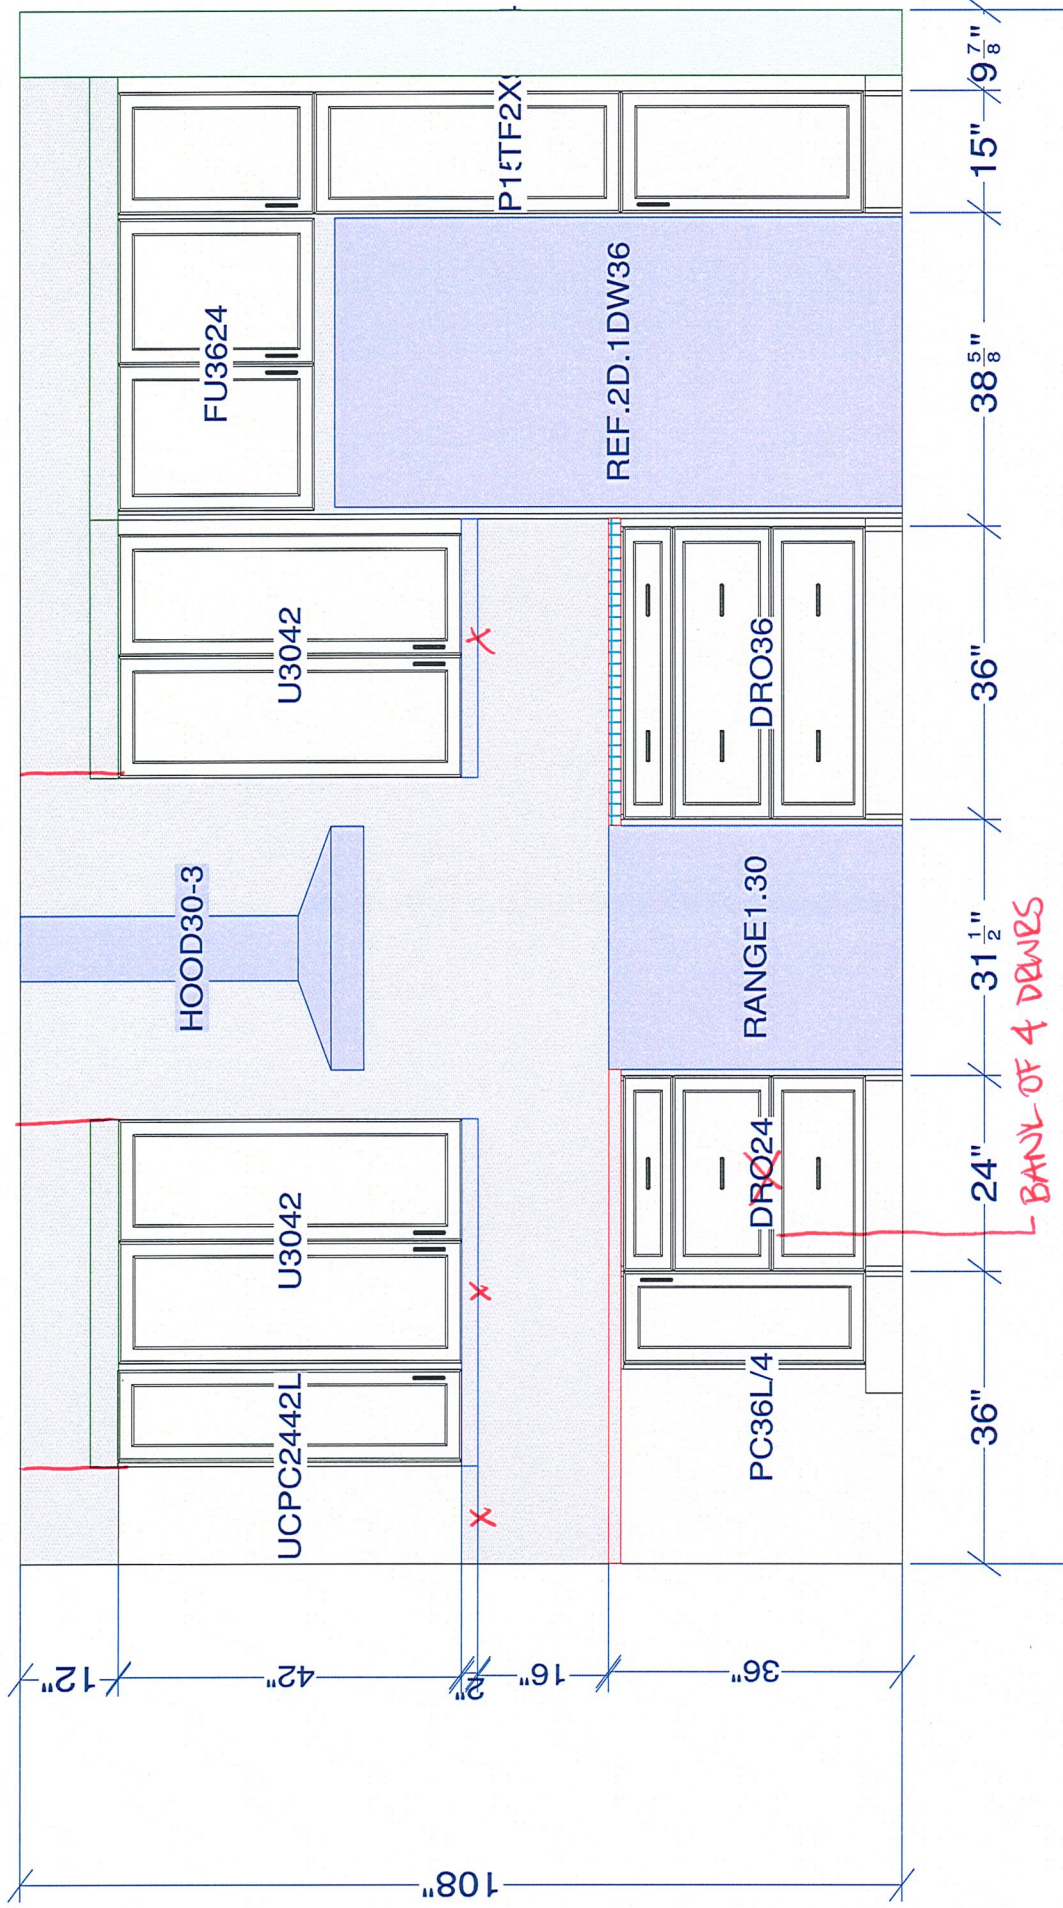

RANGE / FRIDGE WALL ELEVATION

CUSTOMER APPROVAL

I have reviewed these drawings and understand the details of the design and the CANTIER KITCHENS specifications.

Signature _____


Date _____

All dimensions .size designations given are subject to verification on job site and adjustment to fit job conditions.



This is an original design and must not be released or copied unless applicable fee has been paid or job order placed.

Designed: 2021-10-19
Printed: 2021-10-19

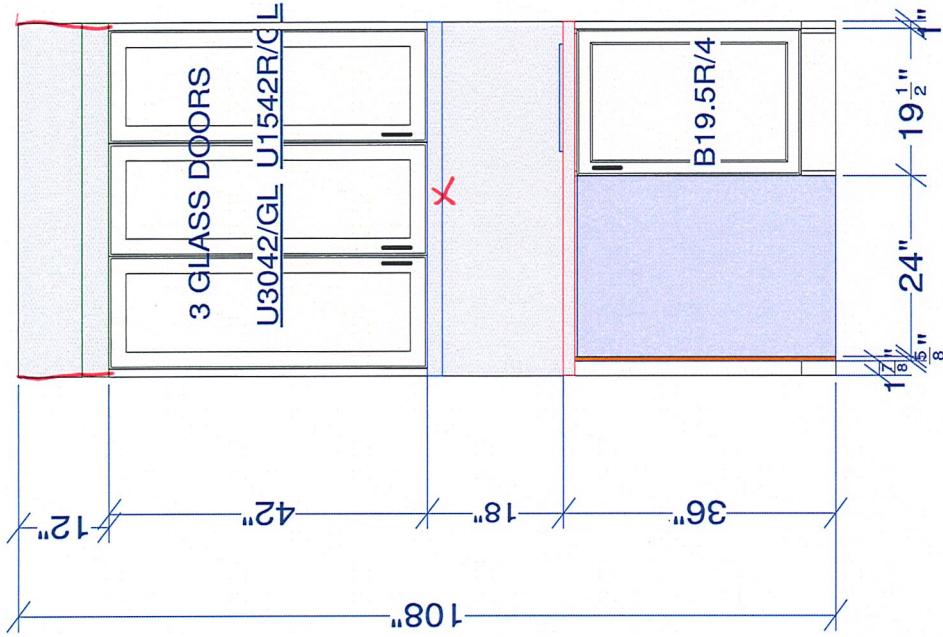


CUSTOMER APPROVAL


I have reviewed these drawings and understand the details of the design and the CARTIER KITCHENS specifications.

Signature _____

Date _____

COFFEE BAR ELEVATION

All dimensions _size designations given are subject to verification on job site and adjustment to fit job conditions.		This is an original design and must not be released or copied unless applicable fee has been paid or job order placed.	Designed: 2021-10-19 Printed: 2021-10-19		
DCR #311 Pathways 2 - Klondike Main Floor Kitchen, 2nd floor vanities.kit			EI 3	Drawing #: 1	No Scale.

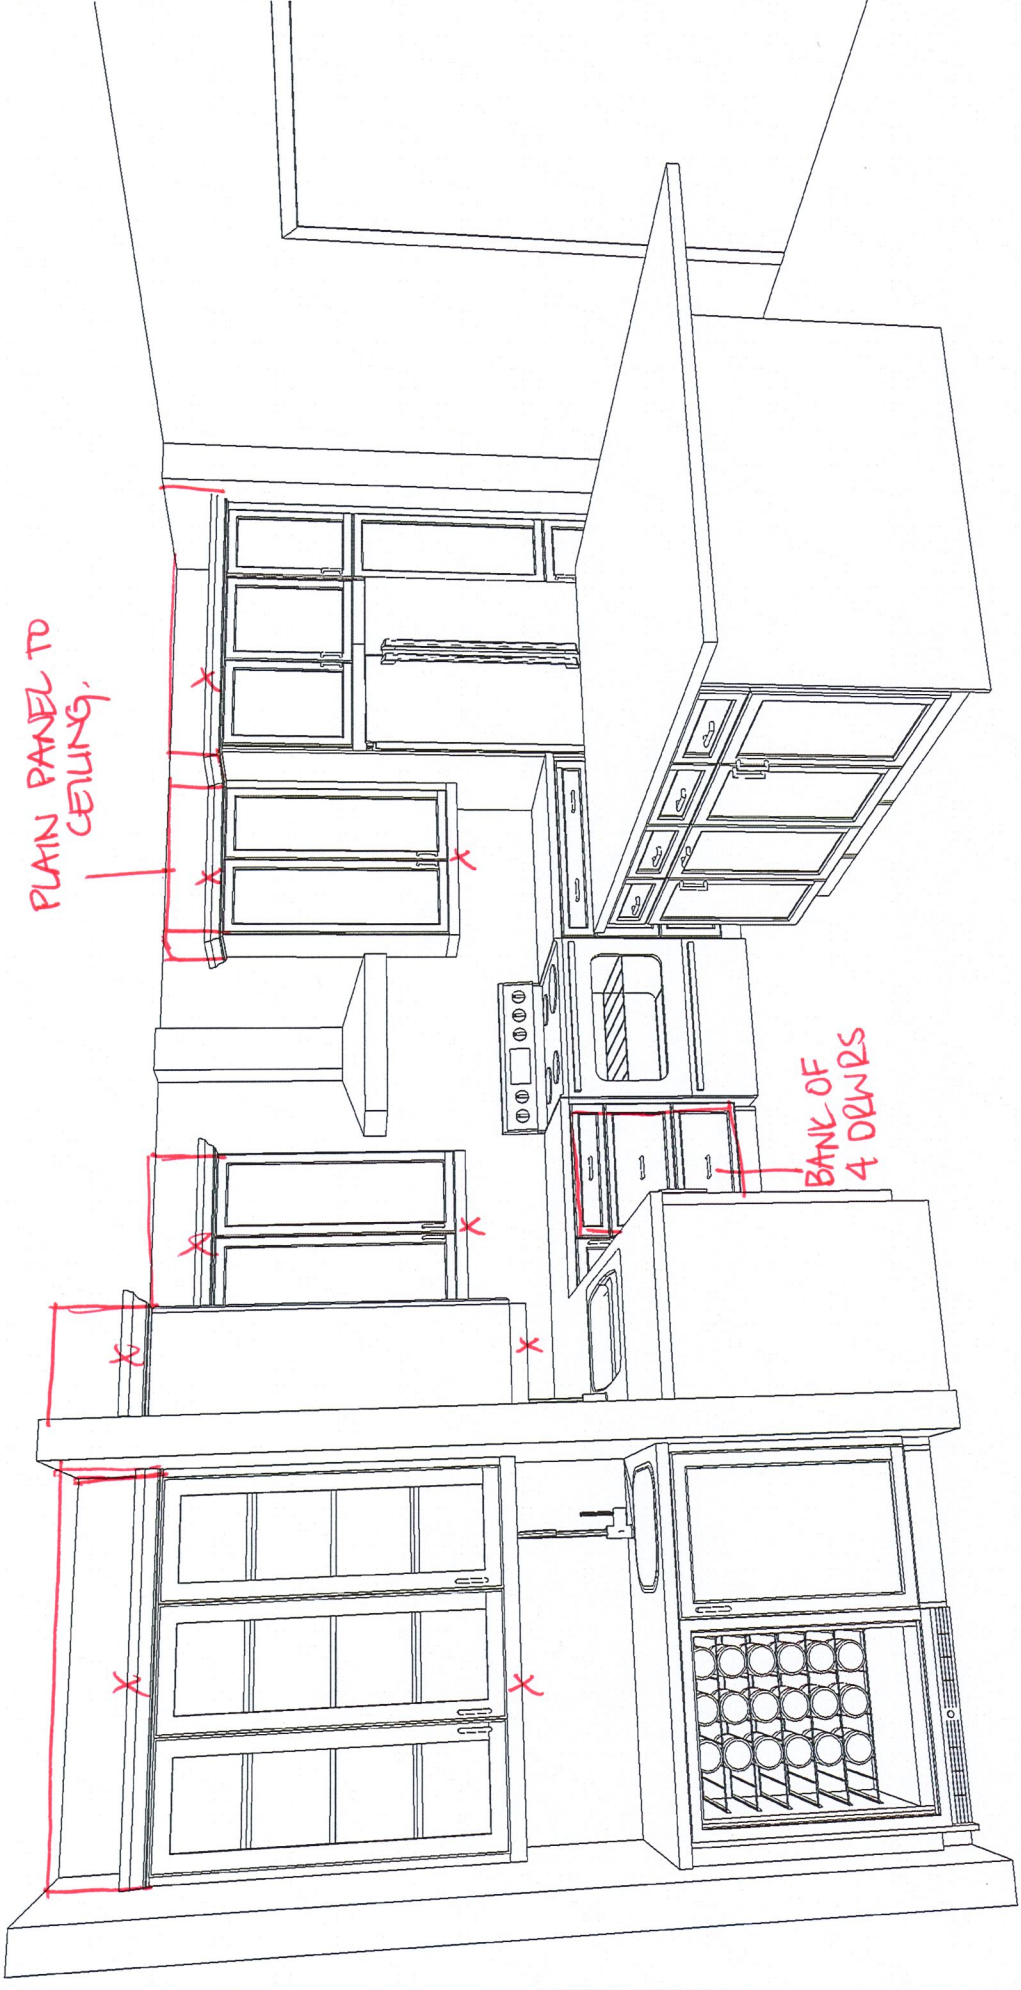

KITCHEN - 3D VIEW #1

CUSTOMER APPROVAL

I have reviewed these drawings and understand the details of the design and the CARTIER KITCHENS specifications.


Signature _____

Date _____

Note: This drawing is an artistic interpretation of the general appearance of the design. It is not meant to be an exact rendition.



Designed: 2021-10-19
Printed: 2021-10-19

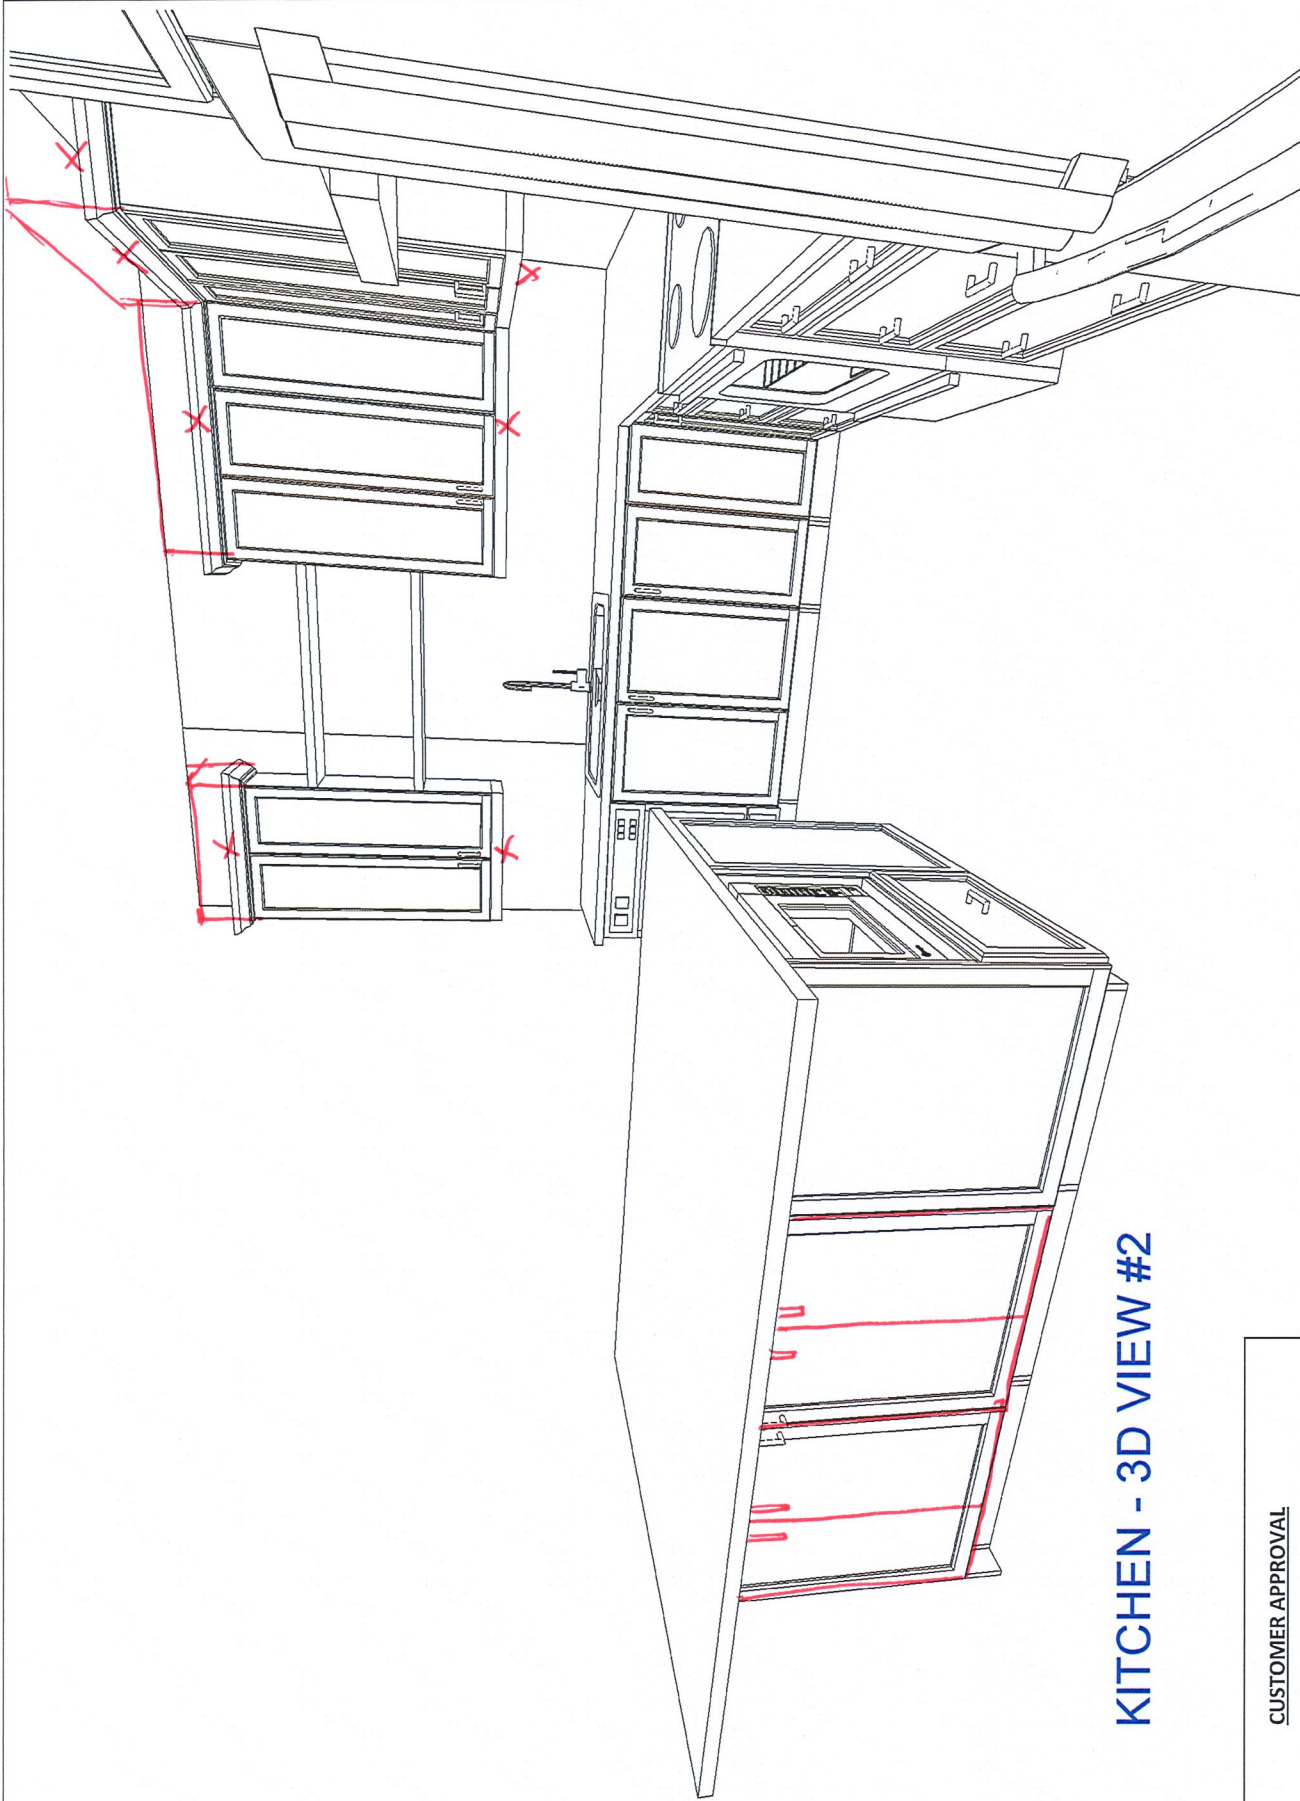

KITCHEN - 3D VIEW #2

CUSTOMER APPROVAL

I have reviewed these drawings and understand the details of the design and the CARTIER KITCHENS specifications.


Signature _____

Date _____

Note: This drawing is an artistic interpretation of the general appearance of the design. It is not meant to be an exact rendition.



Designed: 2021-10-19
Printed: 2021-10-19

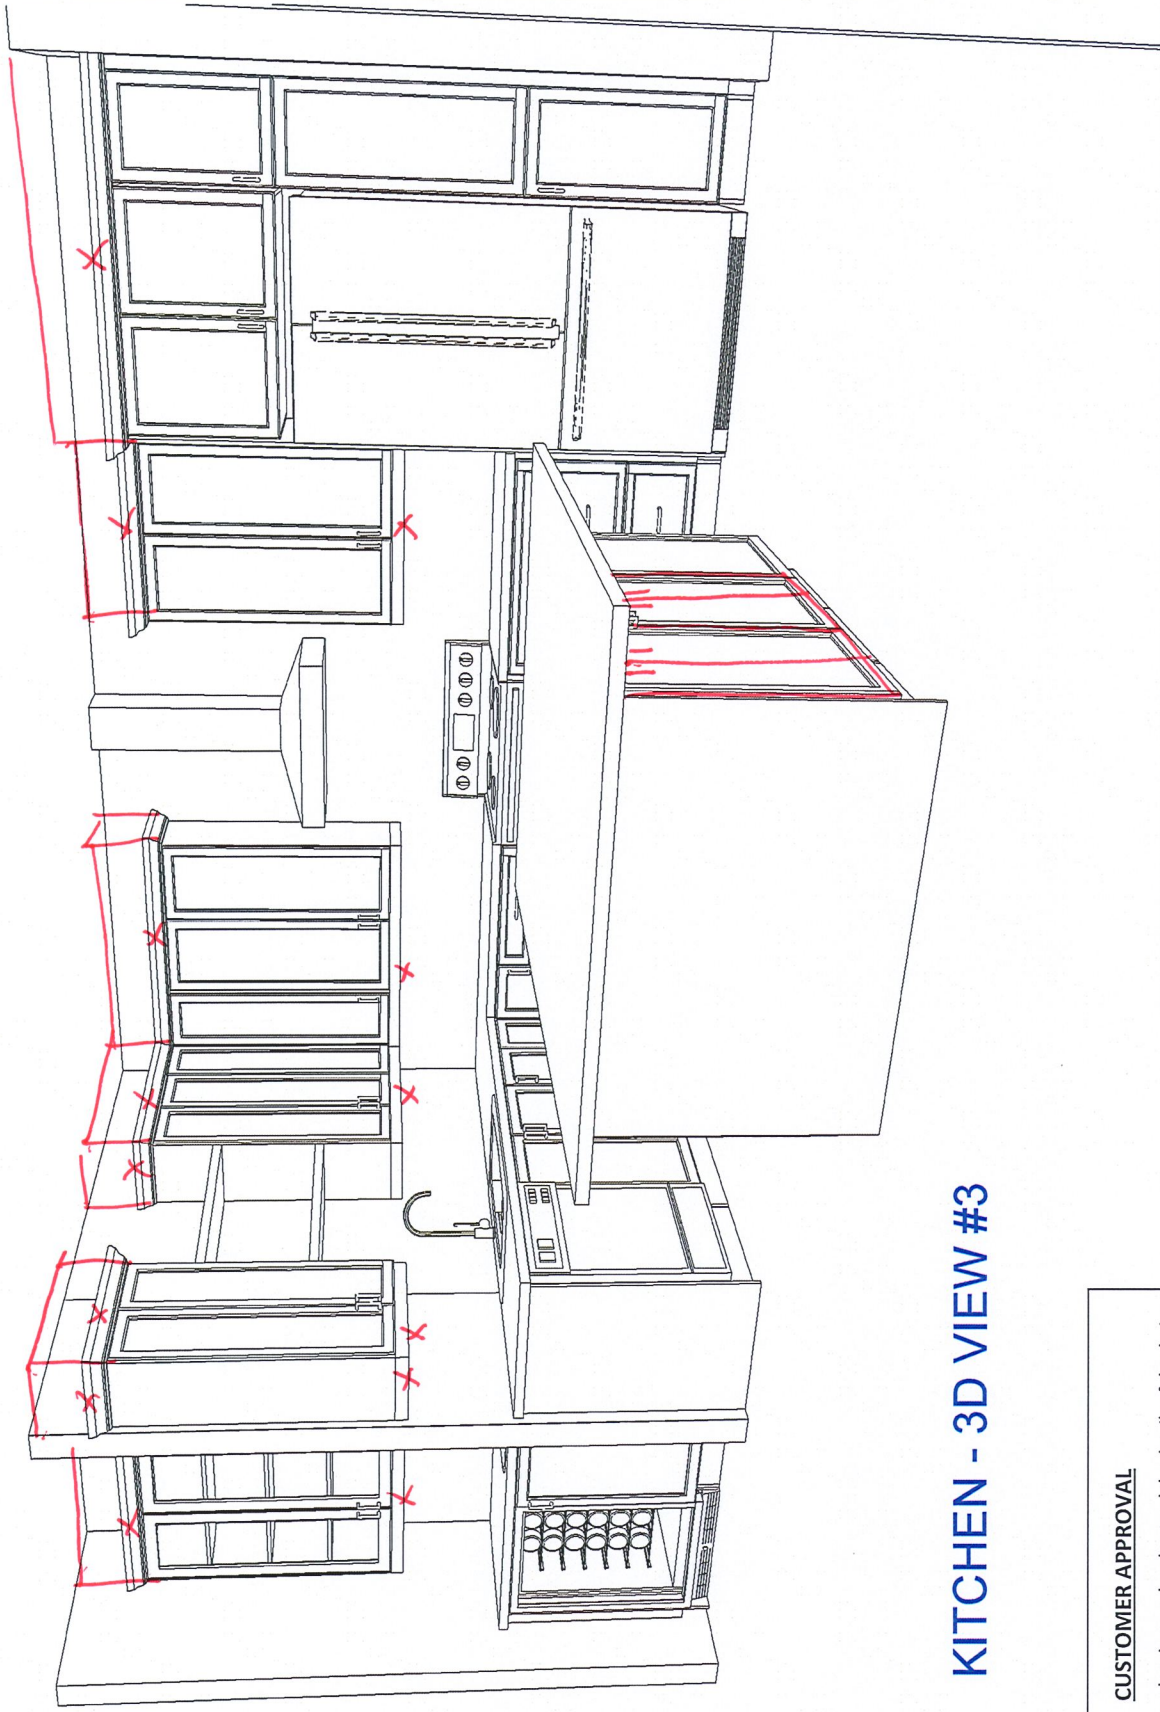

KITCHEN - 3D VIEW #3

CUSTOMER APPROVAL

I have reviewed these drawings and understand the details of the design and the CARTIER KITCHENS specifications.

Signature _____

Date _____


Note: This drawing is an artistic interpretation of the general appearance of the design. It is not meant to be an exact rendition.




Designed: 2021-10-19
Printed: 2021-10-19

DCR #311 Pathways 2 - Klondike Main Floor Kitchen, All


Drawing #: 1

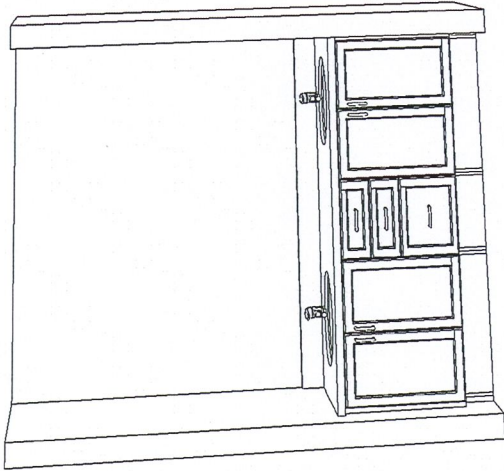


MAIN BATH VANITY

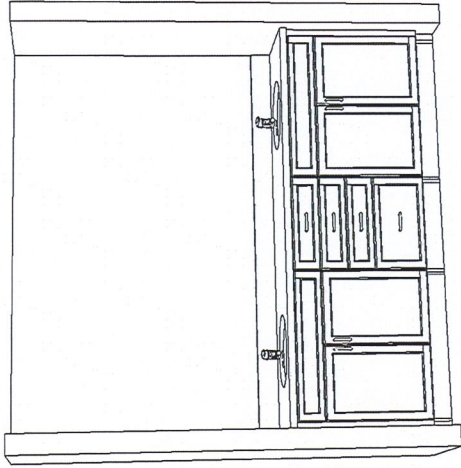

ENSUITE VANITY

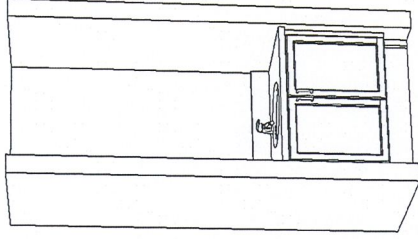

ADDED BATHROOM
VANITY

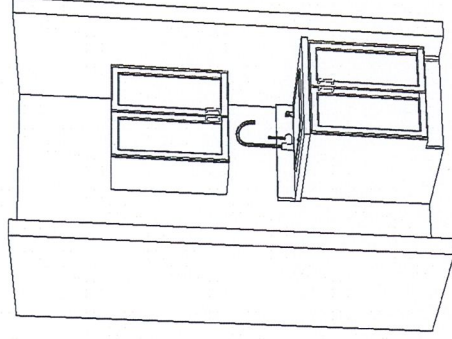

LAUNDRY
ROOM

CUSTOMER APPROVAL

I have reviewed these drawings and understand the details of the design and the CARTIER KITCHENS specifications.

Signature _____

Date _____

Note: This drawing is an artistic interpretation of the general appearance of the design. It is not meant to be an exact rendition.

SPECTRUM KITCHEN and BATH
DESIGN



Designed: 2021-10-20
Printed: 2021-10-20

DCR #311 Pathways 2 - Klondike Main Floor Kitchen, All

Drawing #: 1