


DCR PHOENIX HOMES

LOT #3-149
WHITE TAIL RIDGE 3
MODEL TYPE: BIRCHWOOD (LOFT)

KITCHEN

REVISED: JAN 20-22

NOTE:
ISLAND DELETED
ALL UPPER CABINETS DELETED

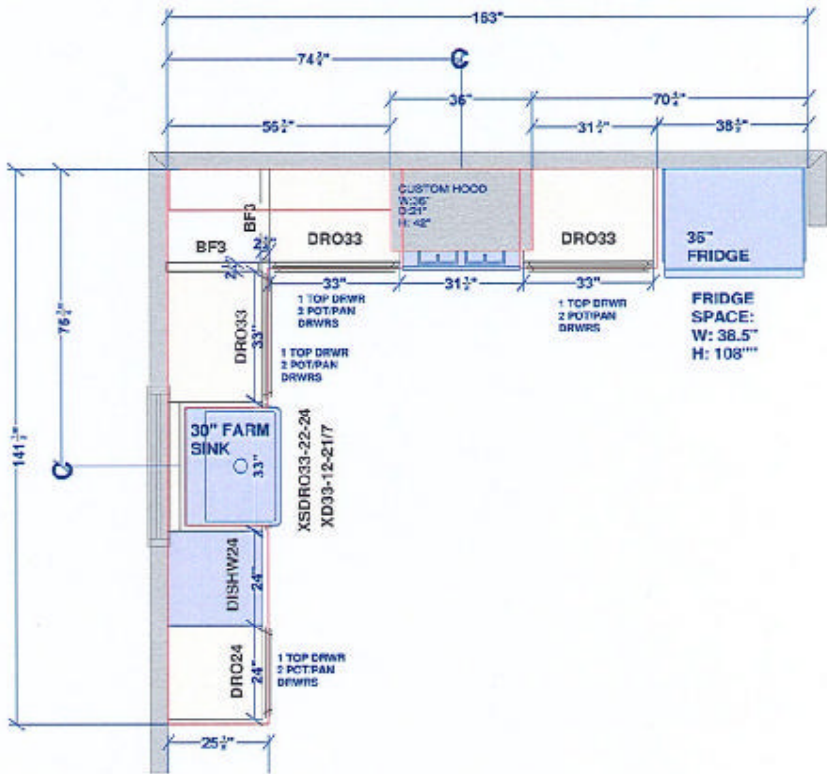

All dimensions .size designations given are subject to verification on job site and adjustment to fit job conditions.



This is an original design and must not be released or copied unless applicable fee has been paid or job order placed.


Designed: 2022-01-20
Printed: 2022-01-20

DCR - White Tail Ridge 3 LOT# 3-149 Kitchen REVISED.kit

All

Drawing #: 1 No Scale.

DS
OL PS

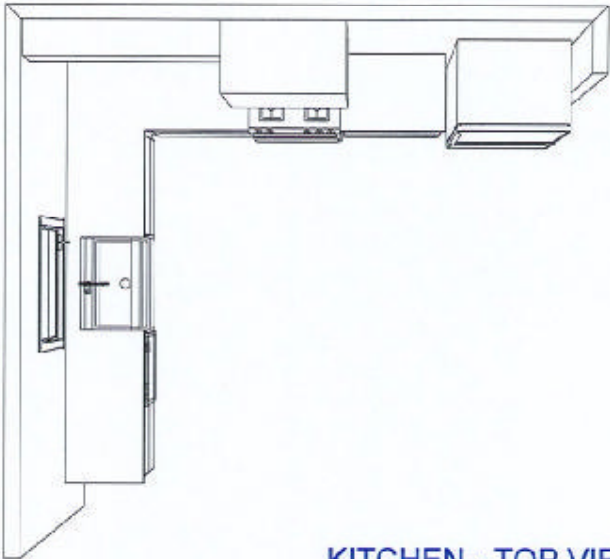

KITCHEN - TOP VIEW

REVISED: JAN 20-22

CUSTOMER APPROVAL I have reviewed these drawings and understand the details of the design and the CARTIER KITCHENS specifications. Signature: _____ Date: _____
--

Note: This drawing is an artistic interpretation of the general appearance of the design. It is not meant to be an exact rendition.		Designed: 2022-01-20
		Printed: 2022-01-20
DCR - White Tail Ridge 3 LOT# 3-149 Kitchen		All
		Drawing #: 1


DS

OL

DS

PS

* FOR REFERENCE OF ELECTRICAL PLUGS ONLY *
(PURCHASERS INSTALLING SHELVES AFTER CLOSE)

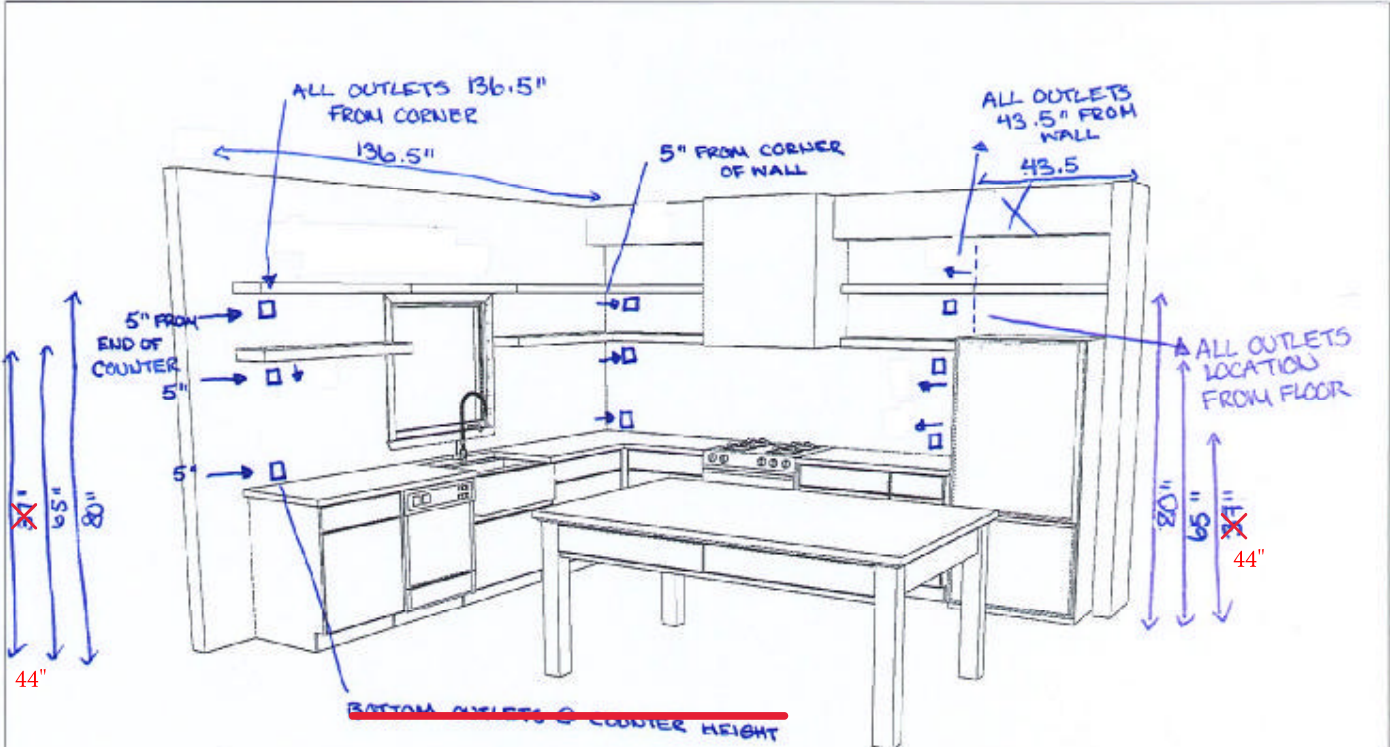

KITCHEN - 3D VIEW #1

BOTTOM OUTLETS AT APPROX 44" ABOVE FLOOR

DS
PS OL

CUSTOMER APPROVAL

I have reviewed these drawings and understand the details of the design and the CARTIER KITCHENS specifications.


Signature _____

Date _____

Note: This drawing is an artistic interpretation of the general appearance of the design. It is not meant to be an exact rendition.		Designed: 2022-01-11
		Printed: 2022-01-14
DCR - White Tail Ridge 3 LOT# 3-149 Kitchen.kit	All	Drawing #: 1

DS
OL PS

* FOR REFERENCE FOR SHELVES & ELECTRICAL
PLUGS *

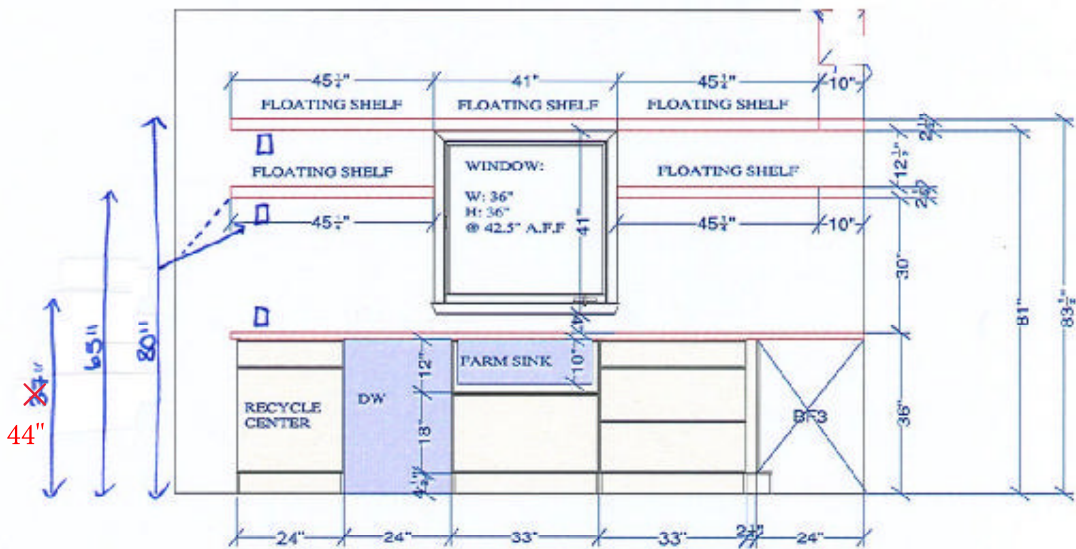

DS
OL

DS
PS

SINK WALL ELEVATION

CUSTOMER APPROVAL

I have reviewed these drawings and understand the details of the design and the COUNTER TOPPING specifications.

Signature: _____

Date: _____

All dimensions, size designations given are subject to verification on job site and adjustment to fit job conditions.




This is an original design and must not be released or copied unless applicable fee has been paid or job order placed.

Designed: 2022-01-11
Printed: 2022-01-14

DS
OL


DS
PS

* FOR REFERENCE FOR SHELVES + ELECTRICAL
PIUGS *

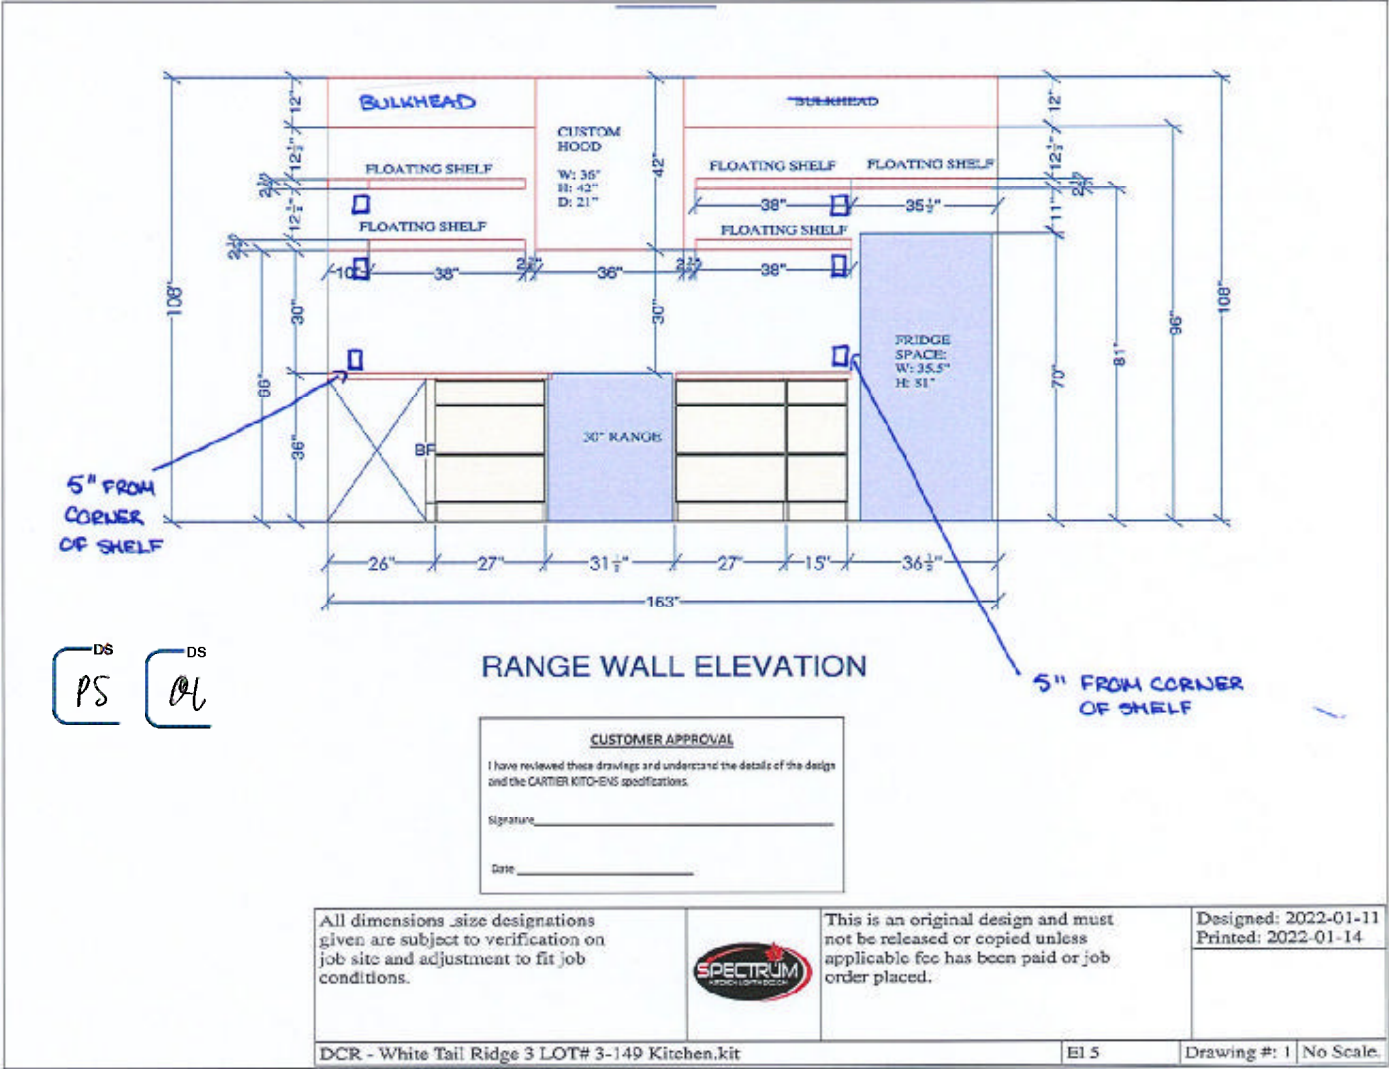

DS
OL

DS
PS

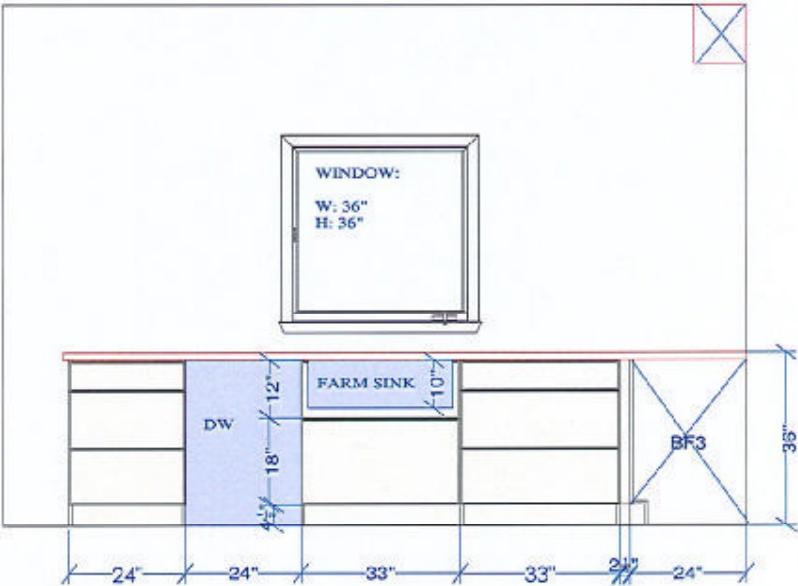

CUSTOMER APPROVAL
I have reviewed these drawings and understand the details of the design and the CARTIER KITCHENS specifications.

Signature: _____


Date: _____

SINK WALL ELEVATION
REVISED: JAN 20-22

All dimensions, size designations given are subject to verification on job site and adjustment to fit job conditions.		This is an original design and must not be released or copied unless applicable fee has been paid or job order placed.	Designed: 2022-01-20 Printed: 2022-01-20	
			DCR - White Tail Ridge 3 LOT# 3-149 Kitchen REVISED.kit	El 4 Drawing #: 1 No Scale.

DS
OL

DS
PS

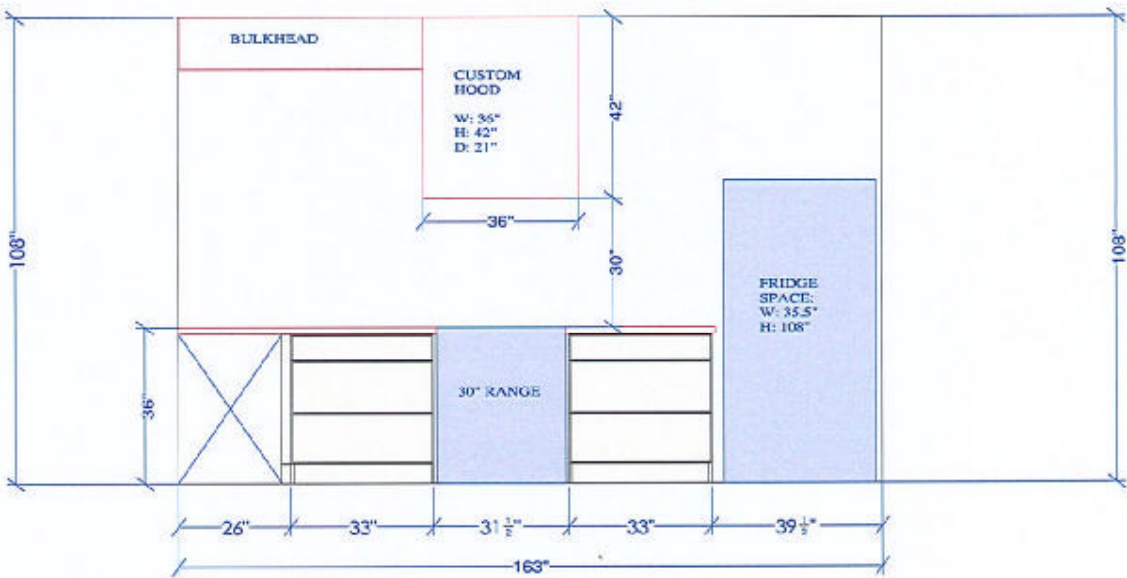

RANGE WALL ELEVATION
REVISED: JAN 20-22


CUSTOMER APPROVAL
I have reviewed these drawings and understand the details of the design and the CARTER KITCHENS specifications.

SIGNATURE: _____
Date: _____

All dimensions, size designations given are subject to verification on job site and adjustment to fit job conditions.		This is an original design and must not be released or copied unless applicable fee has been paid or job order placed.	Designed: 2022-01-20 Printed: 2022-01-20	
DCR - White Tail Ridge 3 LOT# 3-149 Kitchen REVISED.kit			El 5	Drawing #: 1 No Scale.

DS
OL

DS
PS

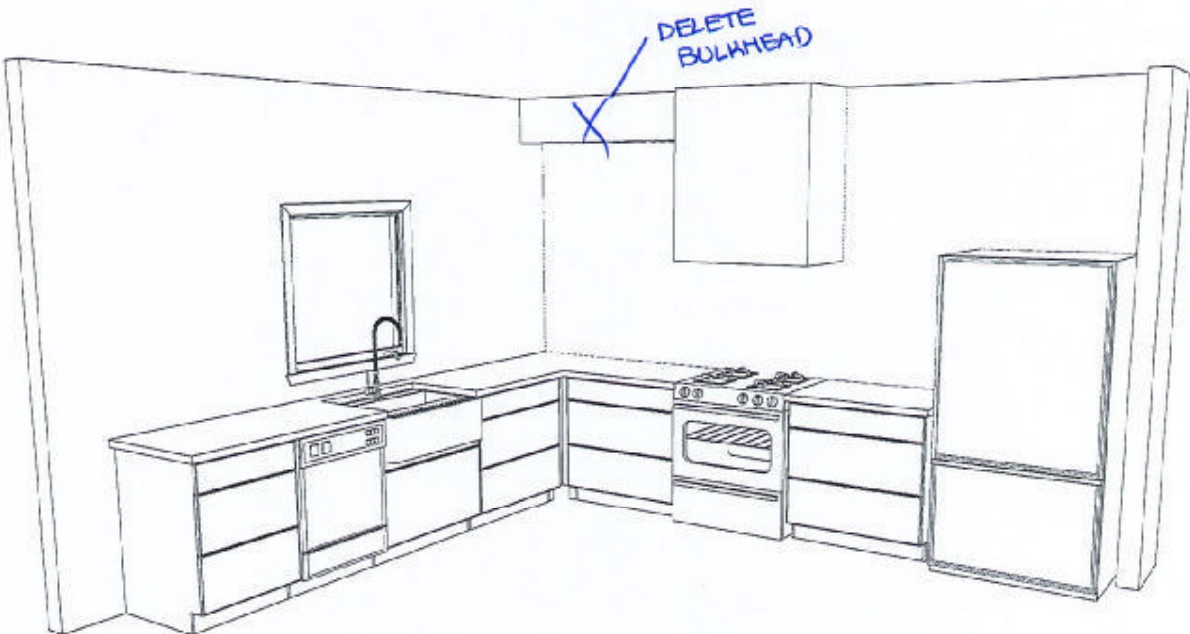

KITCHEN - 3D VIEW #1

REVISED: JAN 20-22

CUSTOMER APPROVAL

I have reviewed these drawings and understand the details of the design and the CARTIER KITCHENS specifications.

Signature_____

Date_____

Note: This drawing is an artistic interpretation of the general appearance of the design. It is not meant to be an exact rendition.		Designed: 2022-01-20
		Printed: 2022-01-20
DCR - White Tail Ridge 3 LOT# 3-149 Kitchen		Drawing #: 1

DS

OL

DS

PS