

MODEL - OAKSIDE (B-20) WITH LOFT (LEFT)

KITCHEN

MOUNTING HEIGHT - 84


REVISED: MAY 2-22

WHITE TAIL RIDGE  
PHASE 3 LOT #60

Increase height of upper cabinets to reach 96 inches


(4) LED puck lights -  
electrical by others

Glass corner cabinet

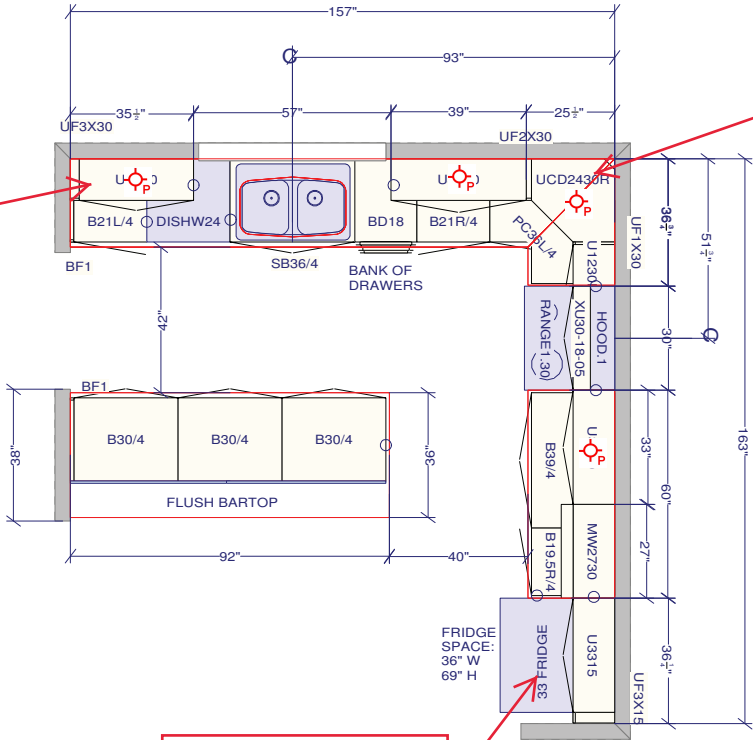


DS  
SH TC


10/31/2022 | 11:33 AM EDT

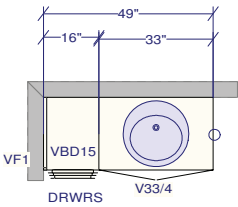


GUEST BATH  
VANITY

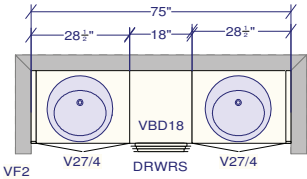

ENSUITE VANITY

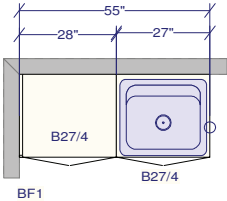

LAUNDRY ROOM

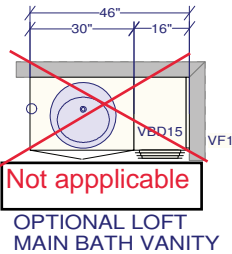

OPTIONAL LOFT  
MAIN BATH VANITY


All dimensions size designations given are subject to verification on job site and adjustment to fit job conditions.



This is an original design and must not be released or copied unless applicable fee has been paid or job order placed.

Designed: 2019-09-04  
Printed: 2022-05-02

WHITE TAIL RIDGE  
PHASE 3 LOT #60

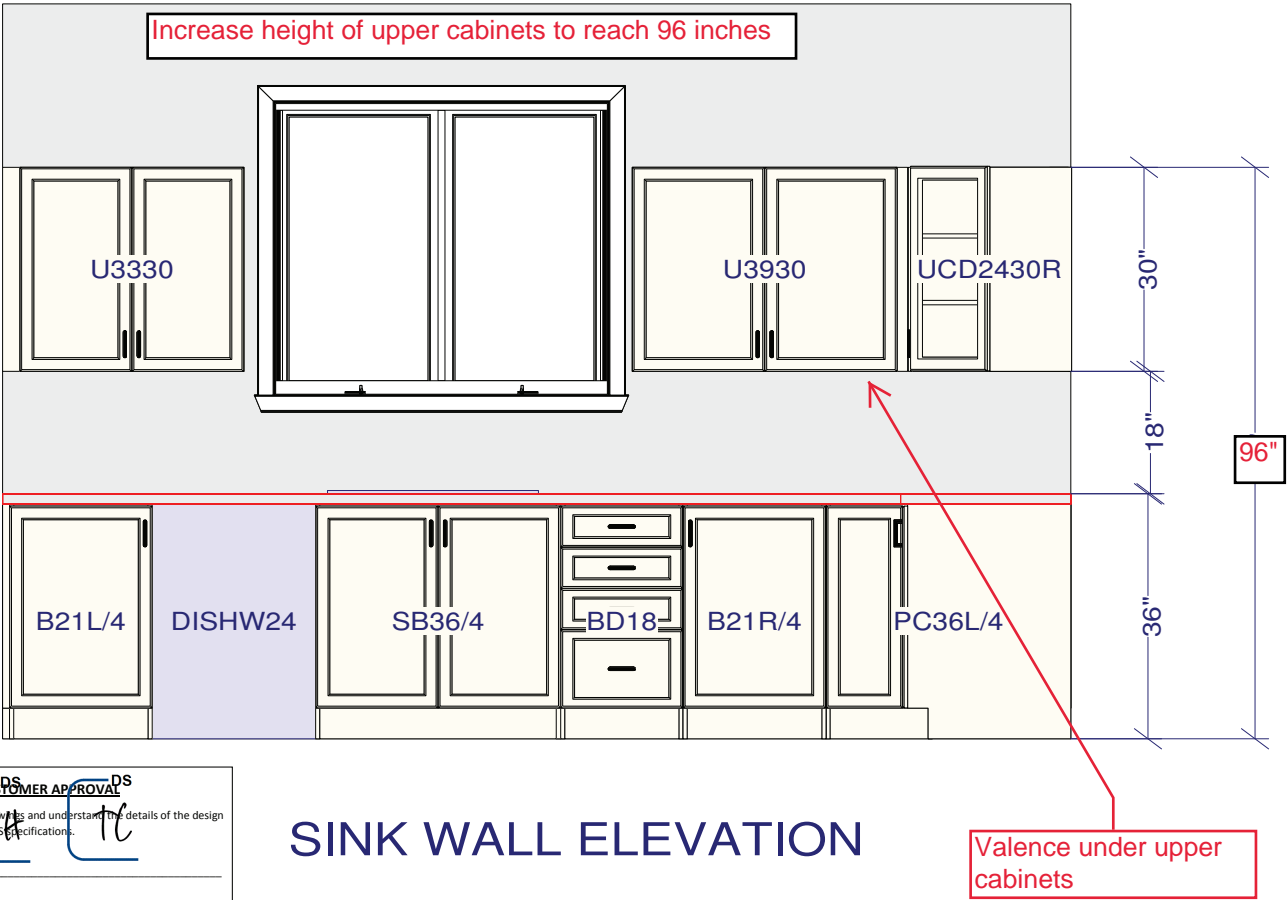

CUSTOMER APPROVAL  
I have reviewed these drawings and understand the details of the design and the CARTIER KITCHENS specifications.  
Signature \_\_\_\_\_  
Date 10/31/2022 | 11:33 AM EDT

All dimensions size designations given are subject to verification on job site and adjustment to fit job conditions.

DCR - Oakside (B-20) with Loft (Left)-.kit




This is an original design and must not be released or copied unless applicable fee has been paid or job order placed.

Designed: 2019-09-04  
Printed: 2022-05-02

Drawing #: 1 No Scale.

WHITE TAIL RIDGE  
PHASE 3 LOT #60

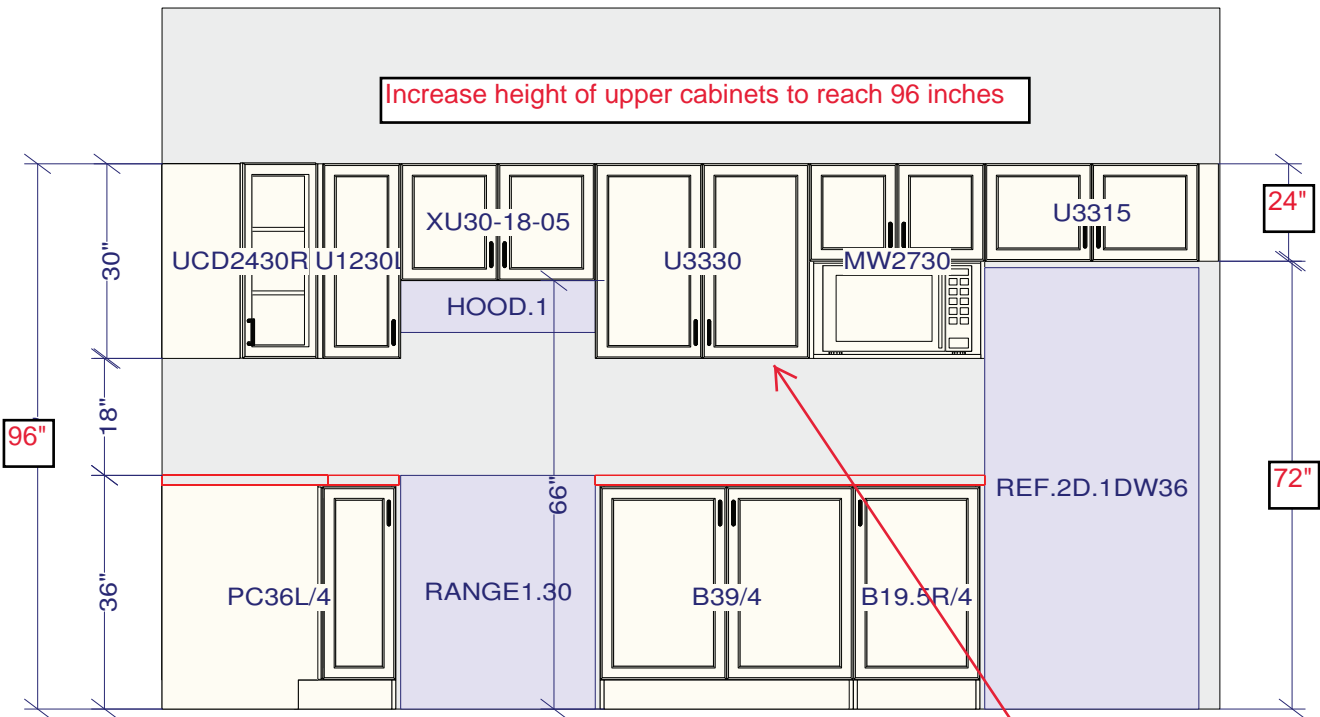

FRIDGE WALL ELEVATION

Valence under upper  
cabinets


DS  
CUSTOMER APPROVAL  
I have reviewed these drawings and understand the details of the design and the CARTIER KITCHEN & BATH specifications.  
Signature \_\_\_\_\_  
Date 10/31/2022 | 11:33 AM EDT

All dimensions ,size designations  
given are subject to verification on  
job site and adjustment to fit job  
conditions.



This is an original design and must  
not be released or copied unless  
applicable fee has been paid or job  
order placed.

Designed: 2019-09-04  
Printed: 2022-05-02

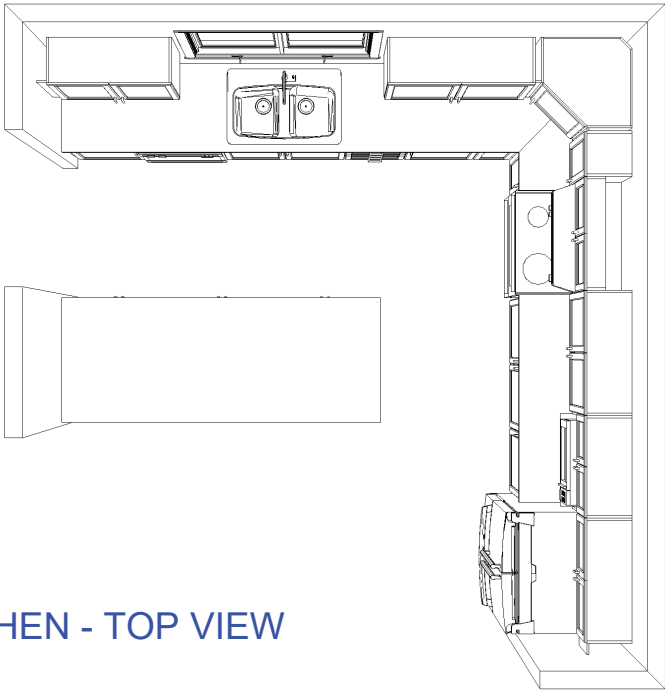

KITCHEN - TOP VIEW

CUSTOMER APPROVAL

I have reviewed these drawings and understand the details of the design and the CARTIER KITCHENS specifications.

Signature \_\_\_\_\_

Date **10/29/2022 | 4:46 PM EDT**

Note: This drawing is an artistic interpretation of the general appearance of the design. It is not meant to be an exact rendition.



Designed: 2019-09-04  
Printed: 2022-05-02



KITCHEN - 3D VIEW #1

**CUSTOMER APPROVAL**

I have reviewed these drawings and understand the details of the design and the CARTIER KITCHEN specifications.

Signature \_\_\_\_\_


Date **10/29/2022 | 4:46 PM EDT**

Note: This drawing is an artistic interpretation of the general appearance of the design. It is not meant to be an exact rendition.




Designed: 2019-09-04  
Printed: 2022-05-02

DCR - Oakside (B-20) with Loft (Left)-.kit All Drawing #: 1

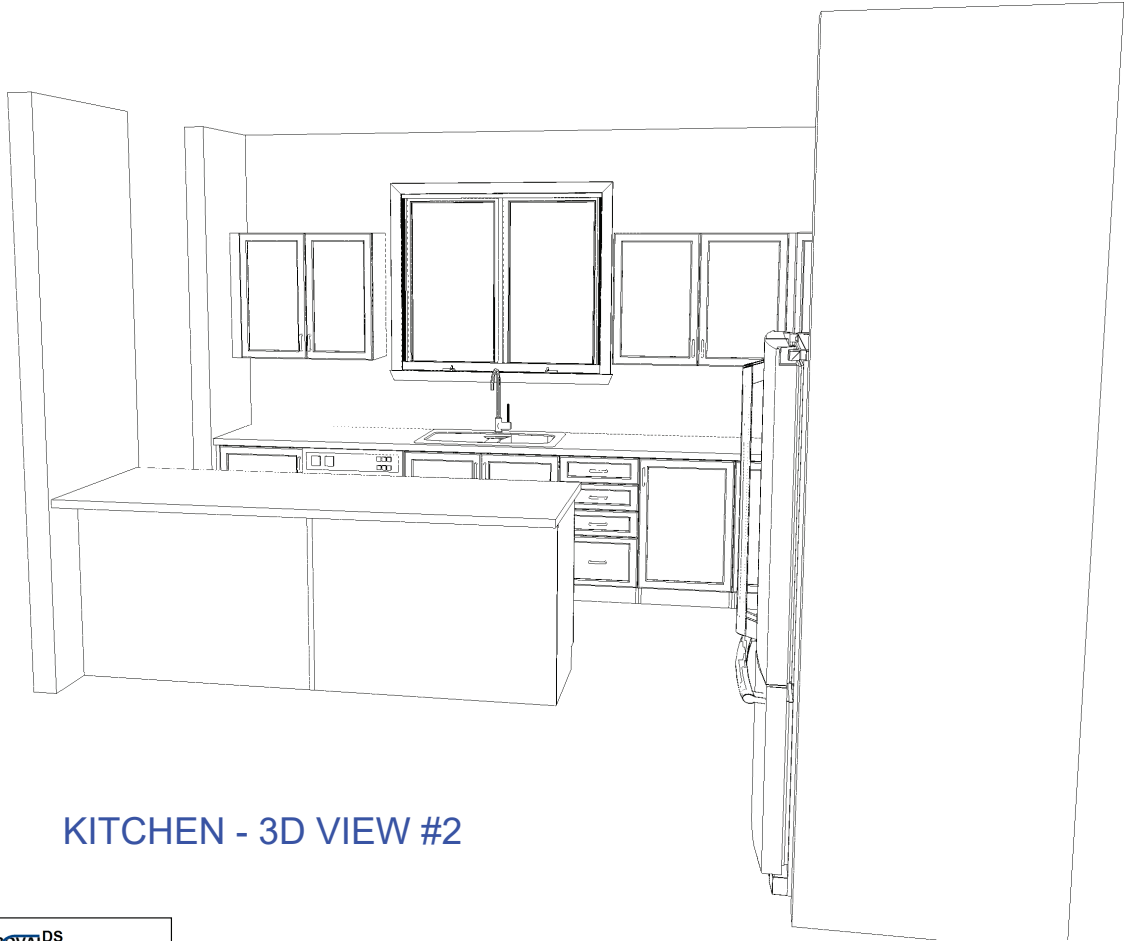


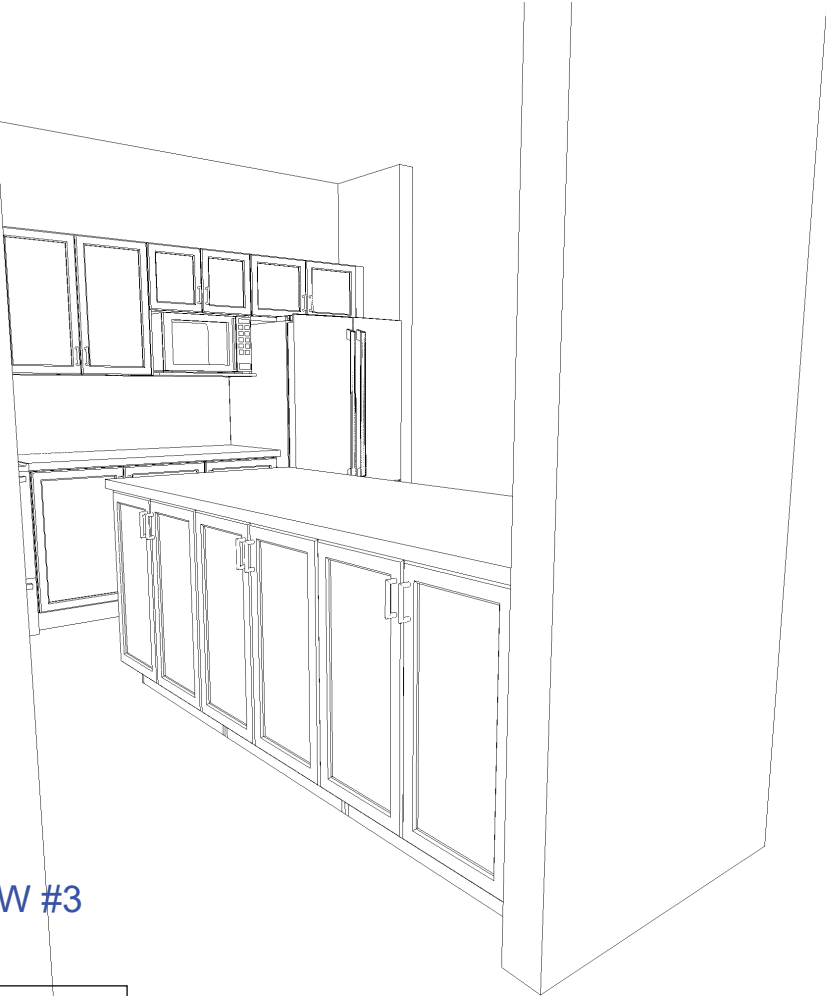
KITCHEN - 3D VIEW #2

<b>CUSTOMER APPROVAL</b>	
I have reviewed these drawings and understand the details of the design and the CARTIER KITCHENS specifications.	
	
Signature	_____
Date	10/29/2022   4:46 PM EDT

Note: This drawing is an artistic interpretation of the general appearance of the design. It is not meant to be an exact rendition.

DCR - Oakside (B-20) with Loft (Left)-.kit

	Designed: 2019-09-04	
	Printed: 2022-05-02	
	All	Drawing #: 1



KITCHEN - 3D VIEW #3

**CUSTOMER APPROVAL**

I have reviewed these drawings and understand the details of the design and the CARTIER KITCHEN specifications.


Signature \_\_\_\_\_

Date **10/29/2022 | 4:46 PM EDT**


Note: This drawing is an artistic interpretation of the general appearance of the design. It is not meant to be an exact rendition.




Designed: 2019-09-04  
Printed: 2022-05-02

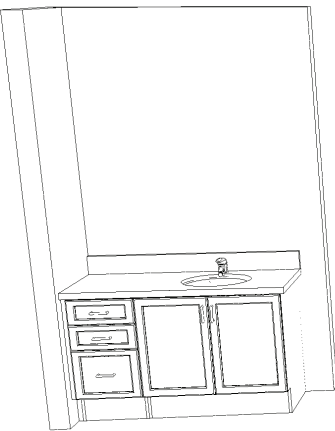

MAIN BATH

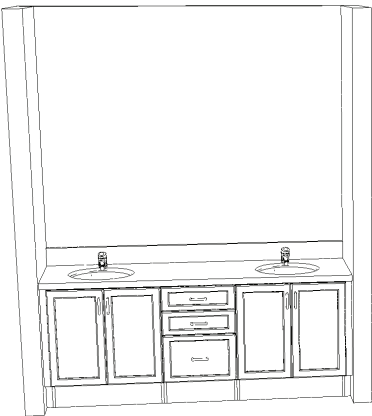

ENSUITE

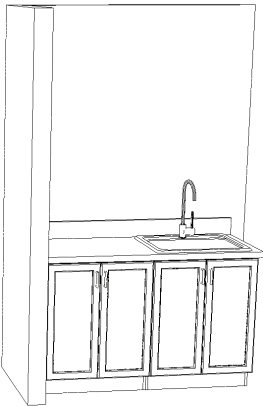

LAUNDRY



OPTIONAL  
LOFT VANITY

Not  
Applicable

CUSTOMER APPROVAL

I have reviewed these drawings and understand the details of the design and the CARTIER KITCHENS specifications.

Signature

DS  
TC  
SA

Date

10/29/2022 | 4:46 PM EDT

Note: This drawing is an artistic interpretation of the general appearance of the design. It is not meant to be an exact rendition.



Designed: 2019-09-04  
Printed: 2022-05-02

DCR - Oakside (B-20) with Loft (Left)-.kit

All

Drawing #: 1