

LOT #3-63
WHITE TAIL RIDGE 3
NEWINGTON (GARAGE RIGHT)
OPTIONAL CHEF'S KITCHEN

MOUNTING HEIGHT: 96

- CABINETS -
HARDWARE -
STANDARD WHITE INTERIOR
METAL DRAWER BOX
4 PCS - 5/8" KICK - FIN. BOTH ENDS
2 PCS - 90 DEG. CORNER MOULD
1 PCS - T-MOULD
5 PCS - FLAT MOULDING

FILL TO CEILING WITH
1" MOULDING, FURRING PANEL
& CEILING CROWN

LIGHT VALANCE


CUSTOMER APPROVAL

I have reviewed these drawings and understand the details of the design
and the CARTIER KITCHENS specifications.

Signature _____


Date _____

REVISED: NOV 7-22

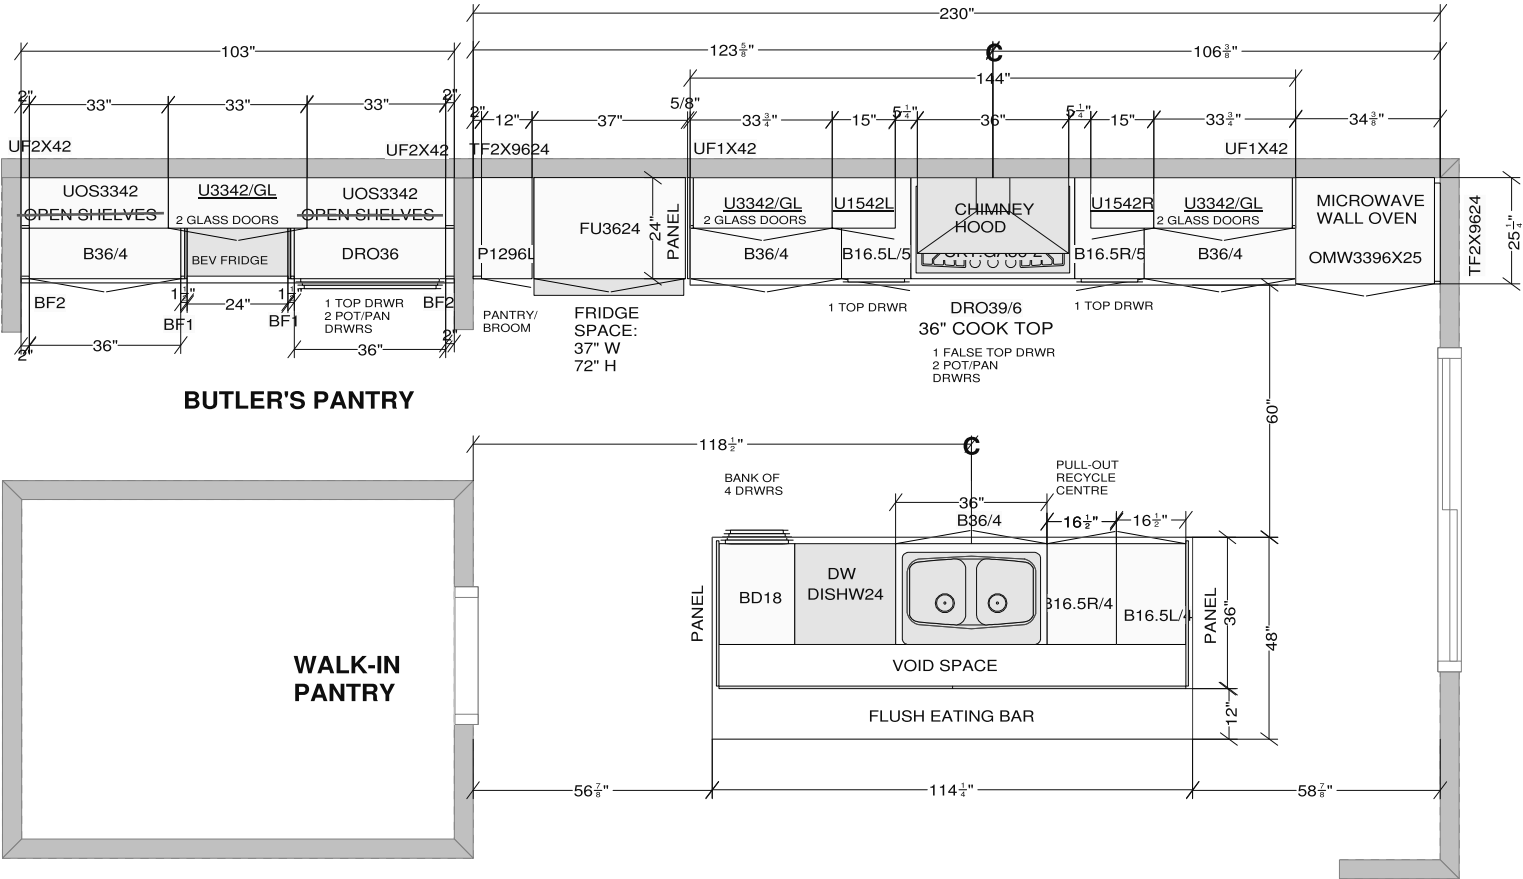

All dimensions _size designations given are subject to verification on job site and adjustment to fit job conditions.		This is an original design and must not be released or copied unless applicable fee has been paid or job order placed.	Designed: 2022-11-07 Printed: 2022-11-07	
				
DCR #3-63 - Newington Chef's 2 .kit			All	Drawing #: 1 No Scale.

FILL TO CEILING WITH
1" MOULDING, FURRING PANEL
& CEILING CROWN

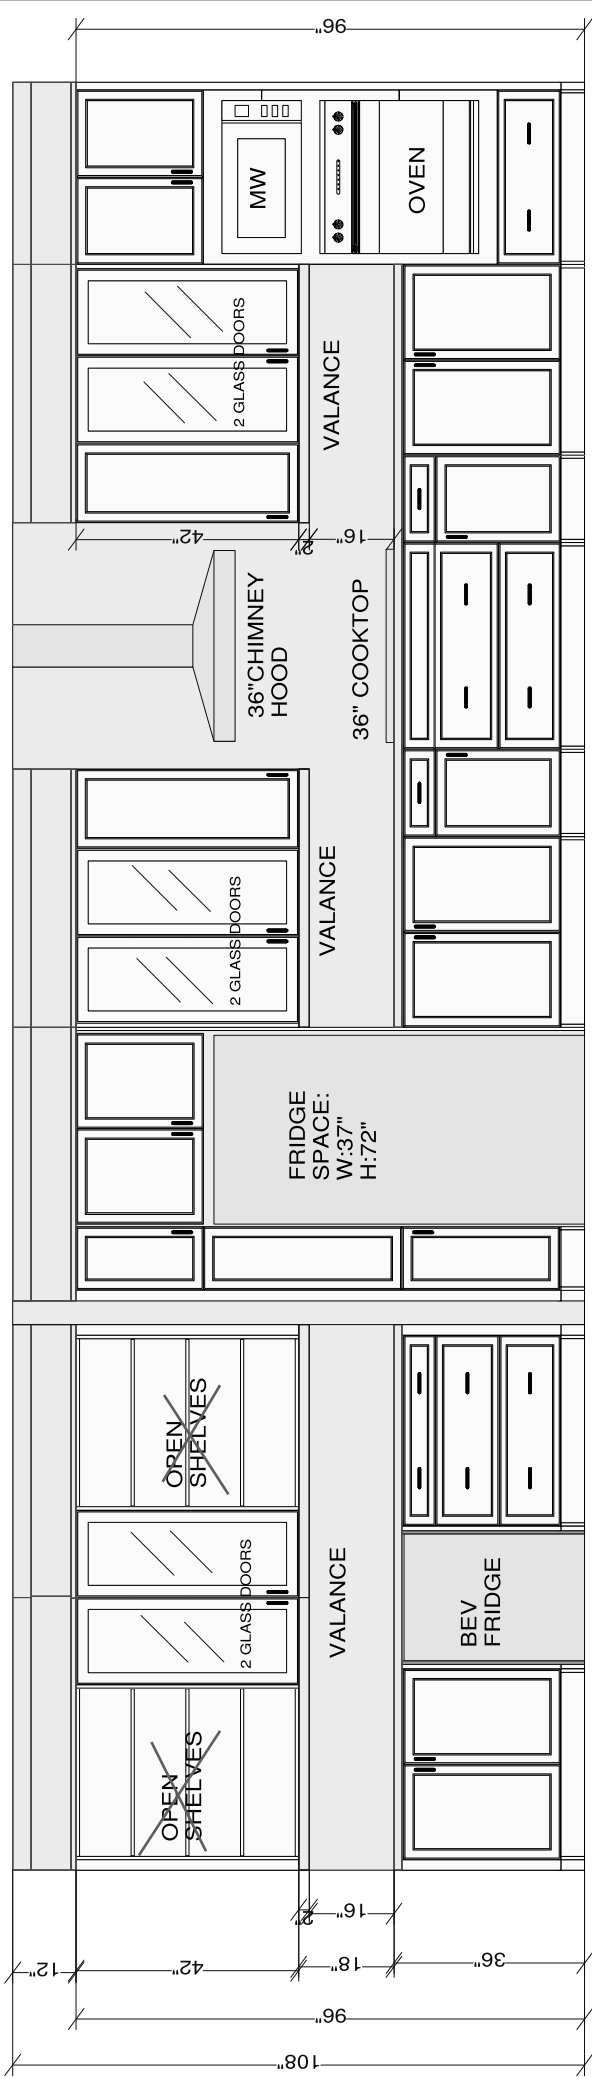

BUTLER'S PANTRY
ELEVATION

FRIDGE / COOKTOP / OVEN WALL ELEVATION

REVISED: NOV 7-22

CUSTOMER APPROVAL

I have reviewed these drawings and understand the details of the design and the CARTIER KITCHENS specifications.

Signature _____

Date _____


All dimensions _size designations
given are subject to verification on
job site and adjustment to fit job
conditions.



This is an original design and must
not be released or copied unless
applicable fee has been paid or job
order placed.

Designed: 2022-11-07
Printed: 2022-11-07



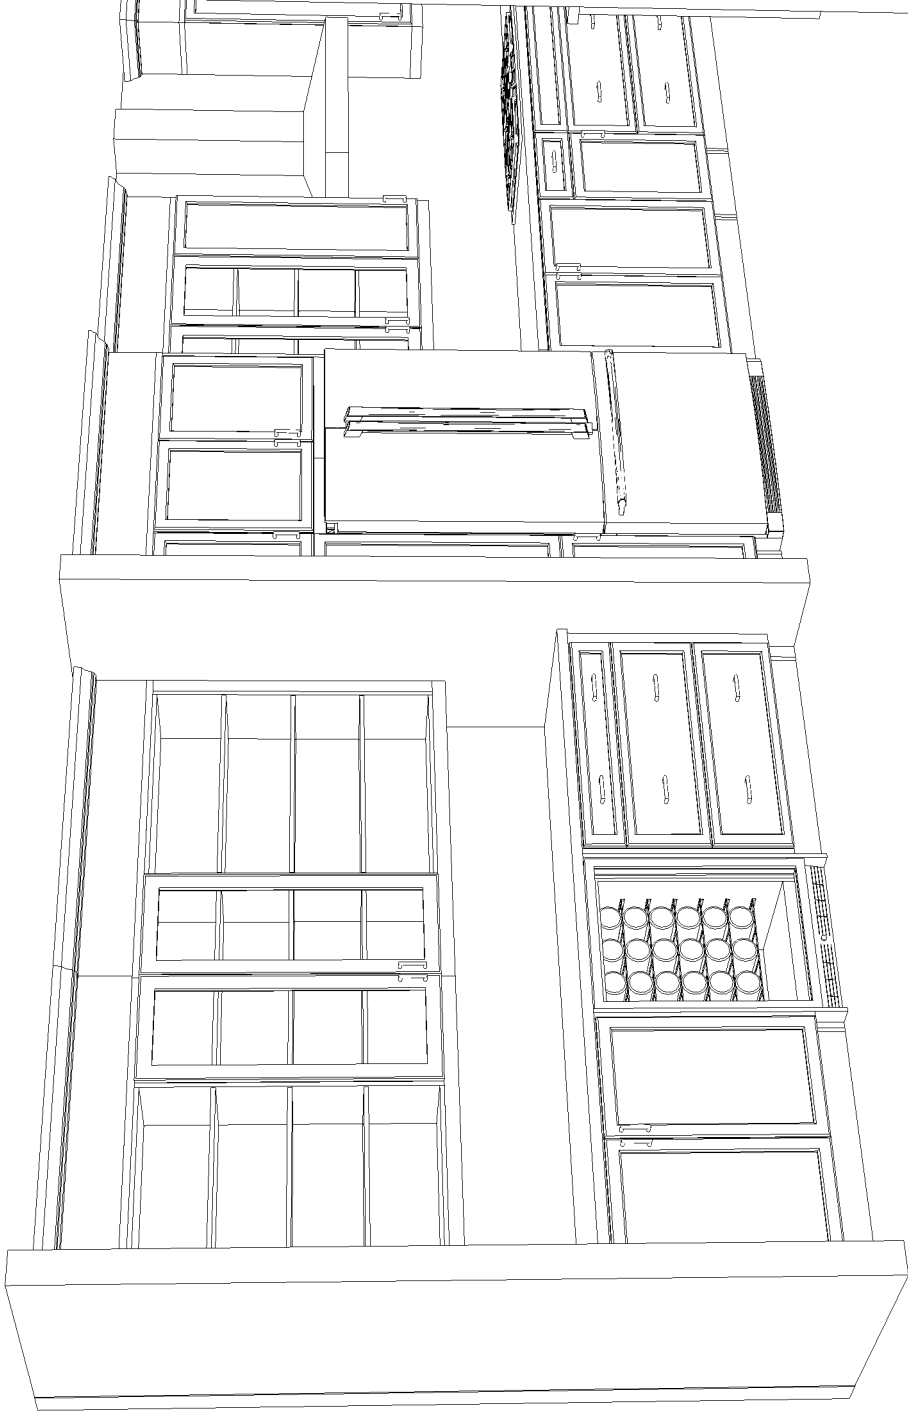

BUTLER'S PANTRY - 3D VIEW

REVISED: NOV 7-22

CUSTOMER APPROVAL

I have reviewed these drawings and understand the details of the design and the CARTIER KITCHENS specifications.

Signature _____

Date _____

Note: This drawing is an artistic interpretation of the general appearance of the design. It is not meant to be an exact rendition.



Designed: 2022-11-07
Printed: 2022-11-07

