


DCR PHOENIX HOMES


NEWINGTON
VANITIES
5 BDRM

LINE 1 & 2
HARDWARE - STD & 1ST UPGRADE
STANDARD WHITE INTERIOR
METAL DRAWER BOX
6 PCS - 5/8" KICK - FIN. BOTH ENDS
6 PCS - FLAT MOULDING


#3-63
WHITE TAIL RIDGE

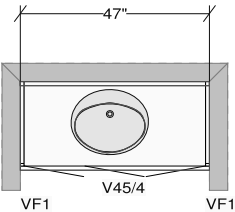


POWDER ROOM

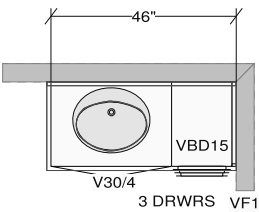


IN LAW - ENSUITE

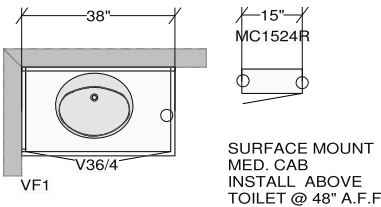

ENSUITE BEDROOM 4

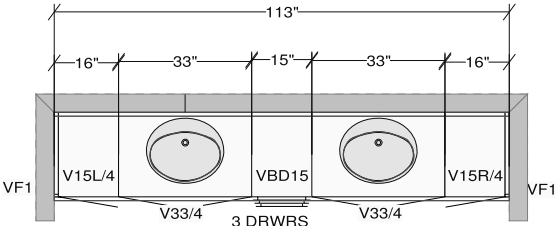

BEDROOM 3 & 5 - JACK & JILL ENSUITE

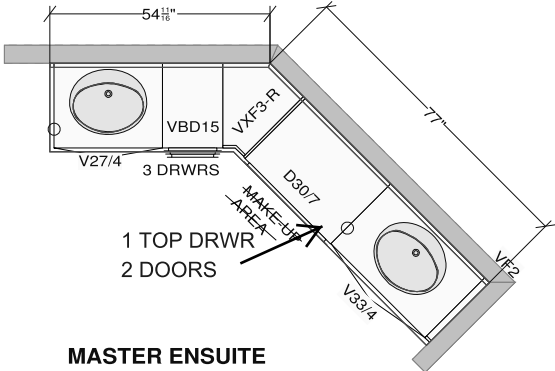

MASTER ENSUITE

CUSTOMER APPROVAL

I have reviewed these drawings and understand the details of the design and the CARTIER KITCHENS specifications.

Signature _____

Date _____

All dimensions _size designations given are subject to verification on job site and adjustment to fit job conditions.

SPECTRUM KITCHEN and BATH DESIGN



This is an original design and must not be released or copied unless applicable fee has been paid or job order placed.

DRAWN BY: LORI DISAVERIO, B.I.D

Designed: 2019-09-04
Printed: 2021-05-20

DS
CA




DS
Lori

NEWINGTON - VANITIES - 5 Bdrm.kit

All

Drawing #: 1

No Scale.

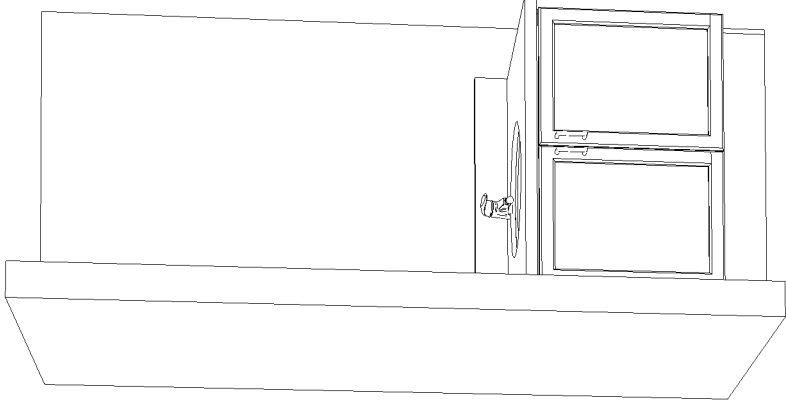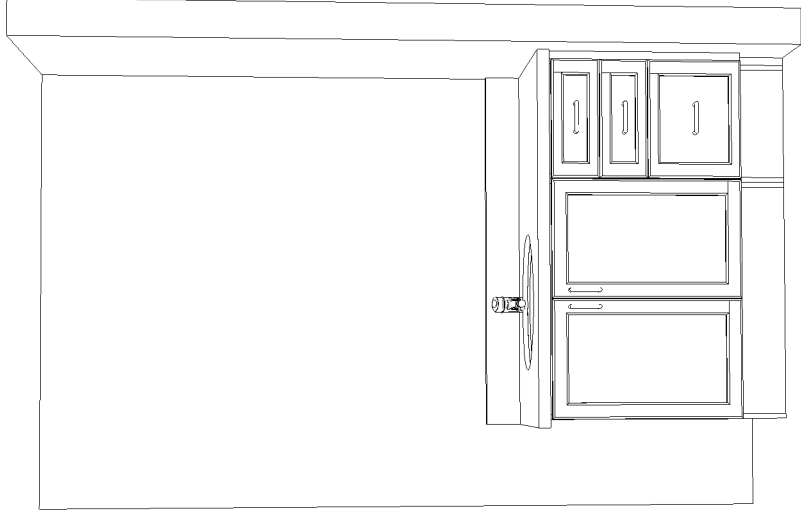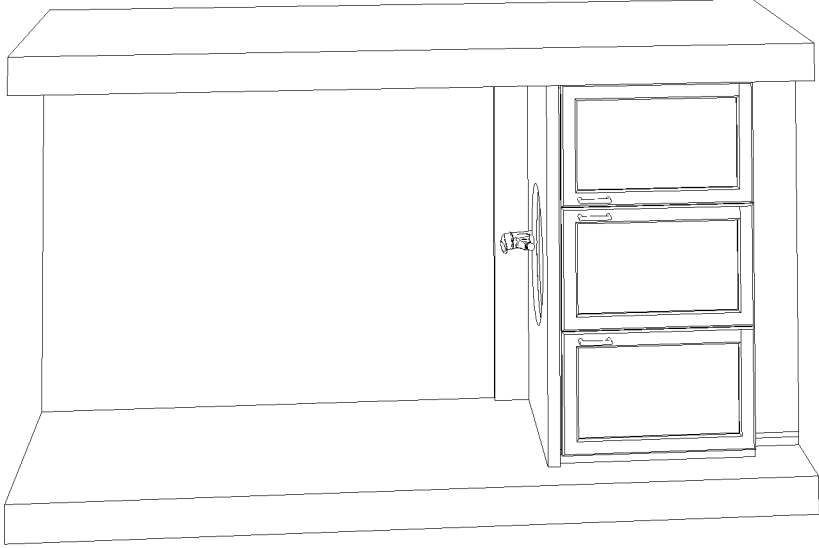

CUSTOMER APPROVAL

I have reviewed these drawings and understand the details of the design and the CARTIER KITCHENS specifications.

Signature_____

Date _____

Note: This drawing is an artistic interpretation of the general appearance of the design. It is not meant to be an exact rendition.

SPECTRUM KITCHEN and BATH DESIGN




Designed: 2019-09-04
Printed: 2021-05-20

DS


NEWINGTON - VANITIES - 5 Bdrm.kit

All

Drawing #: 1

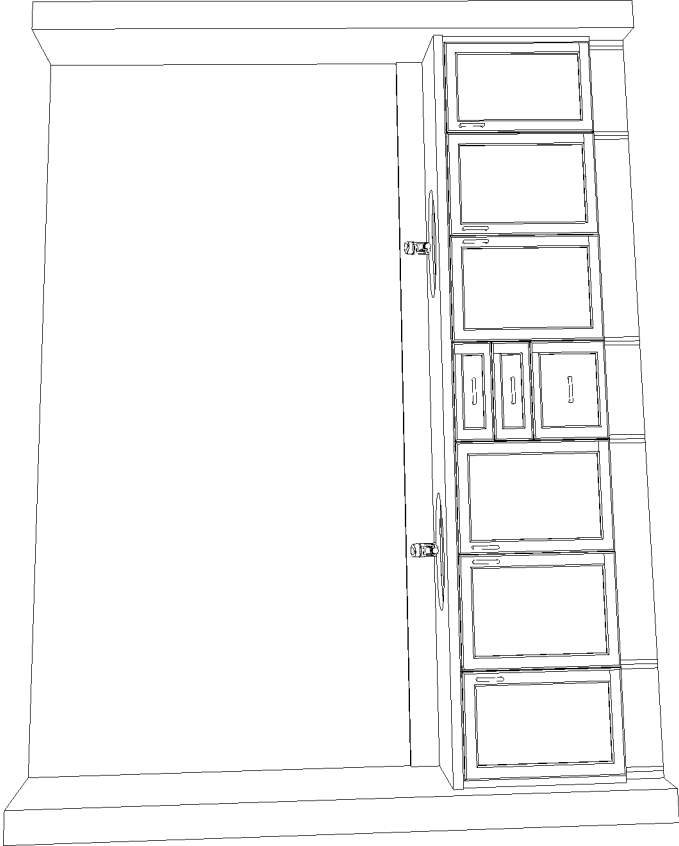

5 BDRM MAIN BATH VANITY (JACK & JILL)

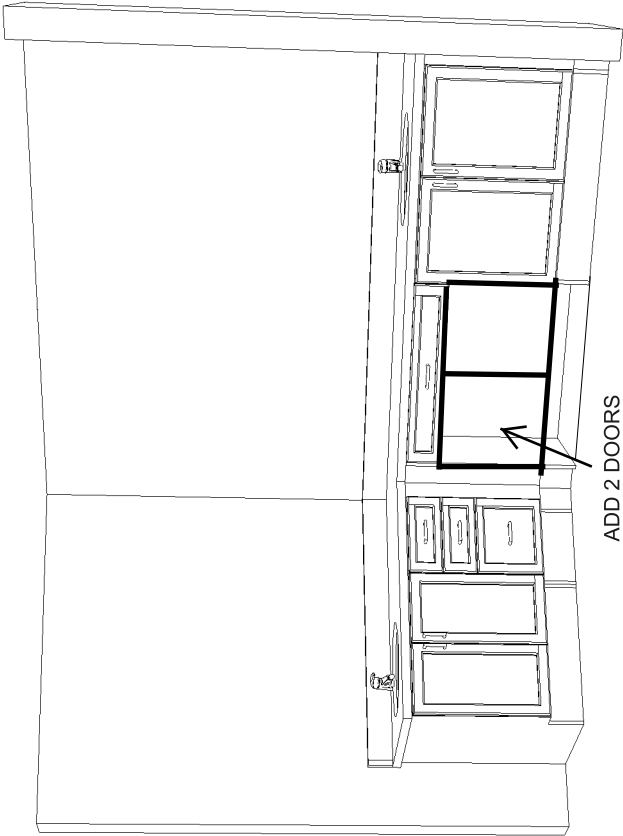

MASTER ENSUITE

CUSTOMER APPROVAL

I have reviewed these drawings and understand the details of the design and the CARTIER KITCHENS specifications.

Signature _____

Date _____

Note: This drawing is an artistic interpretation of the general appearance of the design. It is not meant to be an exact rendition.			Designed: 2019-09-04 Printed: 2021-05-20	
SPECTRUM KITCHEN and BATH DESIGN			DS Ca DS 	
NEWINGTON - VANITIES - 5 Bdrm.kit		All	Drawing #: 1	