

- 125KPA
- 20" x 6" STRIP FOOTING

City of Ottawa
Building Services Branch

Aug 7 6 2022

City of Ottawa
Building Services Branch

SEP 12 2022

Building Code Reviewed

Signature

PHOENIX HOMES

MADISON — 2020

SITE: PATHWAYS 2

212

LOT NUMBER:

CIVIC ADDRESS:
914 OMAGAKI WAY

footprint: 43-10

drawn by: SP

date: NOV/19

scale: $3/16" = 1' - 0"$

sheet no:


D.C.L. - 184

2.2.

5	FINAL BLACKLINES	28 JUN 22	C8
4	ISSUED FOR STRUCTURAL REVIEW	12 MAY 22	SP
3	BEP BLACKLINES – REVISED	12 APR 22	GK
2	BEP BLACKLINES	11 APR 22	GK
1	ISSUED FOR PRICING ONLY	DEC-2019	SP
No.	Description	Date	By
REVISIONS			

CONTRACTOR MUST VERIFY ALL DIMENSIONS ON THE JOB AND REPORT ANY DISCREPANCY TO DCR/PHOENIX BEFORE PROCEEDING WITH THE WORK.
ALL DRAWINGS AND SPECIFICATIONS ARE INSTRUMENTS OF SERVICE AND THE PROPERTY OF THE DCR/PHOENIX WHICH MUST BE RETURNED AT THE COMPLETION OF THE WORK.
ALL DRAWINGS TO BE USED FOR CONSTRUCTION ONLY.
AFTER BUILDING PERMIT HAS BEEN ISSUED,
DO NOT SCALE DRAWINGS, USE DIMENSIONS PROVIDED.

****NOTE****
ALL WINDOW LINTELS TO BE 2-2X10
W/ P2 POSTS ON EACH SIDE U.N.O.

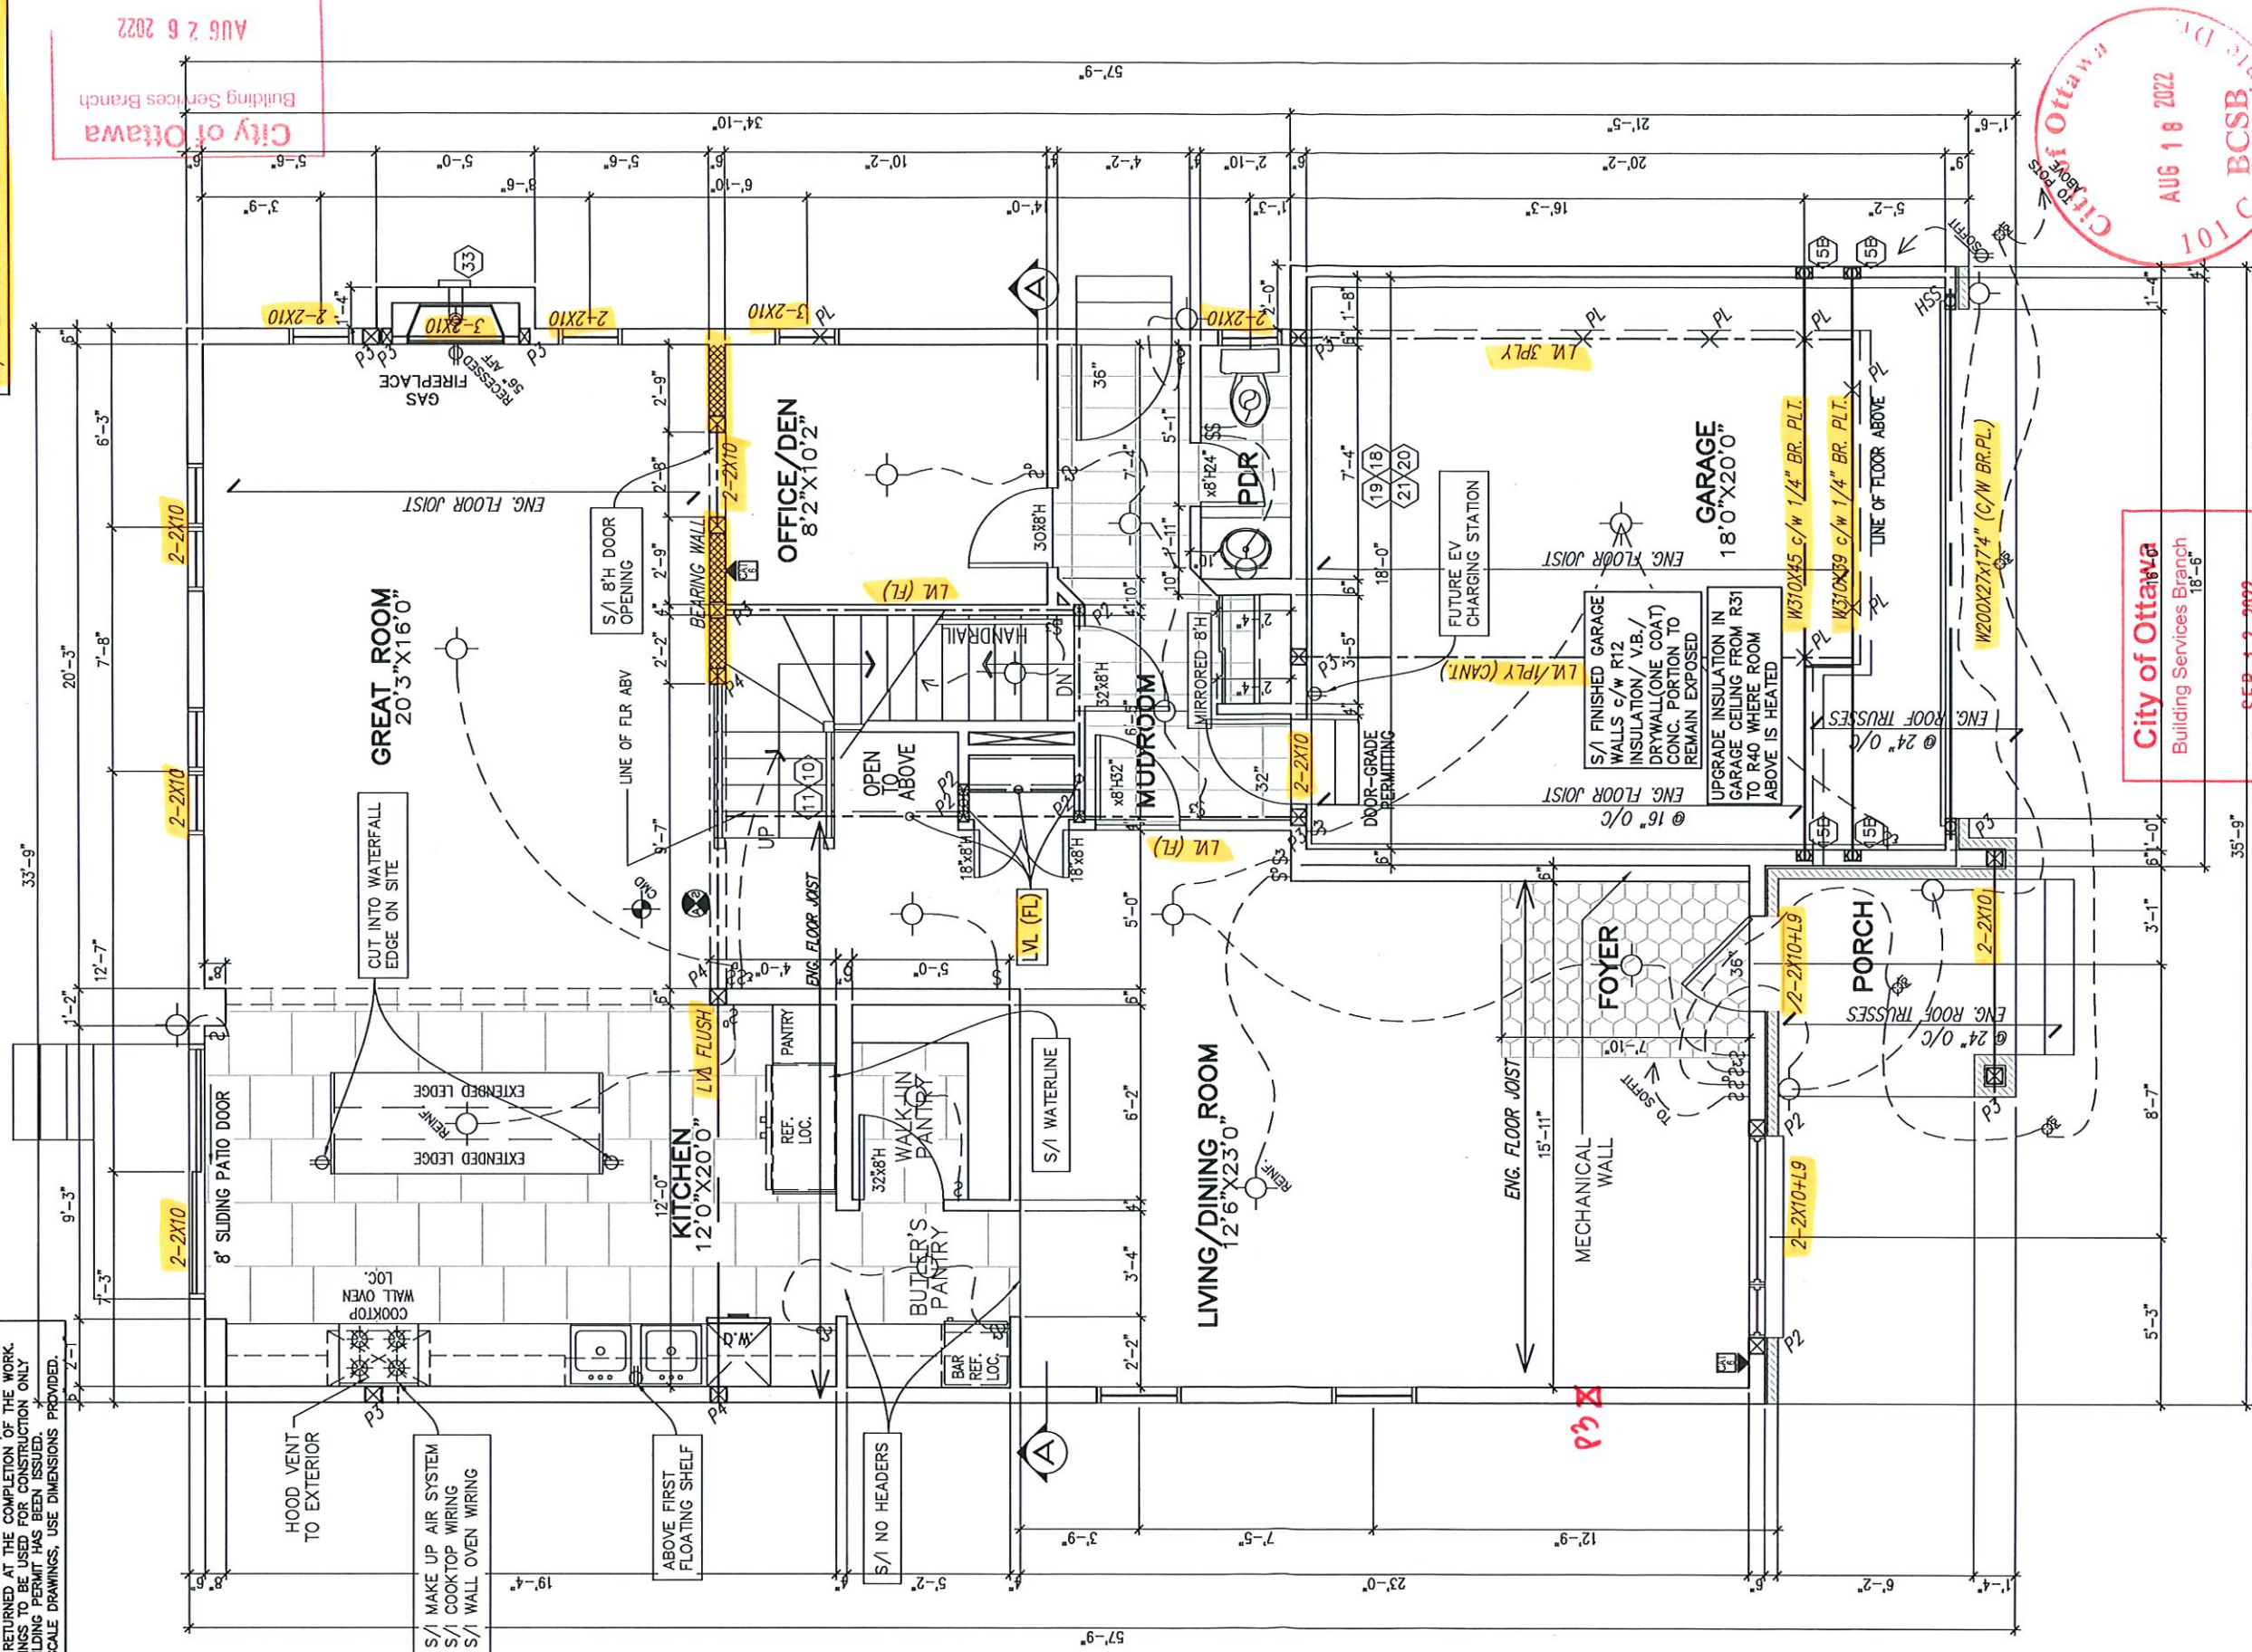


GROUND FLOOR PLAN EL. M
1445 SQFT

NOTE:
ALL LVL'S SUPPORTING FLOOR LOADS ARE FLUSH,
UNLESS NOTED OTHERWISE AND TO BE SPECIFIED
BY THE FLOOR TRUSS MANUFACTURER, SEE
MANUF. LAYOUT.

City of Ottawa
Building Services Branch
18'-5"

SEP 12 2022

Building Code Reviewed

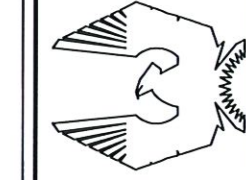

PHOENIX HOMES

MADISON - 2020

SITE: PATHWAYS 2

LOT NUMBER:
CIVIC ADDRESS:
914 OMAGAKI WAY

272


5	FINAL BLACKLINES	28 JUN 22	CB	footprint: 43-10
4	ISSUED FOR STRUCTURAL REVIEW	12 MAY 22	SP	drawn by: SP
3	BEP BLACKLINES - REVISED	12 APR 22	GK	date: NOV/19
2	BEP BLACKLINES	11 APR 22	GK	scale: 3/16"=1'-0"
1	ISSUED FOR PRICING ONLY	DEC-2019	SP	sheet no: 3
REVISIONS				D.C.L. - 184
No.	Description	Date	By	

CONTRACTOR MUST VERIFY ALL DIMENSIONS ON THE JOB AND REPORT ANY DISCREPANCY TO DCR/PHOENIX BEFORE PROCEEDING WITH THE WORK. ALL SPECIFICATIONS ARE INSTRUMENTS OF SERVICE AND MUST BE FOLLOWED TO THE LETTER. ANY DEVIATION MUST BE APPROVED BY THE DCR/PHOENIX BEFORE PROCEEDING. ALL DIMENSIONS TO BE USED FOR CONSTRUCTION ONLY. AFTER BUILDING PERMIT HAS BEEN ISSUED, DO NOT SCALE DRAWINGS, USE DIMENSIONS PROVIDED.

• PROVIDE STUD WALL REINFORCEMENT IN THE MAIN BATHROOM FOR FUTURE INSTALLATION OF GERS BARS IN ACCORDANCE WITH 9.5.2.3. OF THE OBC 2012

NOTE
ALL WINDOW LINTELS TO BE 2-2X10 W/ P2 POSTS ON EACH SIDE U.N.O.


City of Ottawa
Building Services Branch
Aug 2 6 2022
Zoning Reviewed

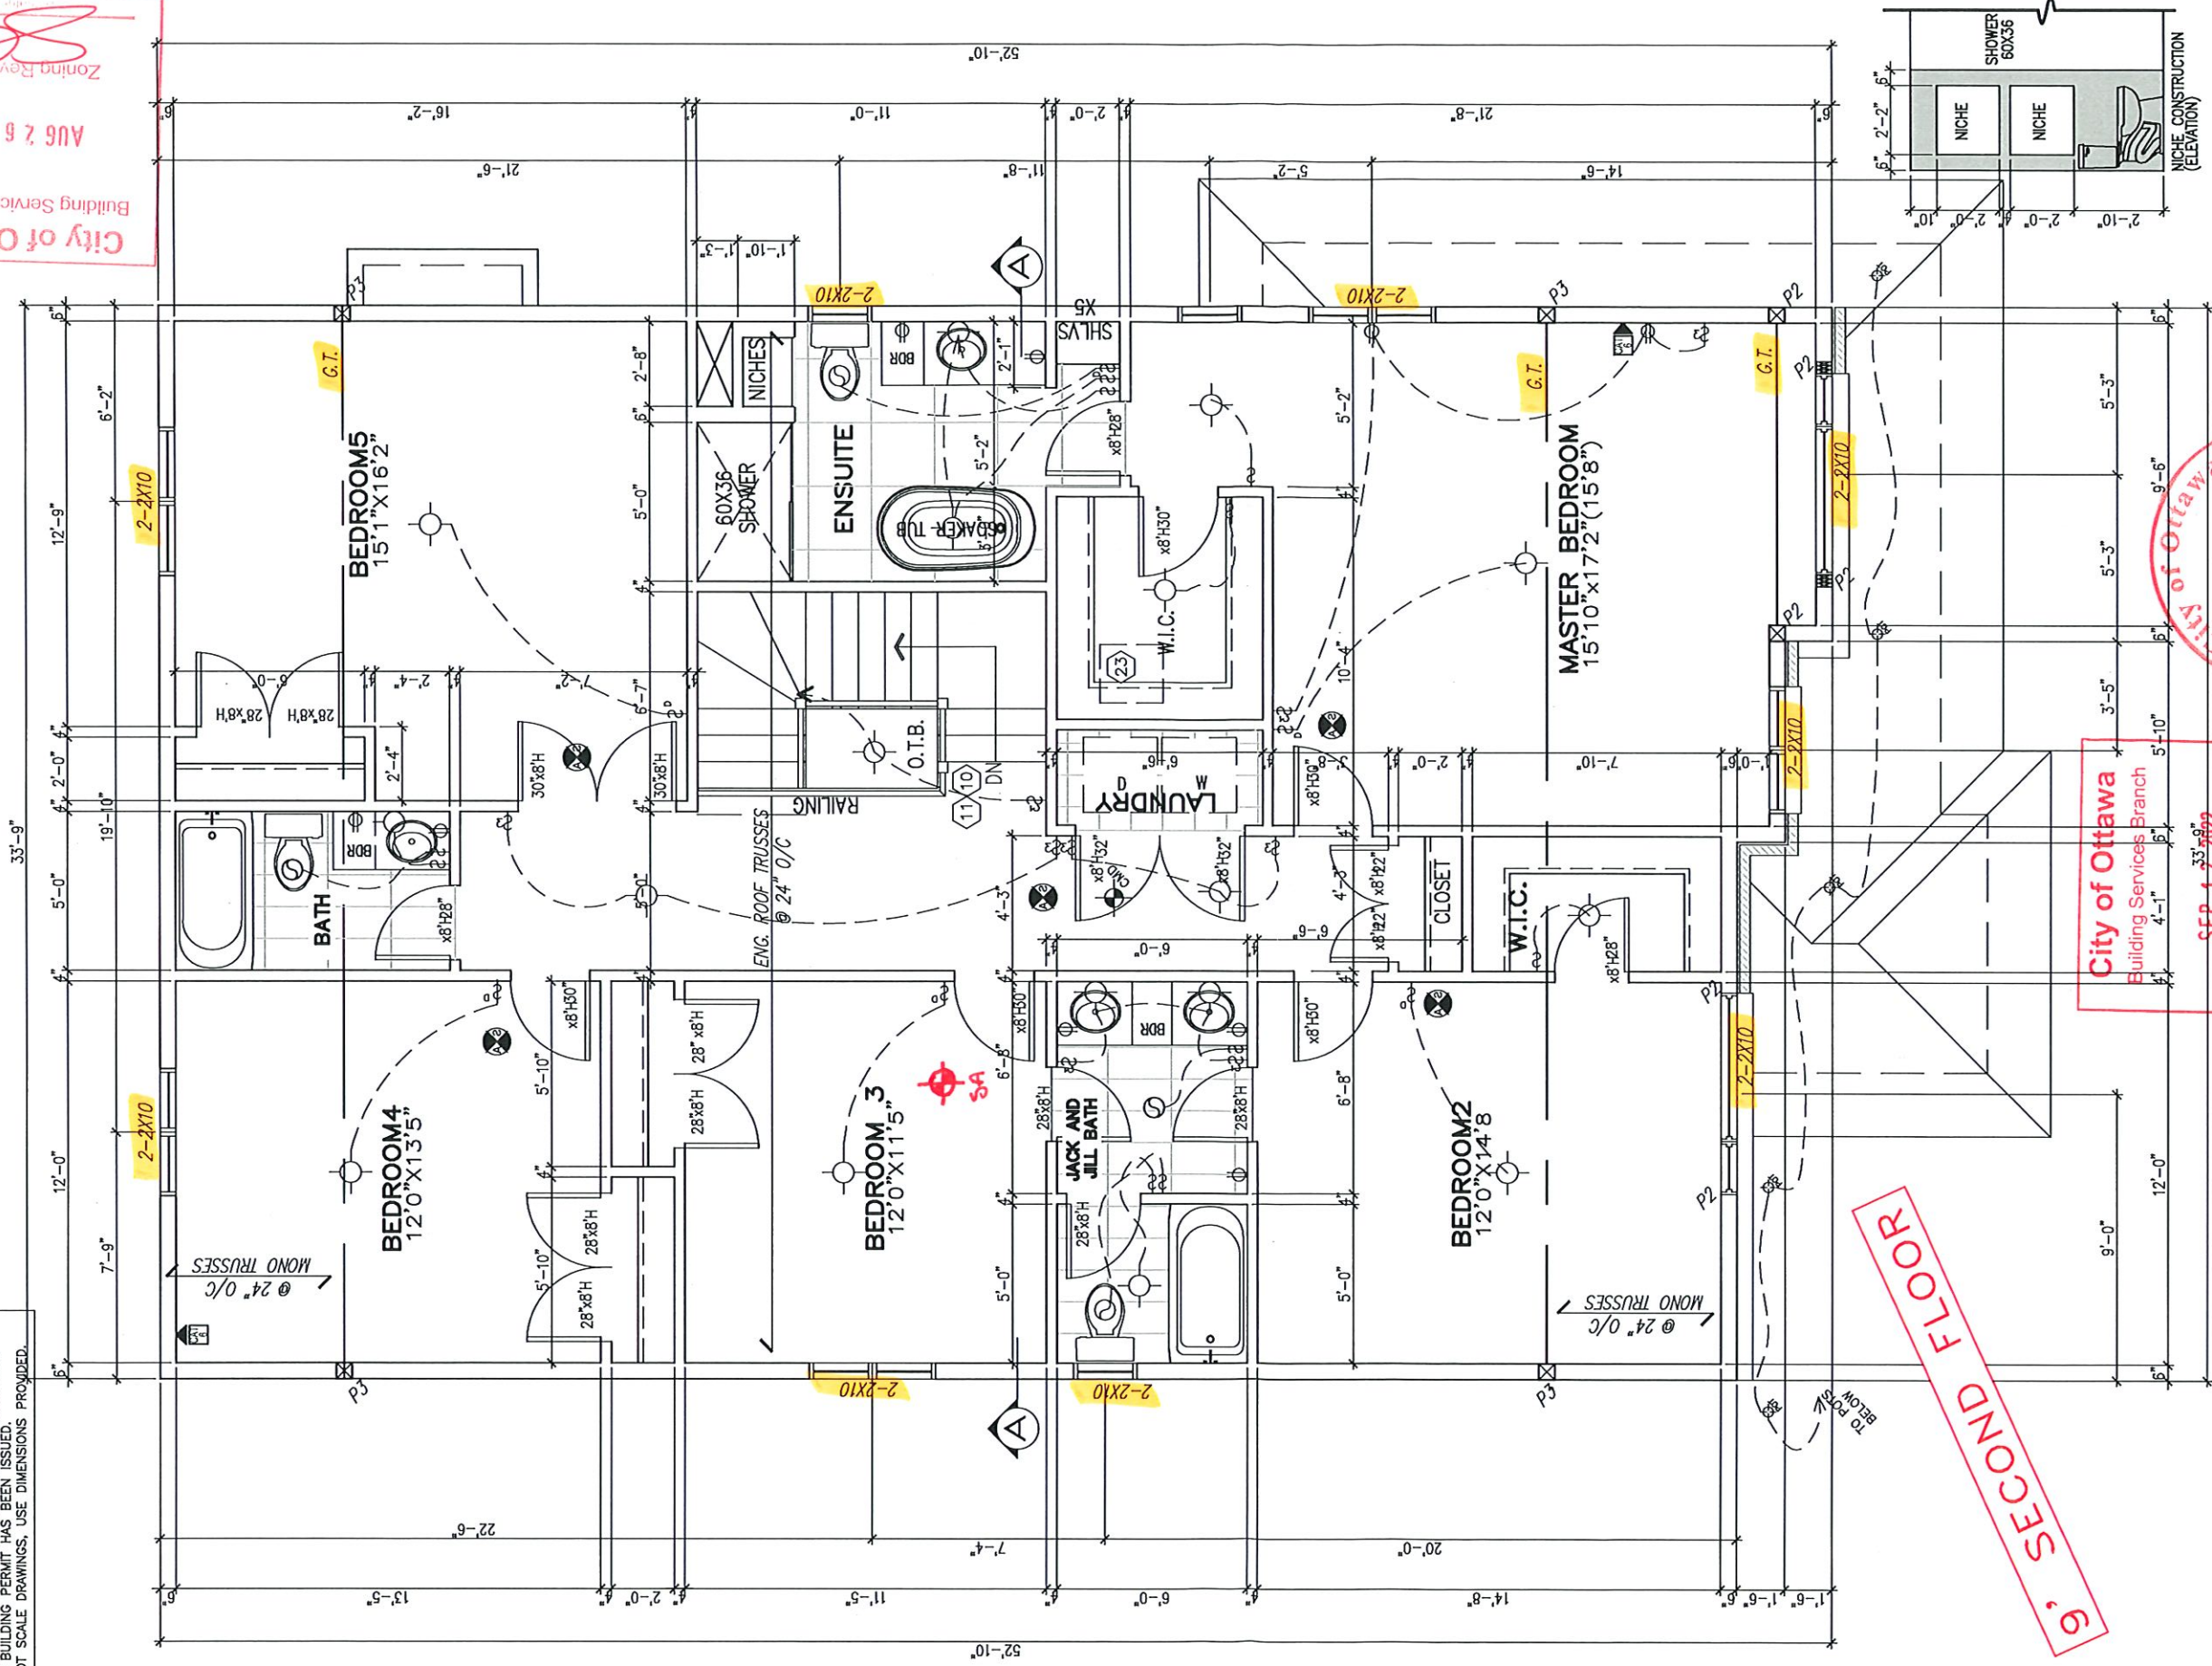

SECOND FLOOR PLAN EL. M
(4 BEDROOM+LOFT)
1723 SQFT

City of Ottawa
Building Services Branch
SEP 1 2 2022
Building Code Reviewed
Signature

NOTE:
ALL LVL'S SUPPORTING FLOOR LOADS ARE FLUSH, UNLESS NOTED OTHERWISE AND TO BE SPECIFIED BY THE FLOOR TRUSS MANUFACTURER, SEE MANUF. LAYOUT.

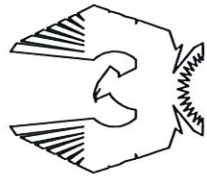

PHOENIX HOMES

MADISON - 2020

SITE: PATHWAYS 2

272

LOT NUMBER:

CIVIC ADDRESS:
914 OMAGAKI WAY

No.	Description	By	Date
5	FINAL BLACKLINES	CB	28 JUN 22
4	ISSUED FOR STRUCTURAL REVIEW	SP	12 MAY 22
3	BEP BLACKLINES - REVISED	GK	12 APR 22
2	BEP BLACKLINES	GK	11 APR 22
1	ISSUED FOR PRICING ONLY	SP	DEC-2019
REVISIONS			



footprint:	43-10
drawn by:	SP
date:	NOV/19
scale:	3/16"=1'-0"
sheet no:	4AC
D.C.L. - 184	8

CONTRACTOR MUST VERIFY ALL DIMENSIONS ON THE JOB AND REPORT ANY DISCREPANCY TO DCR/PHOENIX BEFORE PROCEEDING WITH THE WORK.

9' FOUNDATION POUR

9' SECOND FLOOR

2'-0"

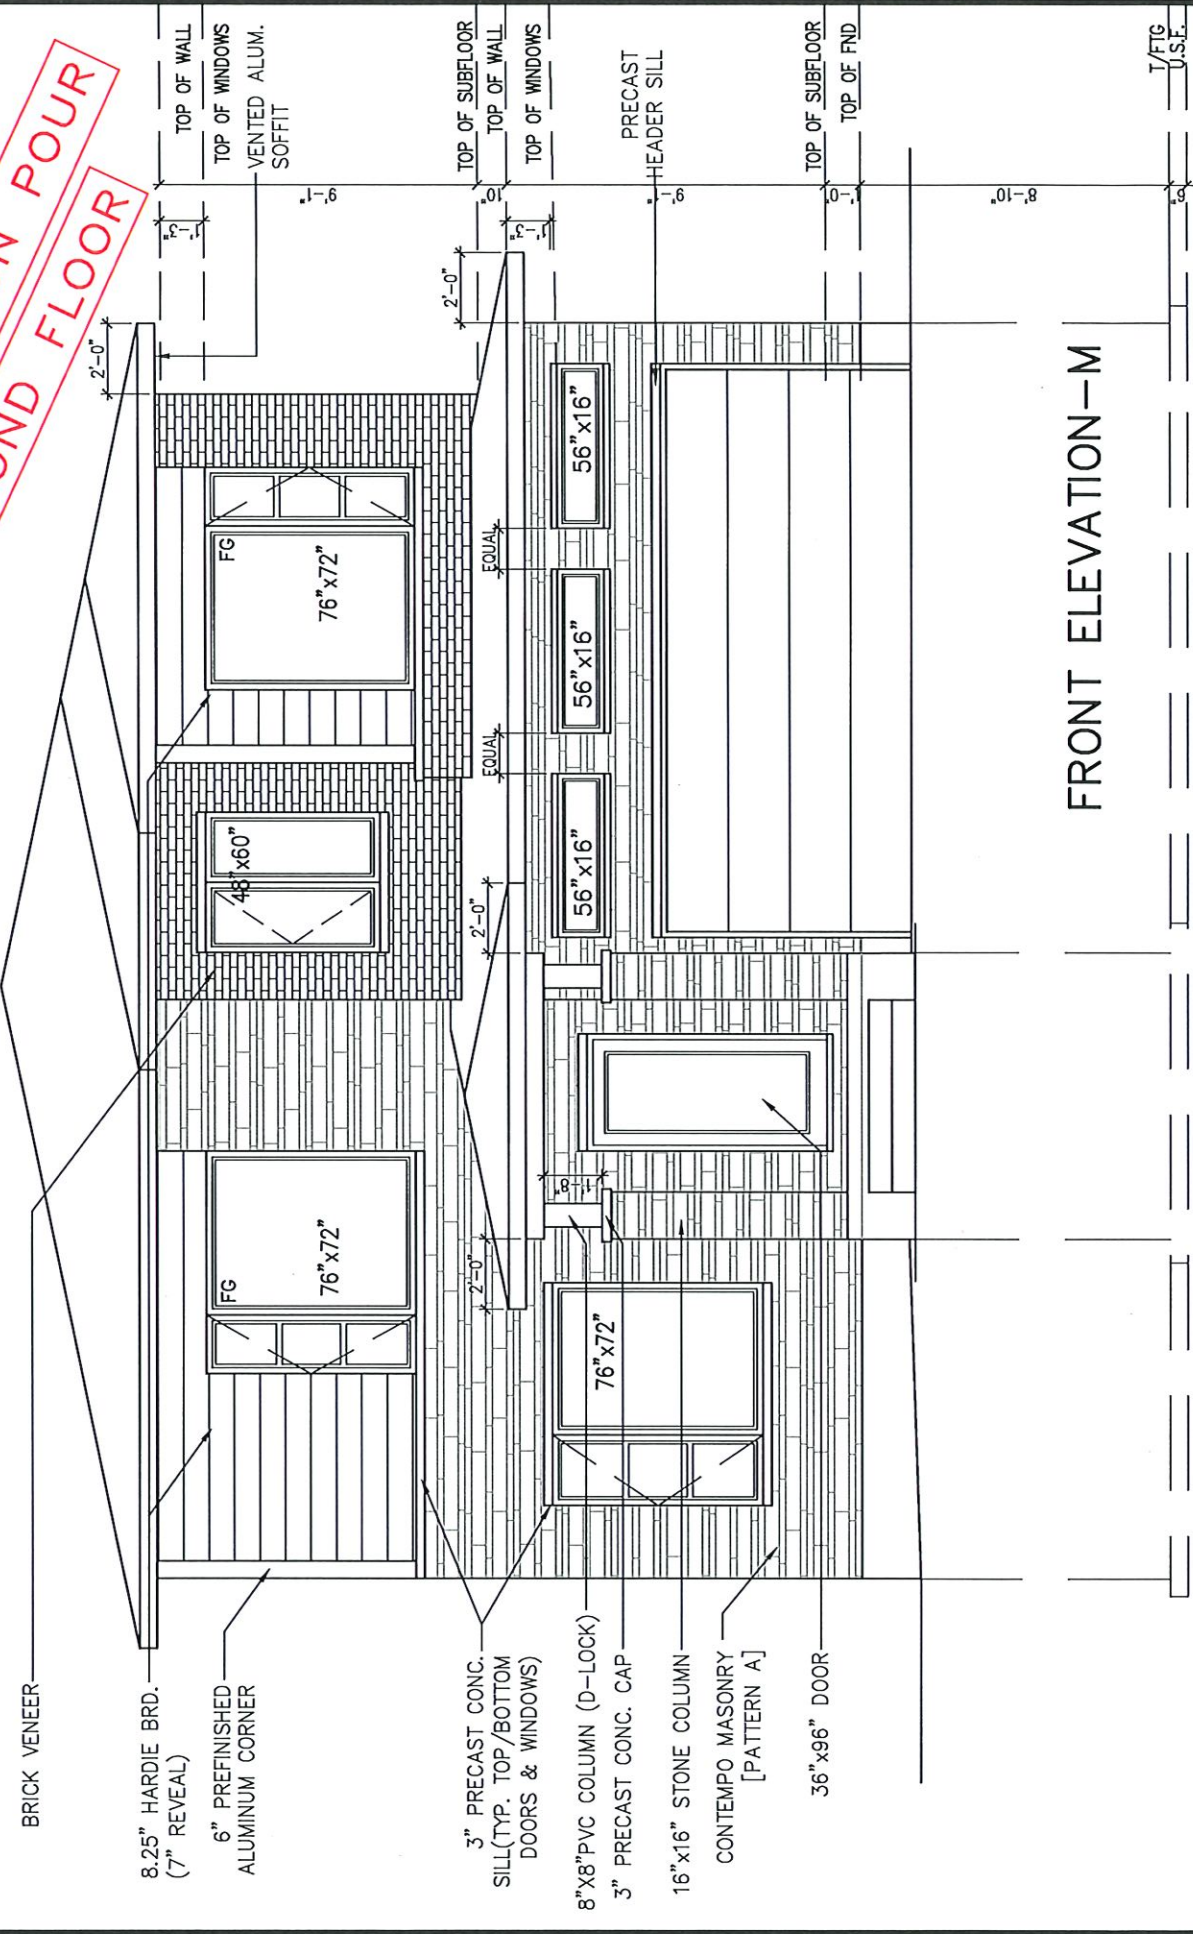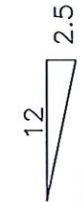


FRONT ELEVATION—M

T/FTG
U.S.F.

DECORATIVE TRIM AROUND
WINDOWS

DO NOT INSTALL
ATTENTION SLIDING CREWMAN**

2'-0"

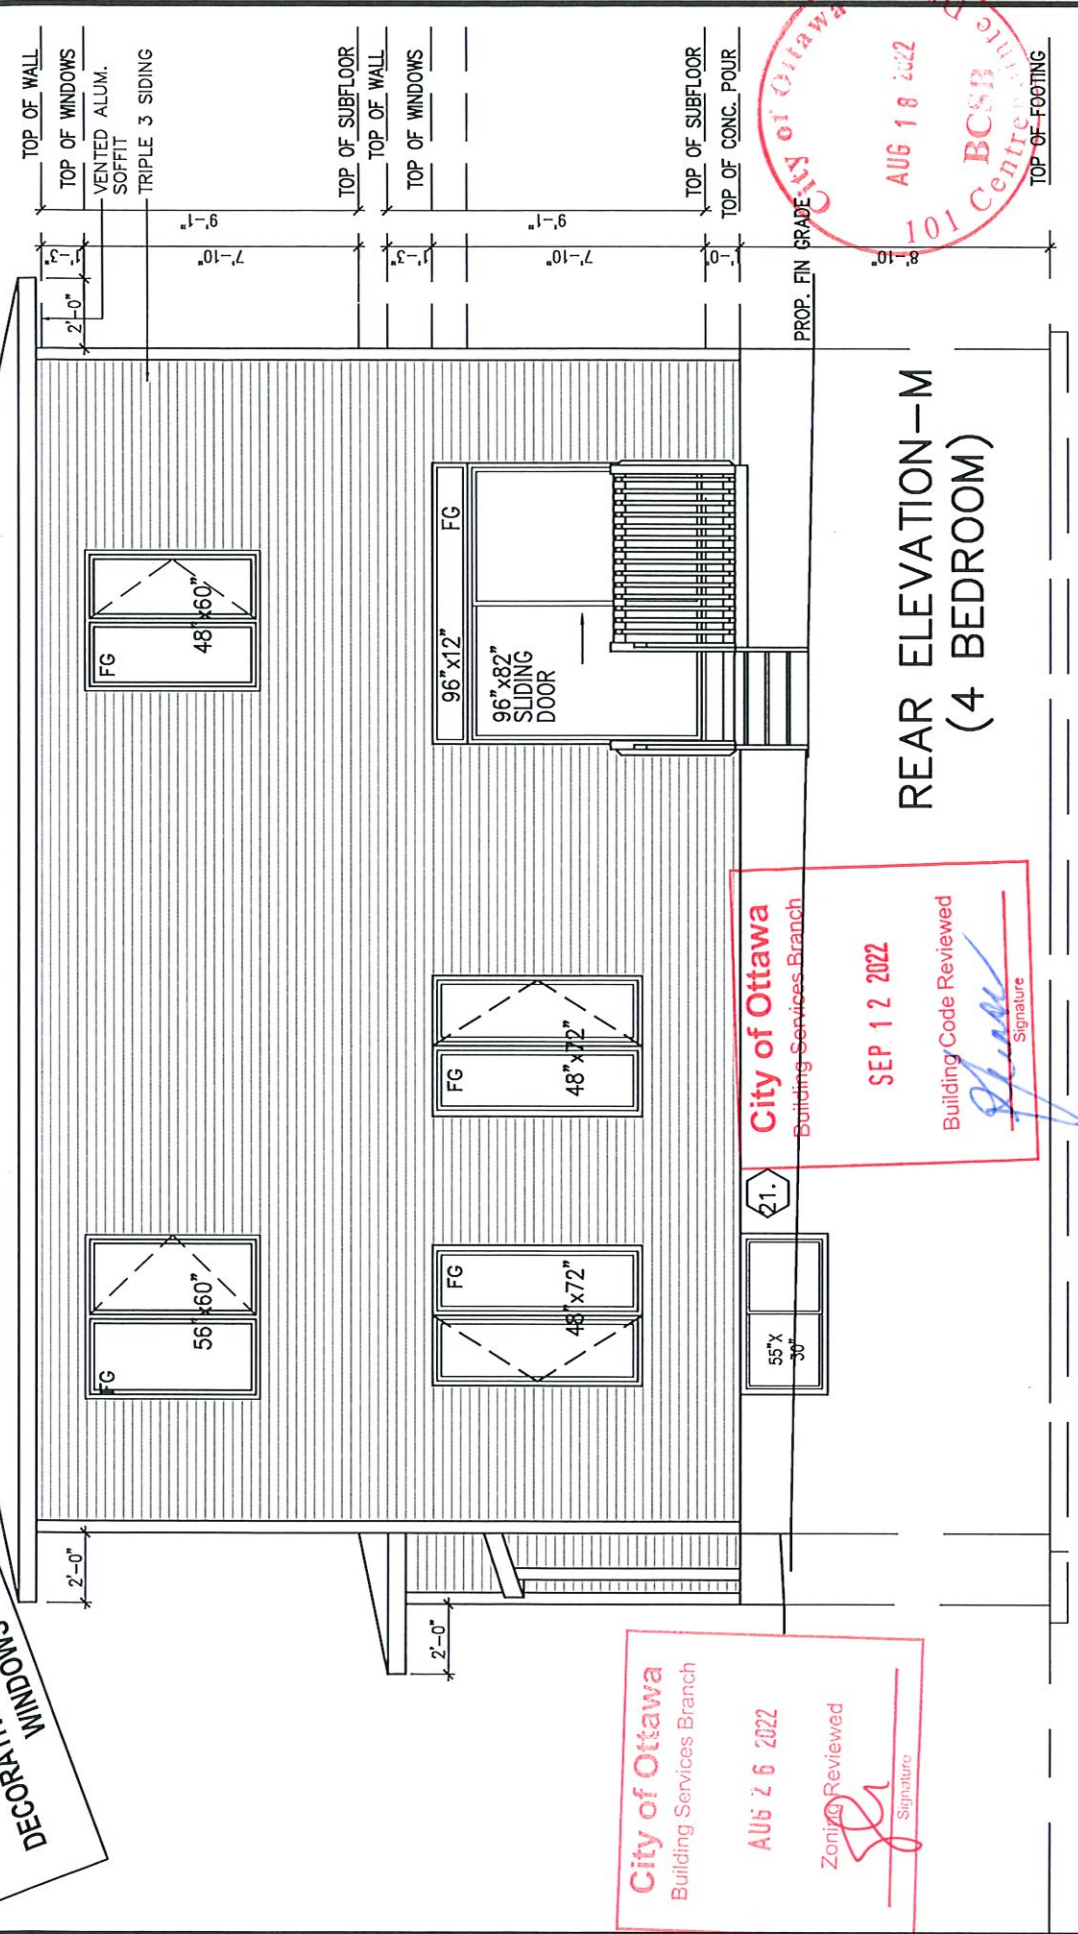

1 GRADE 101-18

REAR ELEVATION—M
(4 BEDROOM)

MADISON - 2020	
SITE: PATHWAYS 2	
LOT NUMBER: 272	
CIVIC ADDRESS: 914 OMAGAKI WAY	
	
PHOENIX HOMES	
footprint: 43-10	
drawn by: SP	
date: NOV/19	
scale: 3/16"=1'-0"	
sheet no: 5D / 8	
D.C.L. - 184	
5 FINAL BLACKLINES	
28 JUN 22 CB	
4 ISSUED FOR STRUCTURAL REVIEW	
12 MAY 22 SP	
3 BEP BLACKLINES - REVISED	
12 APR 22 GK	
2 BEP BLACKLINES	
11 APR 22 GK	
1 ISSUED FOR PRICING ONLY	
DEC-2019 SP	
No.	Description
Date	
By	
REVISIONS	

PHOENIX HOMES



CIVIC ADDRESS:
914 OMAGAKI WAY

LOT NUMBER:

SITE: **PATHWAYS 2**

MADISON - 2020

272


REVISIONS	
No.	Description
1	ISSUED FOR PRICING ONLY
2	BEP BLACKLINES
3	BEP BLACKLINES - REVISED
4	ISSUED FOR STRUCTURAL REVIEW
5	FINAL BLACKLINES
By	Date
SP	DEC-2019
GK	11 APR 22
GK	12 APR 22
SP	12 MAY 22
CB	28 JUN 22

footprint: 43-10
drawn by: SP
date: NOV/19
scale: 3/16"=1'-0"
sheet no: 17
D.C.L. - 184
8A
8


AREA CALCULATIONS	ELEV. 'M'
(4&5 BEDROOM)	1318
MAIN FLOOR AREA	1587 SF
SUBTOTAL	2905 SF
DEDUCT ALL OPEN AREAS	52 SF
TOTAL NET AREA	2853 SF

CONTRACTOR MUST VERIFY ALL DIMENSIONS ON THE JOB AND REPORT ANY DISCREPANCY TO DCR/PHOENIX BEFORE PROCEEDING WITH THE WORK.
ALL DRAWINGS AND SPECIFICATIONS ARE INSTRUMENTS OF SERVICE AND THE PROPERTY OF THE DCR/PHOENIX WHICH MUST BE RETURNED AT THE COMPLETION OF THE WORK.
AFTER BUILDING PERMIT HAS BEEN ISSUED,
DO NOT SCALE DRAWINGS, USE DIMENSIONS PROVIDED.

City of Ottawa
Building Services Branch
SEP 12 2022
Building Code Reviewed

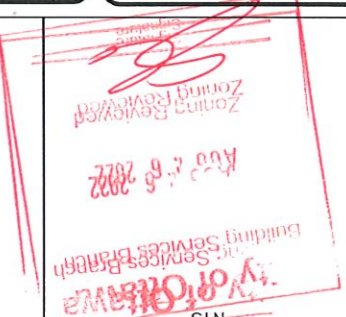


ROOF PLAN-M 4&5BD

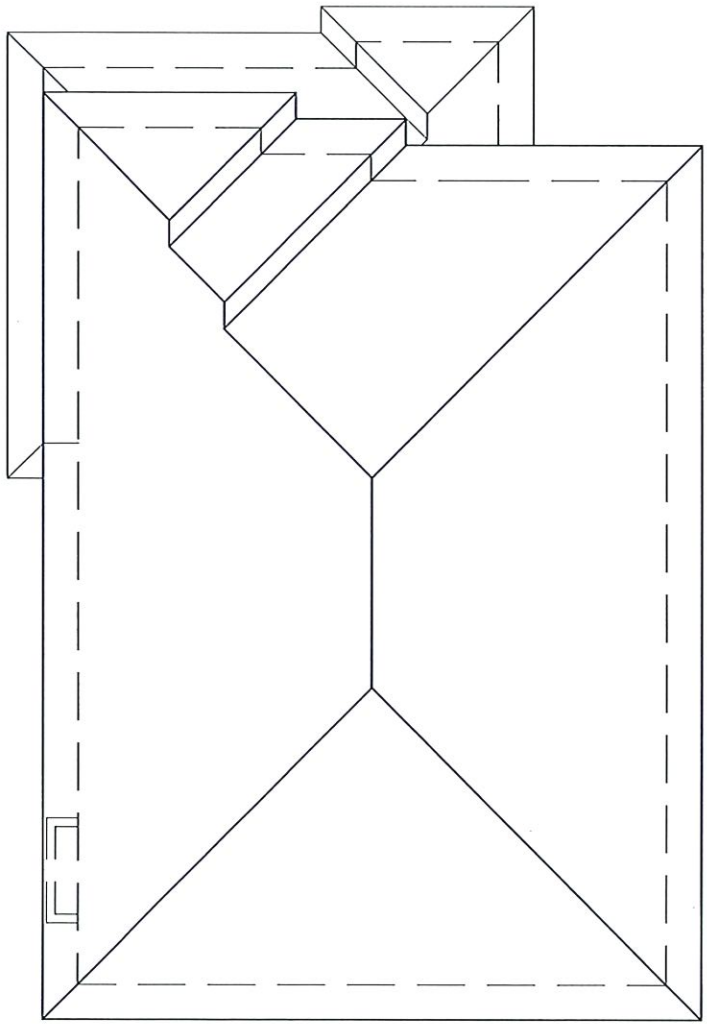


9' SECOND FLOOR
9' FOUNDATION POUR

SECTION "AA" @ STAIR

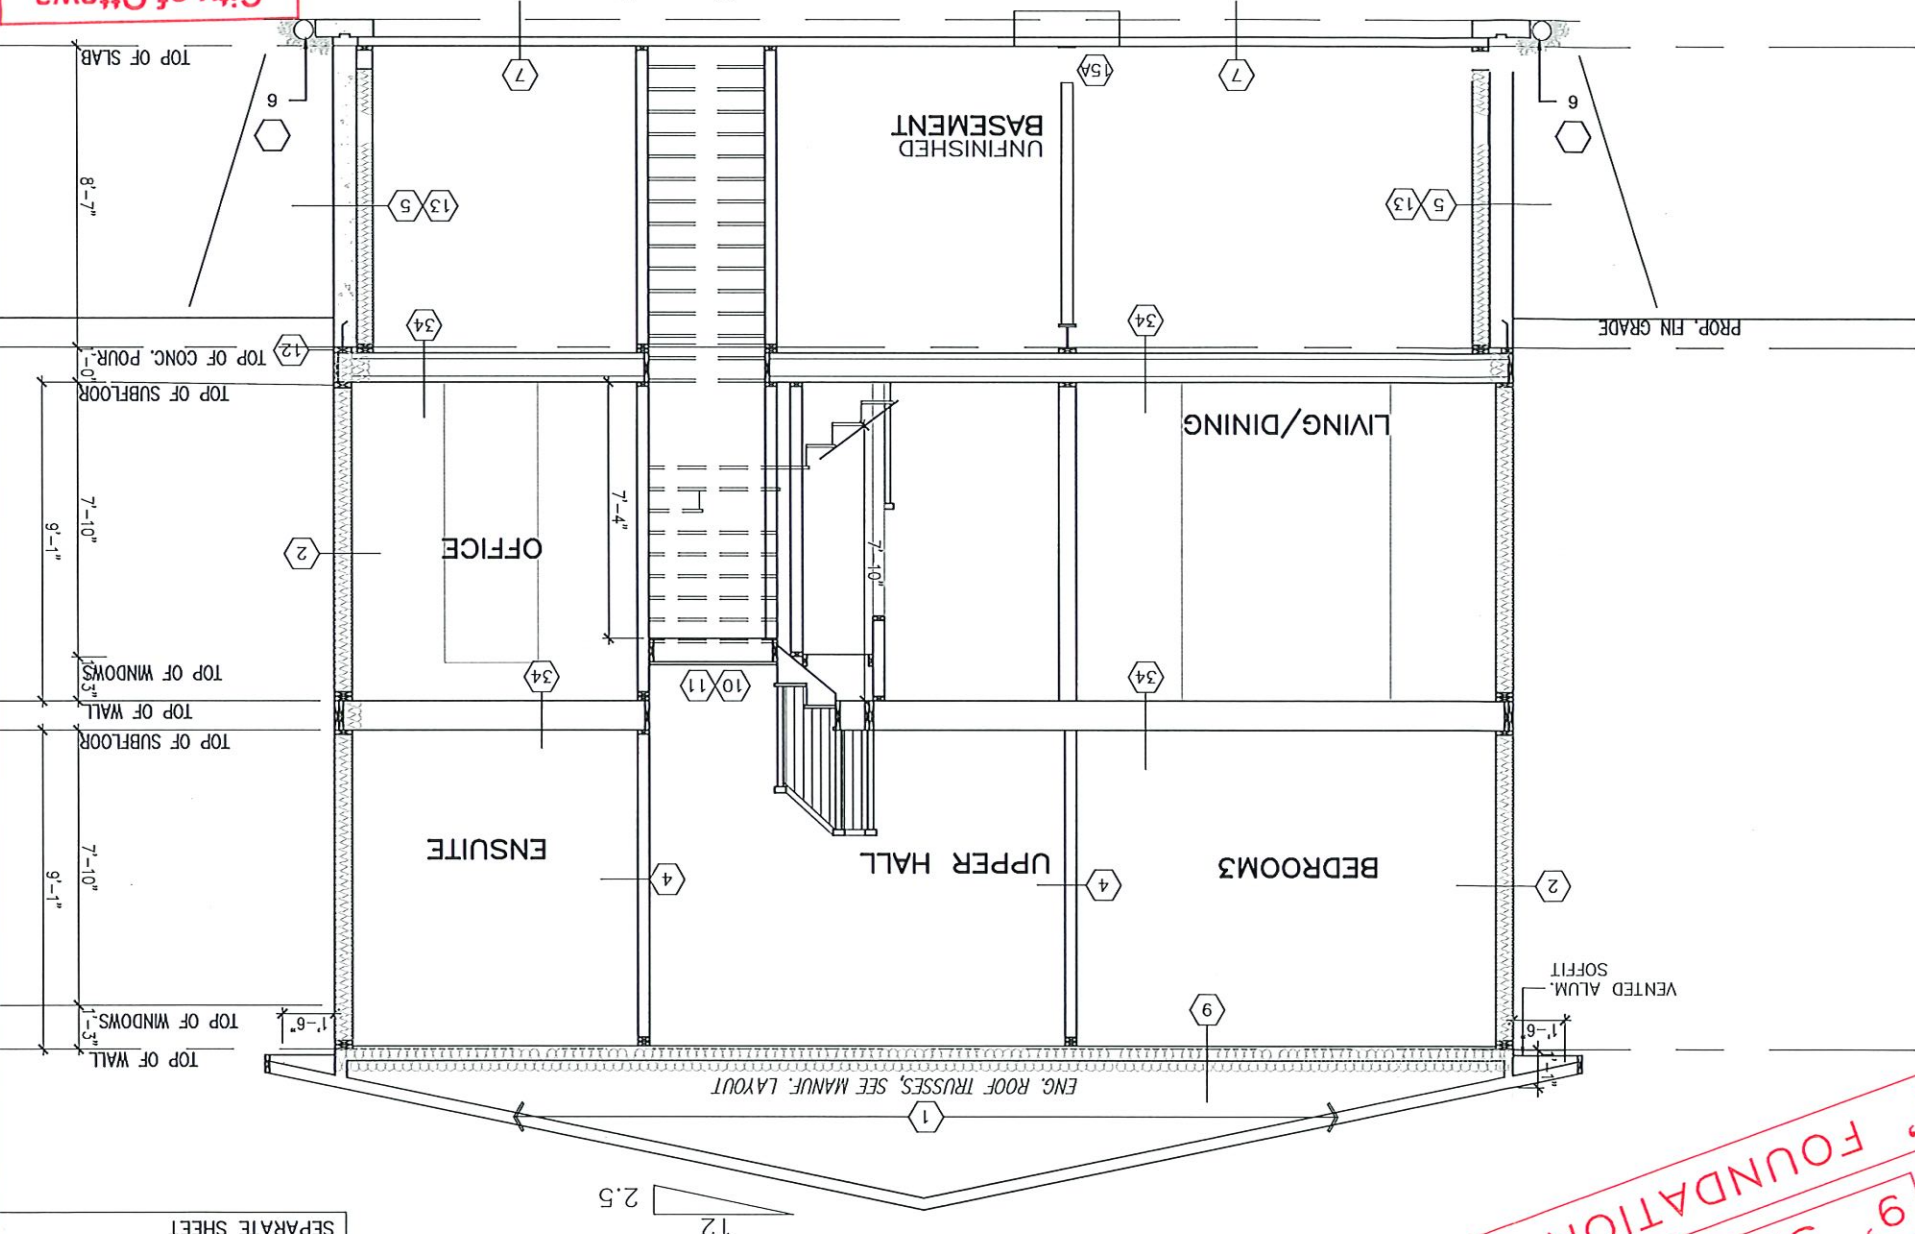

NOTE:
SEE TYPICAL AIR BARRIER AND
VAPOUR BARRIER DETAIL ON
SEPARATE SHEET

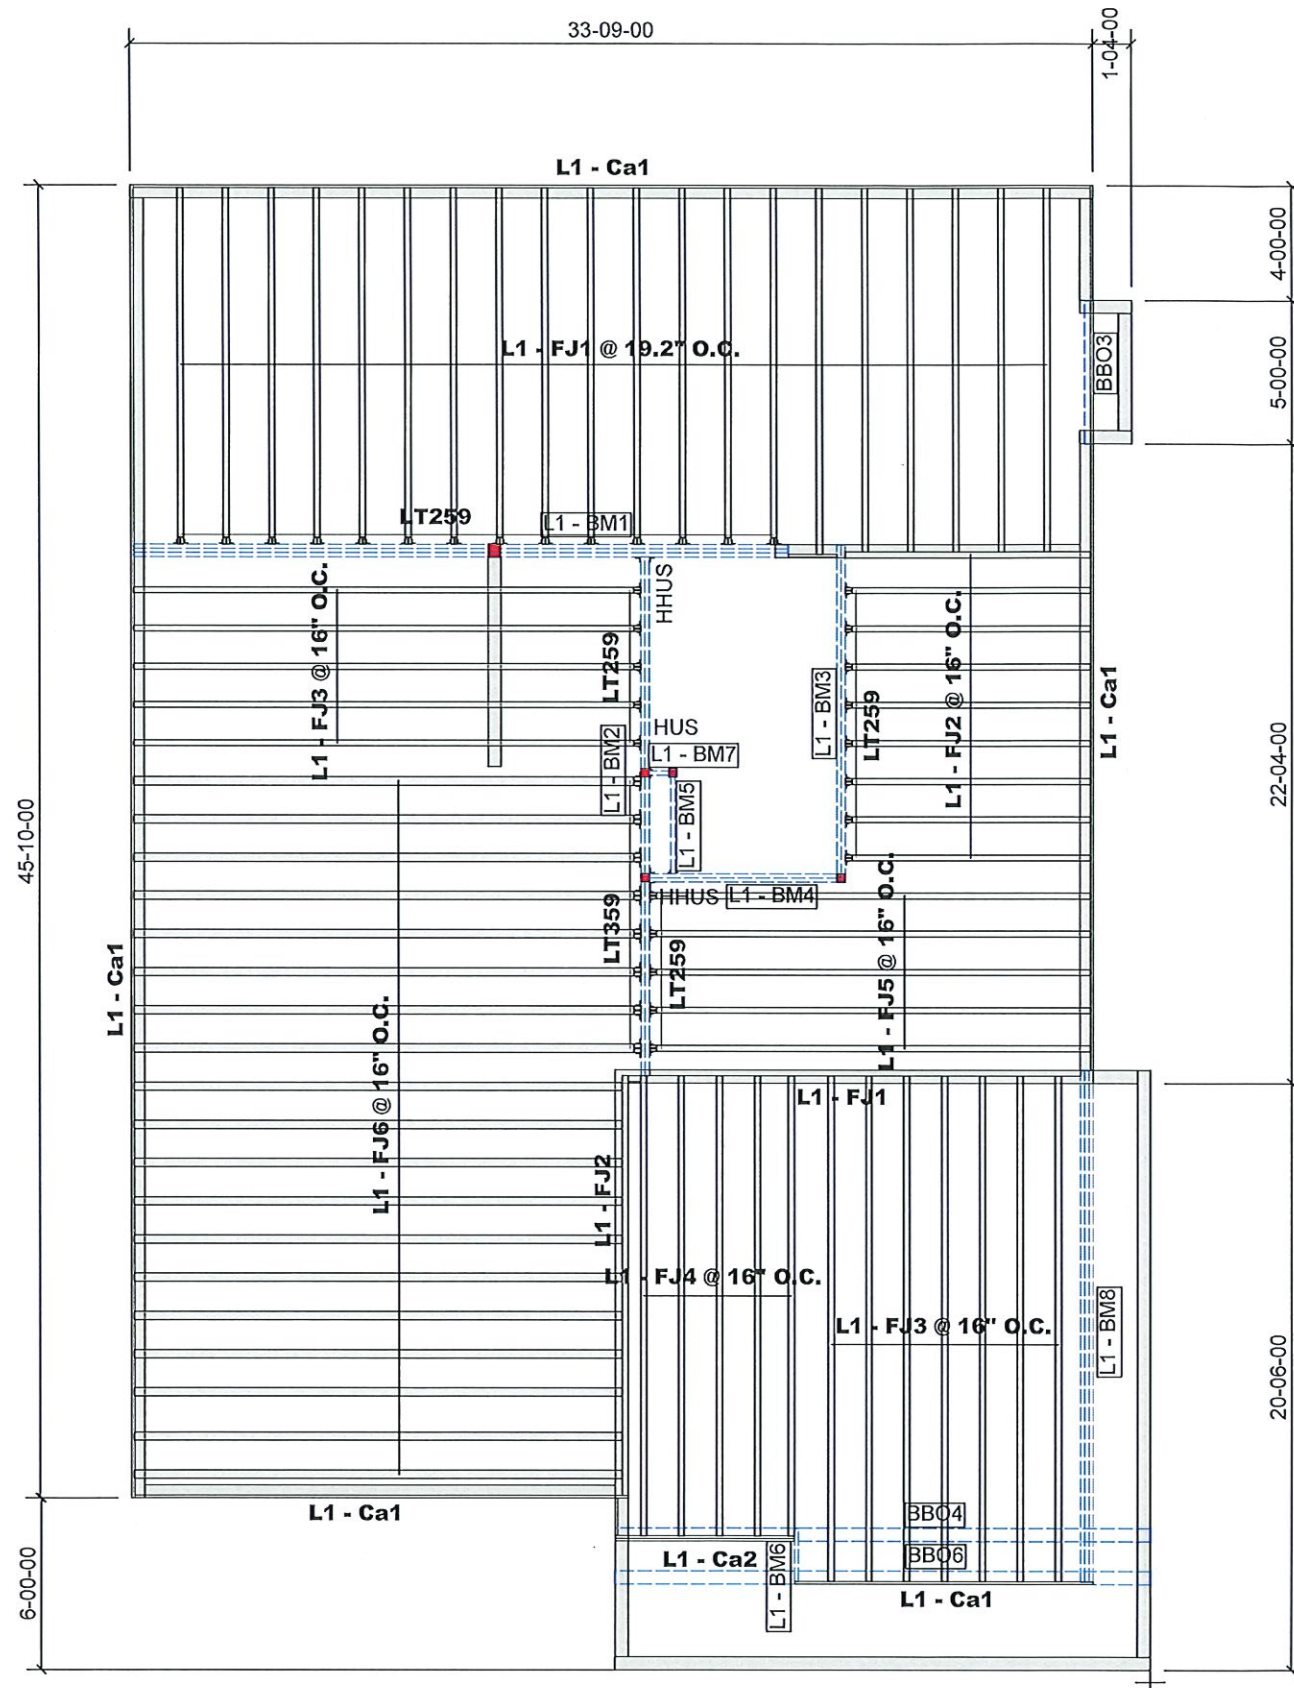

GLUED AND NAILED

LEVEL AND FLOOR CONTAINER NOTES	
Current Date:	5/11/2022
File Name:	PW2-272 Madison 4Bed M.mmdl
Level Name:	2nd Floor
Building Code - Design Methodology:	NBCC 2015
Floor Container:	FC2
Floor Area Loading is:	40 Live Load & 15 Dead Load
Maximum Allowed Deflection	L/480 Live Load & L/240 Total Load

Products					
PlotID	Length	Product	Plies	Net Qty	Fab Type
L1 - FJ1	16-00-00	9 1/2" NI-20	1	1	MFD
L1 - FJ2	15-00-00	9 1/2" NI-20	1	1	MFD
L1 - FJ1 @ 19.2" O.C.	13-00-00	9 1/2" NI-20	1	20	MFD
L1 - FJ2 @ 16" O.C.	9-00-00	9 1/2" NI-20	1	9	MFD
L1 - FJ3 @ 16" O.C.	18-00-00	9 1/2" NI-40x	1	12	MFD
L1 - FJ4 @ 16" O.C.	17-00-00	9 1/2" NI-40x	1	5	MFD
L1 - FJ5 @ 16" O.C.	16-00-00	9 1/2" NI-40x	1	5	MFD
L1 - FJ6 @ 16" O.C.	18-00-00	9 1/2" NI-80	1	19	MFD
L1 - BM1	23-00-00	1 3/4" x 9 1/2" (2.0E 3100) WestFraser LVL	3	3	MFD
L1 - BM2	19-00-00	1 3/4" x 9 1/2" (2.0E 3100) WestFraser LVL	2	2	MFD
L1 - BM3	12-00-00	1 3/4" x 9 1/2" (2.0E 3100) WestFraser LVL	2	2	MFD
L1 - BM4	7-00-00	1 3/4" x 9 1/2" (2.0E 3100) WestFraser LVL	2	2	MFD
L1 - BM5	4-00-00	1 3/4" x 9 1/2" (2.0E 3100) WestFraser LVL	1	1	MFD
L1 - BM6	2-00-00	1 3/4" x 9 1/2" (2.0E 3100) WestFraser LVL	1	1	MFD
L1 - BM7	1-00-00	1 3/4" x 9 1/2" (2.0E 3100) WestFraser LVL	1	1	MFD
L1 - BM8	18-00-00	1 3/4" x 14" (2.0E 3100) WestFraser LVL	3	3	MFD
L1 - Ca1	12-00-00	1 1/8" x 9 1/2" APA Rim Board	1	12	FF
L1 - Ca2	12-00-00	1 1/8" x 9 1/2" APA Rim Board	2	2	FF
L1 - Bk1	1-00-00	9 1/2" NI-20	1	1	MFD

Accessories					
PlotID	Length	Product	Plies	Net Qty	Fab Type
		3/4" Plywood or OSB (23/32" APA Rated Sheathing 48/24 Exposure 1)	1	50	MFD

Connector Summary				
Qty	Manuf	Product	Skew	Supported Mil
32	SIMPSON	LT259	-	9 1/2" NI-20/40x
8	SIMPSON	LT359	-	9 1/2" NI-80
2	SIMPSON	HUS18110	-	1 3/4" x 9 1/2" WF LVL
2	SIMPSON	HHUS410	-	2- 1 3/4" x 9 1/2" WF LVL

THIS DESIGN COMPLIES WITH:

- PART 4 OR 9 OF OBC 2012 Reg. 332/12 (2019 Amendment)
- NORDIC LAM CCMC: 13216-R
- NORDIC JOISTS CCMC: 13032-R
- WEST FRASER CCMC: 12904

(REFER TO INDIVIDUAL FLOOR DRAWINGS FOR SPECIFIC LOADS & SPACING)

FLOOR NOTES:

- FLOOR JOIST SYSTEMS ABOVE THE GARAGE HAS BEEN DESIGNED WITHOUT A DIRECTLY APPLIED CEILING. USE APPLICABLE BLOCKING OR STRAPPING WHERE REQUIRED AS INDICATED ON THE FRAMING PLAN.
- BLOCKING MATERIAL WILL BE SUPPLIED AND INDICATED AS "BLOCKING". NO LONGER ONLY 12' LENGTHS.



GRANDOR LUMBER INC
ALPA LUMBER GROUP

JOB:

PHOENIX HOMES
PATHWAYS PW2-272
MADISON 4BED M
2ND FLOOR 2 OF 2

DATE:

5/11/2022

City of Ottawa
Building Services Branch

SEP 12 2022

Building Code Reviewed

[Signature]
Signature



