


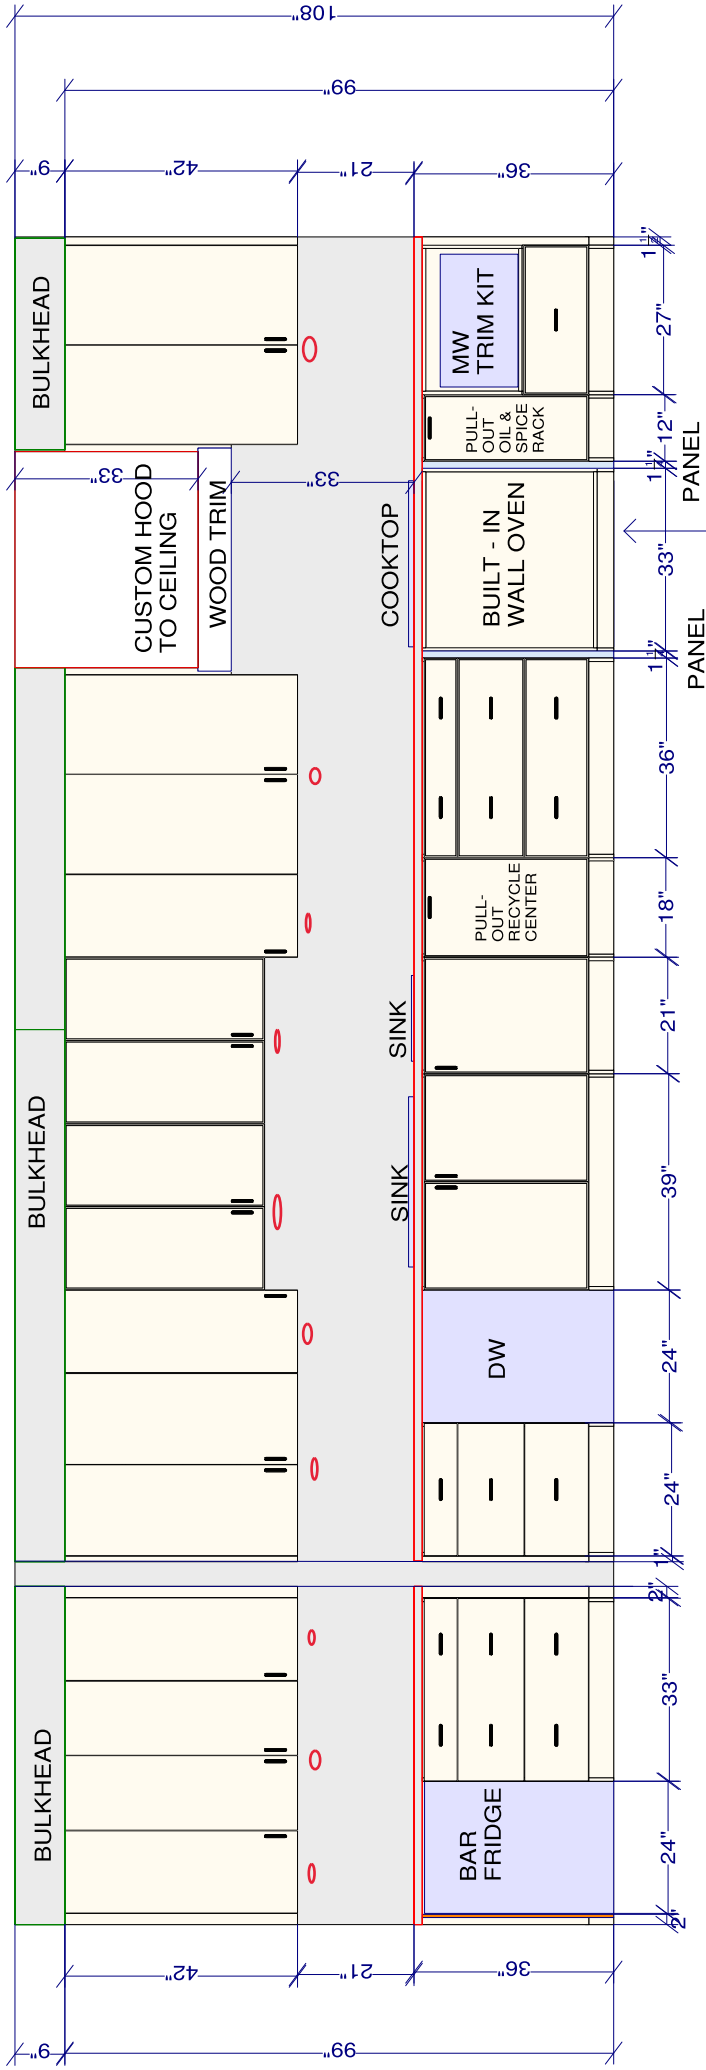

BUTLER'S PANTRY

SINK / COOKTOP WALL ELEVATION

SHORTEN TOE KICK
ON OVEN CABINET
IF NEEDED TO ACCOMMODATE
OVEN BELOW COOKTOP

REVISED: JULY 10-23

CUSTOMER APPROVAL

I have reviewed these drawings and understand the details of the design and the CARTIER KITCHENS specifications.

Signature _____

Date _____


All dimensions ,size designations
given are subject to verification on
job site and adjustment to fit job
conditions.



This is an original design and must
not be released or copied unless
applicable fee has been paid or job
order placed.

Designed: 2023-07-10
Printed: 2023-07-10



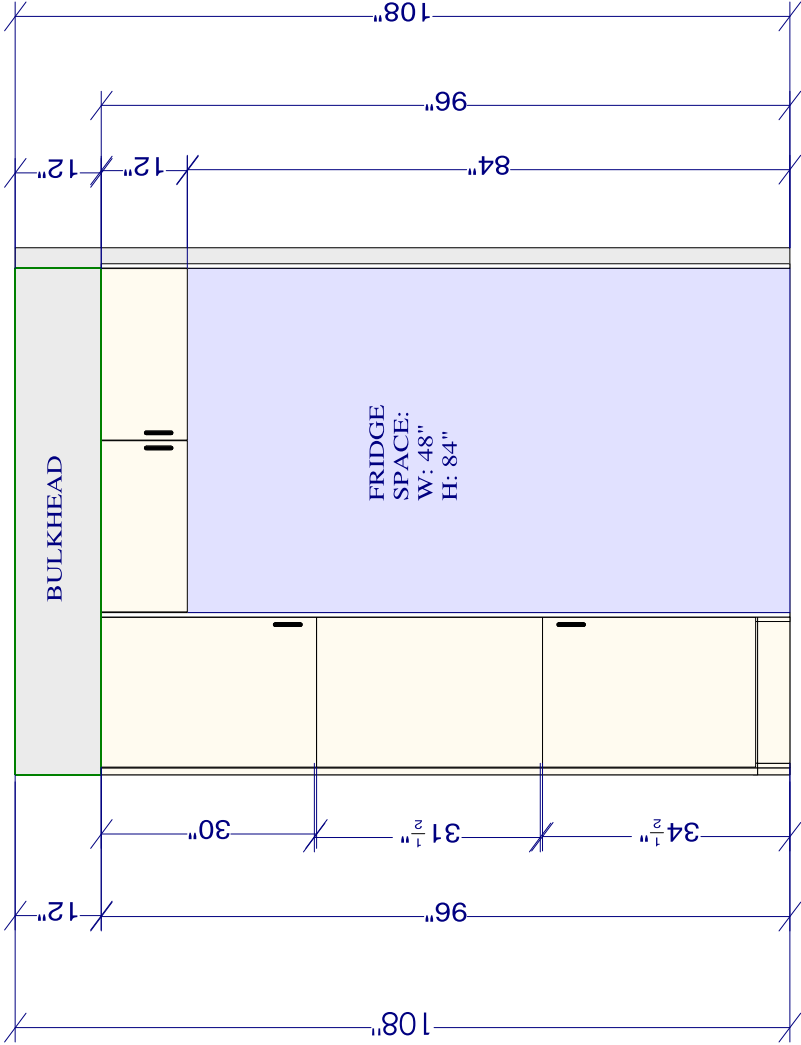

FRIDGE WALL ELEVATION

REVISED: MAY 31-22

CUSTOMER APPROVAL

I have reviewed these drawings and understand the details of the design and the CARTIER KITCHENS specifications.

Signature _____
Date _____

All dimensions _size designations given are subject to verification on job site and adjustment to fit job conditions.



This is an original design and must not be released or copied unless applicable fee has been paid or job order placed.

Designed: 2023-07-10
Printed: 2023-07-10


WD
DS

REVISÉ: JULY 10-23

Date _____



SPECTRUM
KITCHEN & BATH DESIGN

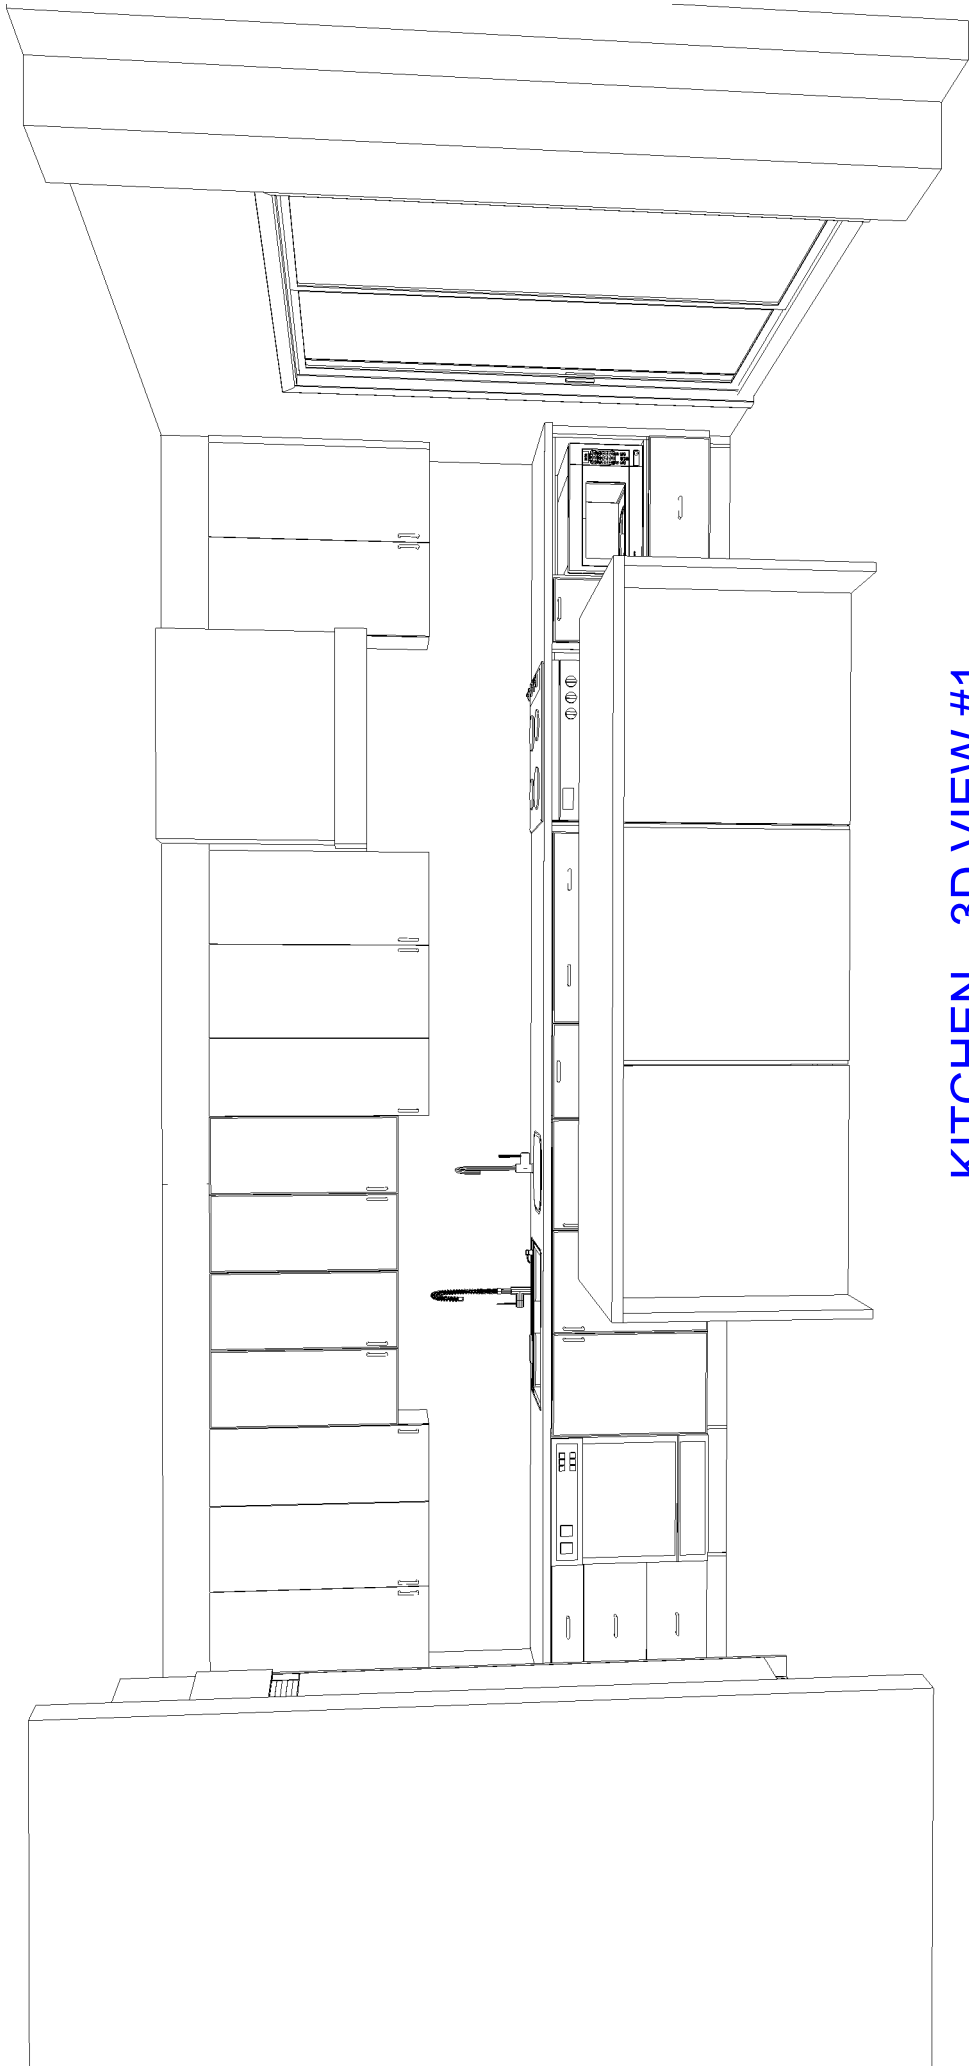

KITCHEN - 3D VIEW #1
REVISED: JULY 10-23

CUSTOMER APPROVAL

I have reviewed these drawings and understand the details of the design and the CARTIER KITCHENS specifications.

Signature _____


Date _____

Note: This drawing is an artistic interpretation of the general appearance of the design. It is not meant to be an exact rendition.



Designed: 2023-07-10
Printed: 2023-07-10



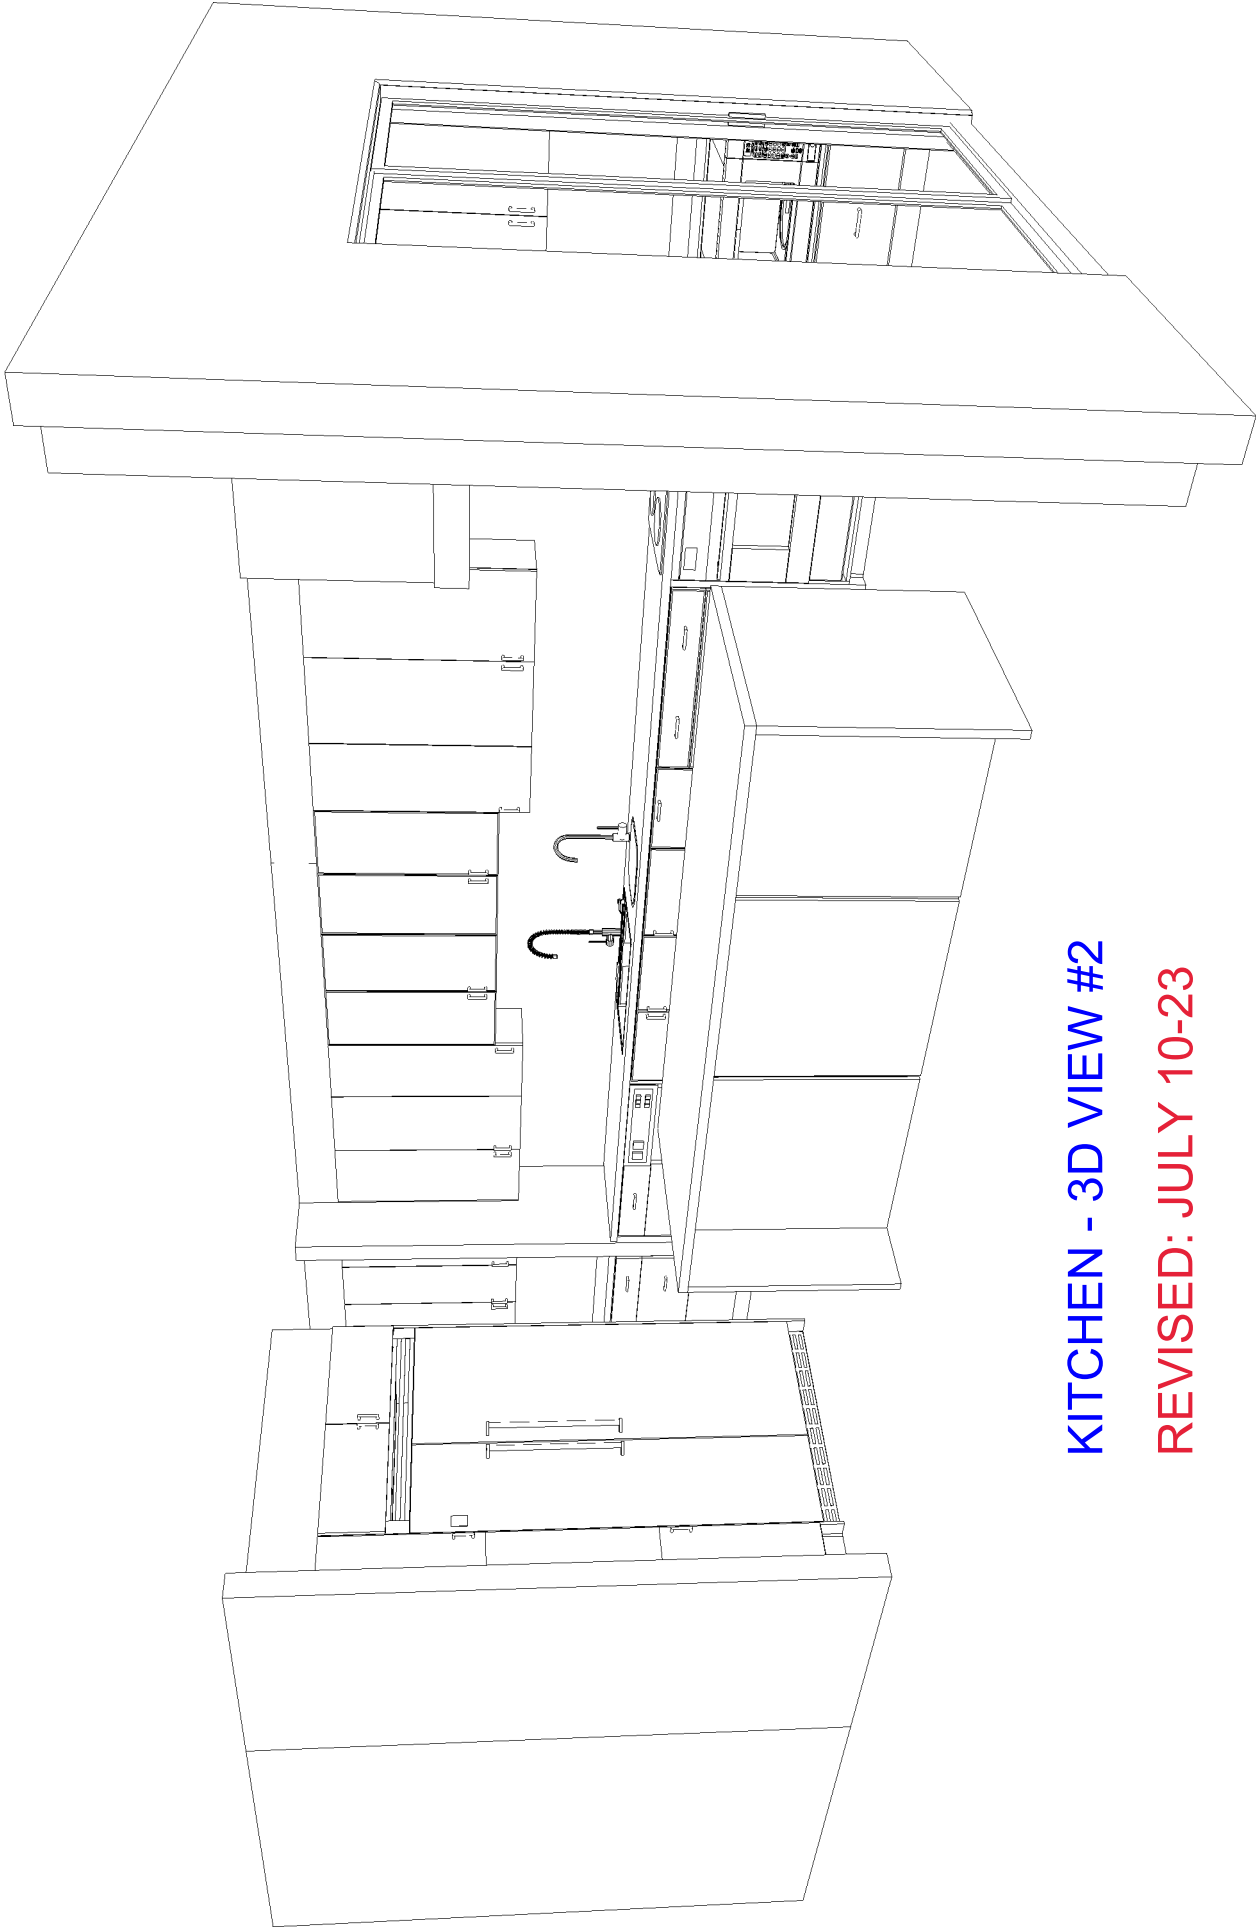

KITCHEN - 3D VIEW #2

REVISED: JULY 10-23


CUSTOMER APPROVAL

I have reviewed these drawings and understand the details of the design and the CARTIER KITCHENS specifications.

Signature _____

Date _____

Note: This drawing is an artistic interpretation of the general appearance of the design. It is not meant to be an exact rendition.		Designed: 2023-07-10 Printed: 2023-07-10	
		 	
DCR - #272 PWYS 2 -Kitchen - REVISION 4.kit		All	Drawing #: 1

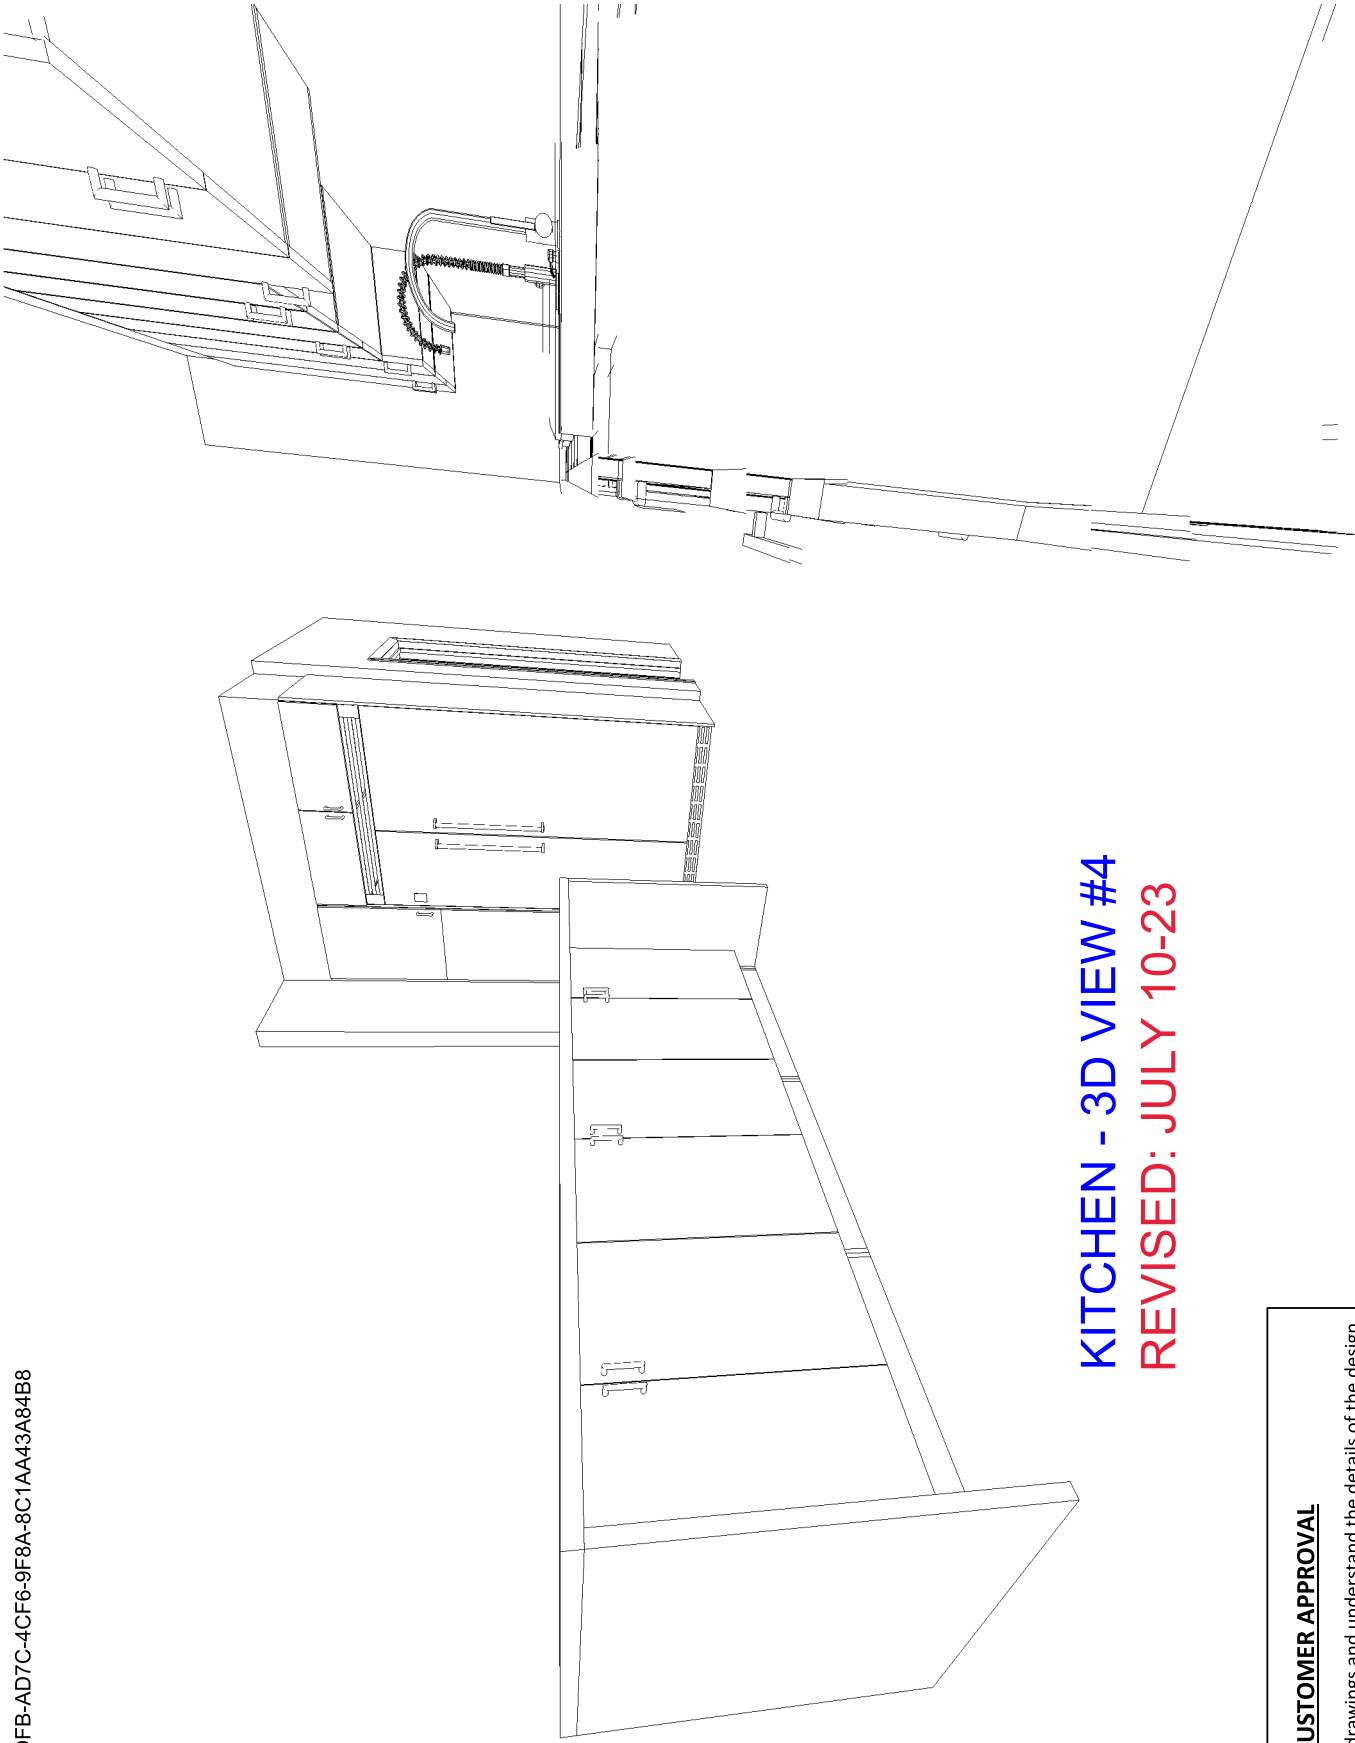

KITCHEN - 3D VIEW #4
REVISED: JULY 10-23

CUSTOMER APPROVAL

I have reviewed these drawings and understand the details of the design and the CARTIER KITCHENS specifications.

Signature _____

Date _____

Note: This drawing is an artistic interpretation of the general appearance of the design. It is not meant to be an exact rendition.

SPECTRUM
KITCHEN & BATH DESIGN


Designed: 2023-07-10
Printed: 2023-07-10

DS
UP

DCR - #272 PWYS 2 - Kitchen - REVISION 4.kit

All

Drawing #: 1

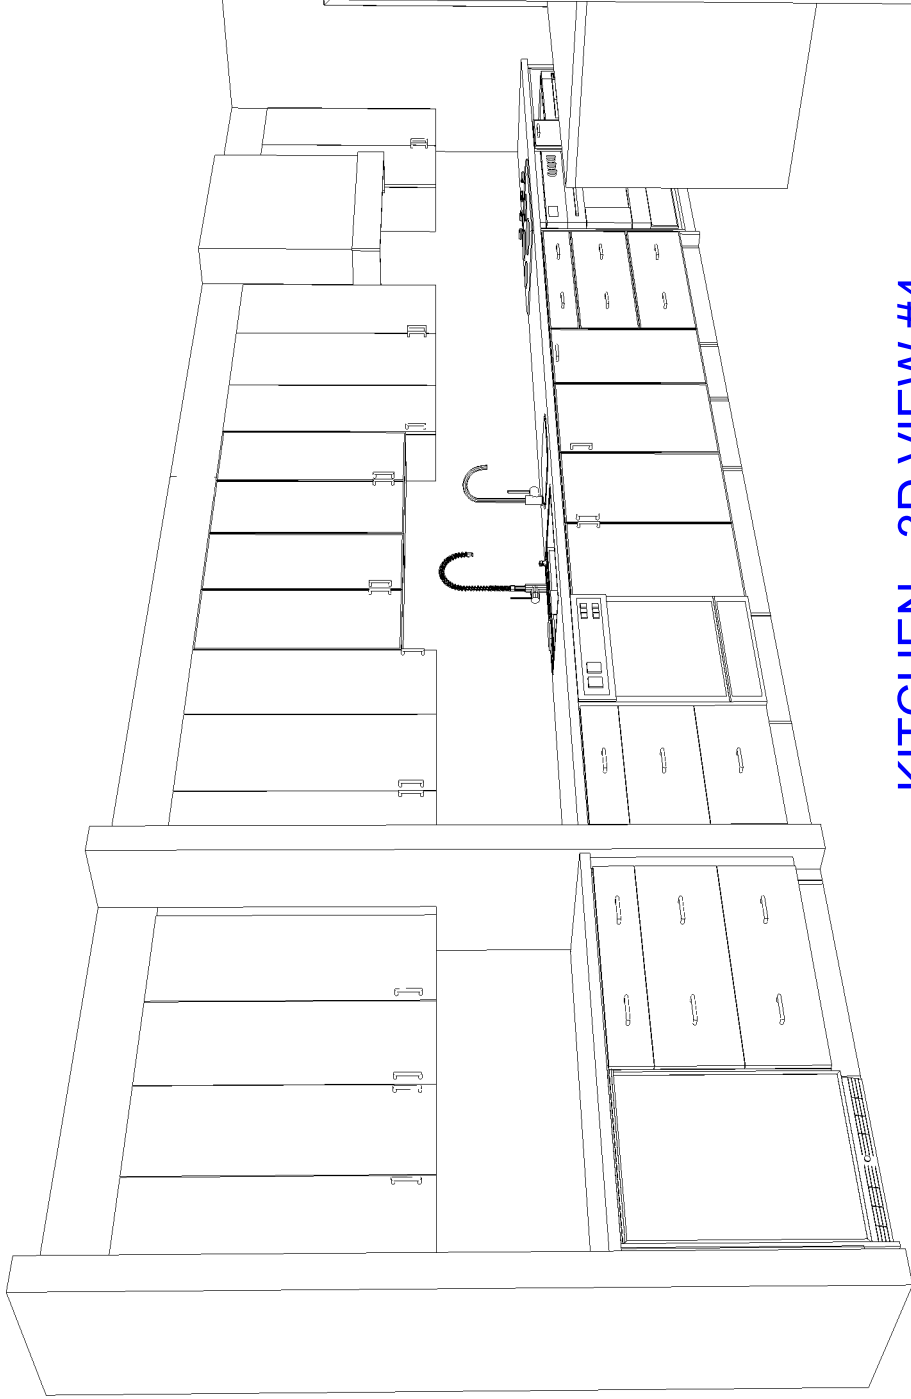

KITCHEN - 3D VIEW #4

REVISED: JULY 10-23

CUSTOMER APPROVAL

I have reviewed these drawings and understand the details of the design and the CARTIER KITCHENS specifications.

Signature _____

Date _____

Note: This drawing is an artistic interpretation of the general appearance of the design. It is not meant to be an exact rendition.



Designed: 2023-07-10
Printed: 2023-07-10

