



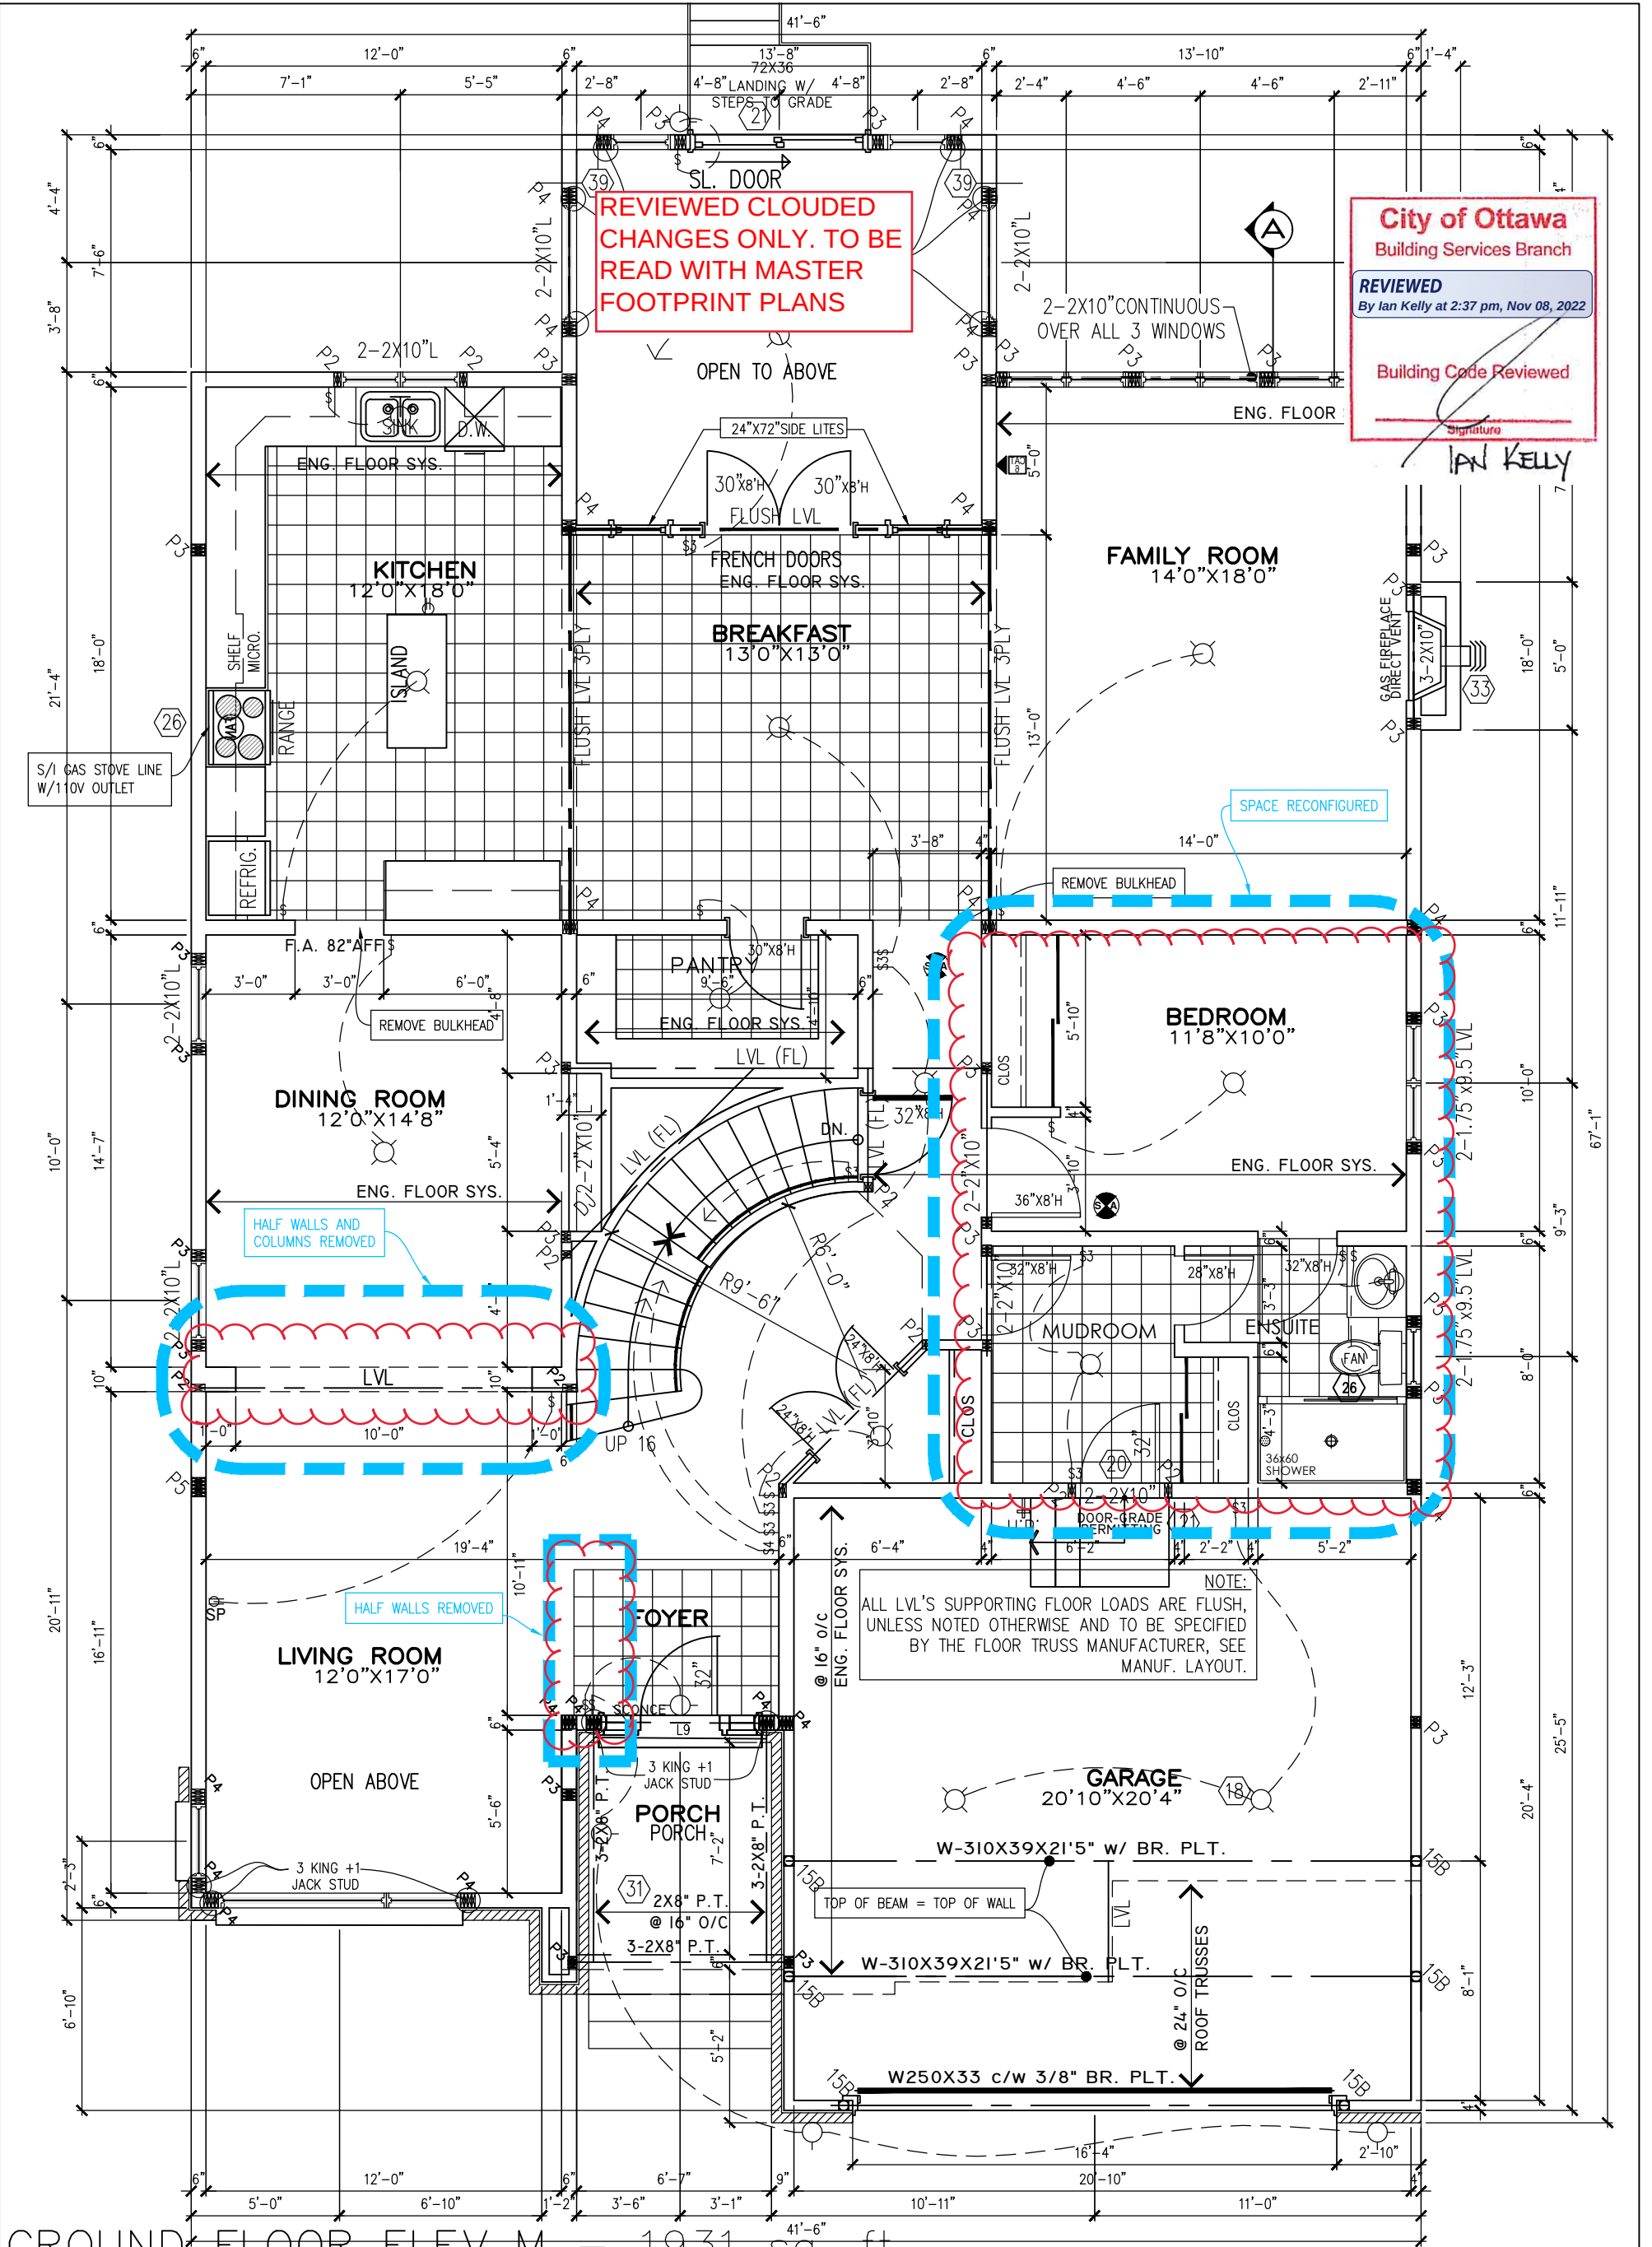

GROUND FLOOR ELEV M = 1931 sq. ft.

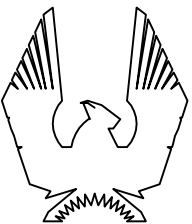

PHOENIX HOMES

ANNAPOLIS-2019-M

SITE:PATHWAYS PH2

LOT NUMBER:

276

CIVIC ADDRESS:
906 OMAGAKI WAY

3 BEP BLACKLINES

MAR-25-22 KE

2 STRUCTURAL REVIEW

FEB-12-19 SP

1 ELEVATION M CREATED

DEC-03-18 SP

No. Description
REVISIONS

Date By

file number: 509

drawn by: T.L.


date: DEC. 2012

scale: 3/16"=1'

sheet no:

D.C.L.-201

3M
9

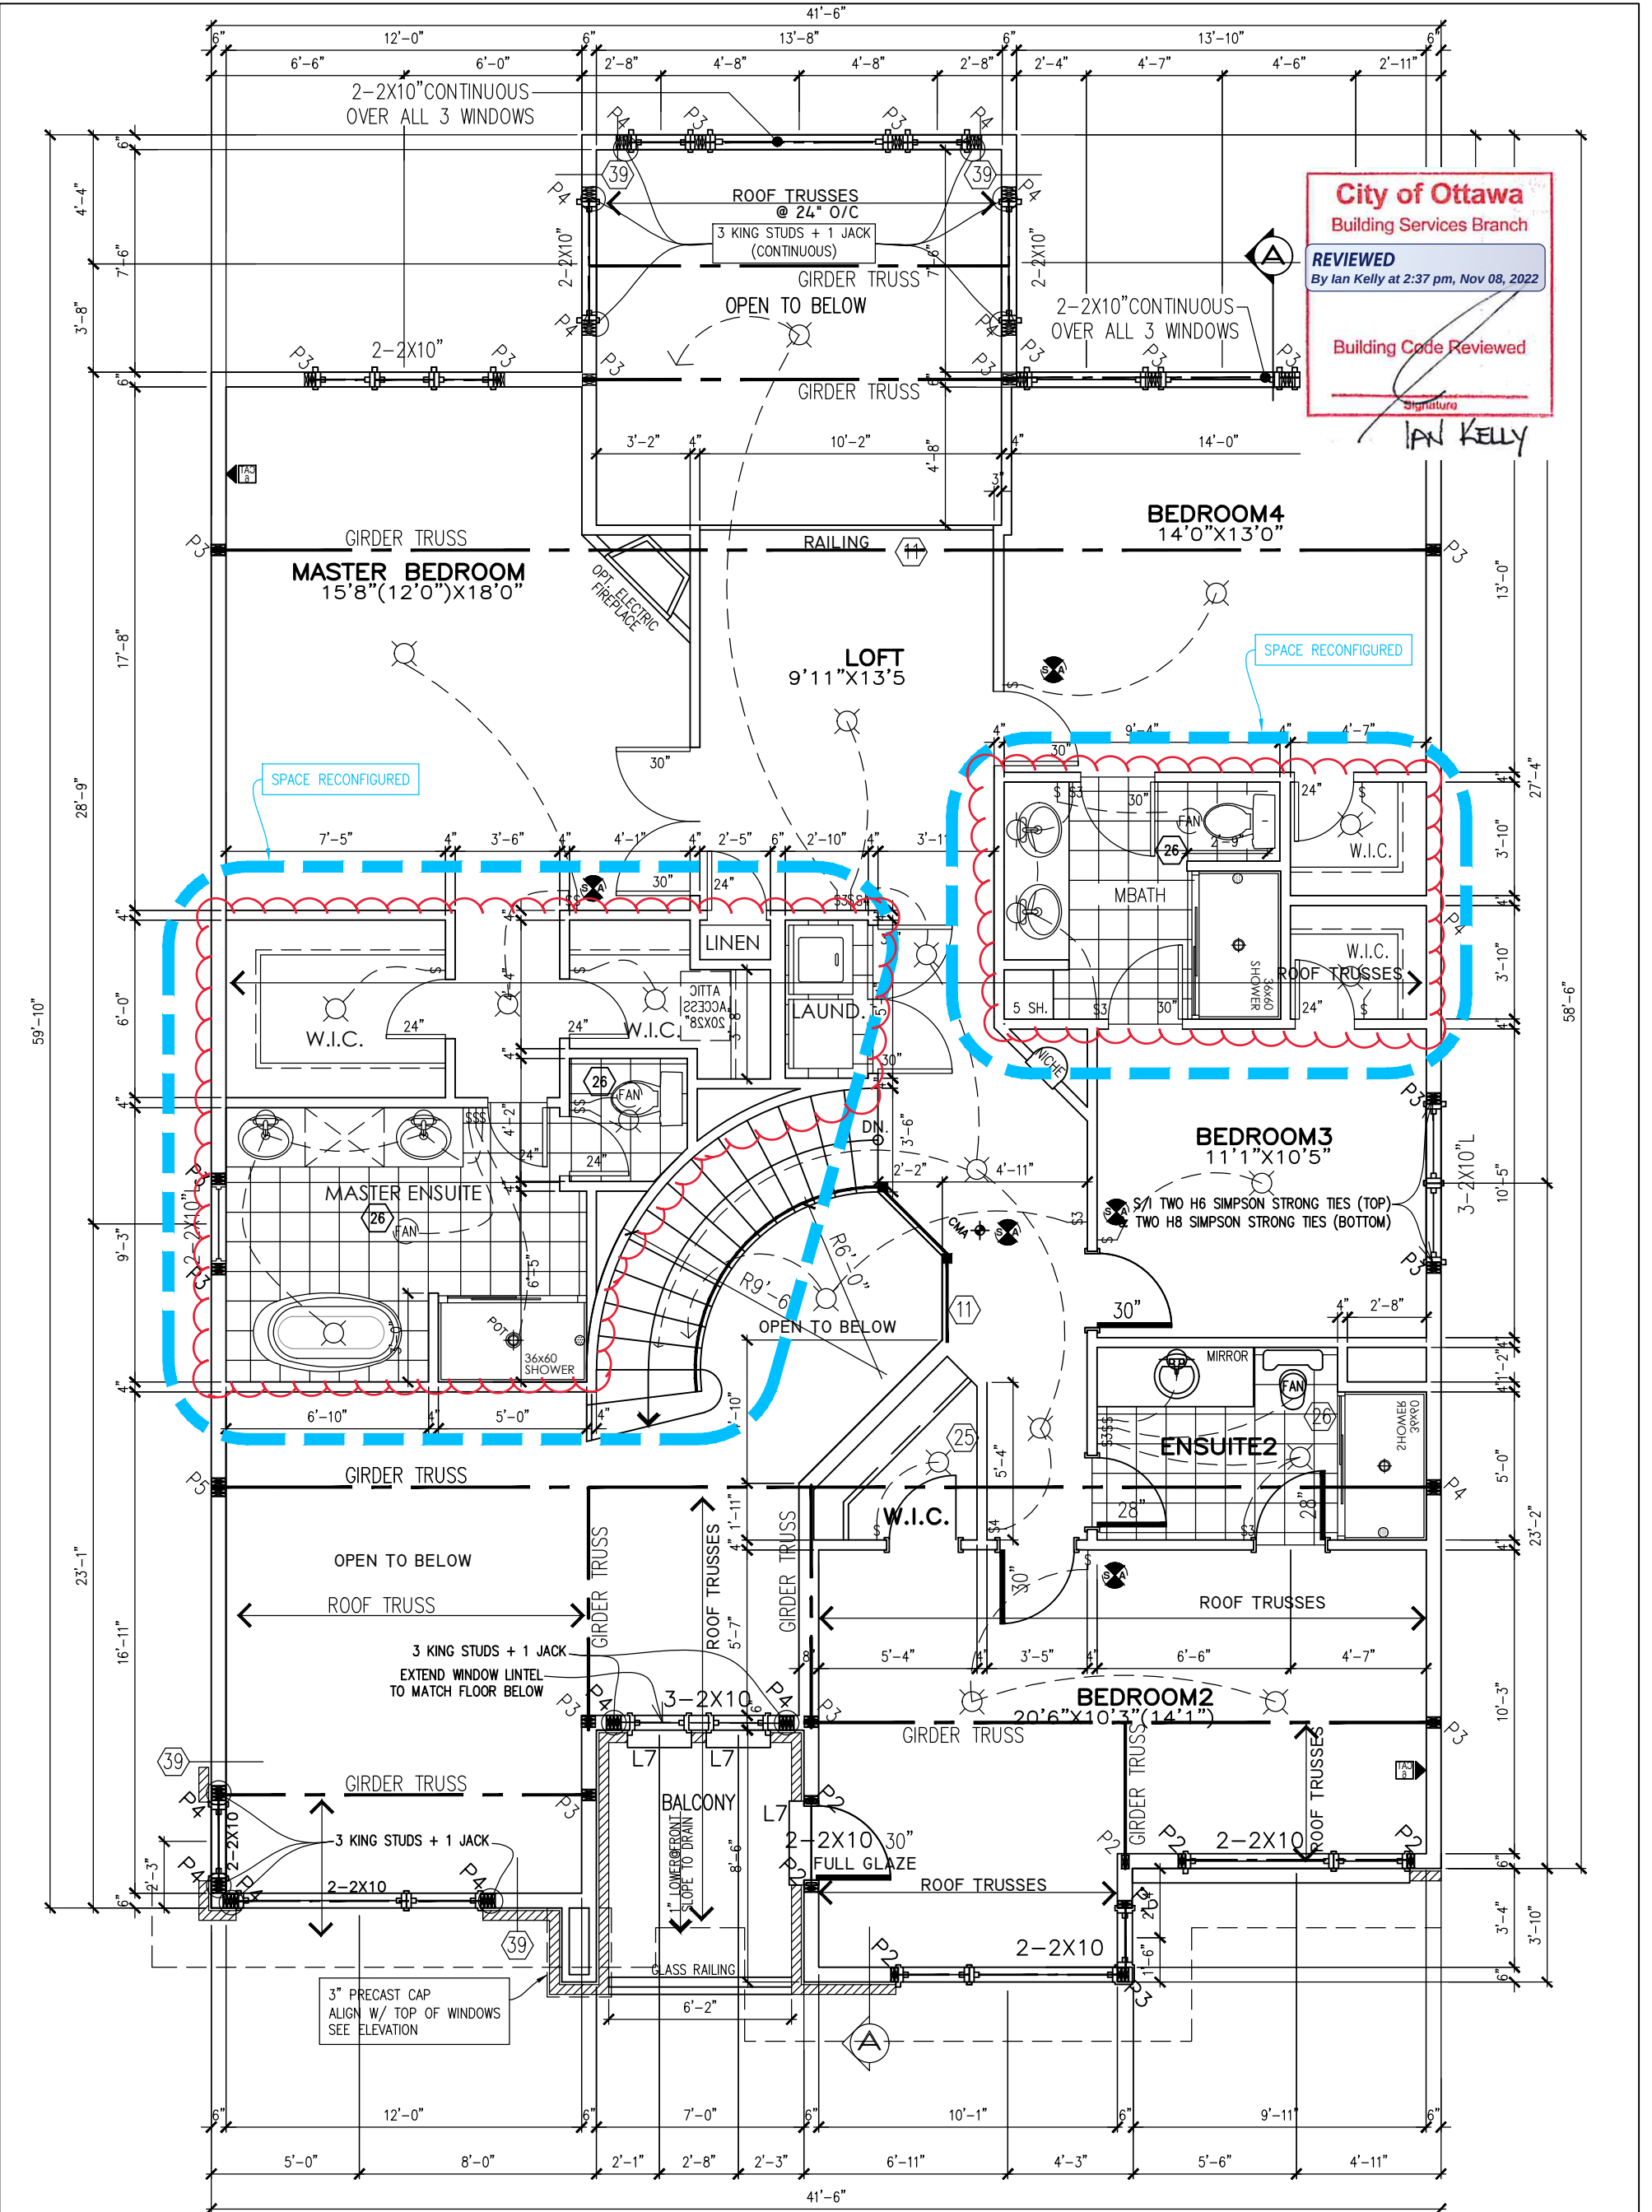

City of Ottawa
Building Services Branch
REVIEWED
By Ian Kelly at 2:37 pm, Nov 08, 2022
Building Code Reviewed
Signature
IAN KELLY

SECOND FLOOR PLAN ELEV. M – 1697 sq. ft.



ANNAPOLIS-2019-M

SITE:PATHWAYS PH2

LOT NUMBER: 276

CIVIC ADDRESS:
906 OMAGAKI WAY

3	BEP BLACKLINES	MAR-25-22	KE
2	STRUCTURAL REVIEW	FEB-12-19	SP
1	ELEVATION M CREATED	DEC-03-18	SP
No.	Description	Date	By
REVISIONS			

file number: 509

drawn by: T.L.

date: DEC. 2012

scale: 3/16"=1'

sheet no:
D.C.L.-201

4M
9