

DCR PHOENIX HOMES

BIRCHWOOD (B22)
KITCHEN / VANITIES
MOUNTING HEIGHT:



CABINETS - CARTIER LINE 1 & 2
HARDWARE - STD & 1ST UPGRADE
STD WHITE INTERIORS
METAL DRWR BOX
5 PCS - 5/8" KICK
2 PCS - C MOULD
1 PC - T MOULD
7 PCS - FLAT SHOE MOLDING

CUSTOMER APPROVAL

I have reviewed these drawings and understand the details of the design and the **ENTIRE CONTENTS** of this plan.

Signature _____


Date _____

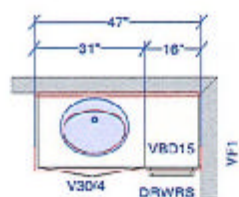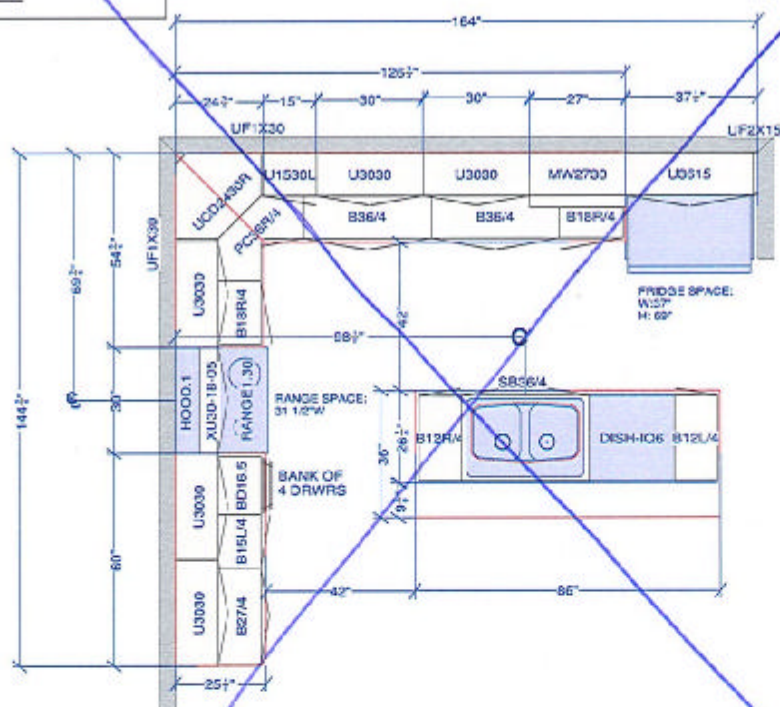

MAIN BATH



ENSUITE

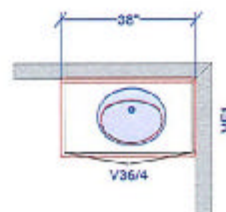

OPTIONAL LOFT
VANITY

All dimensions size designations given are subject to verification on job site and adjustment to fit job conditions.



This is an original design and must not be released or copied unless applicable fee has been paid or job order placed.

Designed: 2022-01-25
Printed: 2022-09-27


DCR-BIRCHWOOD-LEFT.kit

All


Drawing #: 1	No Scale.
--------------	-----------

DS BB SB


VANIITES - 3D VIEW

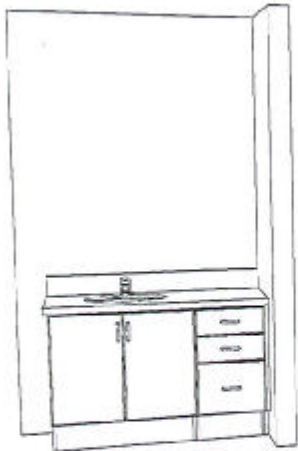

MAIN BATH

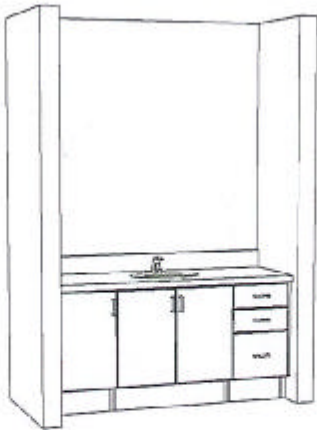

ENSUITE

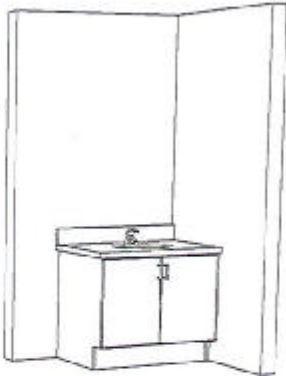

OPTIONAL
LOFT

CUSTOMER APPROVAL

I have reviewed these drawings and understand the details of the design and the CARTIER KITCHENS specifications.

Signature _____

Date _____

Note: This drawing is an artistic interpretation of the general appearance of the design. It is not meant to be an exact rendition.



Designed: 2022-01-26
Printed: 2022-09-27

DCR-BIRCHWOOD-LEFT.kit

All

Drawing #: 1

DS BB DS SB