


DCR PHOENIX HOMES


BIRCHWOOD (B22) LEFT
ALTERNATE KITCHEN
MOUNTING HEIGHT: ~~84~~ 96"

*INSTALLED 21" ABOVE COUNTER

CABINETS - CARTIER LINE 1 & 2
HARDWARE - STD & 1ST UPGRADE
STD WHITE INTERIORS
METAL DRWR BOX
5 PCS - 5/8" KICK
2 PCS - C MOULD
1 PC - T MOULD
7 PCS - FLAT SHOE MOLDING

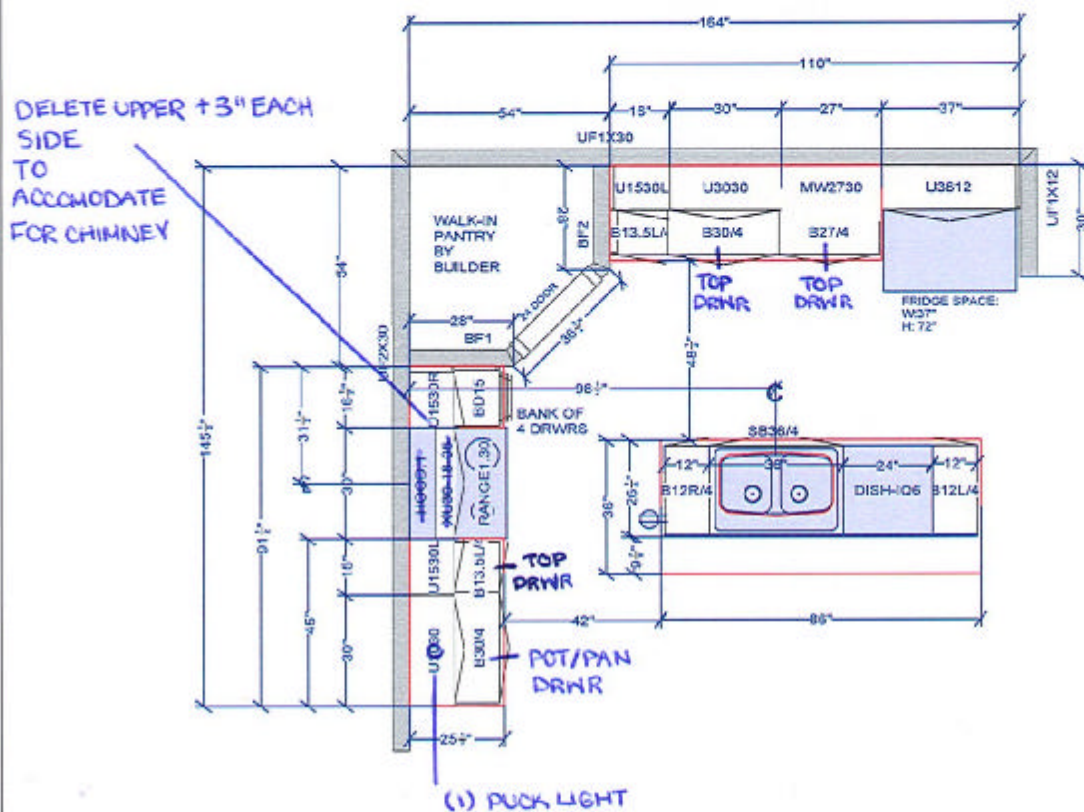

<u>CUSTOMER APPROVAL</u> I have reviewed these drawings and understand the details of the design and the Cabinet/Electrical specifications. Signature _____ Date _____	All dimensions, size designations given are subject to verification on job site and adjustment to fit job conditions.		This is an original design and must not be released or copied unless applicable fee has been paid or job order placed.	Designed: 5/18/2023 Printed: 5/23/2023
DCR-BIRCHWOOD - Alt Kitchen with Walk-in Pantry-LEFT			All	Drawing #: 1 No Scale

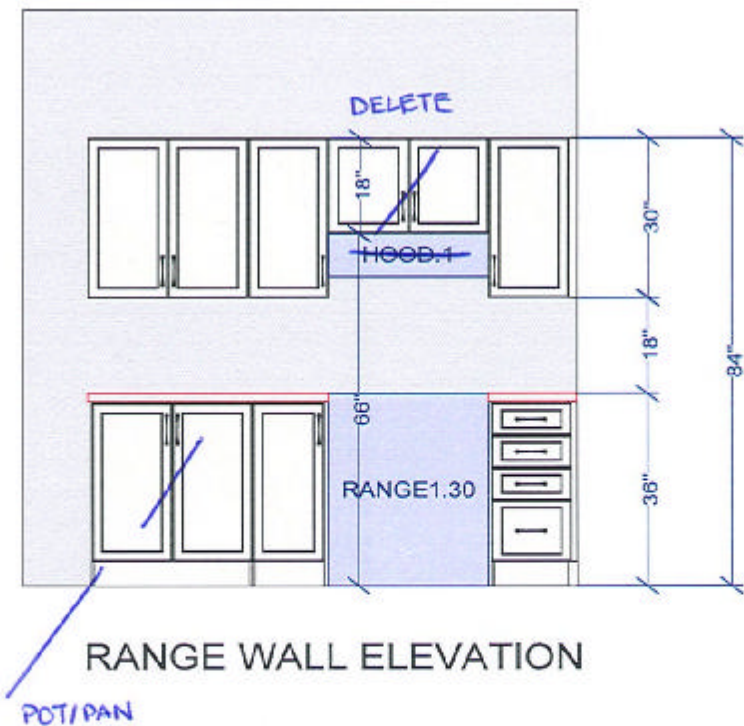

CUSTOMER APPROVAL
I have reviewed these drawings and understand the details of the design and the Contractor's responsibilities.
Signature _____
Date _____


All dimensions, size designations given are subject to verification on job site and adjustment to fit job conditions.



This is an original design and must not be released or copied unless applicable fee has been paid or job order placed.

Digned: 5/18/2023
Printed: 5/23/2023

DS BB DS SB

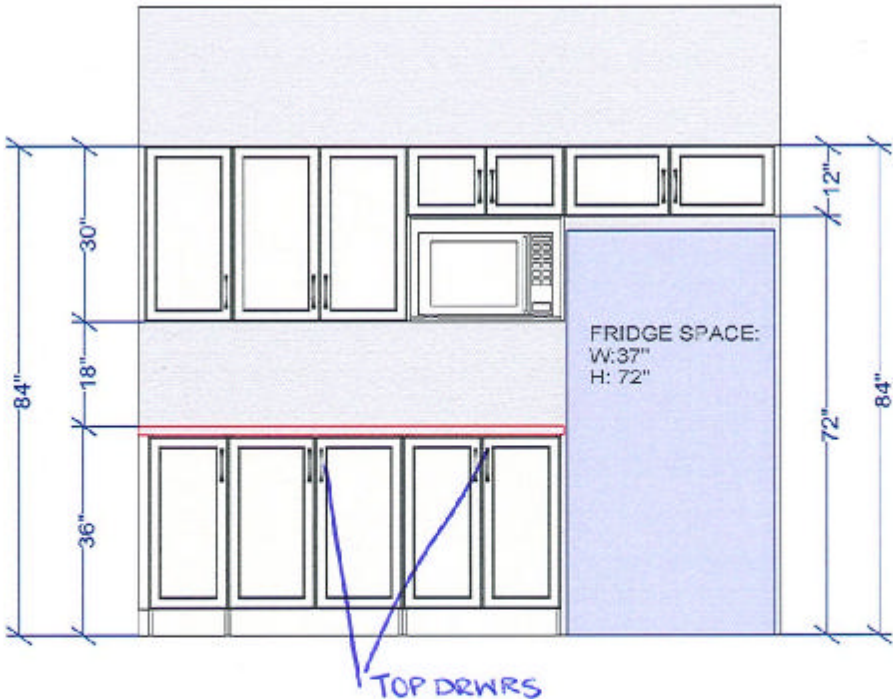

FRIDGE WALL ELEVATION

CUSTOMER APPROVAL
I have reviewed these drawings and understand the details of the design and the fabricator's specifications.

Signature: _____
Date: _____


All dimensions, size designations given are subject to verification on job site and adjustment to fit job conditions.



This is an original design and must not be released or copied unless applicable fee has been paid or job order placed.

Designed: 5/18/2023
Printed: 5/23/2023

DS BB DS SB

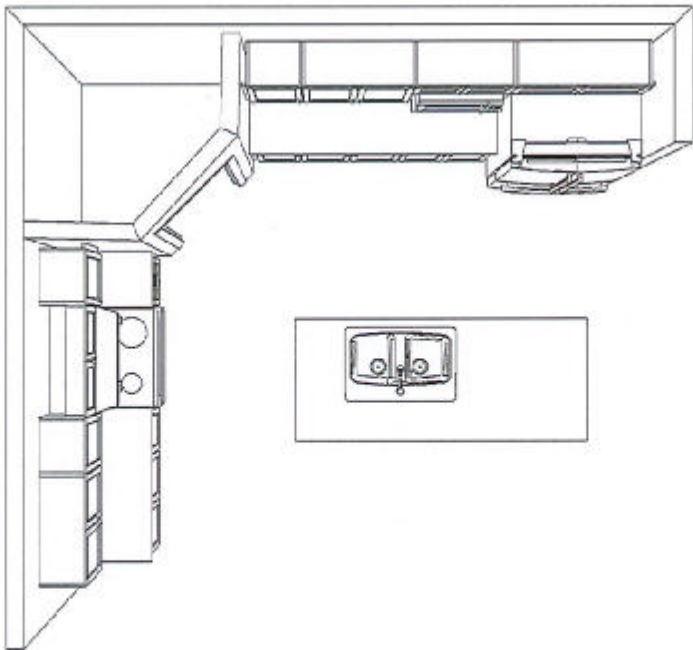

KITCHEN TOP VIEW


CUSTOMER APPROVAL I have reviewed these drawings and understand the details of the design and the Order Kitchen specifications. Signature _____ Date _____

Note: This drawing is an artistic interpretation of the general appearance of the design. It is not meant to be an exact rendition.



Designed: 5/18/2023
Printed: 5/23/2023

DS BB	DS SB
----------	----------

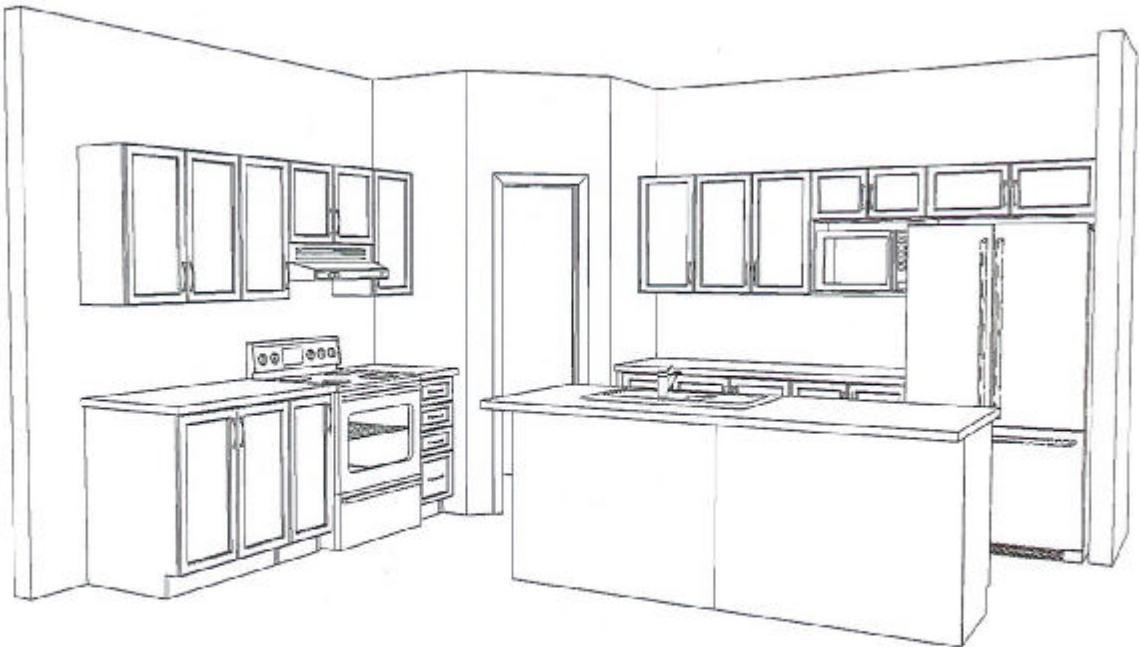

KITCHEN 3D VIEW #1


<u>CUSTOMER APPROVAL</u> I have reviewed these drawings and understand the details of the design and the Carter Kitchen specifications. Signature: _____ Date: _____
--

Note: This drawing is an artistic interpretation of the general appearance of the design. It is not meant to be an exact rendition.



Designed: 5/18/2023
Printed: 5/23/2023

DS BB	DS SB
----------	----------

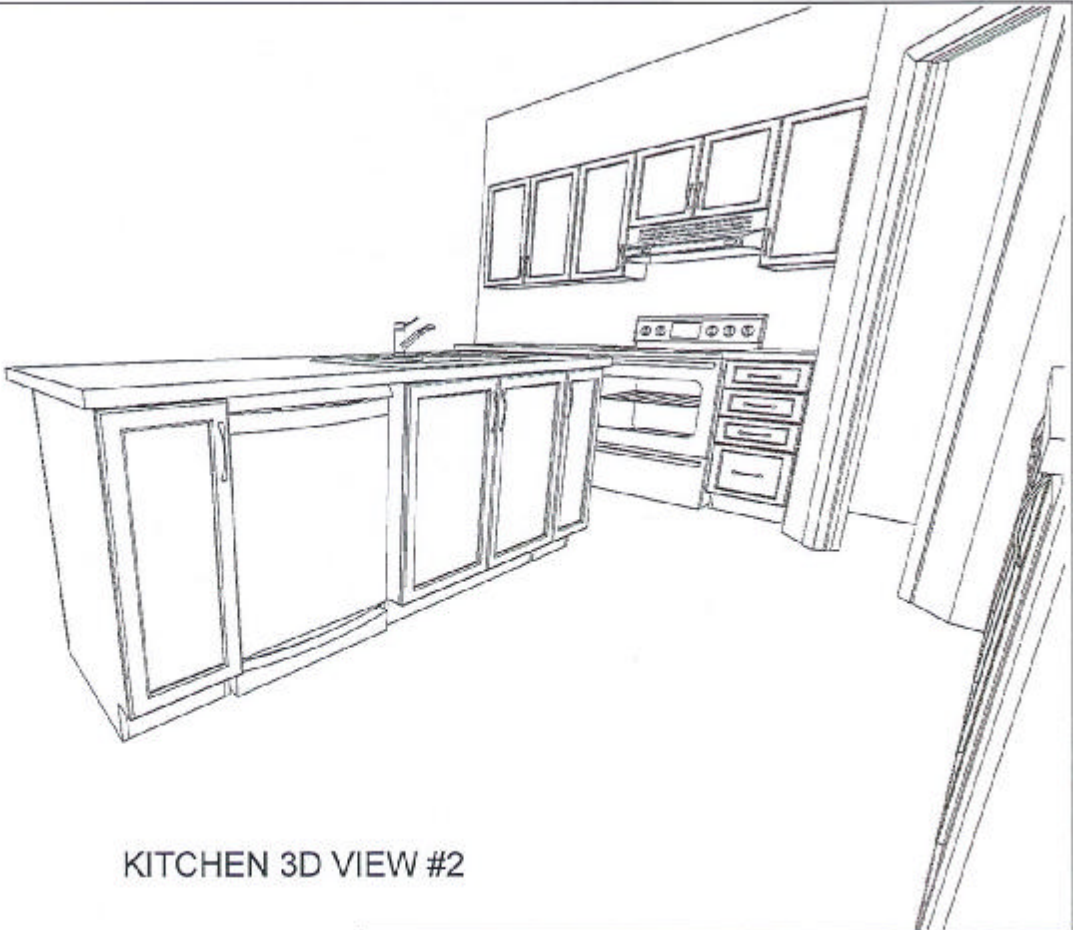

KITCHEN 3D VIEW #2

CUSTOMER APPROVAL	
I have reviewed these drawings and understand the details of the design and the Carter Kitchens specifications.	
Signature _____	
Date _____	

Note: This drawing is an artistic interpretation of the general appearance of the design. It is not meant to be an exact rendition.



Designed: 5/16/2023
Printed: 5/23/2023

DS BB	DS SB
----------	----------