



LOT #279  
PATHWAYS 2  
PLATINA (512)  
VANITIES


CABINETS -  
HARDWARE -  
STD WHITE INTERIORS  
METAL DRWR BOX  
5 PCS - 5/8" KICK  
5PCS - FLAT MOULDING

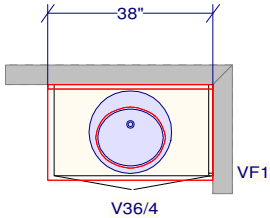


BASEMENT

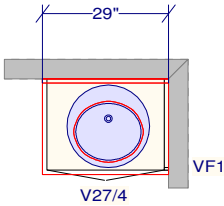

POWDER ROOM

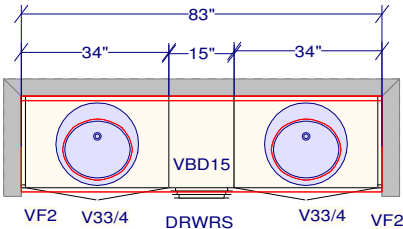


MAIN (SHARED BATH)

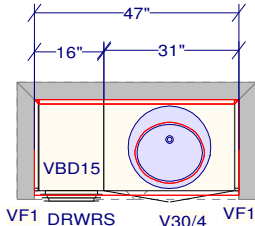

2ND. ENSUITE

PRIMARY ENSUITE

REVISED: JUNE 13-22

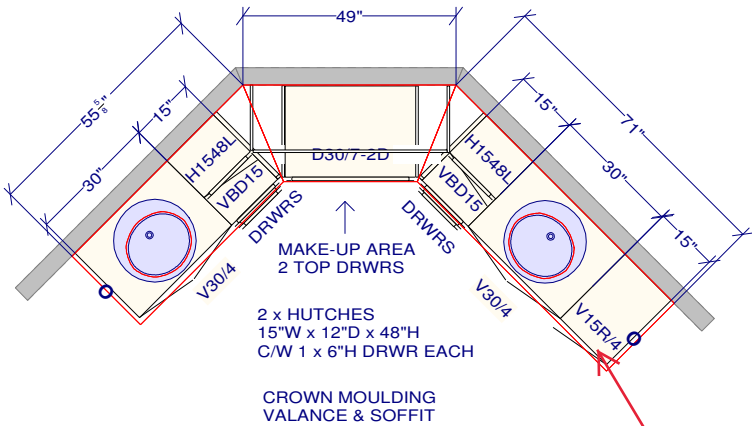

Add bank of drawers

DS  
EST

DS  
B.M


12/9/2022 | 12:07 PM PST

All dimensions, size designations given are subject to verification on job site and adjustment to fit job conditions.



This is an original design and must not be released or copied unless applicable fee has been paid or job order placed.

Designed: 2022-06-13  
Printed: 2022-06-13

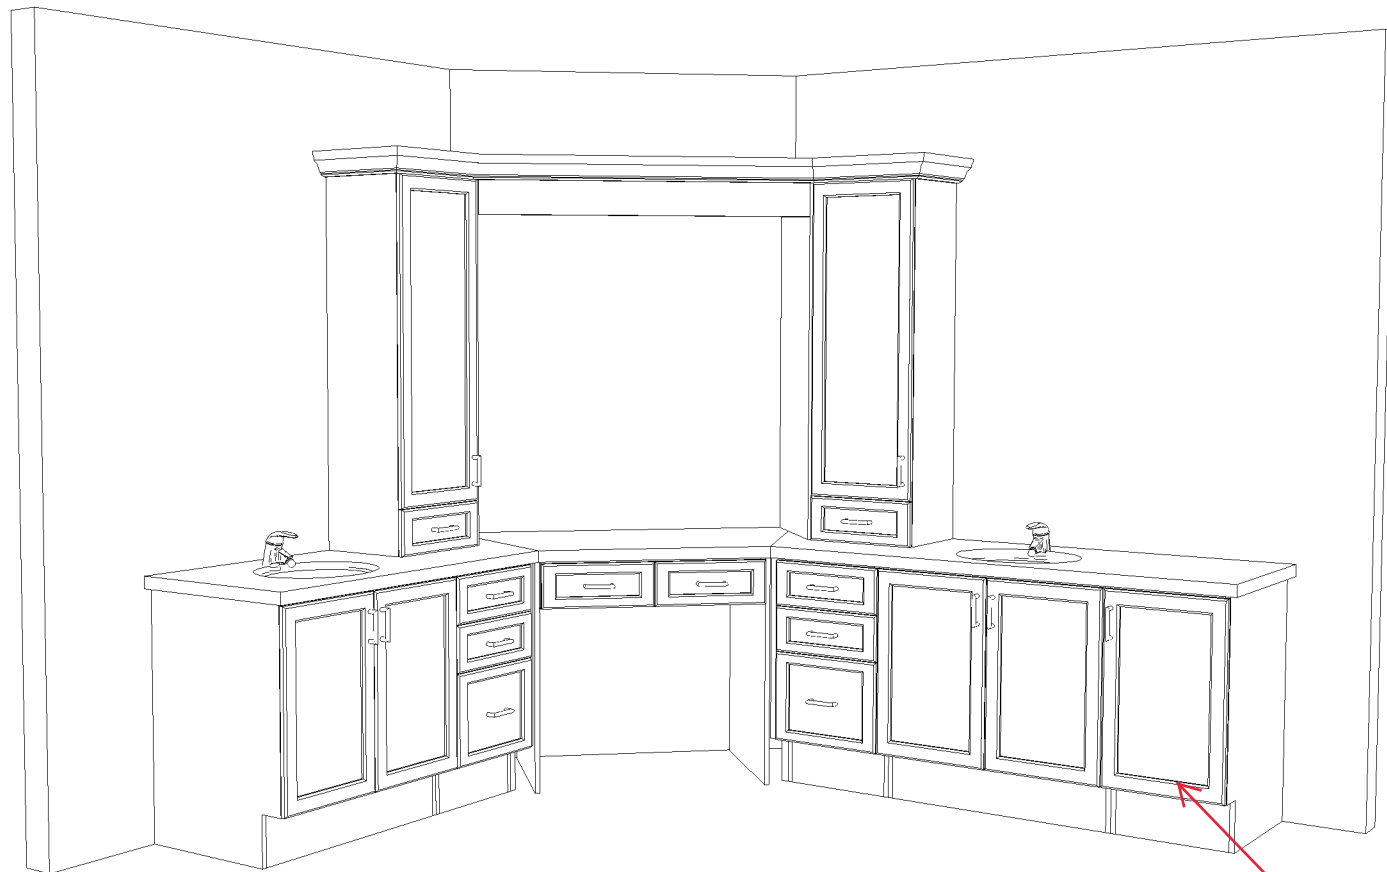

## PRIMARY ENSUITE - 3D VIEW

REVISED: JUNE 13-22

Add bank of drawers

### CUSTOMER APPROVAL

I have reviewed these drawings and understand the details of the design and the Carter Kitchens specifications.

Signature [Signature]

Date 12/9/2022 | 12:07 PM PST

Note: This drawing is an artistic interpretation of the general appearance of the design. It is not meant to be an exact rendition.



Designed: 2022-06-13  
Printed: 2022-06-13