


DCR PHOENIX HOMES


LO #91
DIAMNDVIEW ESTATES 3
NEWINGTON
(GARAGE RIGHT)
OPTIONAL CHEF'S KITCHEN

MOUNTING HT: 96
FILL TO CEILING WITH
1" MOULDING, FURRING PNALE
& CEILING CROWN
LIGHT VALANCE

CABINETS -
HARDWARE -
STANDARD WHITE INTERIOR
METAL DRAWER BOX
4 PCS - 5/8" KICK - FIN. BOTH ENDS
2 PCS - 90 DEG. CORNER MOULD
1 PCS - T-MOULD
5 PCS - FLAT MOULDING

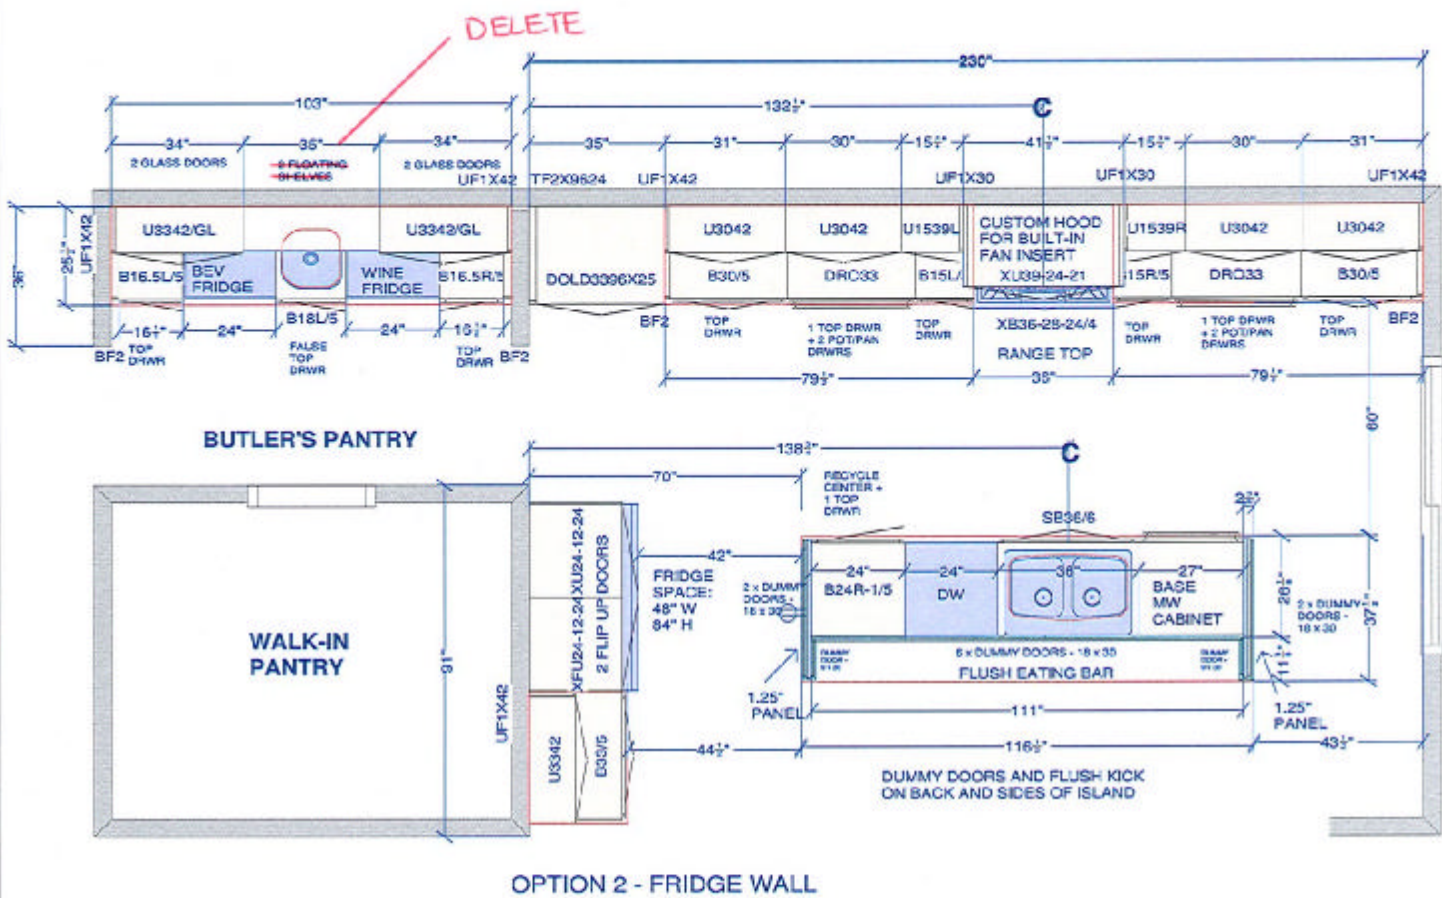

REPLACED W/ STD DOUBLE DOOR CABINET
HEIGHT DECREASED BY APPROX 6"

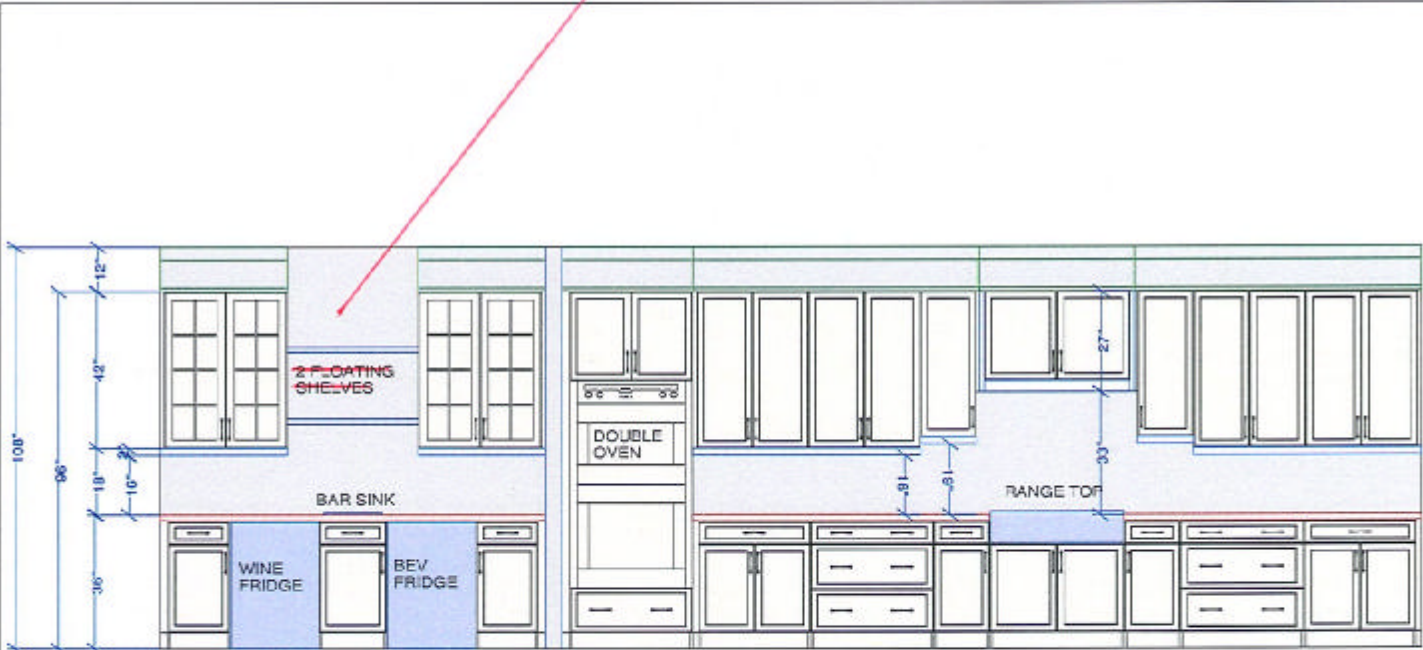

BUTLER'S PANTRY ELEVATION

OVEN / RANGE TOP ELEVATION

CUSTOMER APPROVAL

I have reviewed these drawings and understand the details of the design and the CARTIER CITCHENS specifications.

Signature _____


Date _____

All dimensions ,size designations given are subject to verification on job site and adjustment to fit job conditions.

This is an original design and must not be released or copied unless applicable fee has been paid or job order placed.

Designed: 2023-05-03
Printed: 2023-05-03



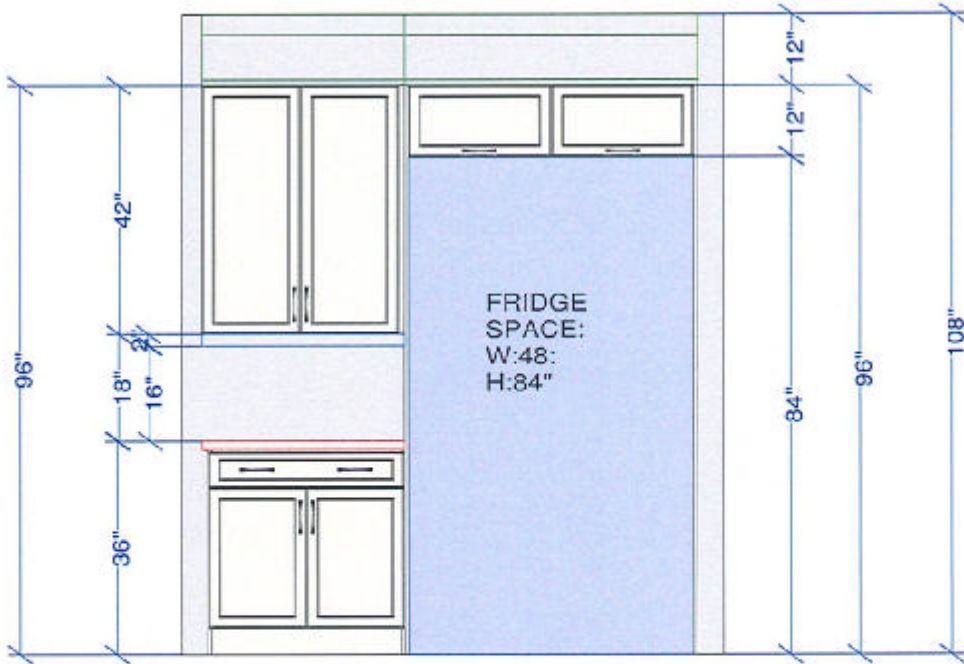

CUSTOMER APPROVAL


I have reviewed these drawings and understand the details of the design and the CARTIER KITCHENS specifications.

Signature _____

Date _____

FRIDGE WALL ELVATION
OPTION 2

All dimensions _size designations given are subject to verification on job site and adjustment to fit job conditions.		This is an original design and must not be released or copied unless applicable fee has been paid or job order placed.	Designed: 2023-05-03 Printed: 2023-05-03	
			DCR #91 DV3 - Kitchen - Option 2 - fridge wall.kit	Drawing #: 1 No Scale.

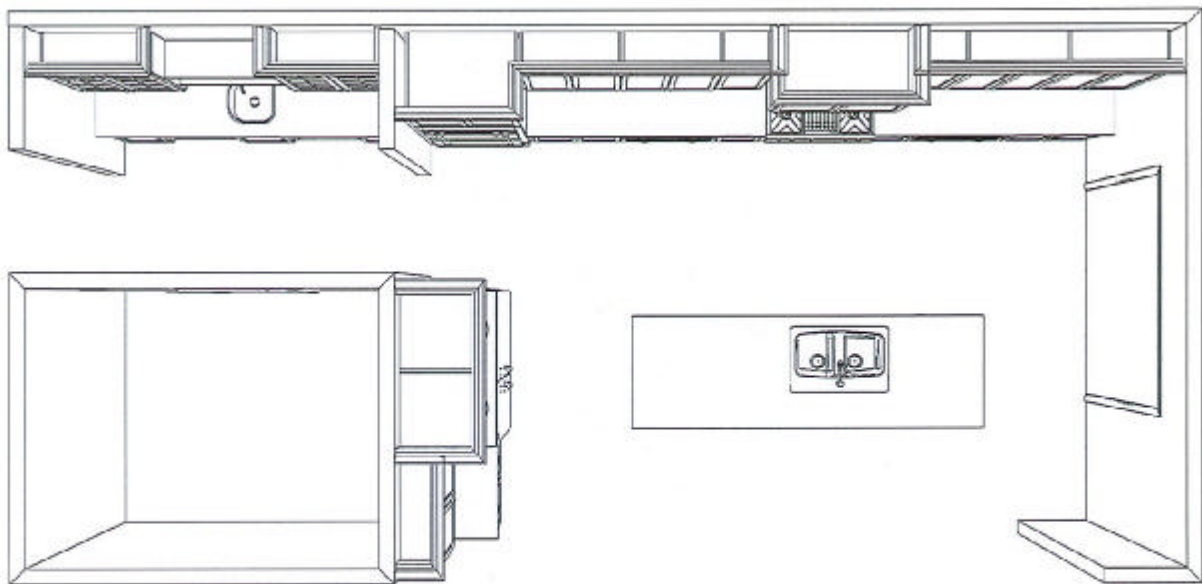


OPTION 2 - FRIDGE WALL
KITCEHN - TOP VIEW

CUSTOMER APPROVAL I have reviewed these drawings and understand the details of the design and the CAUTION KITCHENS specifications. Signature _____ Date _____
--

Note: This drawing is an artistic interpretation of the general appearance of the design. It is not meant to be an exact rendition.		Designed: 2023-05-03 Printed: 2023-05-03
		DCR #91 DV3 - Kitchen - Option 2 - fridge wall.kit All Drawing #: 1



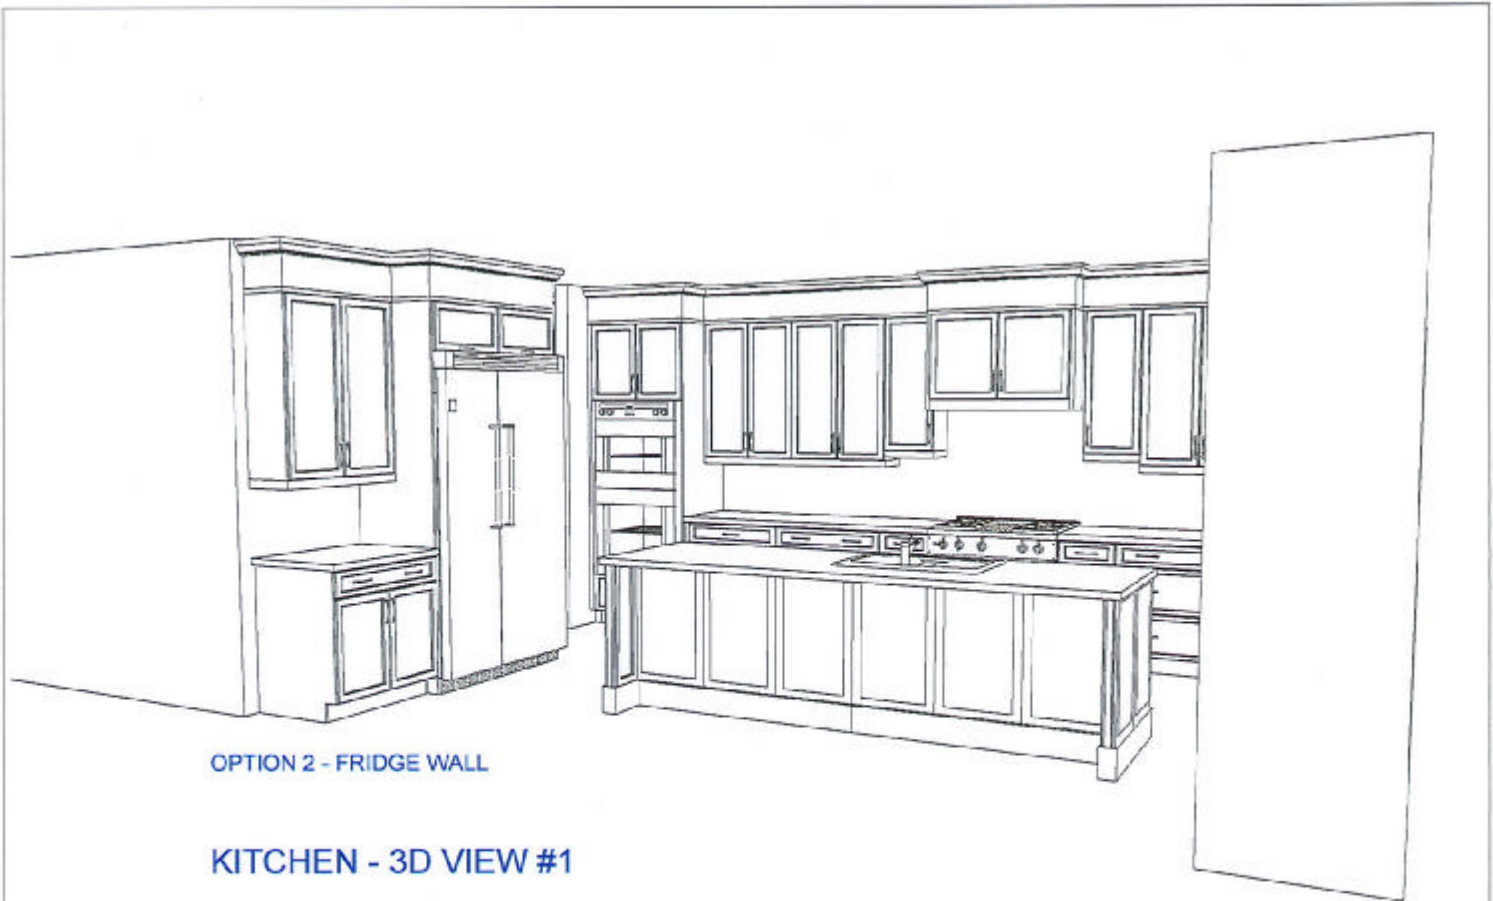

OPTION 2 - FRIDGE WALL

KITCHEN - 3D VIEW #1

CUSTOMER APPROVAL	
I have reviewed these drawings and understand the details of the design and the CARTIER KITCHENS specifications.	
Signature _____	
Date _____	

Note: This drawing is an artistic interpretation of the general appearance of the design. It is not meant to be an exact rendition.	Designed: 2023-05-03 Printed: 2023-05-03	
	DCR #91 DV3 - Kitchen - Option 2 - All	Drawing #: 1



OPTION 2 - FRIDGE WALL
KITCHEN - 3D VIEW #2

CUSTOMER APPROVAL I have reviewed these drawings and understand the details of the design and the CARTIER KITCHENS specifications. Signature _____ Date _____
--

Note: This drawing is an artistic interpretation of the general appearance of the design. It is not meant to be an exact rendition.	Designed: 2023-05-03 Printed: 2023-05-03
DCR #91 DV3 - Kitchen - Option 2 - All Drawing #: 1	






OPTION 2 - FRIDGE WALL
KITCHEN - 3D VIEW #3

CUSTOMER APPROVAL	
I have reviewed these drawings and understand the details of the design and the CARTER KITCHENS specifications.	
Signature	_____
Date	_____

Note: This drawing is an artistic interpretation of the general appearance of the design. It is not meant to be an exact rendition.		Designed: 2023-05-03
		Printed: 2023-05-03
DCR #91 DV3 - Kitchen - Option 2 - fridge wall.kit	All	Drawing #: 1

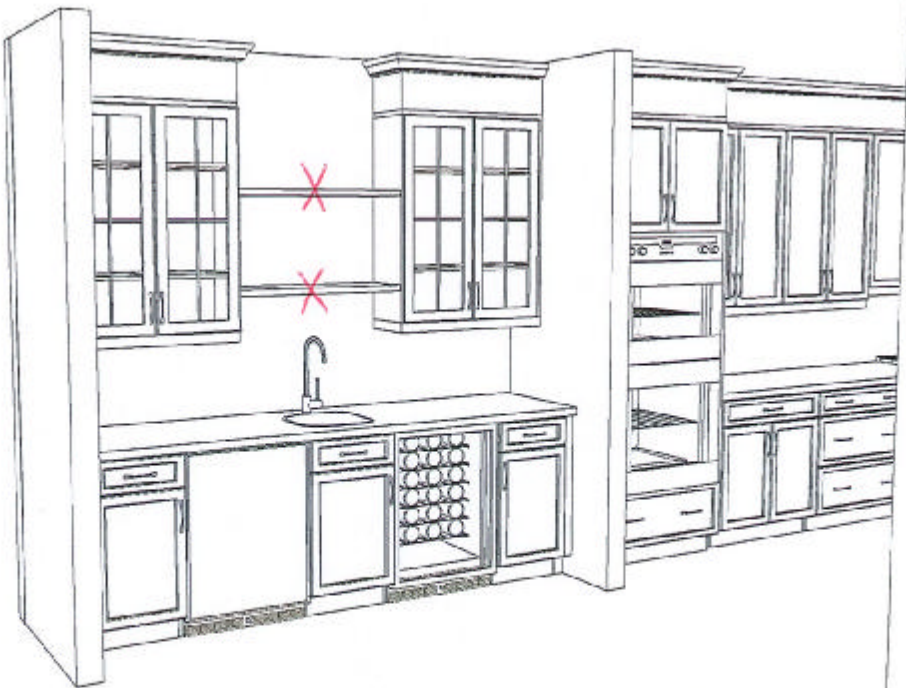

BUTLER'S PANTRY - 3D VIEW # 4

CUSTOMER APPROVAL

I have reviewed these drawings and understand the details of the design and the CARTER KITCHENS specifications.

Signature _____

Date _____

Note: This drawing is an artistic interpretation of the general appearance of the design. It is not meant to be an exact rendition.

Designed: 2023-05-03
Printed: 2023-05-03

