

DCR PHOENIX HOMES

MODEL - MADISON (43-10)

KITCHEN / VANITIES

MOUNTING HEIGHT - 84

CABNETS-

HARDWARE -

STANDARD WHITE INTERIOR

METAL DRAWER BOX

4 PCS - 5/8" KICK - FIN, BOTH ENDS

2 PCS - LOOSE FILLER - 6 x 96

1 PCS - 90 DEG. CORNER MOULD


1 PCS - T-MOULD

5 PCS - FLAT MOULD


DELETE UPPER
TO ACCOMMODATE
CHIMNEY HOOD

CHANGED TO
(2) 24" BASE
CABINETS


* SOFT CLOSE
DOORS & DRAWERS

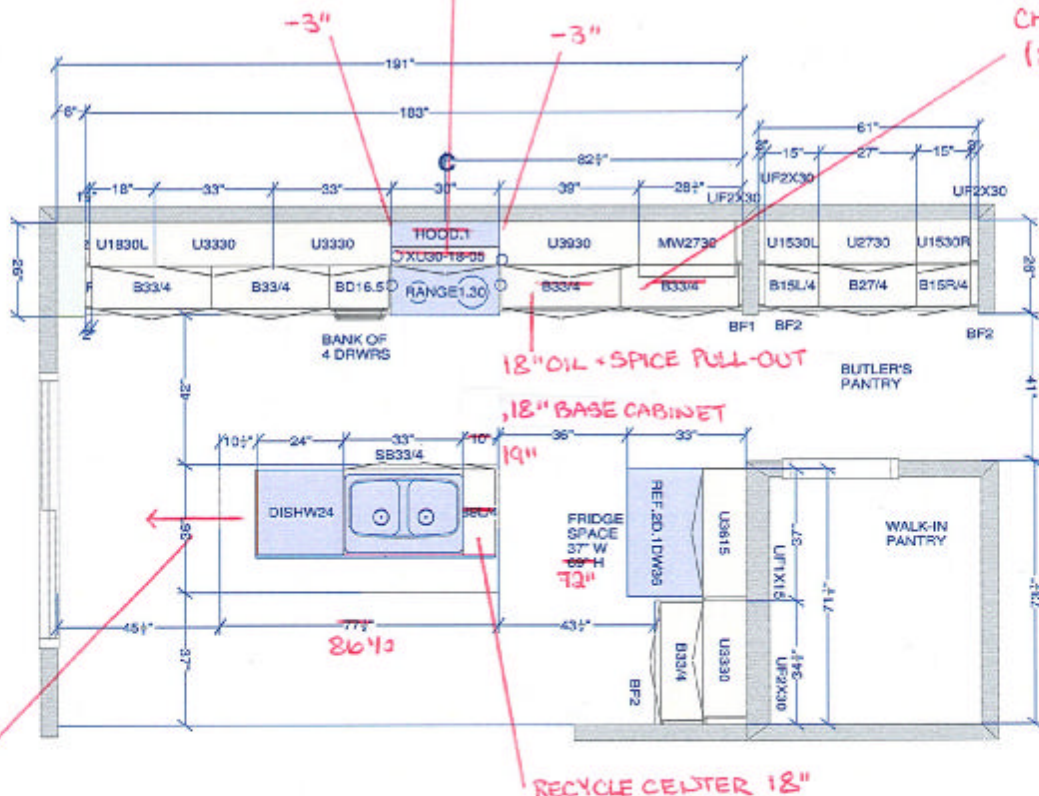

ISLAND SHIFTED
TOWARD PATIO DOOR
BY APPROX 10"

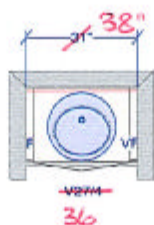


~~POWDER ROOM~~
BEDROOM #5
ENSUITE

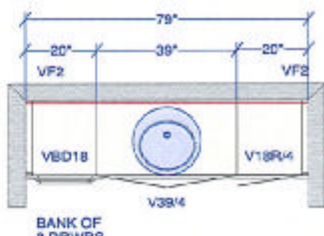

MAIN BATH

NOTE: 4 BDRM+LOFT - VANITY REVERSED

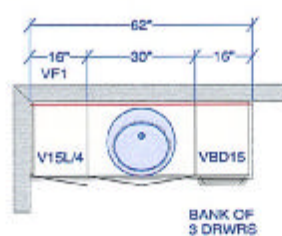

MASTER ENSUITE

NOTES: BDRM+LOET - VANITY REVERSED

All dimensions & size designations given are subject to verification on job site and adjustment to fit job conditions.

SPECTRUM KITCHEN and BATH
DESIGN

DCR - Madison (43-10) Kitchen kit




This is an original design and must not be released or copied unless applicable fee has been paid or job order placed.

DRAWN BY: LORI DISAVERIO, B.I.D.


Designed: 2020-01-15
Printed: 2020-01-15

All	Drawing #: 1	No Scale.
-----	--------------	-----------

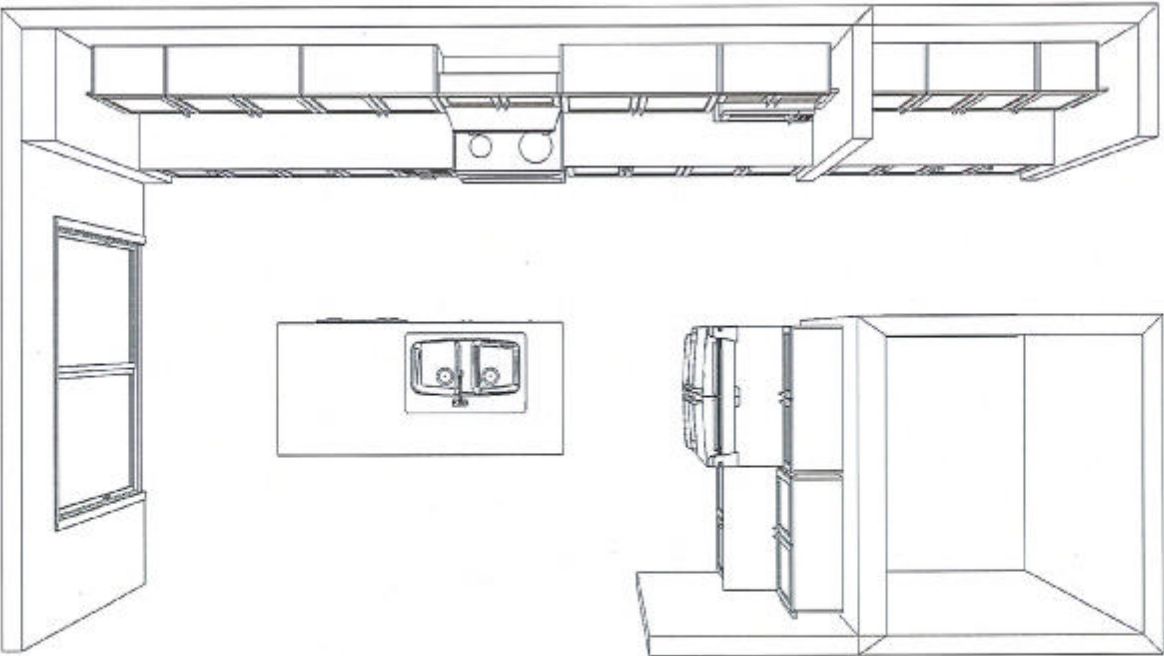


KITCHEN - TOP VIEW

Note: This drawing is an artistic interpretation of the general appearance of the design. It is not meant to be an exact rendition.		Designed: 1/15/2020 Printed: 1/16/2020	
		DCR - Madison (43-10) Kitchen	Drawing #: 1

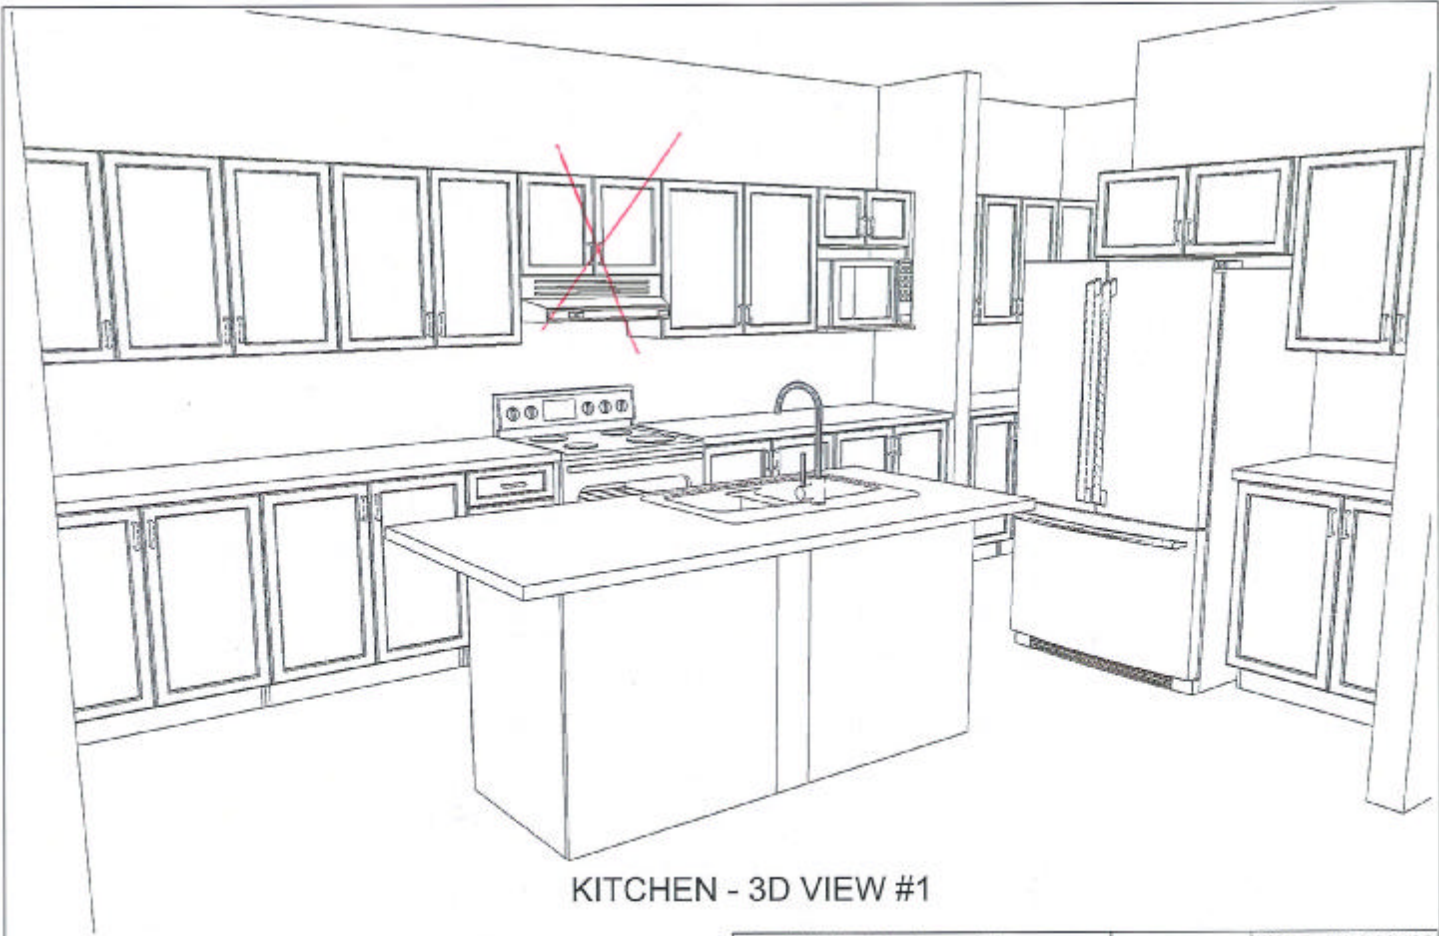


KITCHEN - 3D VIEW #1

Note: This drawing is an artistic interpretation of the general appearance of the design. It is not meant to be an exact rendition.		Designed: 1/15/2020 Printed: 1/16/2020	
		DCR - Madison (43-10) Kitchen	Drawing #: 1

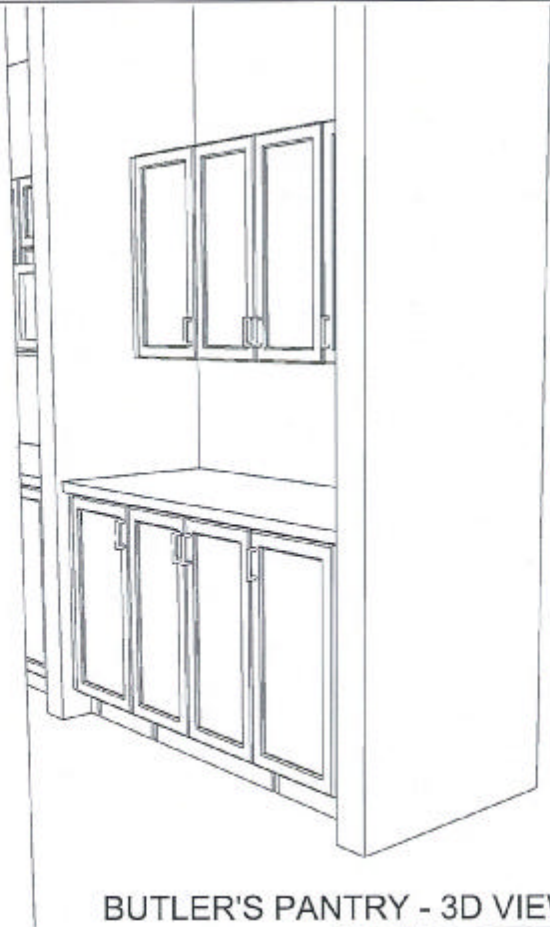

BUTLER'S PANTRY - 3D VIEW #3


Note: This drawing is an artistic interpretation of the general appearance of the design. It is not meant to be an exact rendition.		Designed: 1/15/2020 Printed: 1/16/2020	
		DCR - Madison (43-10) Kitchen	Drawing #: 1

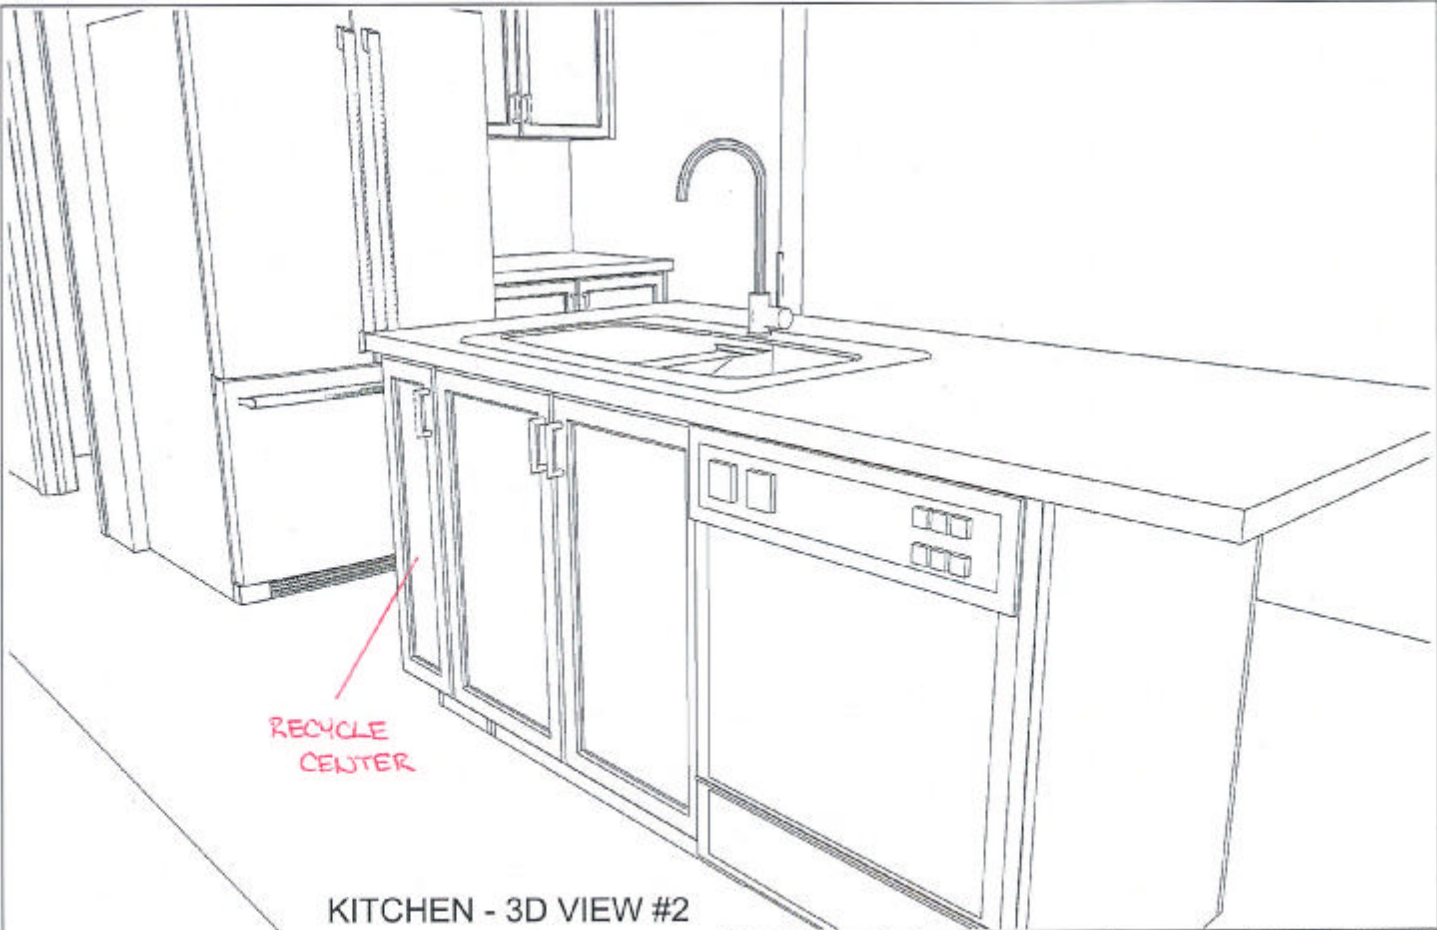

RECYCLE
CENTER

KITCHEN - 3D VIEW #2

Note: This drawing is an artistic interpretation of the general appearance of the design. It is not meant to be an exact rendition.		Designed: 1/15/2020 Printed: 1/16/2020	
		DCR - Madison (43-10) Kitchen	Drawing #: 1

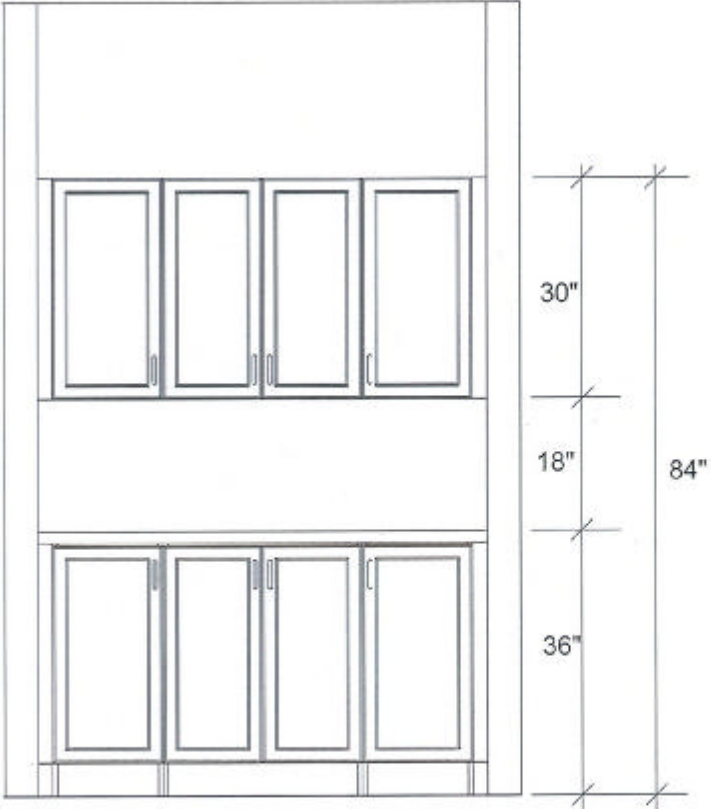


BUTLER'S PANTRY ELEVATION

Note: This drawing is an artistic interpretation of the general appearance of the design. It is not meant to be an exact rendition.		Designed: 1/15/2020 Printed: 1/16/2020	
		DCR - Madison (43-10) Kitchen	Drawing #: 1






FRIDGE ELEVATION

Note: This drawing is an artistic interpretation of the general appearance of the design. It is not meant to be an exact rendition.		Designed: 1/15/2020
		Printed: 1/16/2020
DCR - Madison (43-10) Kitchen	All	Drawing #: 1

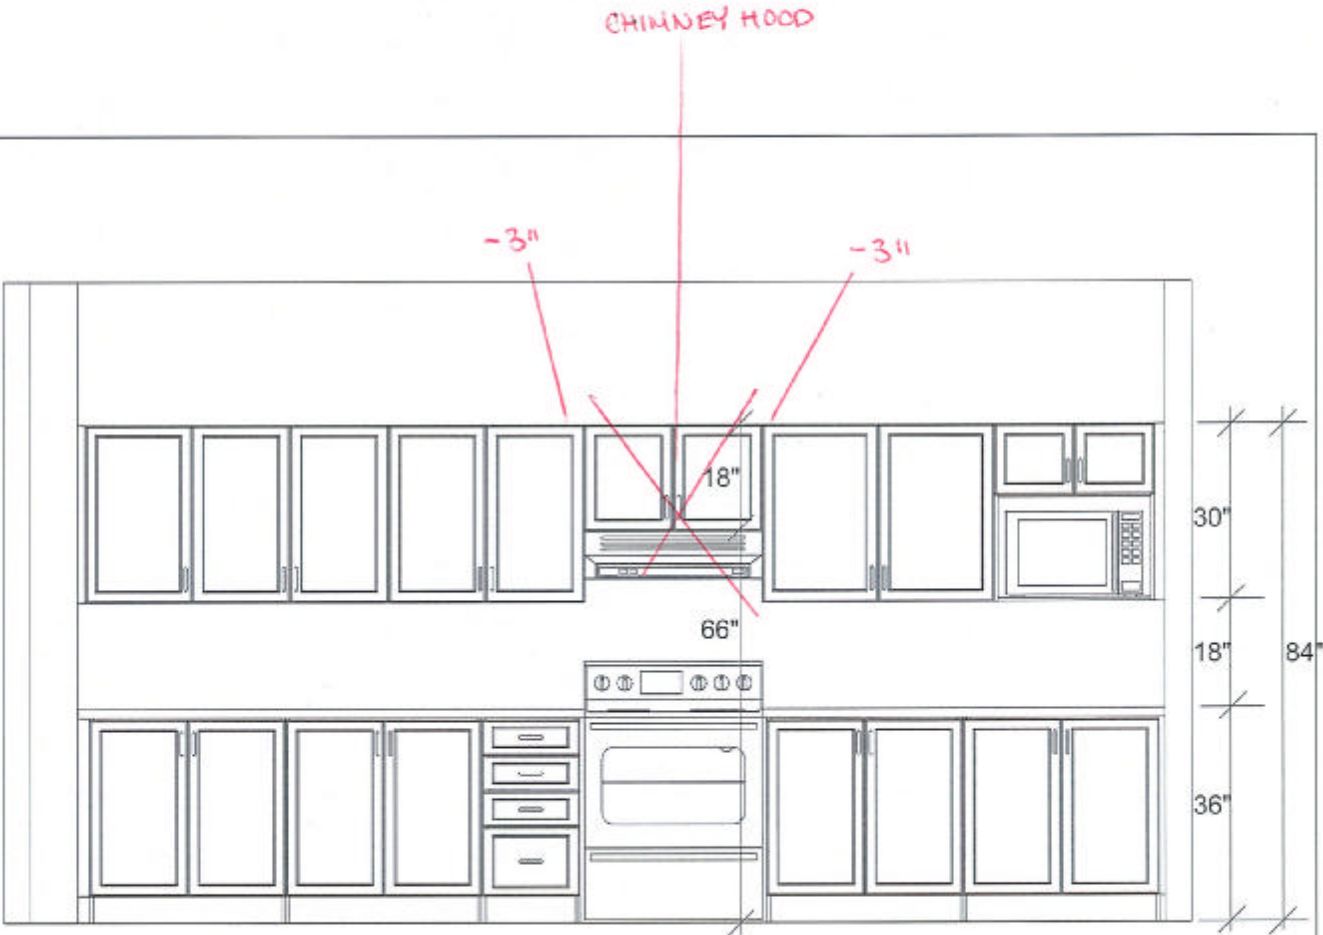

RANGE ELEVATION

Note: This drawing is an artistic interpretation of the general appearance of the design. It is not meant to be an exact rendition.		Designed: 1/15/2020 Printed: 1/16/2020
DCR - Madison (43-10) Kitchen	All	Drawing #: 1

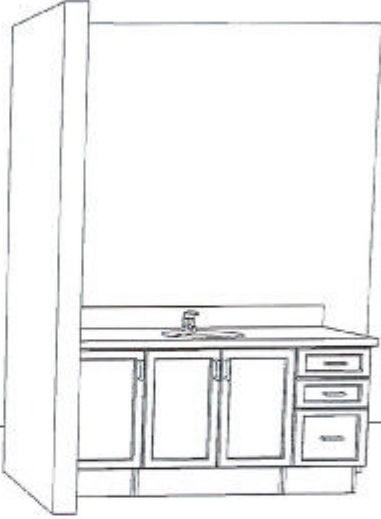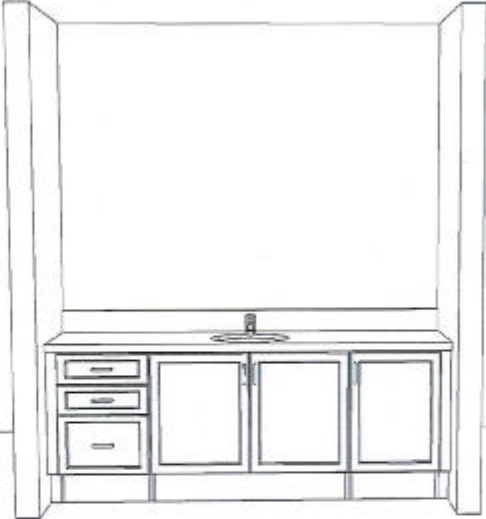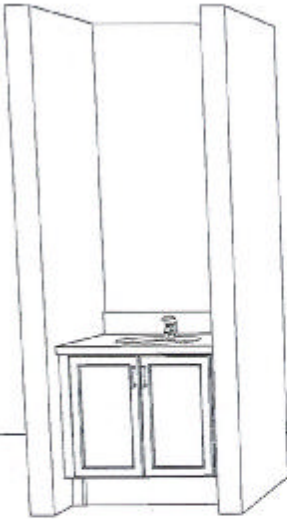

~~POWDER ROOM~~
BEDROOM #5
ENSUITE

MAIN BATH

MASTER ENSUITE

Note: This drawing is an artistic interpretation of the general appearance of the design. It is not meant to be an exact rendition.



DCR - Madison (43-10) Kitchen

All

Designed: 1/15/2020
Printed: 1/16/2020
Drawing #: 1