


Lot #292  
PATHWAYS 2  
KLONDIKE  
BASEMENT APARTMENT - 2 BDRM

KITCHEN / VANITIES  
MOUNTING HEIGHT - 84

- CABINETS -  
HARDWARE -  
STANDARD WHITE INTERIOR  
METAL DRAWER BOX  
5 PCS - 5/8" KICK - FIN. BOTH ENDS  
1 PCS - 90 DEG. CORNER MOULD  
1 PCS - T-MOULD  
4 PCS - FLAT MOULD


AS PER SITE MEASURE  
Nov 2-23

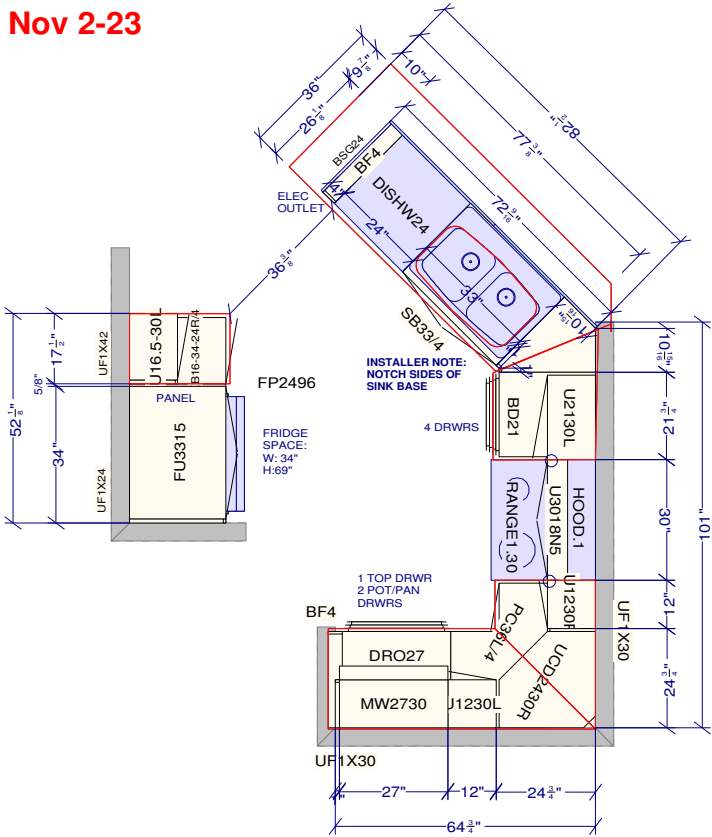

DocuSigned by:  
Sukhwinder Salota  
A07A710127C64FE...

11/15/2023 | 11:59 AM EST

DocuSigned by:  
Gurinderjit Singh Khaira  
06A835E4D2B34F9...

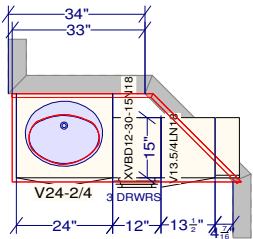

MAIN BATH

All dimensions size designations given are subject to verification on job site and adjustment to fit job conditions.



This is an original design and must not be released or copied unless applicable fee has been paid or job order placed.

Designed: 2023-11-06  
Printed: 2023-11-06