


****NOTE****
ALL WINDOW LINTELS TO BE 2-2X10
W/ P2 POSTS ON EACH SIDE U.N.O.

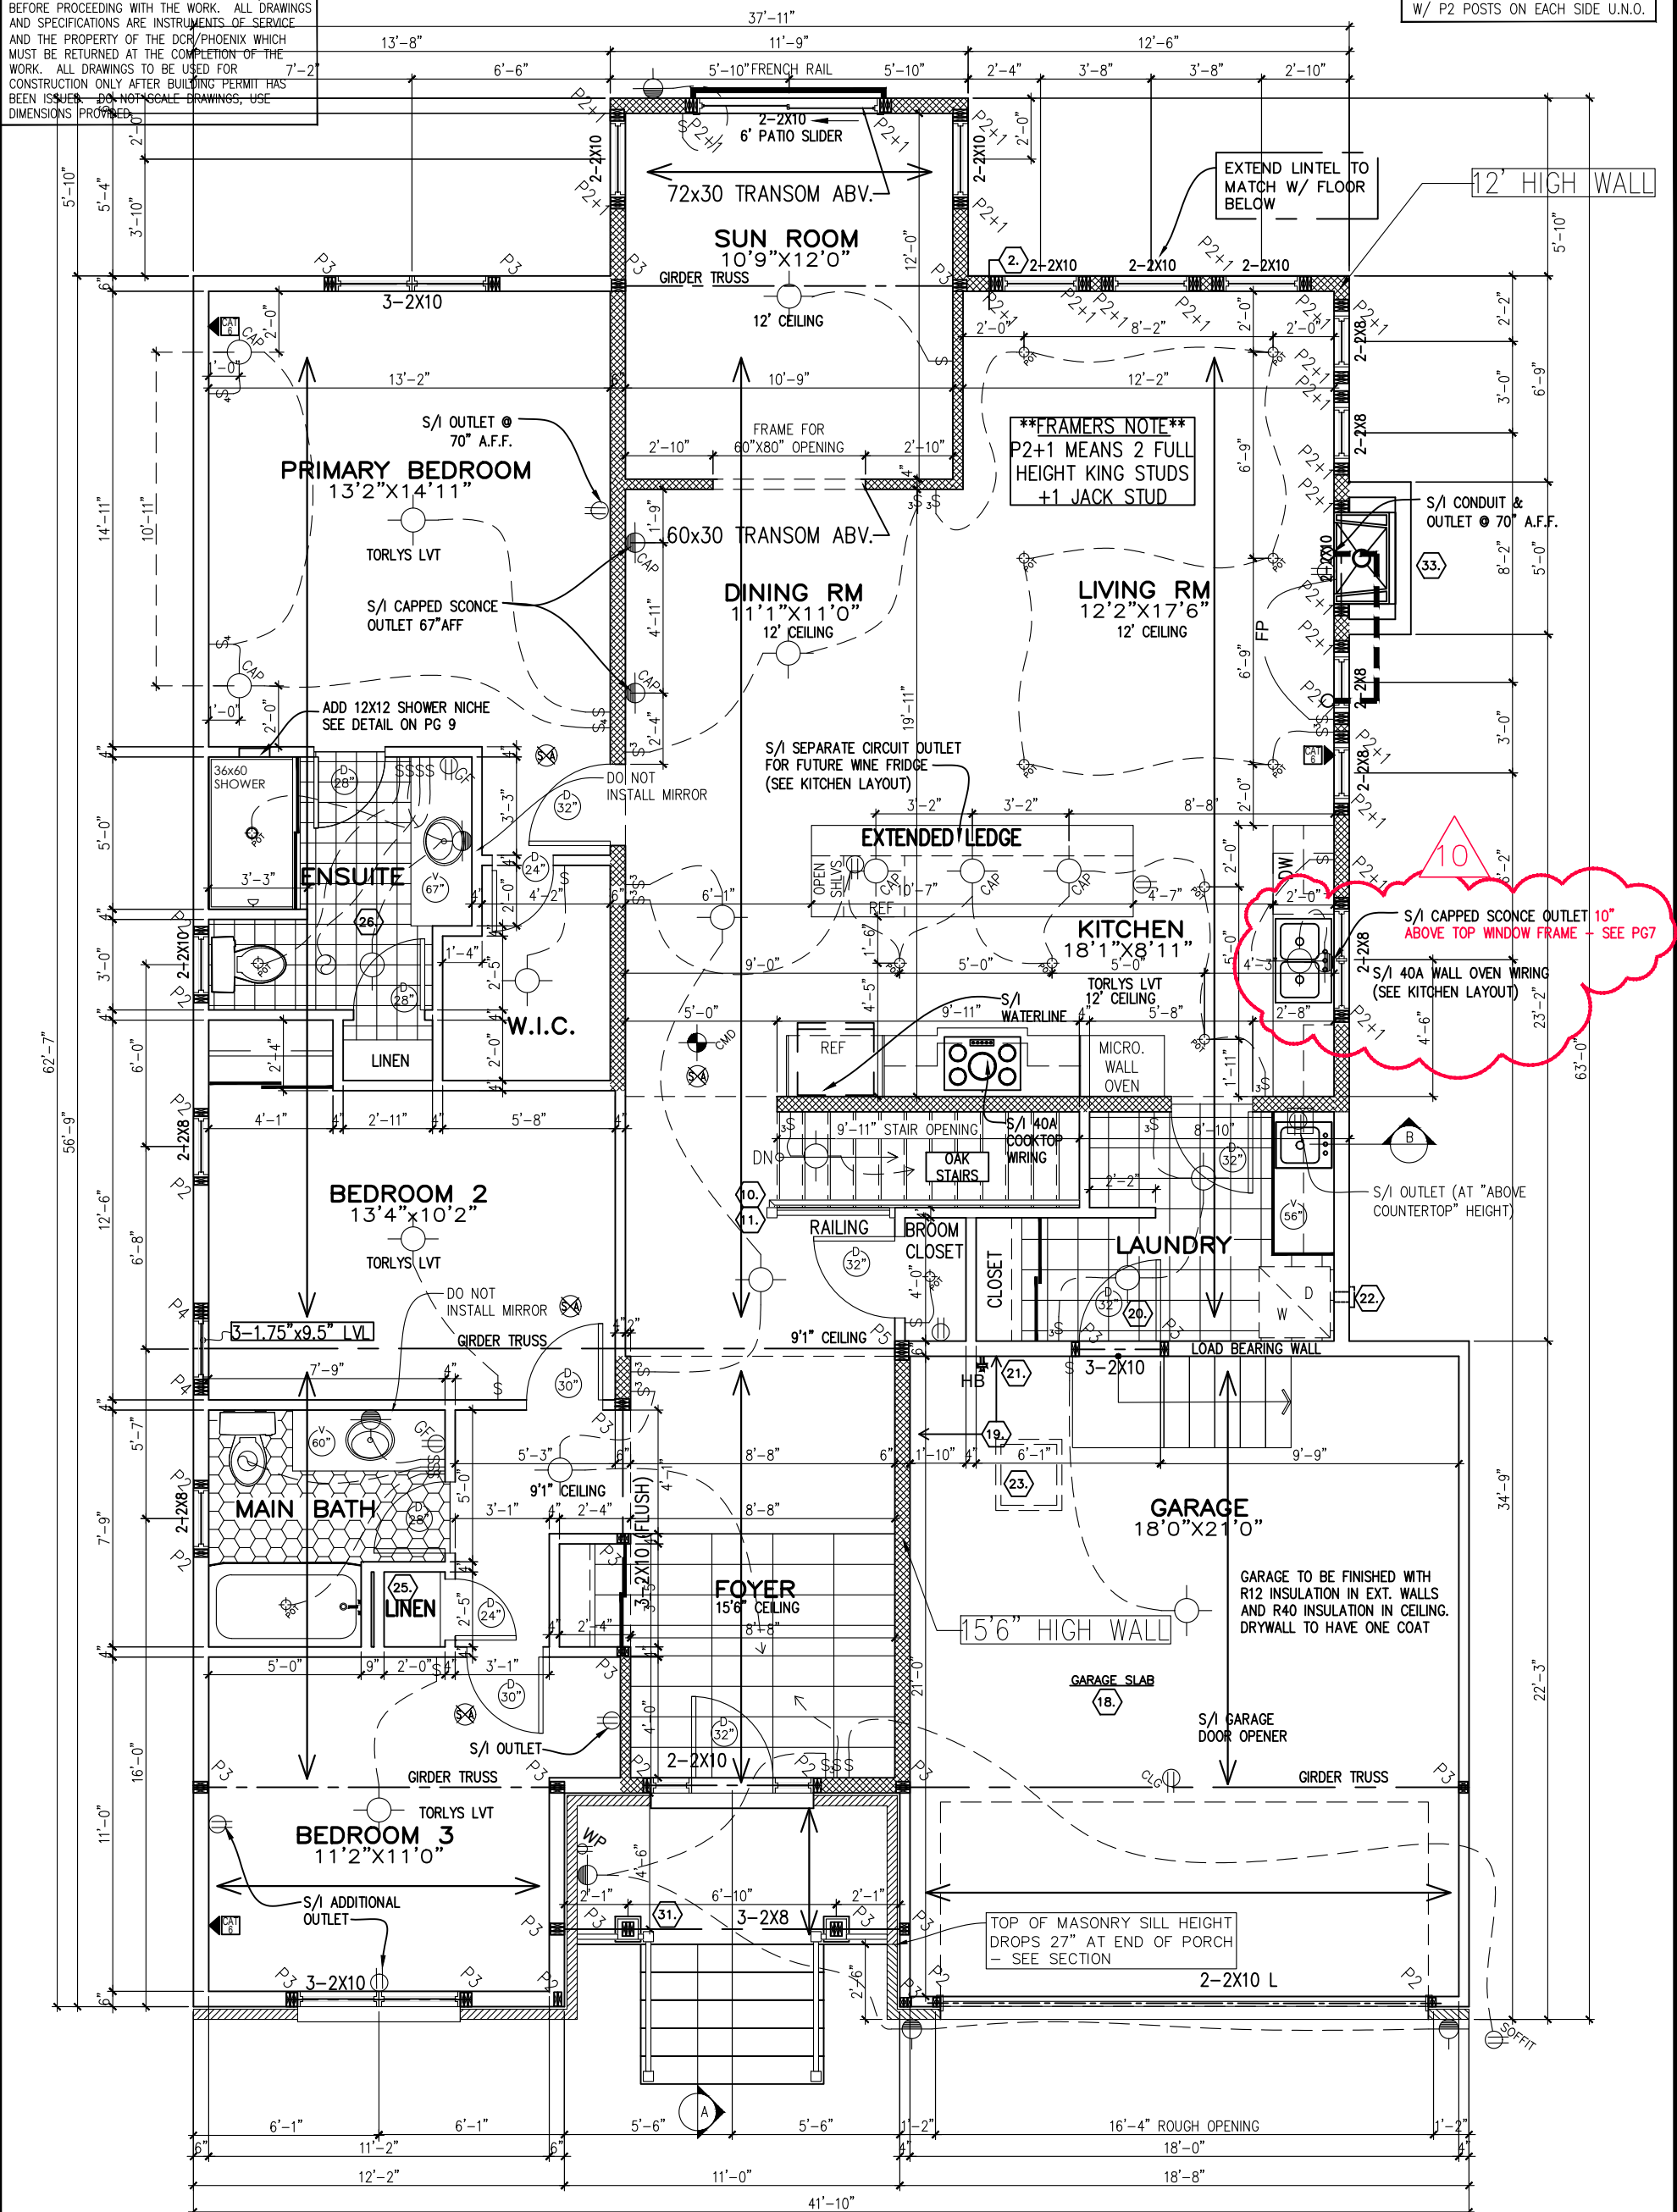


BASEMENT = 25 SQ. FT.
GROUND FLOOR = 1834 SQ. FT.
TOTAL = 1859 SQ. FT.

-FLAT CEILINGS THROUGHOUT / NO STIPPLE

-BYPASS SLIDERS FOR ALL SLIDING CLOSET DOORS

R ELEVATION

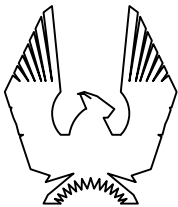

PHOENIX HOMES

SITE: WHITETAIL RIDGE PH. 4


LOT NUMBER:

CIVIC ADDRESS:
128 FRANK FISHER CRESCENT


128

10	FINAL FOR SITE – REVISED KITCHEN WINDOW	02/04/24	CB
9	FINAL FOR SITE	30/08/23	CB
8	FINAL BLACKLINES	13/06/23	CB
7	ISSUED FOR ENGINEERING	23/05/23	CB
6	ISSUED FOR LAYOUTS	10/05/23	CB
5	BEP BLACKLINES	08/05/23	SP
No.	Description	dd/mm/yy	By
REVISIONS			


footprint:	B-24
drawn by:	SD
date:	SEP/12
scale:	3/16"=1'-0"
sheet no:	
D.C.L.-A-4	

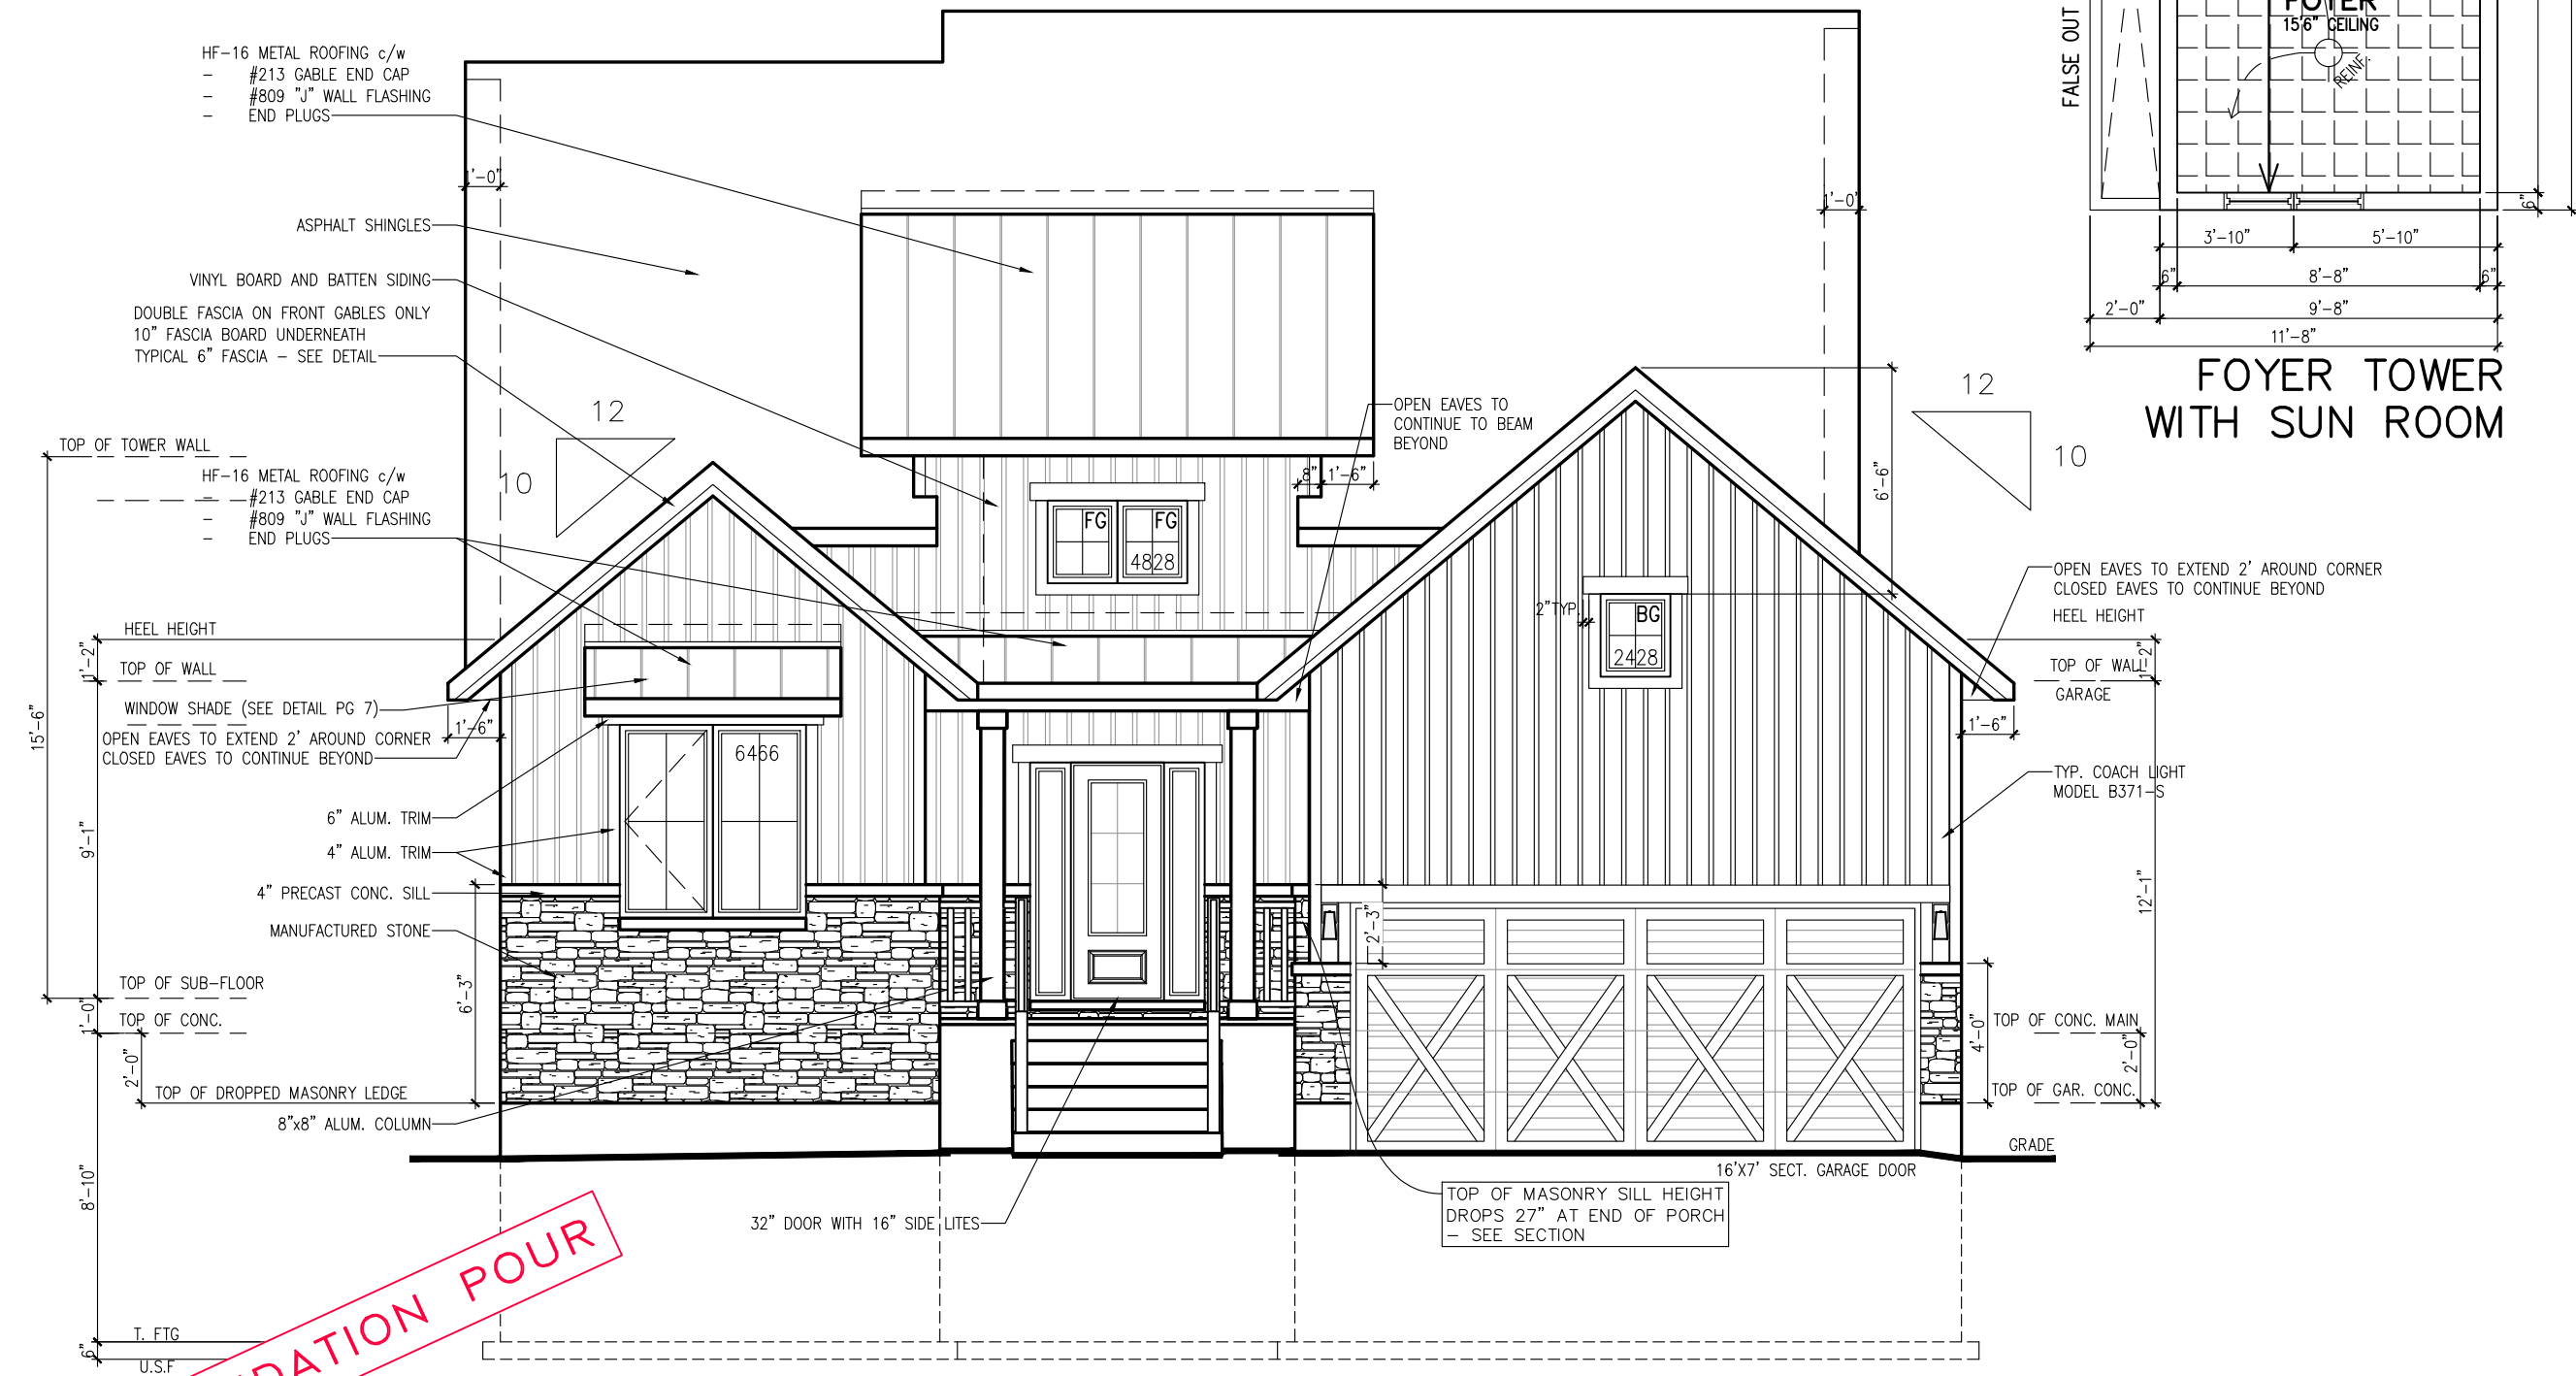

A diagram showing a foundation pour area. A red stamp with the text "9' FOUNDATION POUR" is overlaid diagonally across the diagram. The diagram includes a vertical line on the left, a horizontal line labeled "T. FTG" (Tie Footing), and a horizontal line labeled "U.S.F." (Unreinforced Steel Form). A dashed line indicates the foundation's extent.

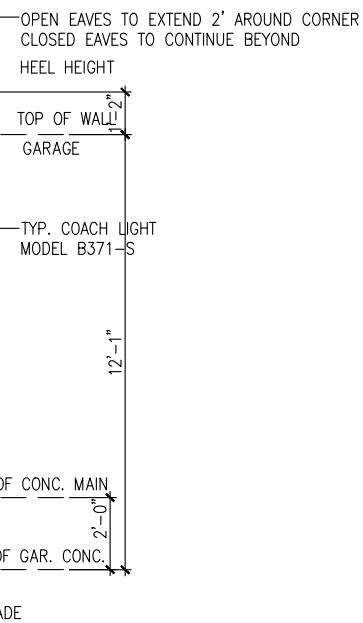

9' FOUNDATION POUR

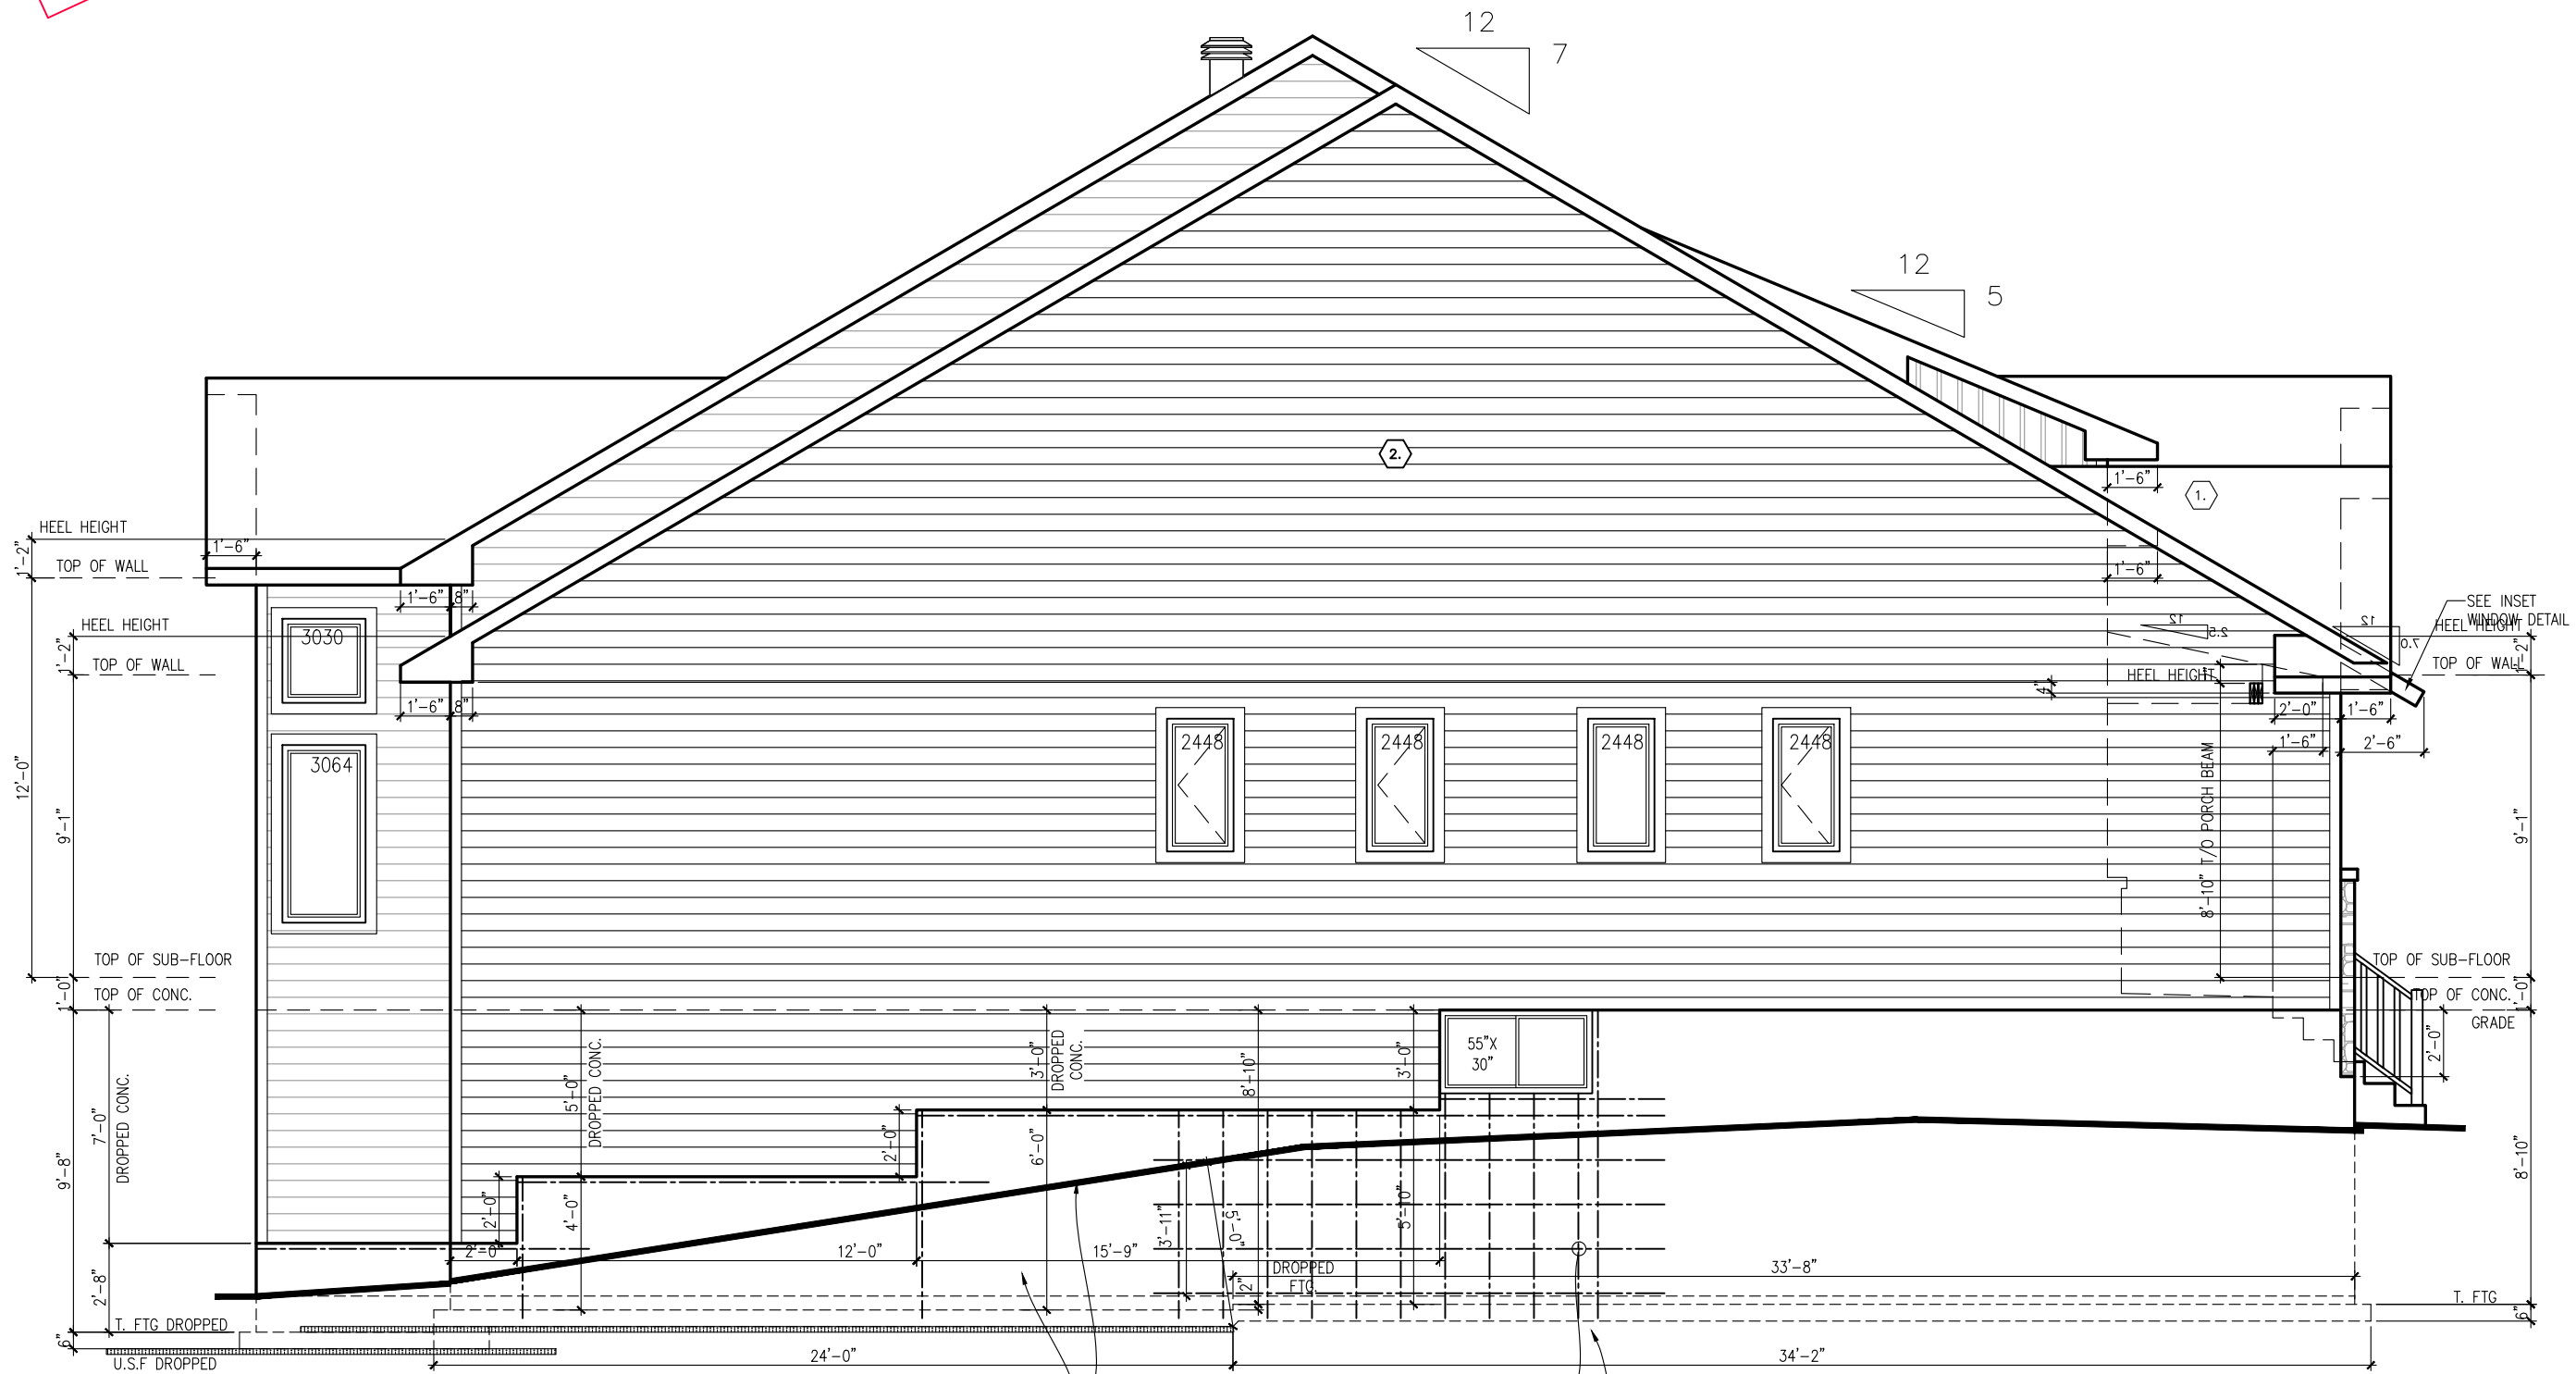

LEFT SIDE ELEVATION R
WITH SUNROOM

2-15M @ EACH FACE
(EXTEND VERT. TO
FOOTING & HOR. 24"
BEYOND FACE)

[OBC 9.15.4.2]
WHERE DISTANCE IS GREATER THAN 3'-11"
BETWEEN GRADE AND TOP OF CONCRETE SLAB
REINFORCE WALL W/ 15M(VERT.& HOR.) @ 16" o/c
& 15M BENT DOWELS (32"X12") @ 16" o/c

SRP400 R10 [2 3/8" THICK SHEETS]
EXTEND 48" BEYOND FOOTING

footprint:	B-24
drawn by:	SD
date:	SEP/12
scale:	3/16"=1'-0"
sheet no:	6
D.C.L.-A-4	9

10	FINAL FOR SITE - REVISED KITCHEN WINDOW	02/04/24	CB
9	FINAL FOR SITE	30/08/23	CB
8	FINAL BLACKLINES	13/06/23	CB
7	ISSUED FOR ENGINEERING	23/05/23	CB
6	ISSUED FOR LAYOUTS	10/05/23	CB
5	BEP BLACKLINES	08/05/23	SP
No.	Description	dd/mm/yy	By
REVISIONS			




SPRINGFIELD R - 2022

SITE: WHITETAIL RIDGE PH. 4

LOT NUMBER: 128

CIVIC ADDRESS:
128 FRANK FISHER CRESCENT

PHOENIX HOMES

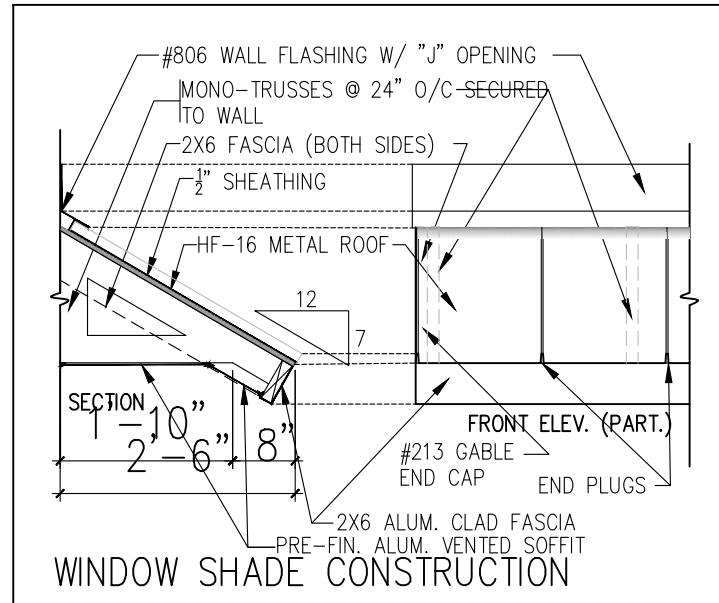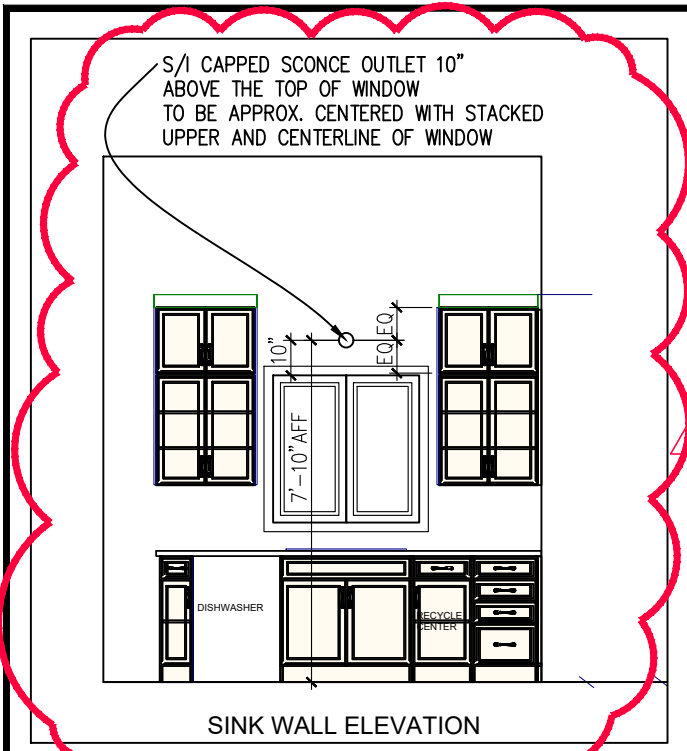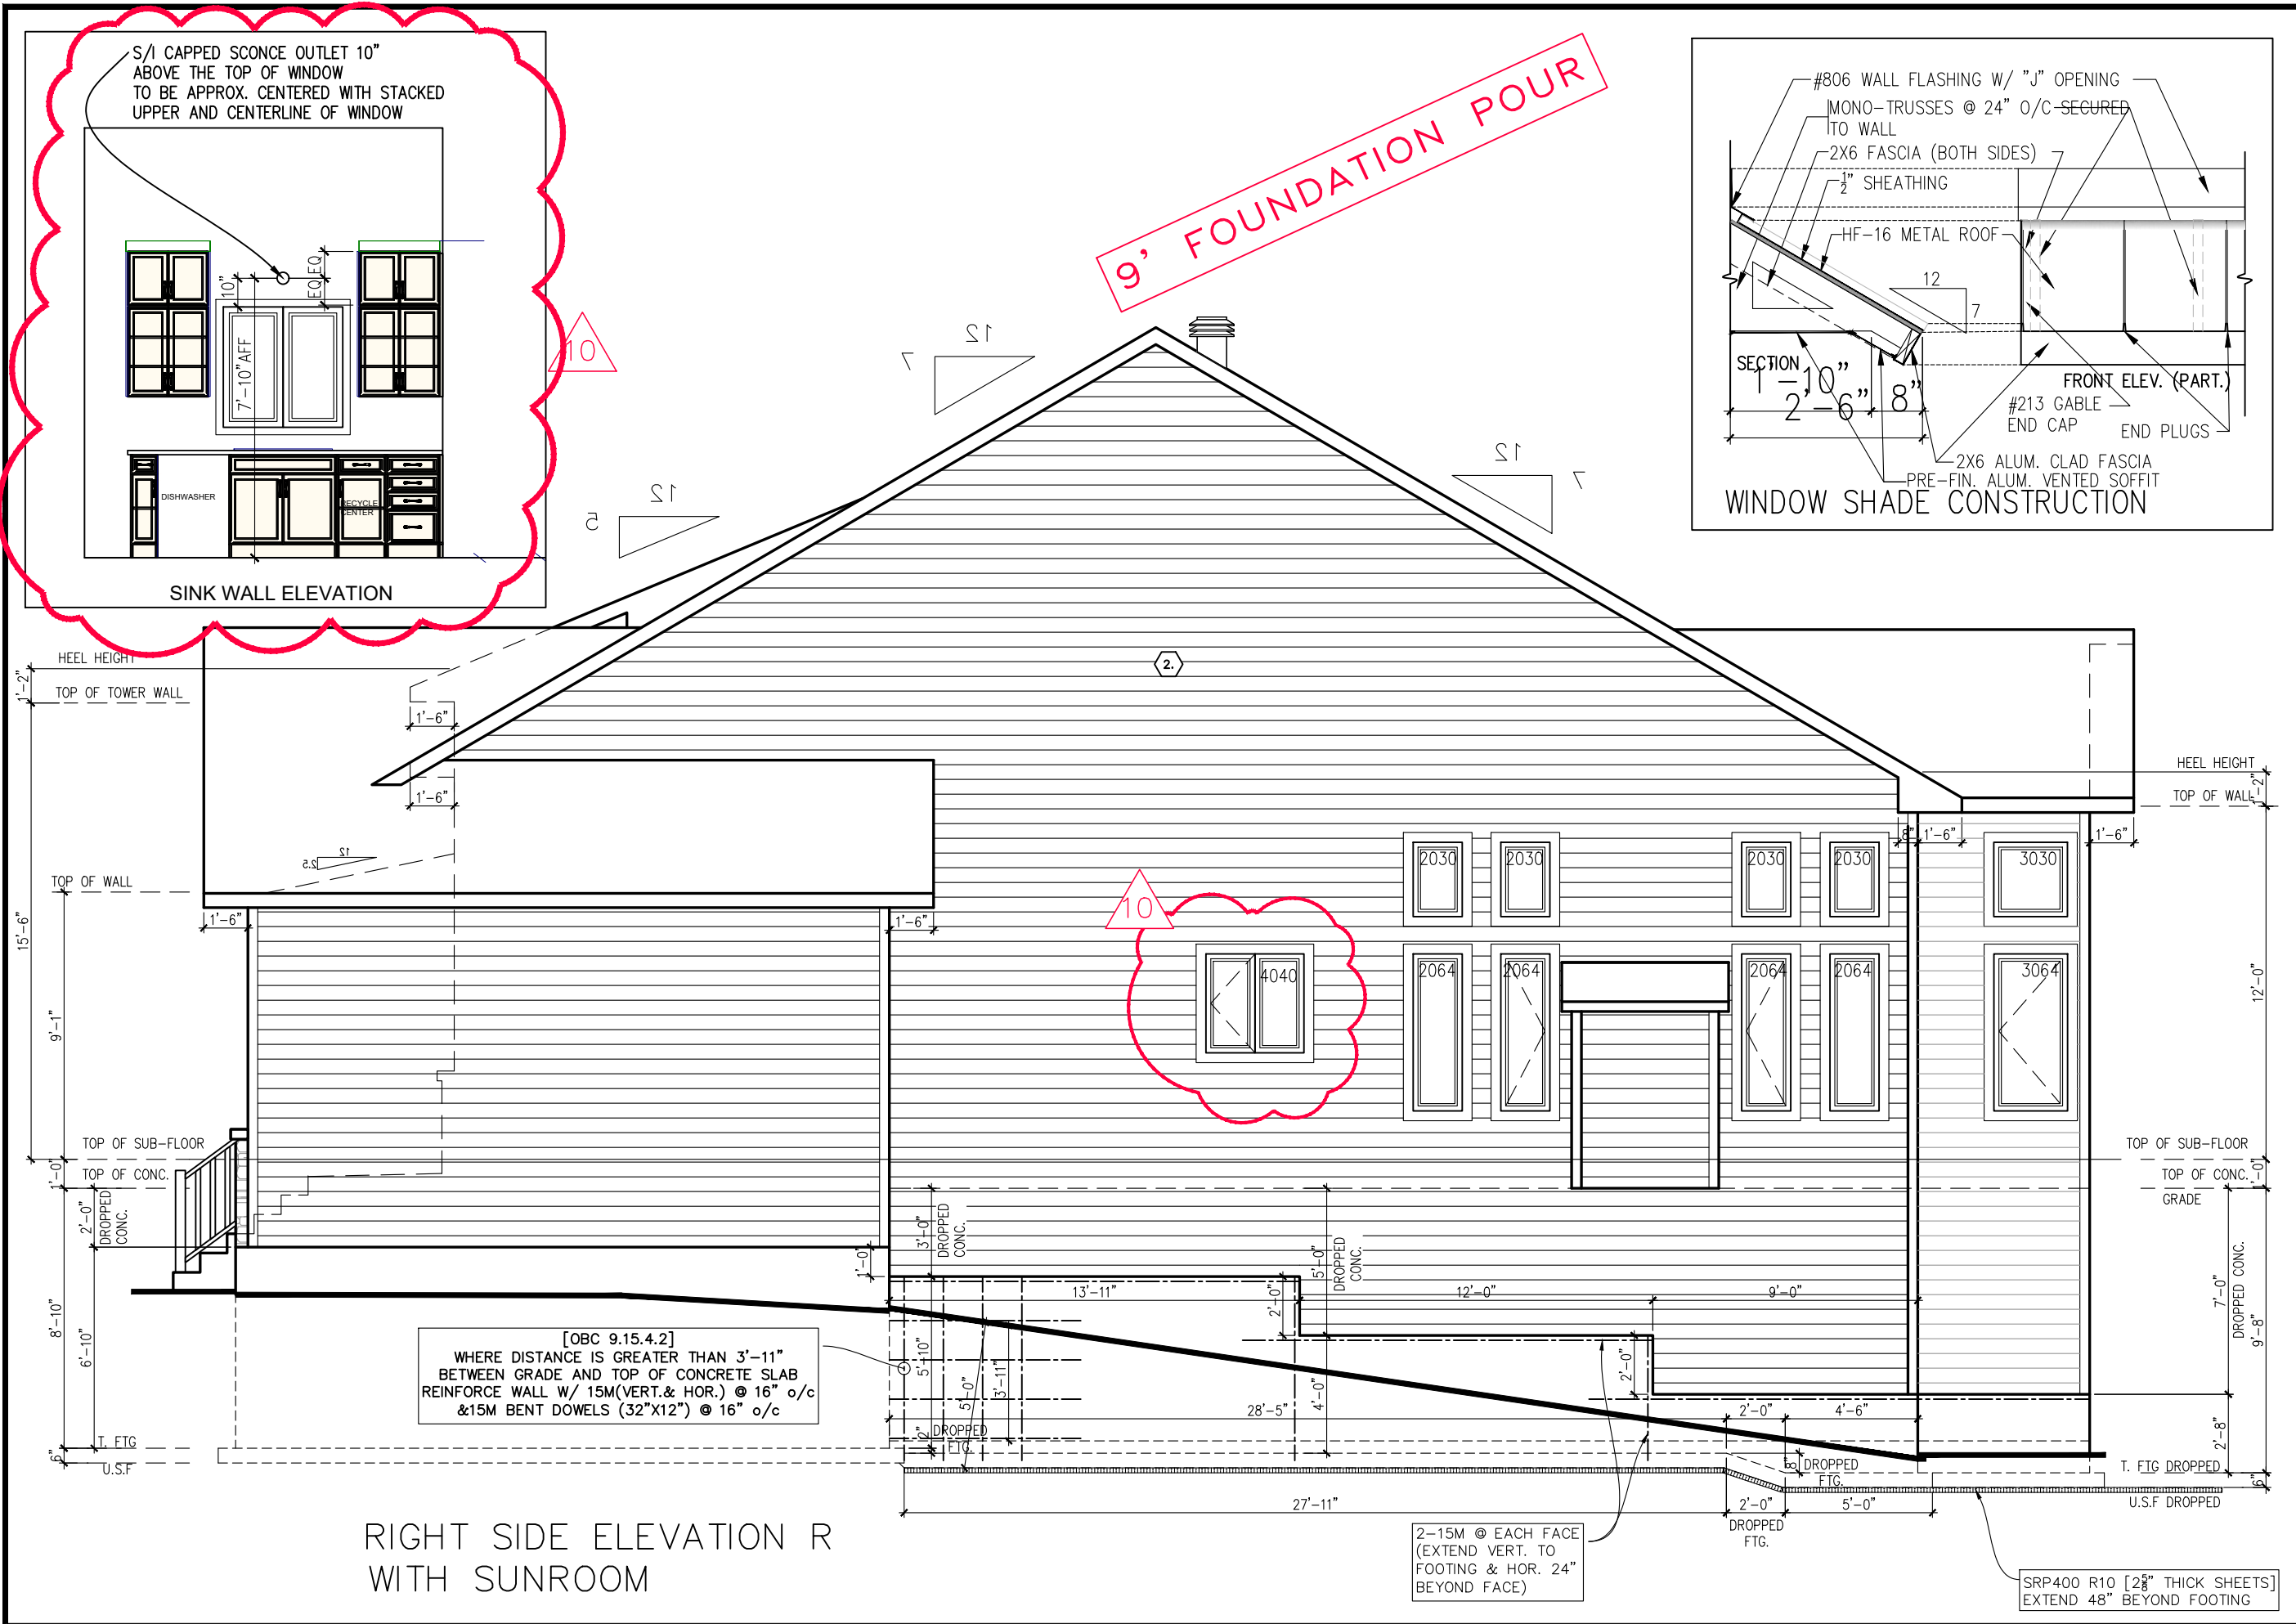

footprint:	B-24
drawn by:	SD
date:	SEP/12
scale:	3/16"=1'-0"
sheet no:	7
D.C.L.-A-4	9

10	FINAL FOR SITE - REVISED KITCHEN WINDOW	02/04/24	CB
9	FINAL FOR SITE	30/08/23	CB
8	FINAL BLACKLINES	13/06/23	CB
7	ISSUED FOR ENGINEERING	23/05/23	CB
6	ISSUED FOR LAYOUTS	10/05/23	CB
5	BEP BLACKLINES	08/05/23	SP
No.	Description	dd/mm/yy	By
REVISIONS			

SPRINGFIELD R - 2022


SITE: WHITETAIL RIDGE PH. 4

LOT NUMBER: 128


CIVIC ADDRESS: 128 FRANK FISHER CRESCENT

PHOENIX HOMES

9' FOUNDATION POUR

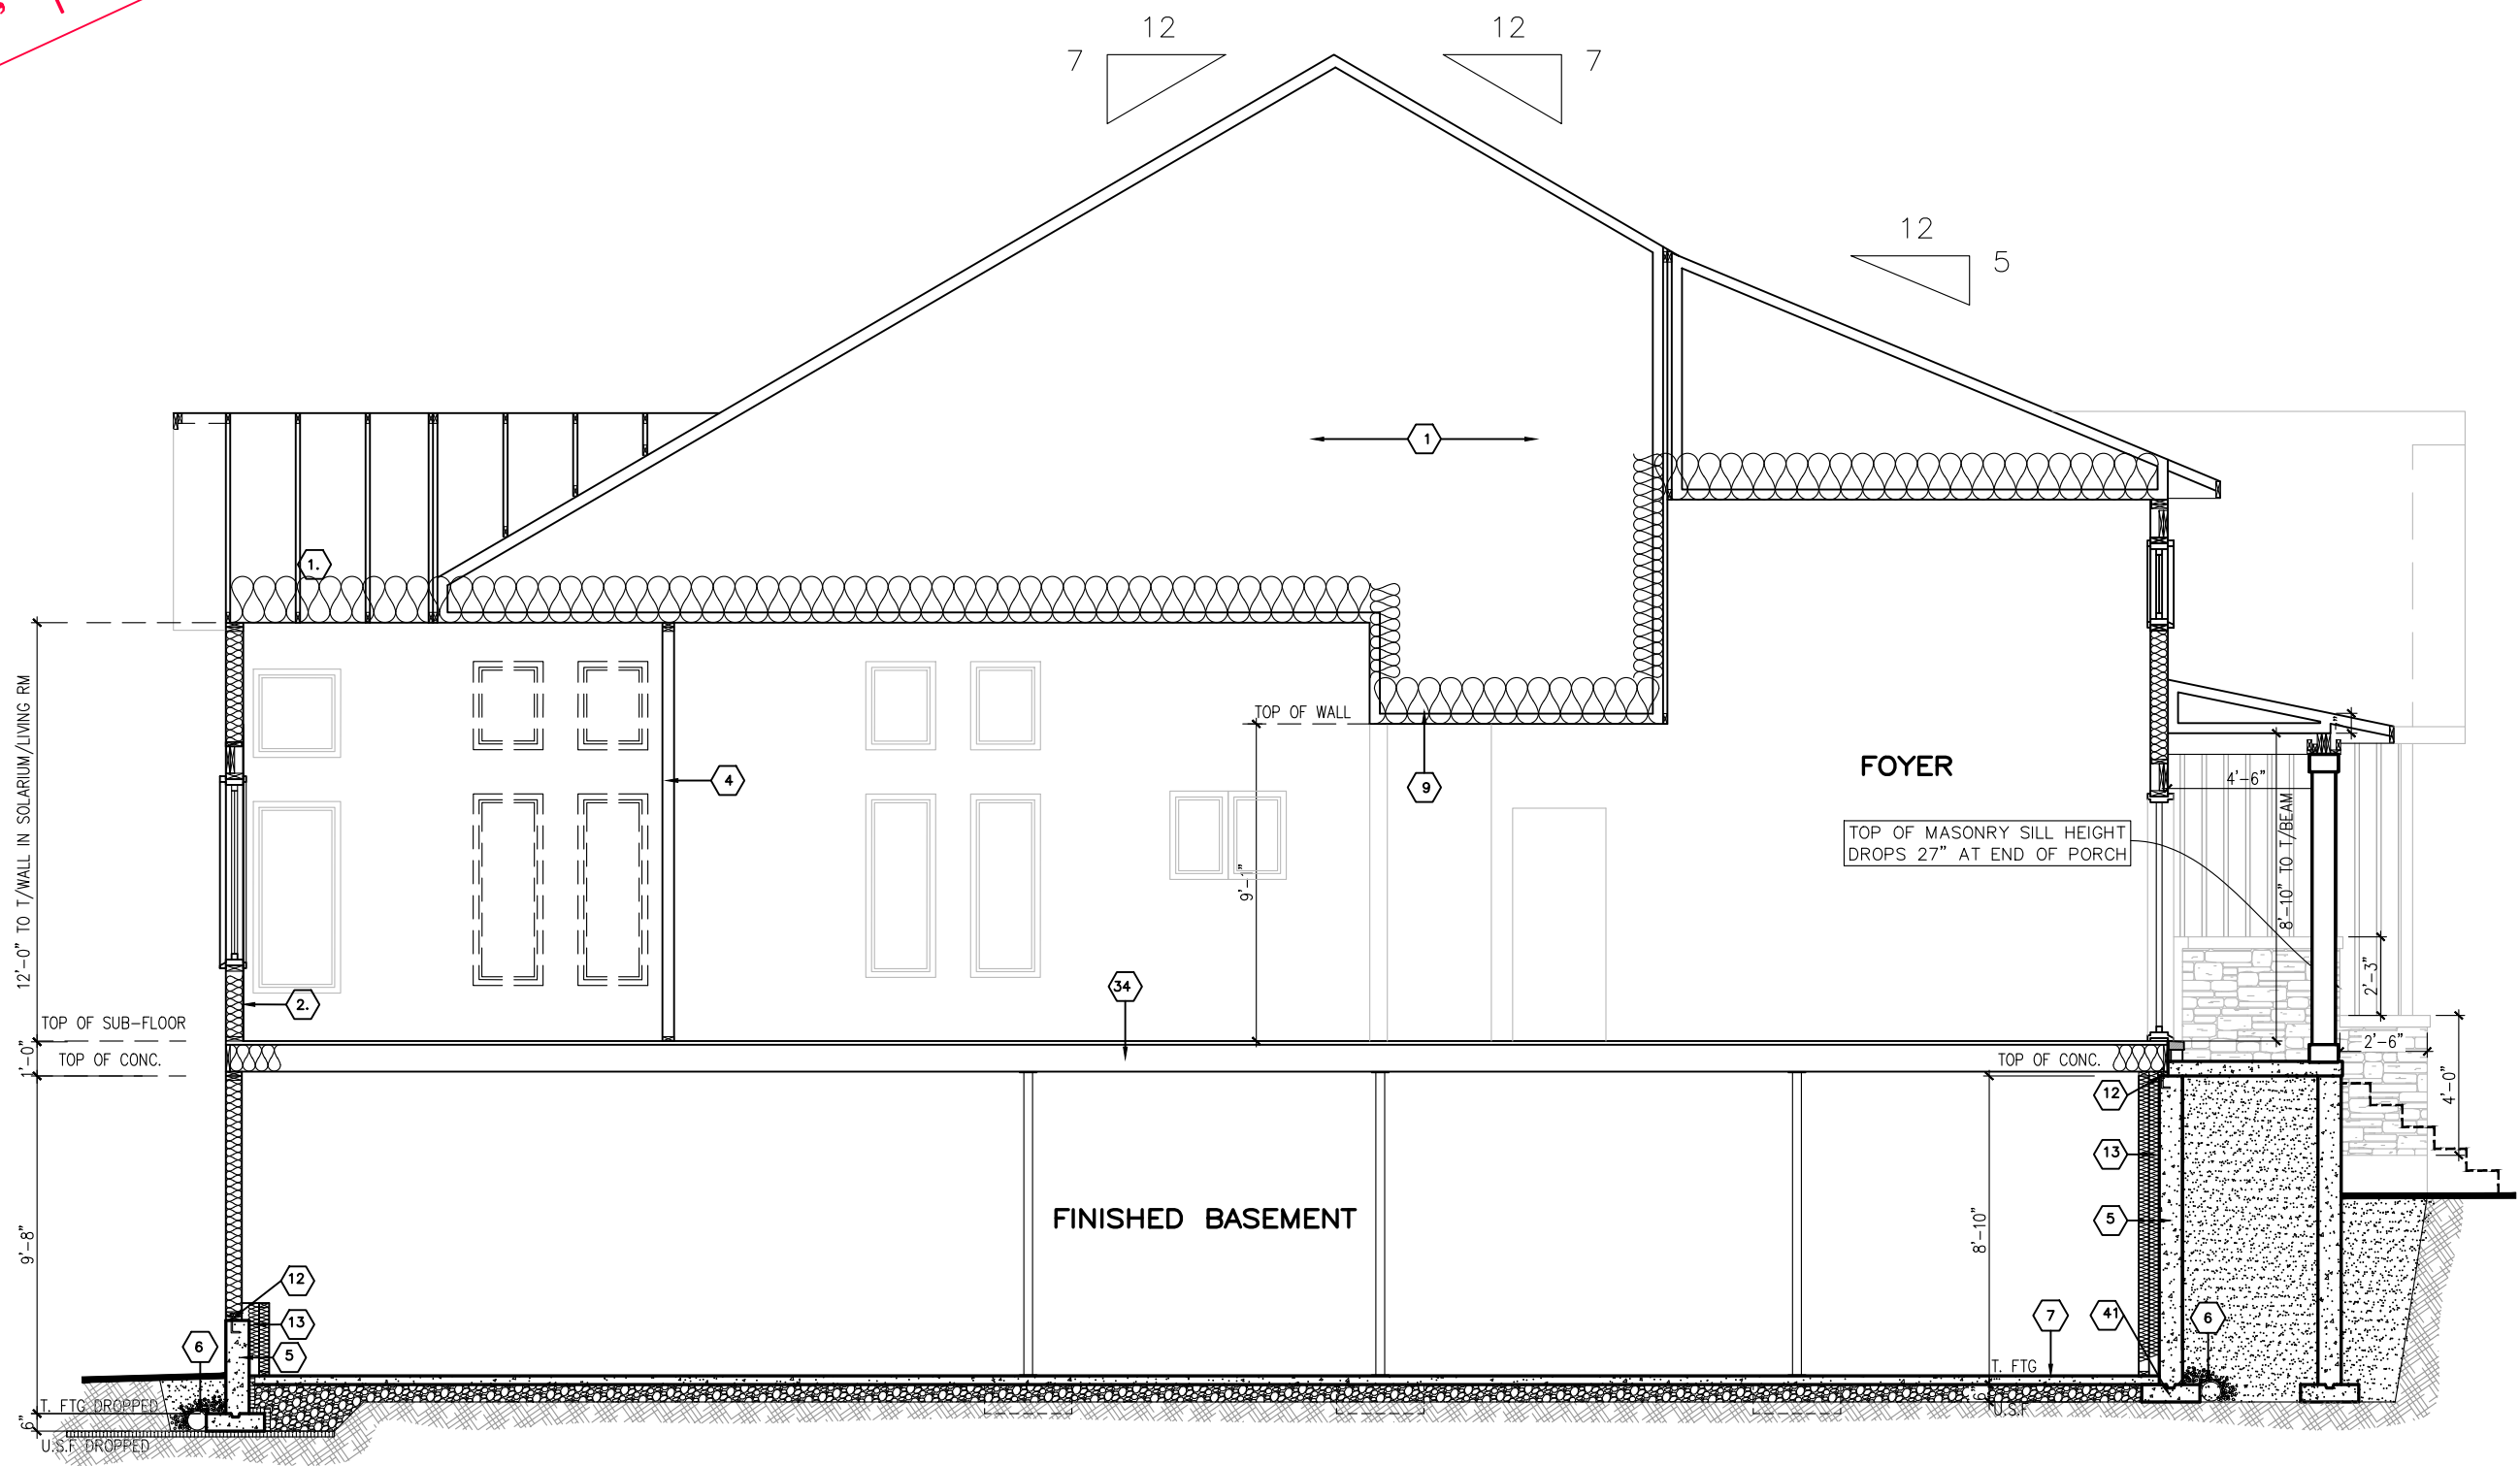

ELEVATION R
SECTION A

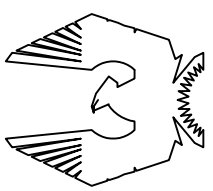

PHOENIX HOMES

SPRINGFIELD R – 2022

SITE: WHITETAIL RIDGE PH. 4


LOT NUMBER: 128

CIVIC ADDRESS: 128 FRANK FISHER CRESCENT


footprint:	B-24
drawn by:	SD
date:	SEP/12
scale:	3/16"=1'-0"
sheet no:	8
D.C.L. - A-4	9

No.	Description	By	ad/mm/yy
10	FINAL FOR SITE – REVISED KITCHEN WINDOW	CB	02/04/24
9	FINAL FOR SITE	CB	30/08/23
8	FINAL BLACKLINES	CB	13/06/23
7	ISSUED FOR ENGINEERING	CB	23/05/23
6	ISSUED FOR LAYOUTS	CB	10/05/23
5	BEP BLACKLINES	SP	08/05/23

9' FOUNDATION POUR

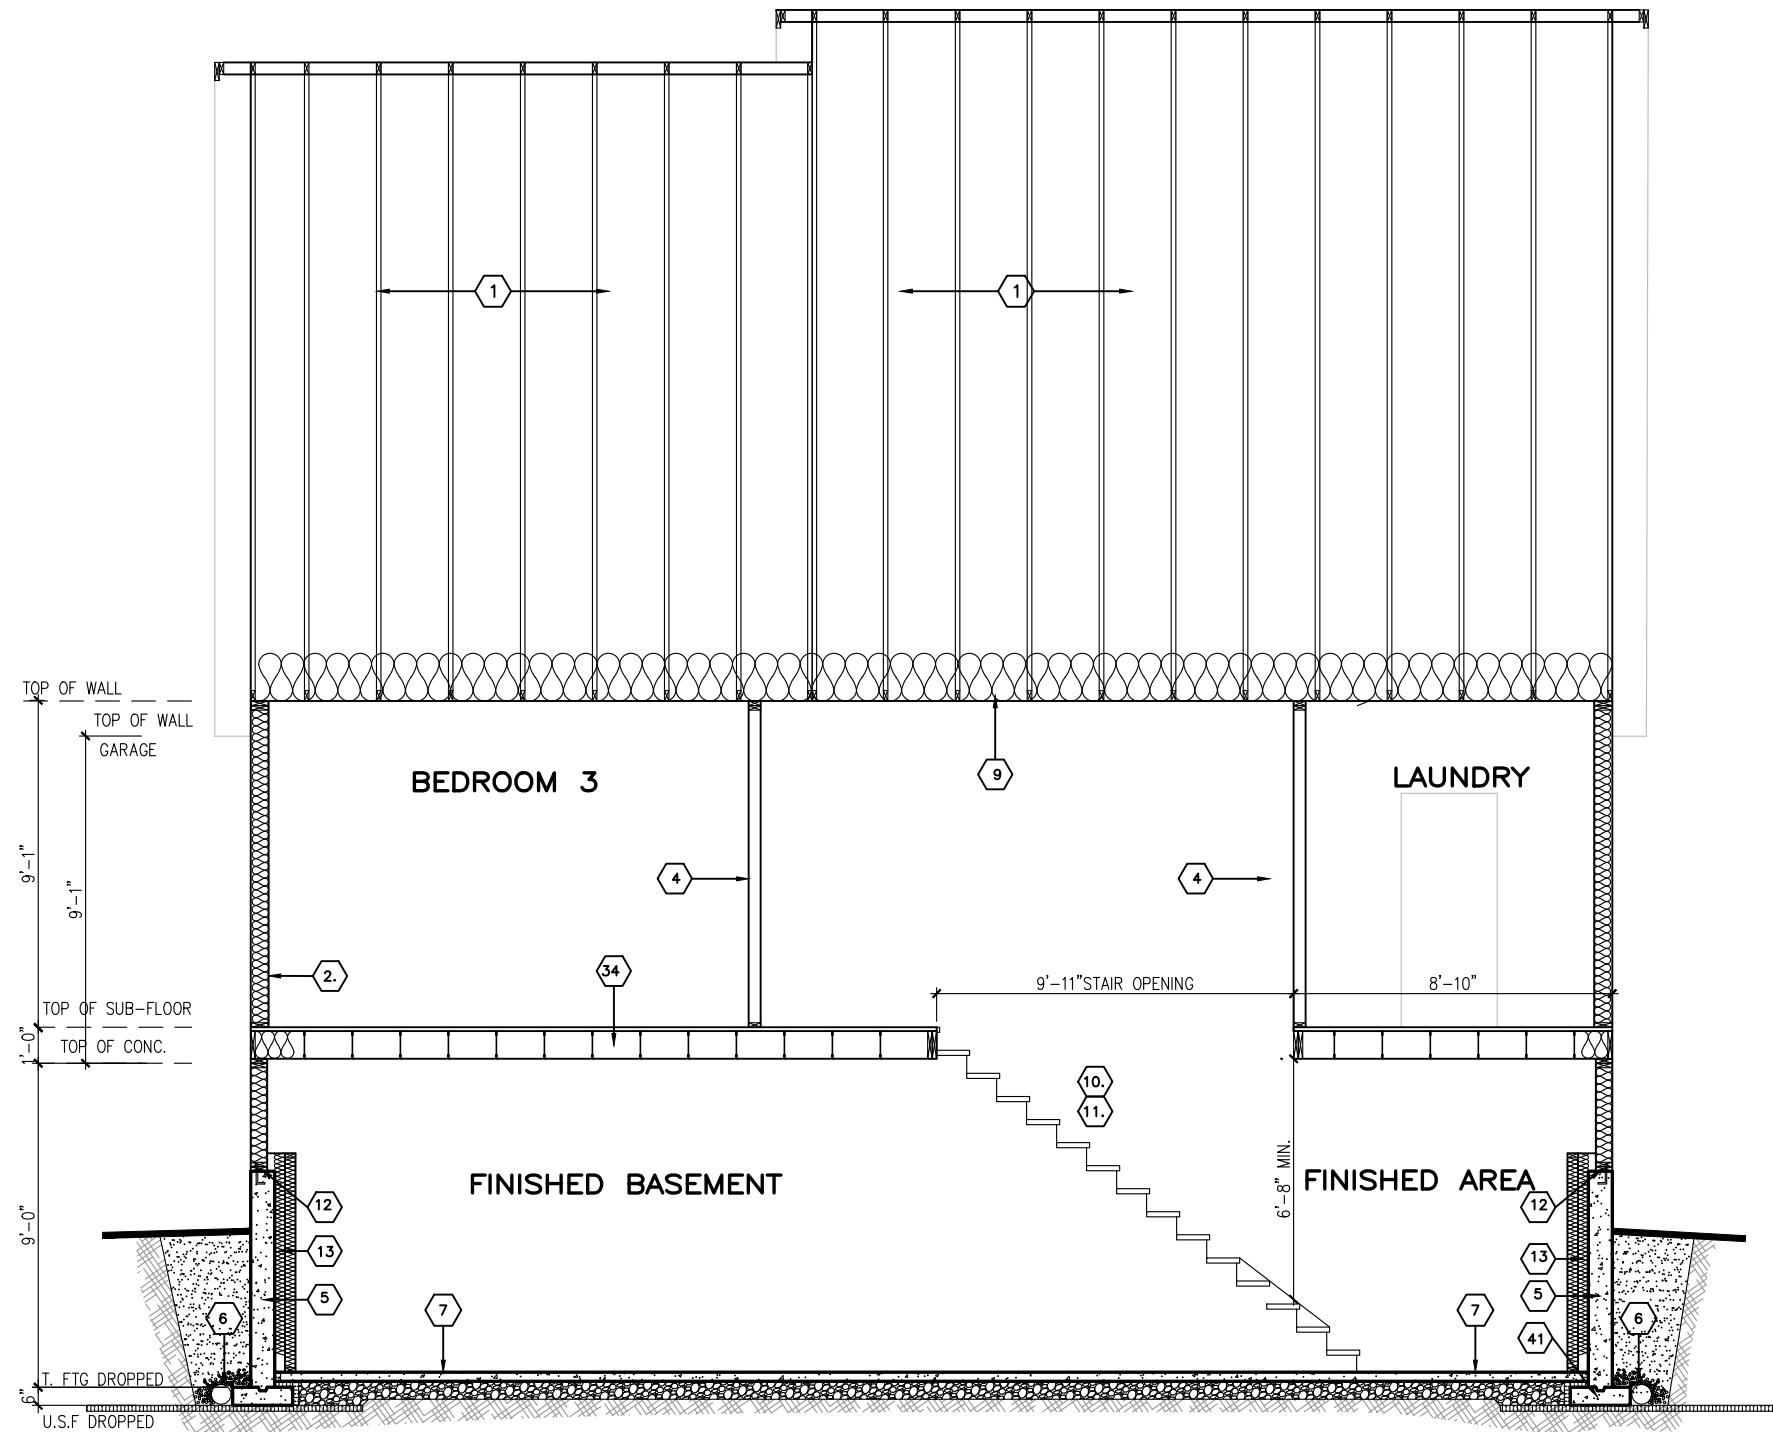

ELEVATION R
SECTION B

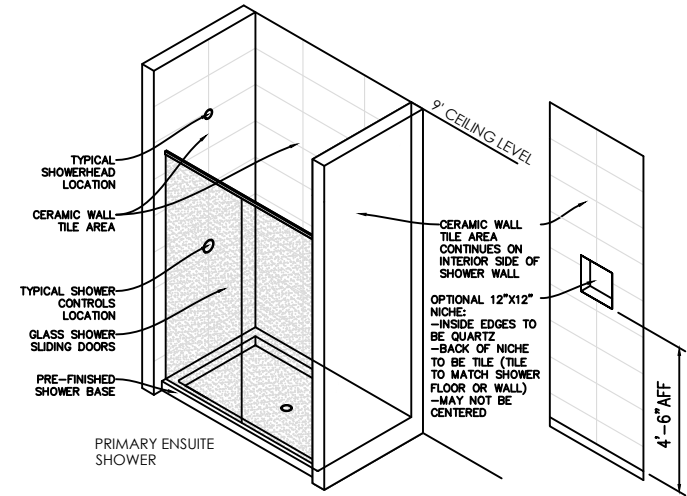

footprint:	B-24
drawn by:	SD
date:	SEP/12
scale:	3/16"=1'-0"
sheet no:	9
D.C.L. - A-4	9


No.	Description	REVISIONS	By
10	FINAL FOR SITE - REVISED KITCHEN WINDOW	02/04/24	CB
9	FINAL FOR SITE	30/08/23	CB
8	FINAL BLACKLINES	13/06/23	CB
7	ISSUED FOR ENGINEERING	23/05/23	CB
6	ISSUED FOR LAYOUTS	10/05/23	CB
5	BEP BLACKLINES	08/05/23	SP

SPRINGFIELD R - 2022

SITE: WHITETAIL RIDGE PH. 4

LOT NUMBER: 128

CIVIC ADDRESS: 128 FRANK FISHER CRESCENT

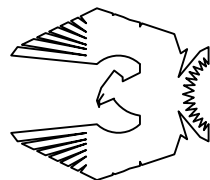

PHOENIX HOMES