

- CABINETS - LINE 3
- HARDWARE - STANDARD
- STANDARD WHITE INTERIOR
- SOFT CLOSE DRAWERS
- STD HINGES
- 4 PCS - 5/8" KICK - FIN. BOTH ENDS
- 2 PCS - 90 DEG. CORNER MOULD
- 1 PCS - T-MOULD
- 5 PCS - FLAT MOULDING

DocuSigned by:
K. Allen
E39CAE2A54684CB...

5/14/2024 | 10:5

LOT #3-63
WHITE TAIL RIDGE 3
NEWINGTON (GARAGE RIGHT)
OPTIONAL CHEF'S KITCHEN

MOUNTING HEIGHT: 96

DocuSigned by:
Clive Allen
1DBC50A78E74FB...


5/14/2024 | 10:5

~~FILL TO CEILING WITH
PLAIN PANEL IN MATCHING MATERIAL
& COLOUR TO CABINET DOORS
RECESSED APPROX. 1/2" FROM FRONT OF CABINET BOX~~

FILL TO CEILING WITH PLAIN PANEL FLUSH
TO CABINET DOORS
PANEL IN MATCHING COLOUR AND FINISH
TO CABINET DOORS

LIGHT VALANCE - 2"H
PLAIN FLAT STYLE - RCESSED APPROX. 1/2"
FROM FRONT OF CABINETE BOX

REVISED: MAY 7-24

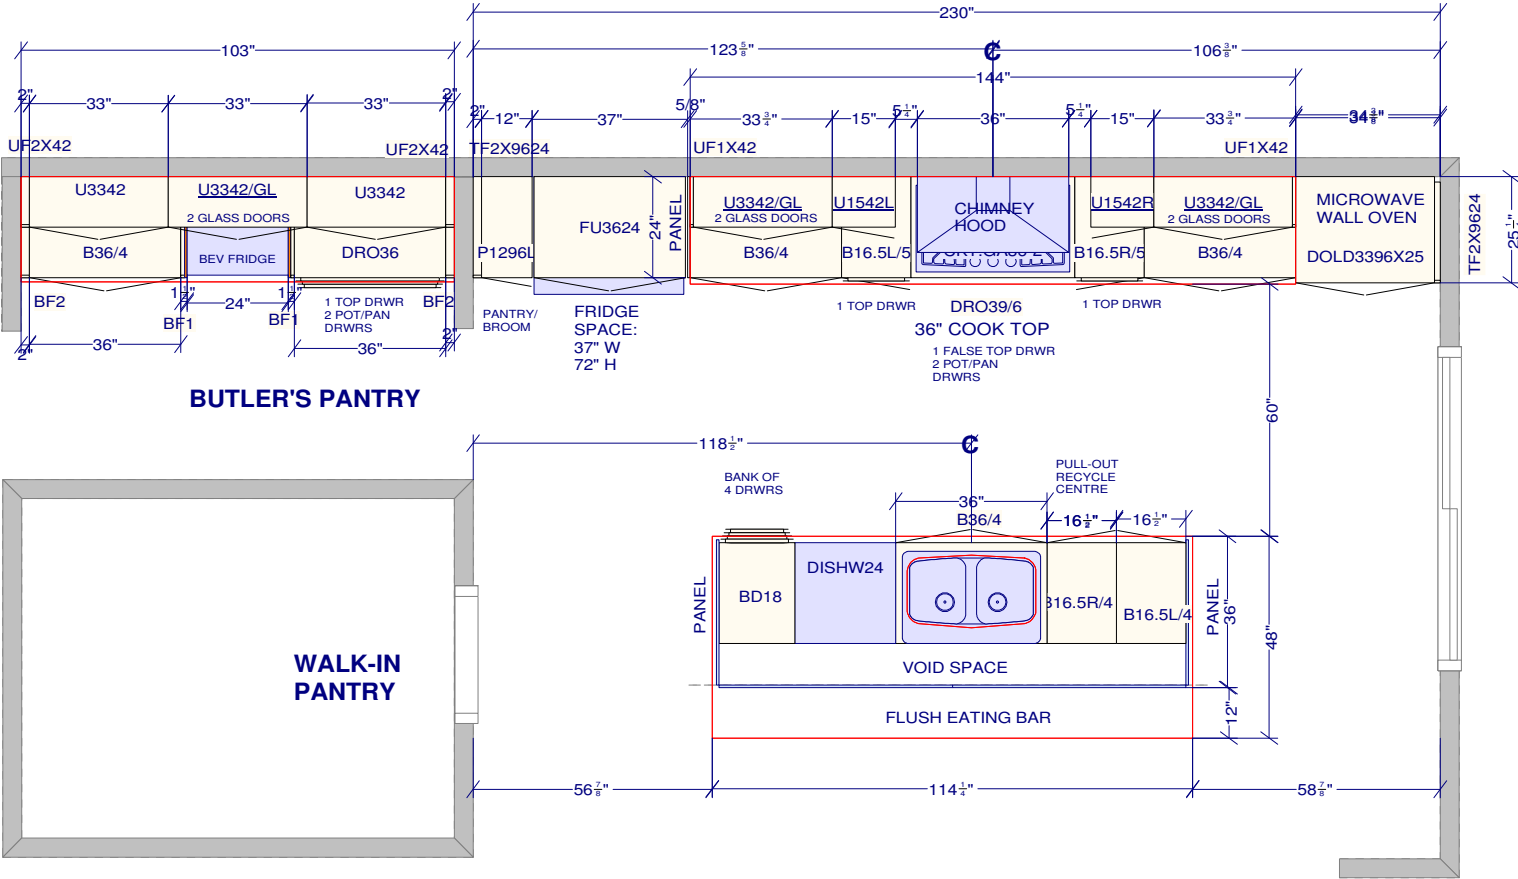

All dimensions ,size designations given are subject to verification on job site and adjustment to fit job conditions.	This is an original design and must not be released or copied unless applicable fee has been paid or job order placed.	Designed: 2024-05-07 Printed: 2024-05-07	
		DCR #3-63 - Newington Chef's 2 - May 7-24 .kit	Drawing #: 1 No Scale.

DocuSigned by:
K. Haller
E39CAE2A54684CB...


5/14/2024 | 10:49 AM EDT

FILL TO CEILING WITH PLAIN PANEL
FLUSH TO CABINET DOORS
PANEL IN MATCHING COLOUR AND
FINISH TO CABINET DOORS

DocuSigned by:
Clive Allen
1DBC50A78E74FB...

5/14/2024 | 10:58 AM

~~FILL TO CEILING WITH
PLAIN PANEL RECESSED APPROX. 1/2"
FROM FRONT OF CABINET BOX~~

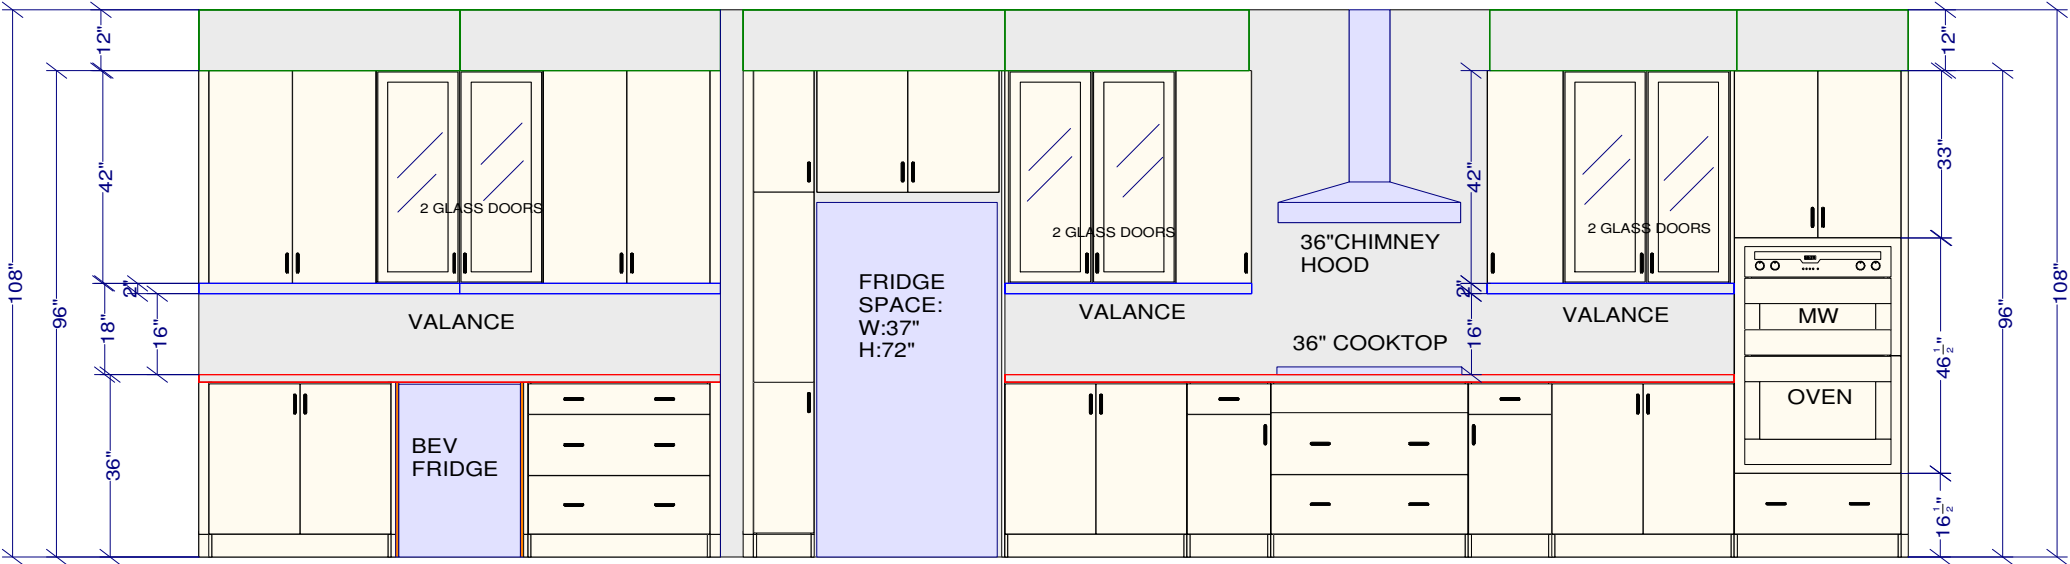

BUTLER'S PANTRY
ELEVATION

FRIDGE / COOKTOP / OVEN WALL ELEVATION

REVISED: MAY 7-24

All dimensions & size designations given are subject to verification on job site and adjustment to fit job conditions.


This is an original design and must not be released or copied unless applicable fee has been paid or job order placed.

Designed: 2024-05-07
Printed: 2024-05-07

DocuSigned by:
K. Lallen
E39CAE2A54684CB...

DocuSigned by:
Clive Allen
1DBC50A78E74FB...

5/14/2024 | 10:49 AM EDT 5/14/2024 | 10:58 AM EDT

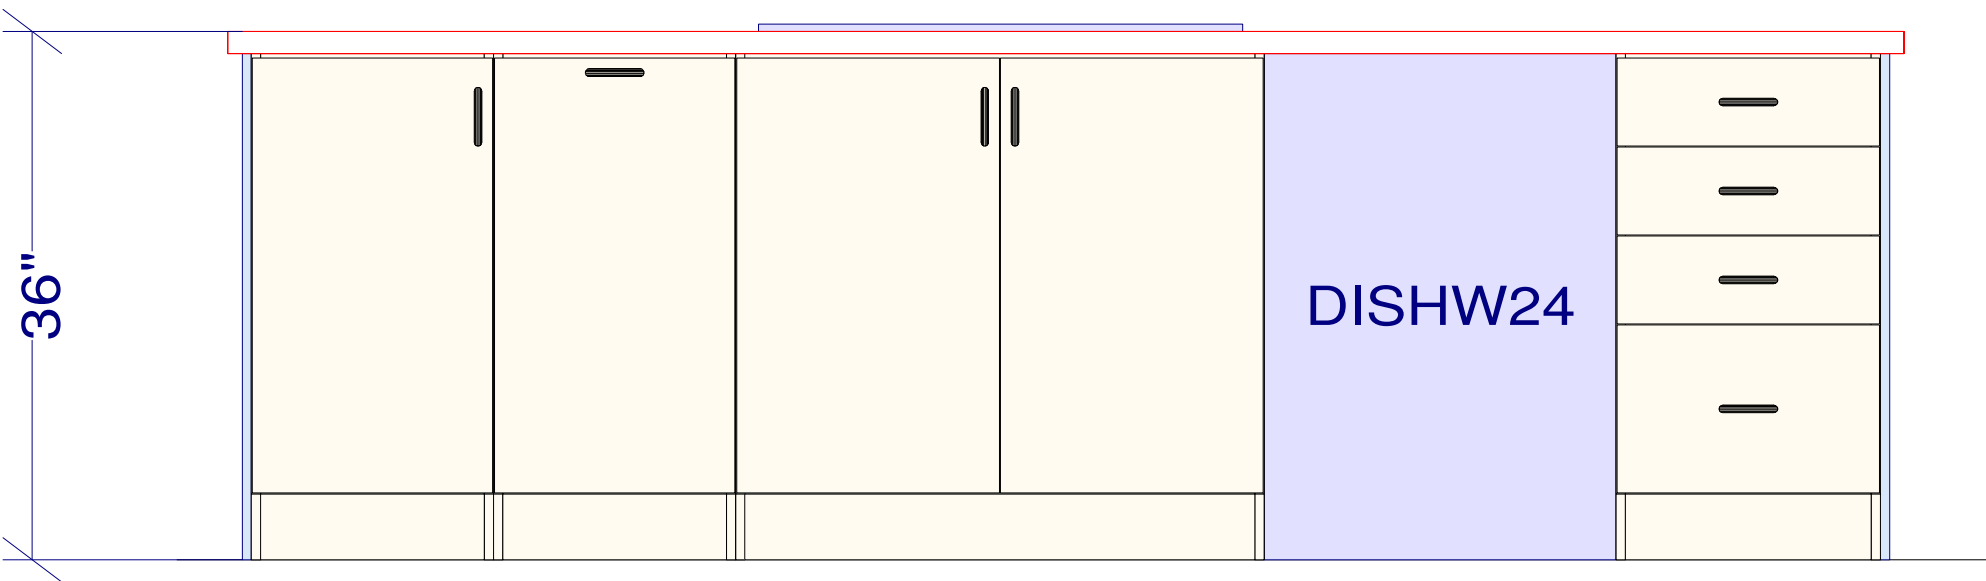

ISLAND ELEVATION

REVISED MAY 7-24

All dimensions ,size designations given are subject to verification on job site and adjustment to fit job conditions.

This is an original design and must not be released or copied unless applicable fee has been paid or job order placed.

Designed: 2024-05-07
Printed: 2024-05-07



KITCHEN - 3D VIEW #1


REVISED MAY 7-24

DS
h.h

DS
Ca

Note: This drawing is an artistic interpretation of the general appearance of the design. It is not meant to be an exact rendition.

Designed: 2024-05-07
Printed: 2024-05-07

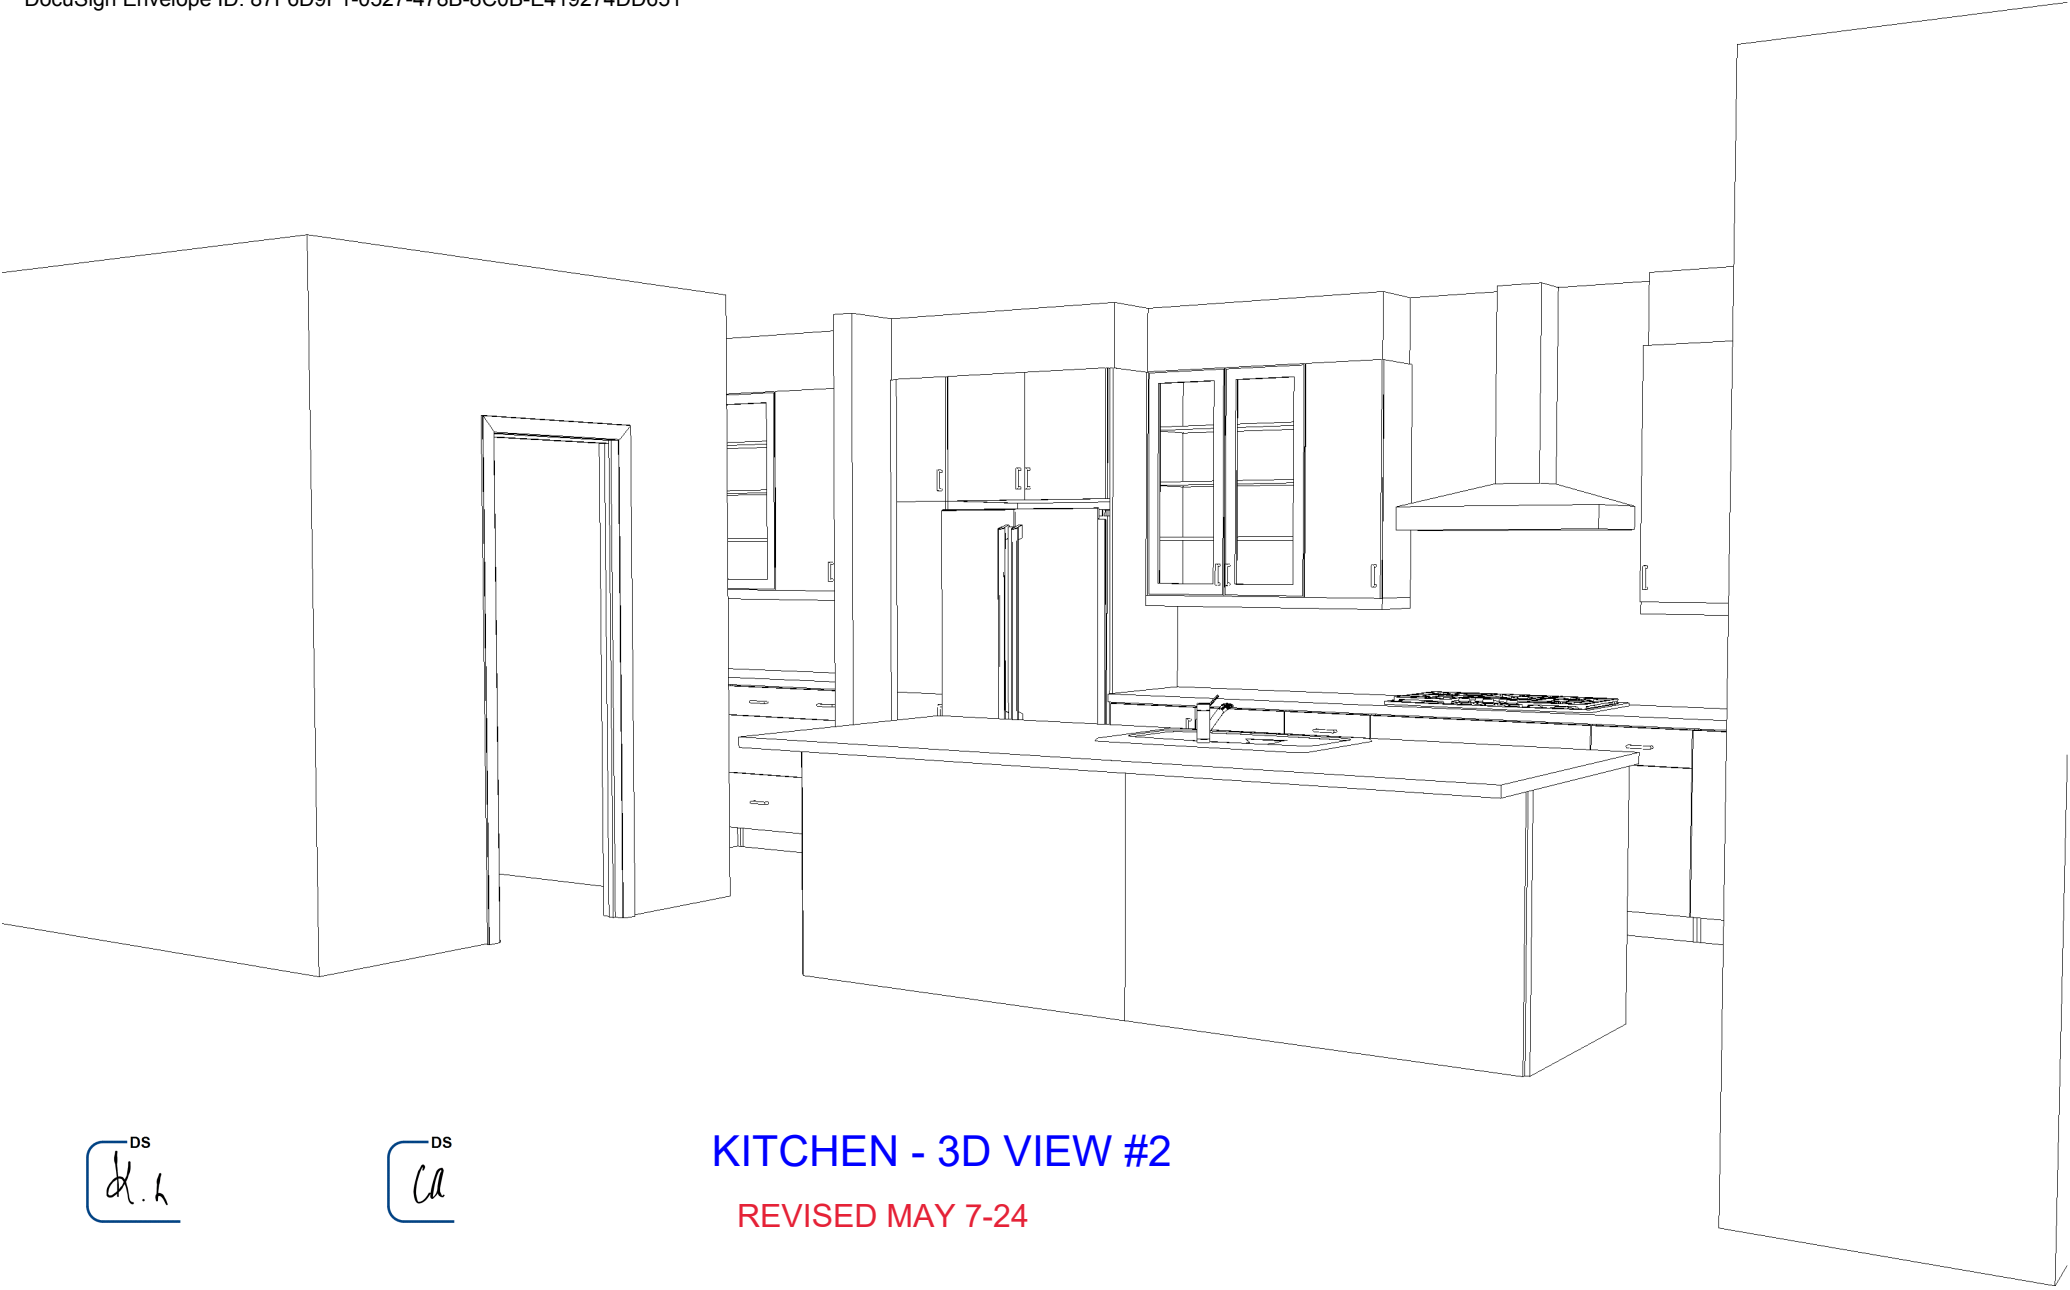

DS
d.h.

DS
ca

KITCHEN - 3D VIEW #2

REVISED MAY 7-24

Note: This drawing is an artistic interpretation of the general appearance of the design. It is not meant to be an exact rendition.

Designed: 2024-05-07
Printed: 2024-05-07



KITCHEN - 3D VIEW #3

DS
d.h.

DS
ca

REVISED MAY 7-24

Note: This drawing is an artistic interpretation of the general appearance of the design. It is not meant to be an exact rendition.

Designed: 2024-05-07
Printed: 2024-05-07



KITCHEN - 3D VIEW #4

REVISED MAY 7-24

DS
d.h.

DS
ca

Note: This drawing is an artistic interpretation of the general appearance of the design. It is not meant to be an exact rendition.

Designed: 2024-05-07
Printed: 2024-05-07