


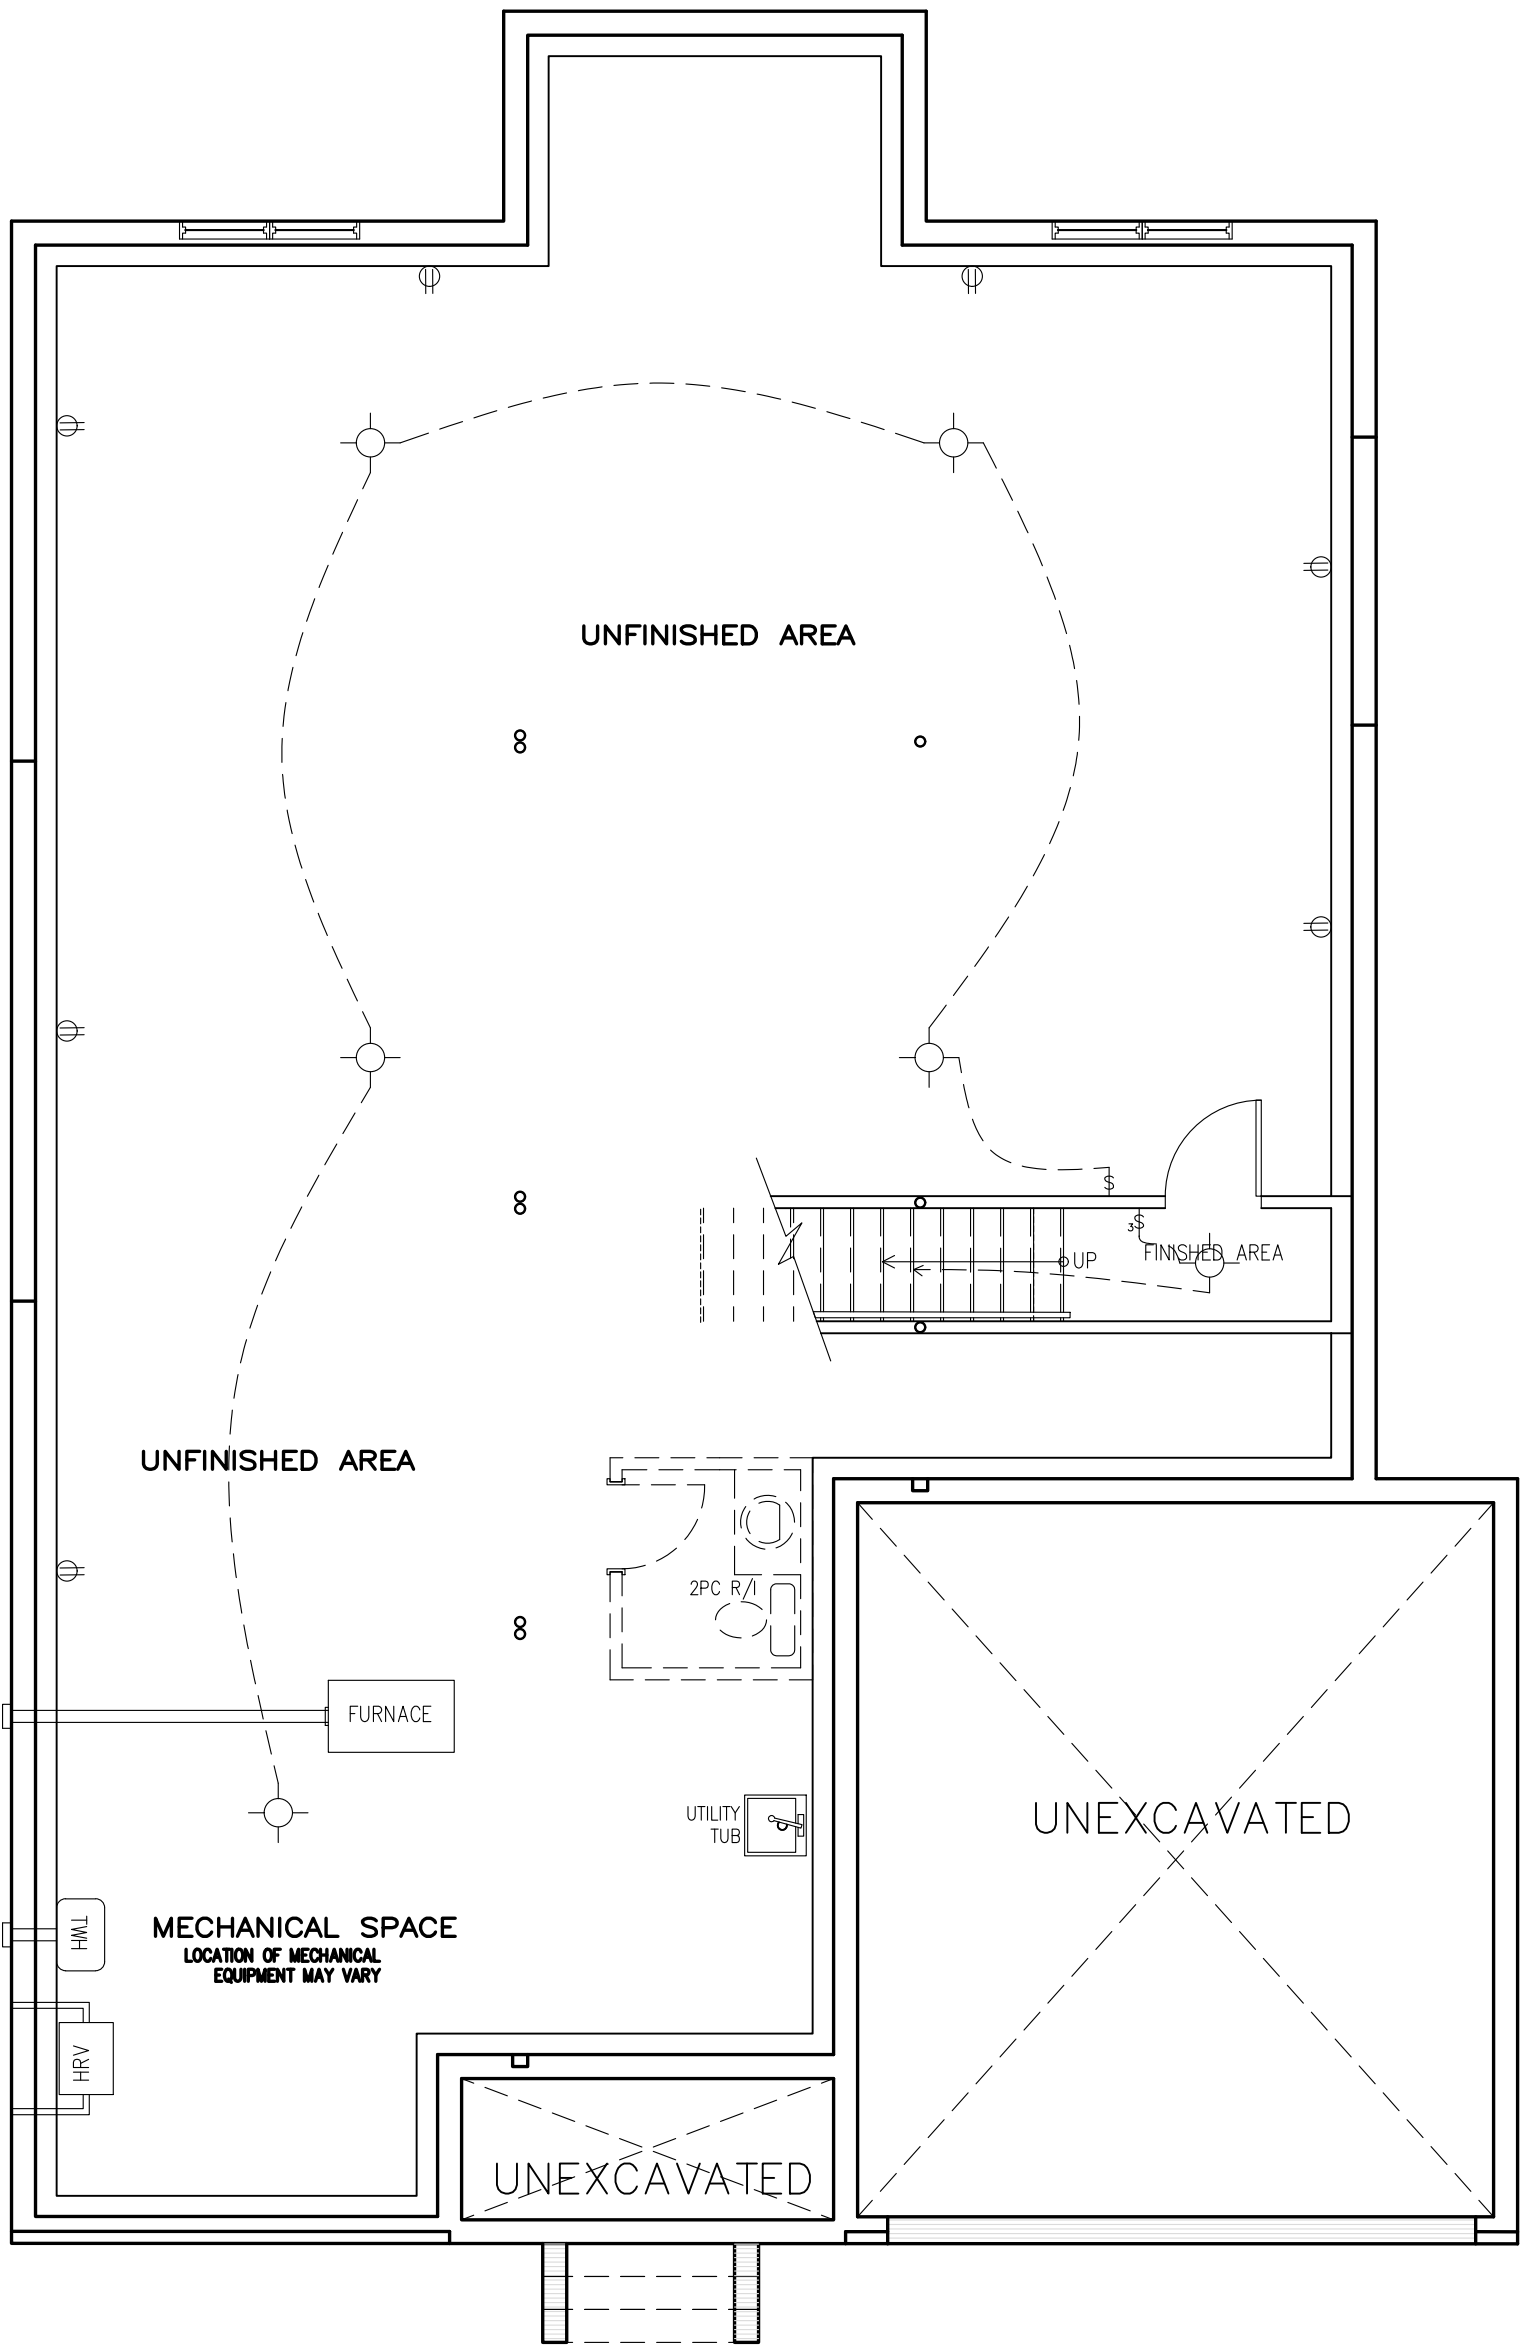

DS

AR

DS

BASEMENT PLAN

E.& O.E. / FOR REFERENCE ONLY
SUBJECT TO CHANGES

M ELEVATION



SPRINGFIELD M – 2022


SITE: WHITETAIL RIDGE PH.4

LOT NUMBER: 137

CIVIC ADDRESS:
111 FRANK FISHER CRESCENT

10	FINAL BLACKLINES	27/10/23	CB
9	FLAT ROOF FRAMING NOTES ADDED	03/10/23	CB
8	ISSUED FOR ENGINEERING	12/09/23	CB
7	BEP BLACKLINES	07/09/23	CB
6	ISSUED FOR LAYOUTS	22/08/23	CB
5	PRELIM BLACKLINES	22/08/23	CB
No.	Description	dd/mm/yy	By
REVISIONS			

footprint:	B – 24
drawn by:	CB
date:	JAN/23
scale:	3/16"=1'-0"
sheet no:	2/9
D.C.L.-A-11	

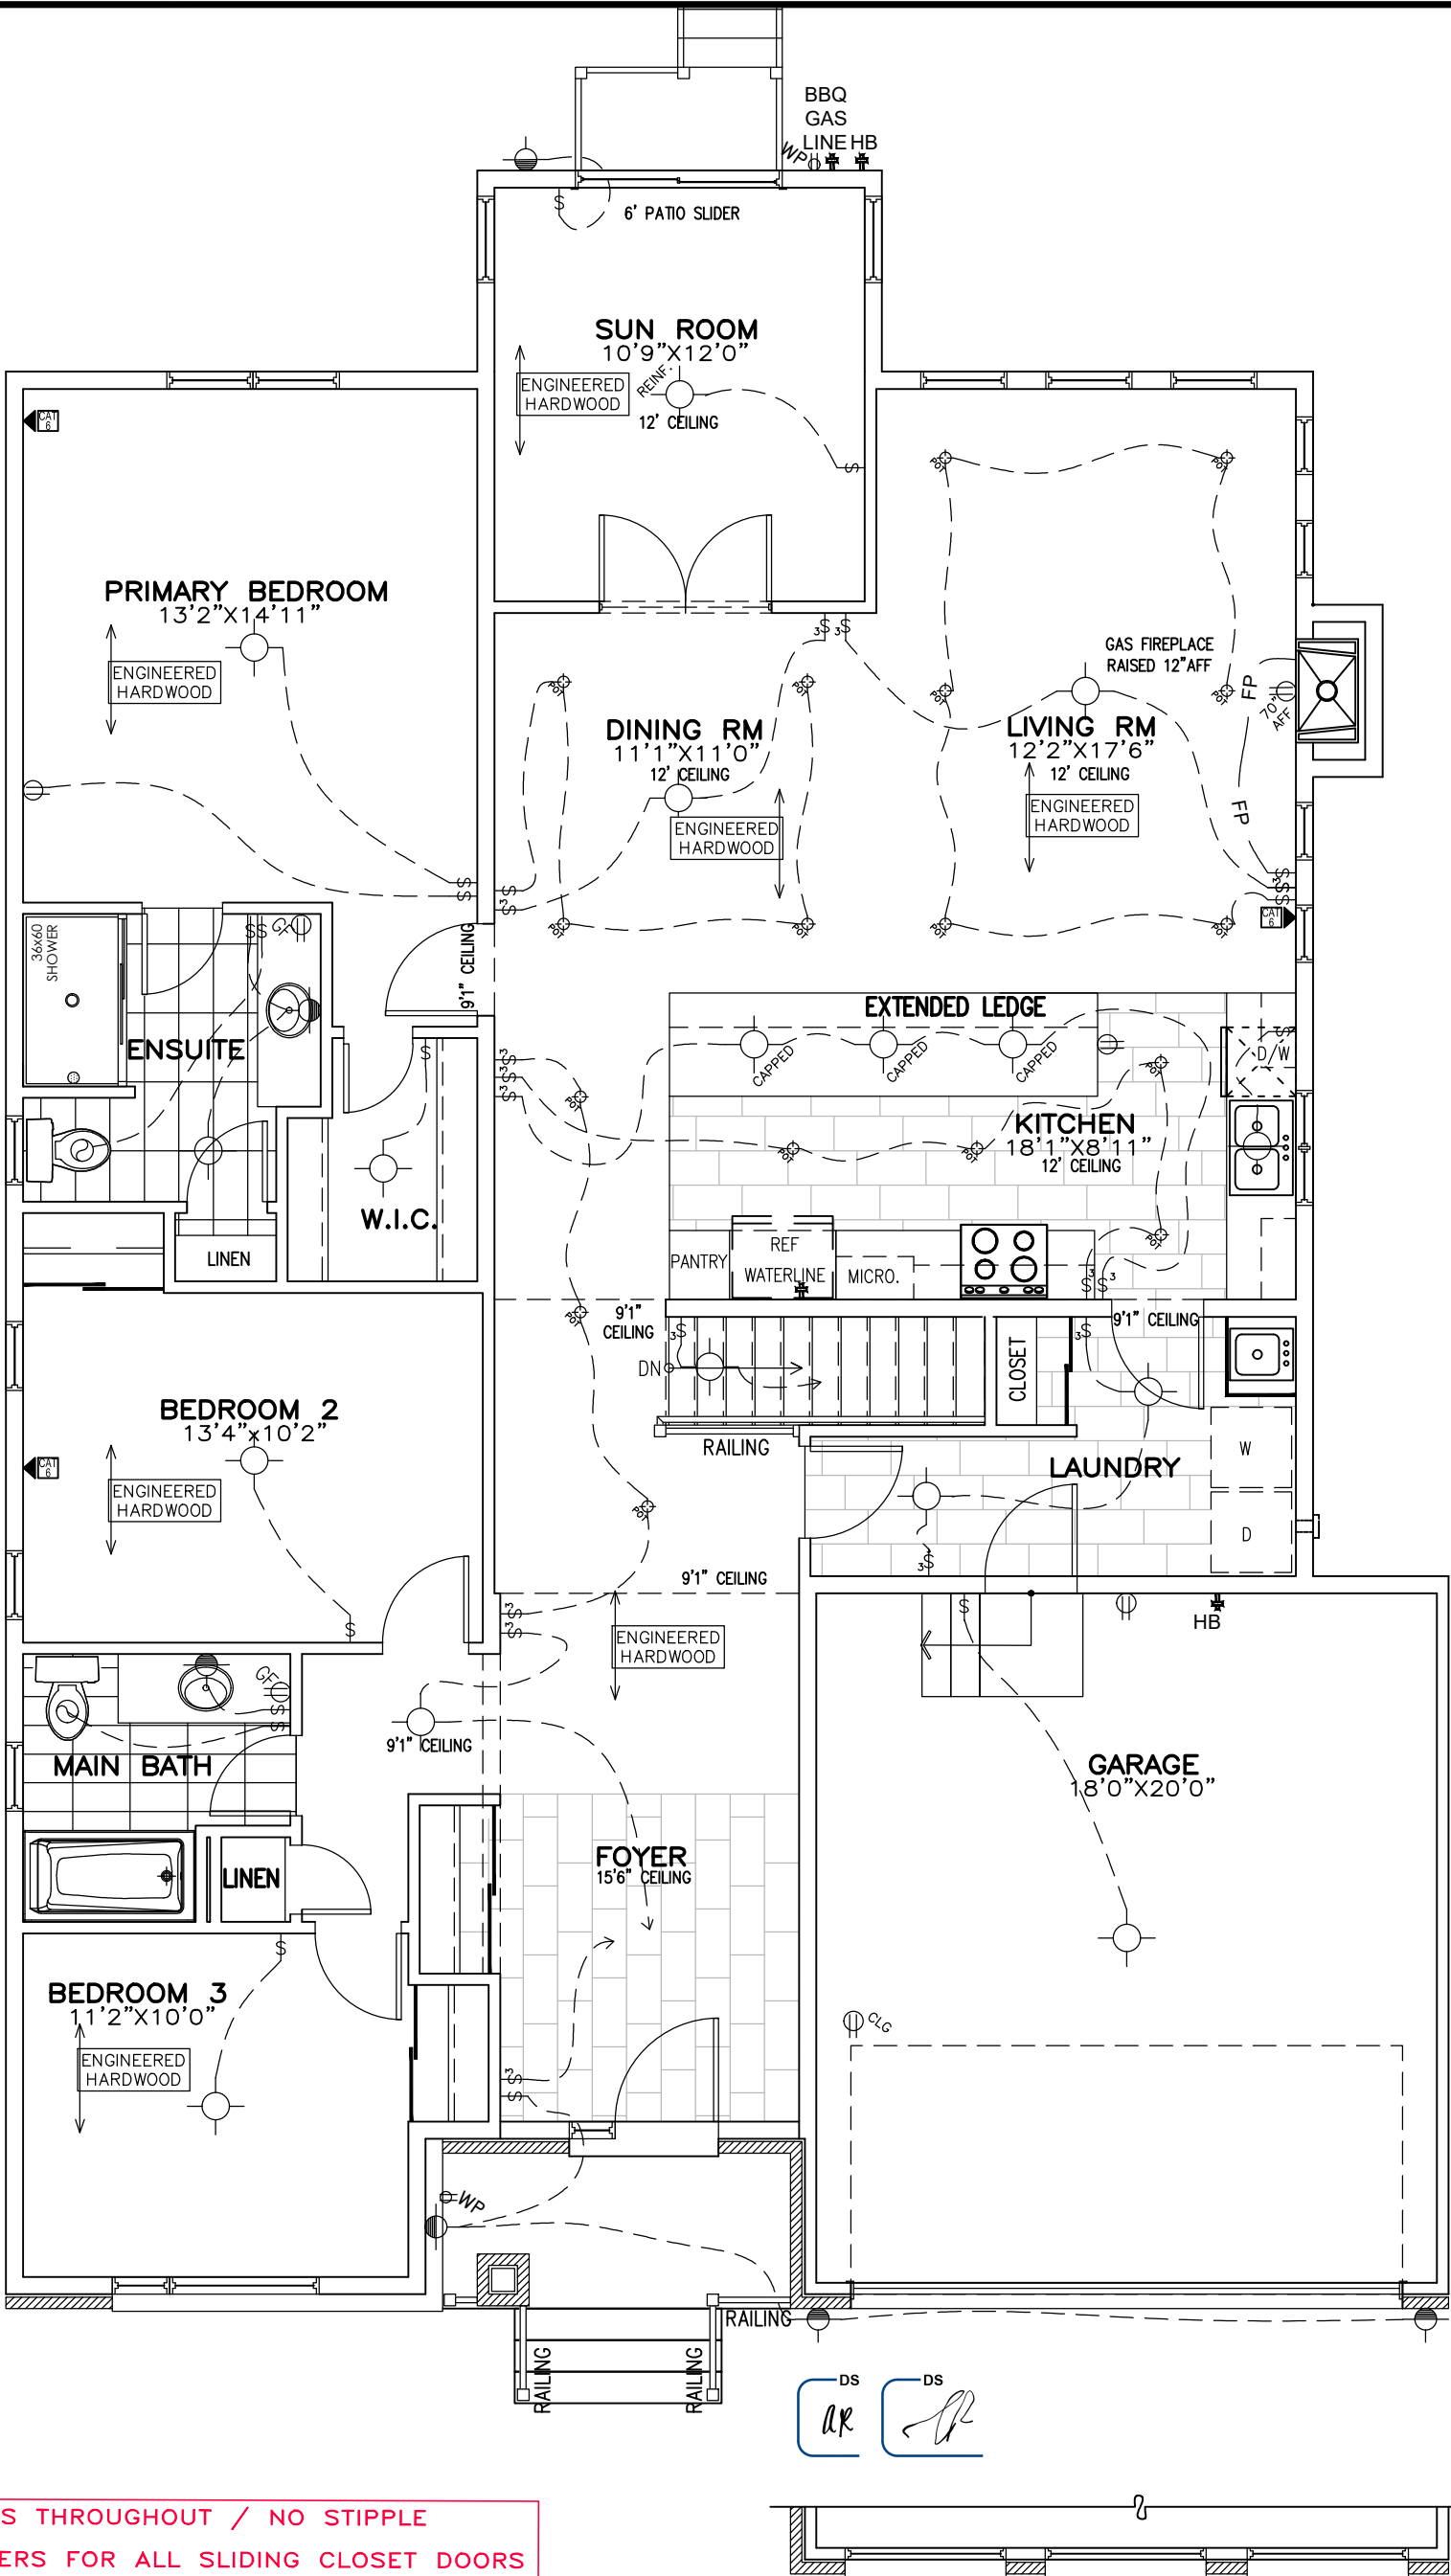

E.&O.E. / FOR REFERENCE ONLY
SUBJECT TO CHANGES

-FLAT CEILINGS THROUGHOUT / NO STIPPLE
-BYPASS SLIDERS FOR ALL SLIDING CLOSET DOORS

GROUND FLOOR
M ELEVATION

STRUCTURE FOR WINDOWS ABOVE
GARAGE DOOR FOR M ELEVATION

PHOENIX HOMES

SPRINGFIELD M – 2022

SITE: WHITETAIL RIDGE PH.4

LOT NUMBER: 137

CIVIC ADDRESS:
111 FRANK FISHER CRESCENT

11	FINAL BLACKLINES – REVISED	07/11/23	SP
10	FINAL BLACKLINES	27/10/23	CB
9	FLAT ROOF FRAMING NOTES ADDED	03/10/23	CB
8	ISSUED FOR ENGINEERING	12/09/23	CB
7	BEP BLACKLINES	07/09/23	CB
6	ISSUED FOR LAYOUTS	22/08/23	CB
No.	Description	dd/mm/yy	By
REVISIONS			

footprint: B–24

drawn by: CB

date: JAN/23

scale: 3/16"=1'–0"

sheet no: 3/9

D.C.L.–A–11