



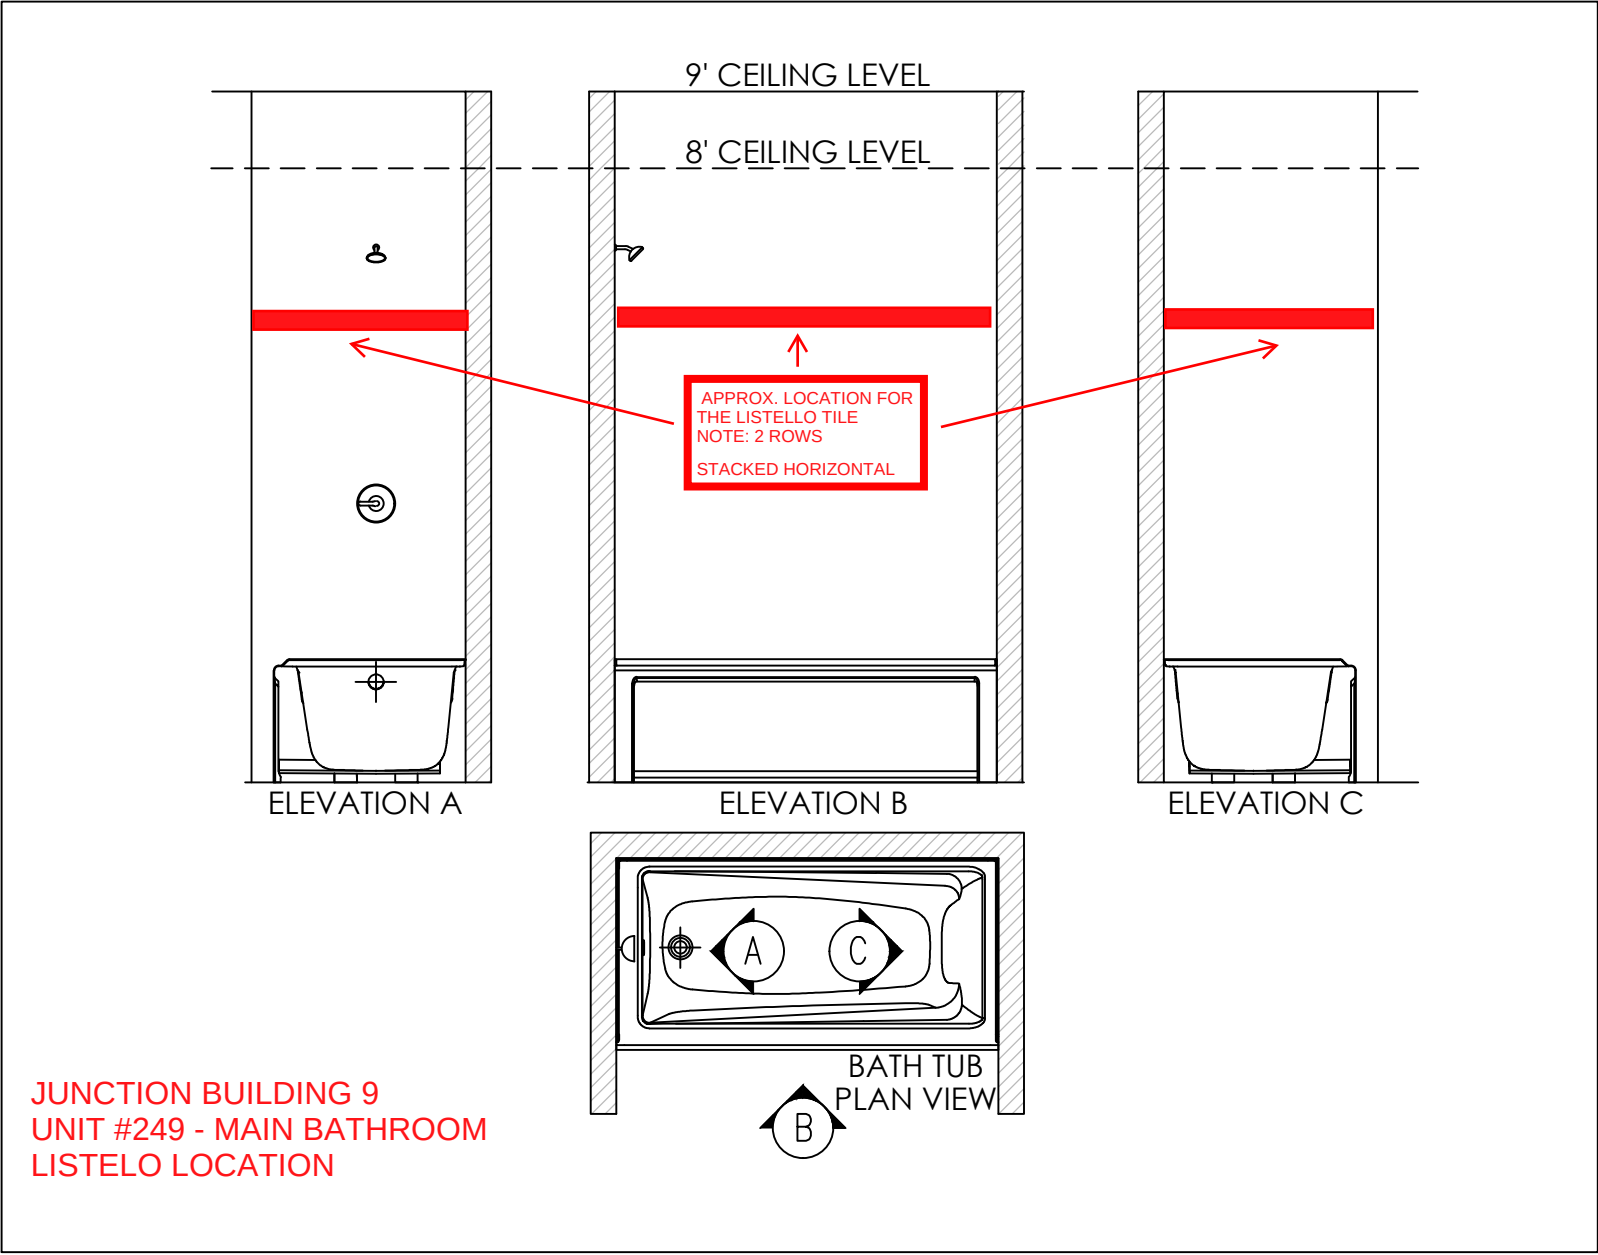

JUNCTION BUILDING 9
UNIT #249 - MAIN BATHROOM
LISTELO LOCATION

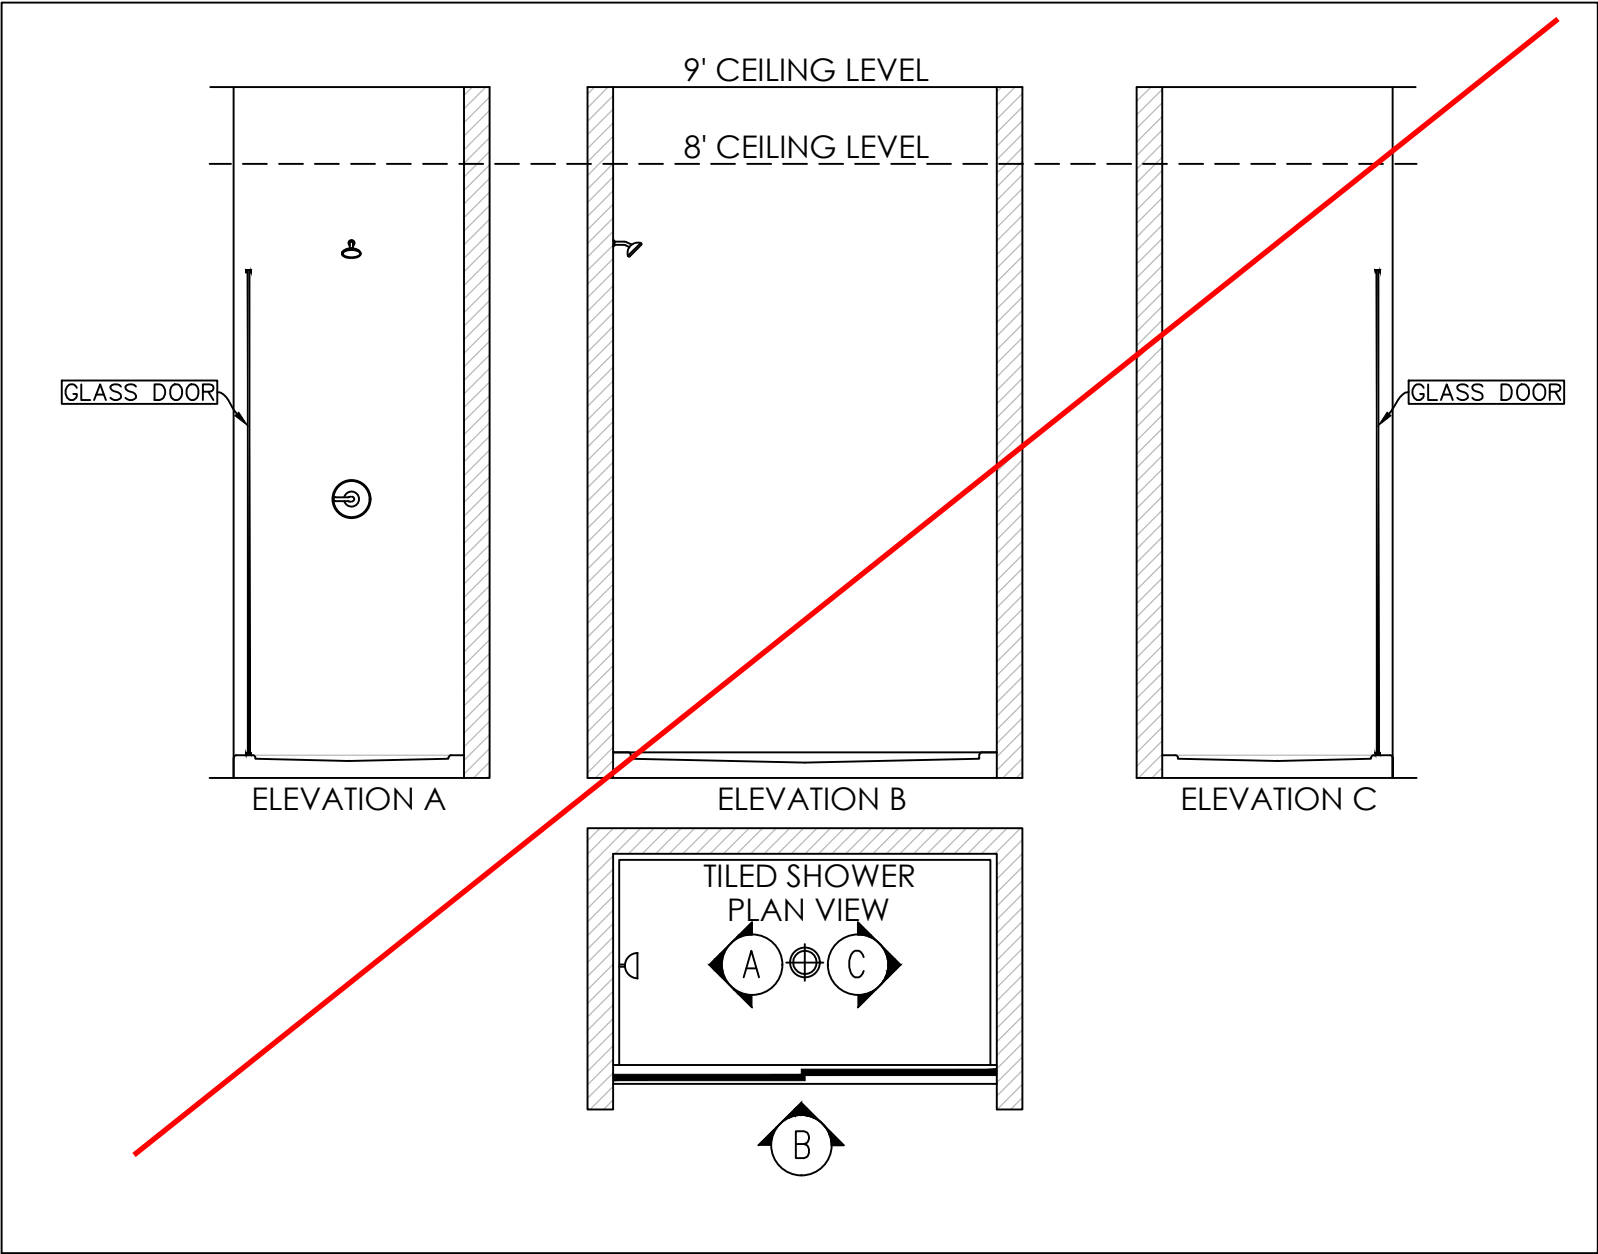

SCALE
NOT TO
SCALE

PHOENIX HOMES

TUB/SHOWER ELEVATIONS