

NOTE

ALL WINDOW LINTELS TO BE 2-2X10
W/ P2 POSTS ON EACH SIDE U.N.O.


City of Ottawa
Building Services Branch

REVIEWED
By rossgr1 at 11:35 am, Jul 10, 2024

Building Code Reviewed

Signature
B. B. B.


- FLAT CEILINGS THROUGHOUT - NO STIPPLE
- S/I BYPASS SLIDING DOORS IN LIEU OF VINYL

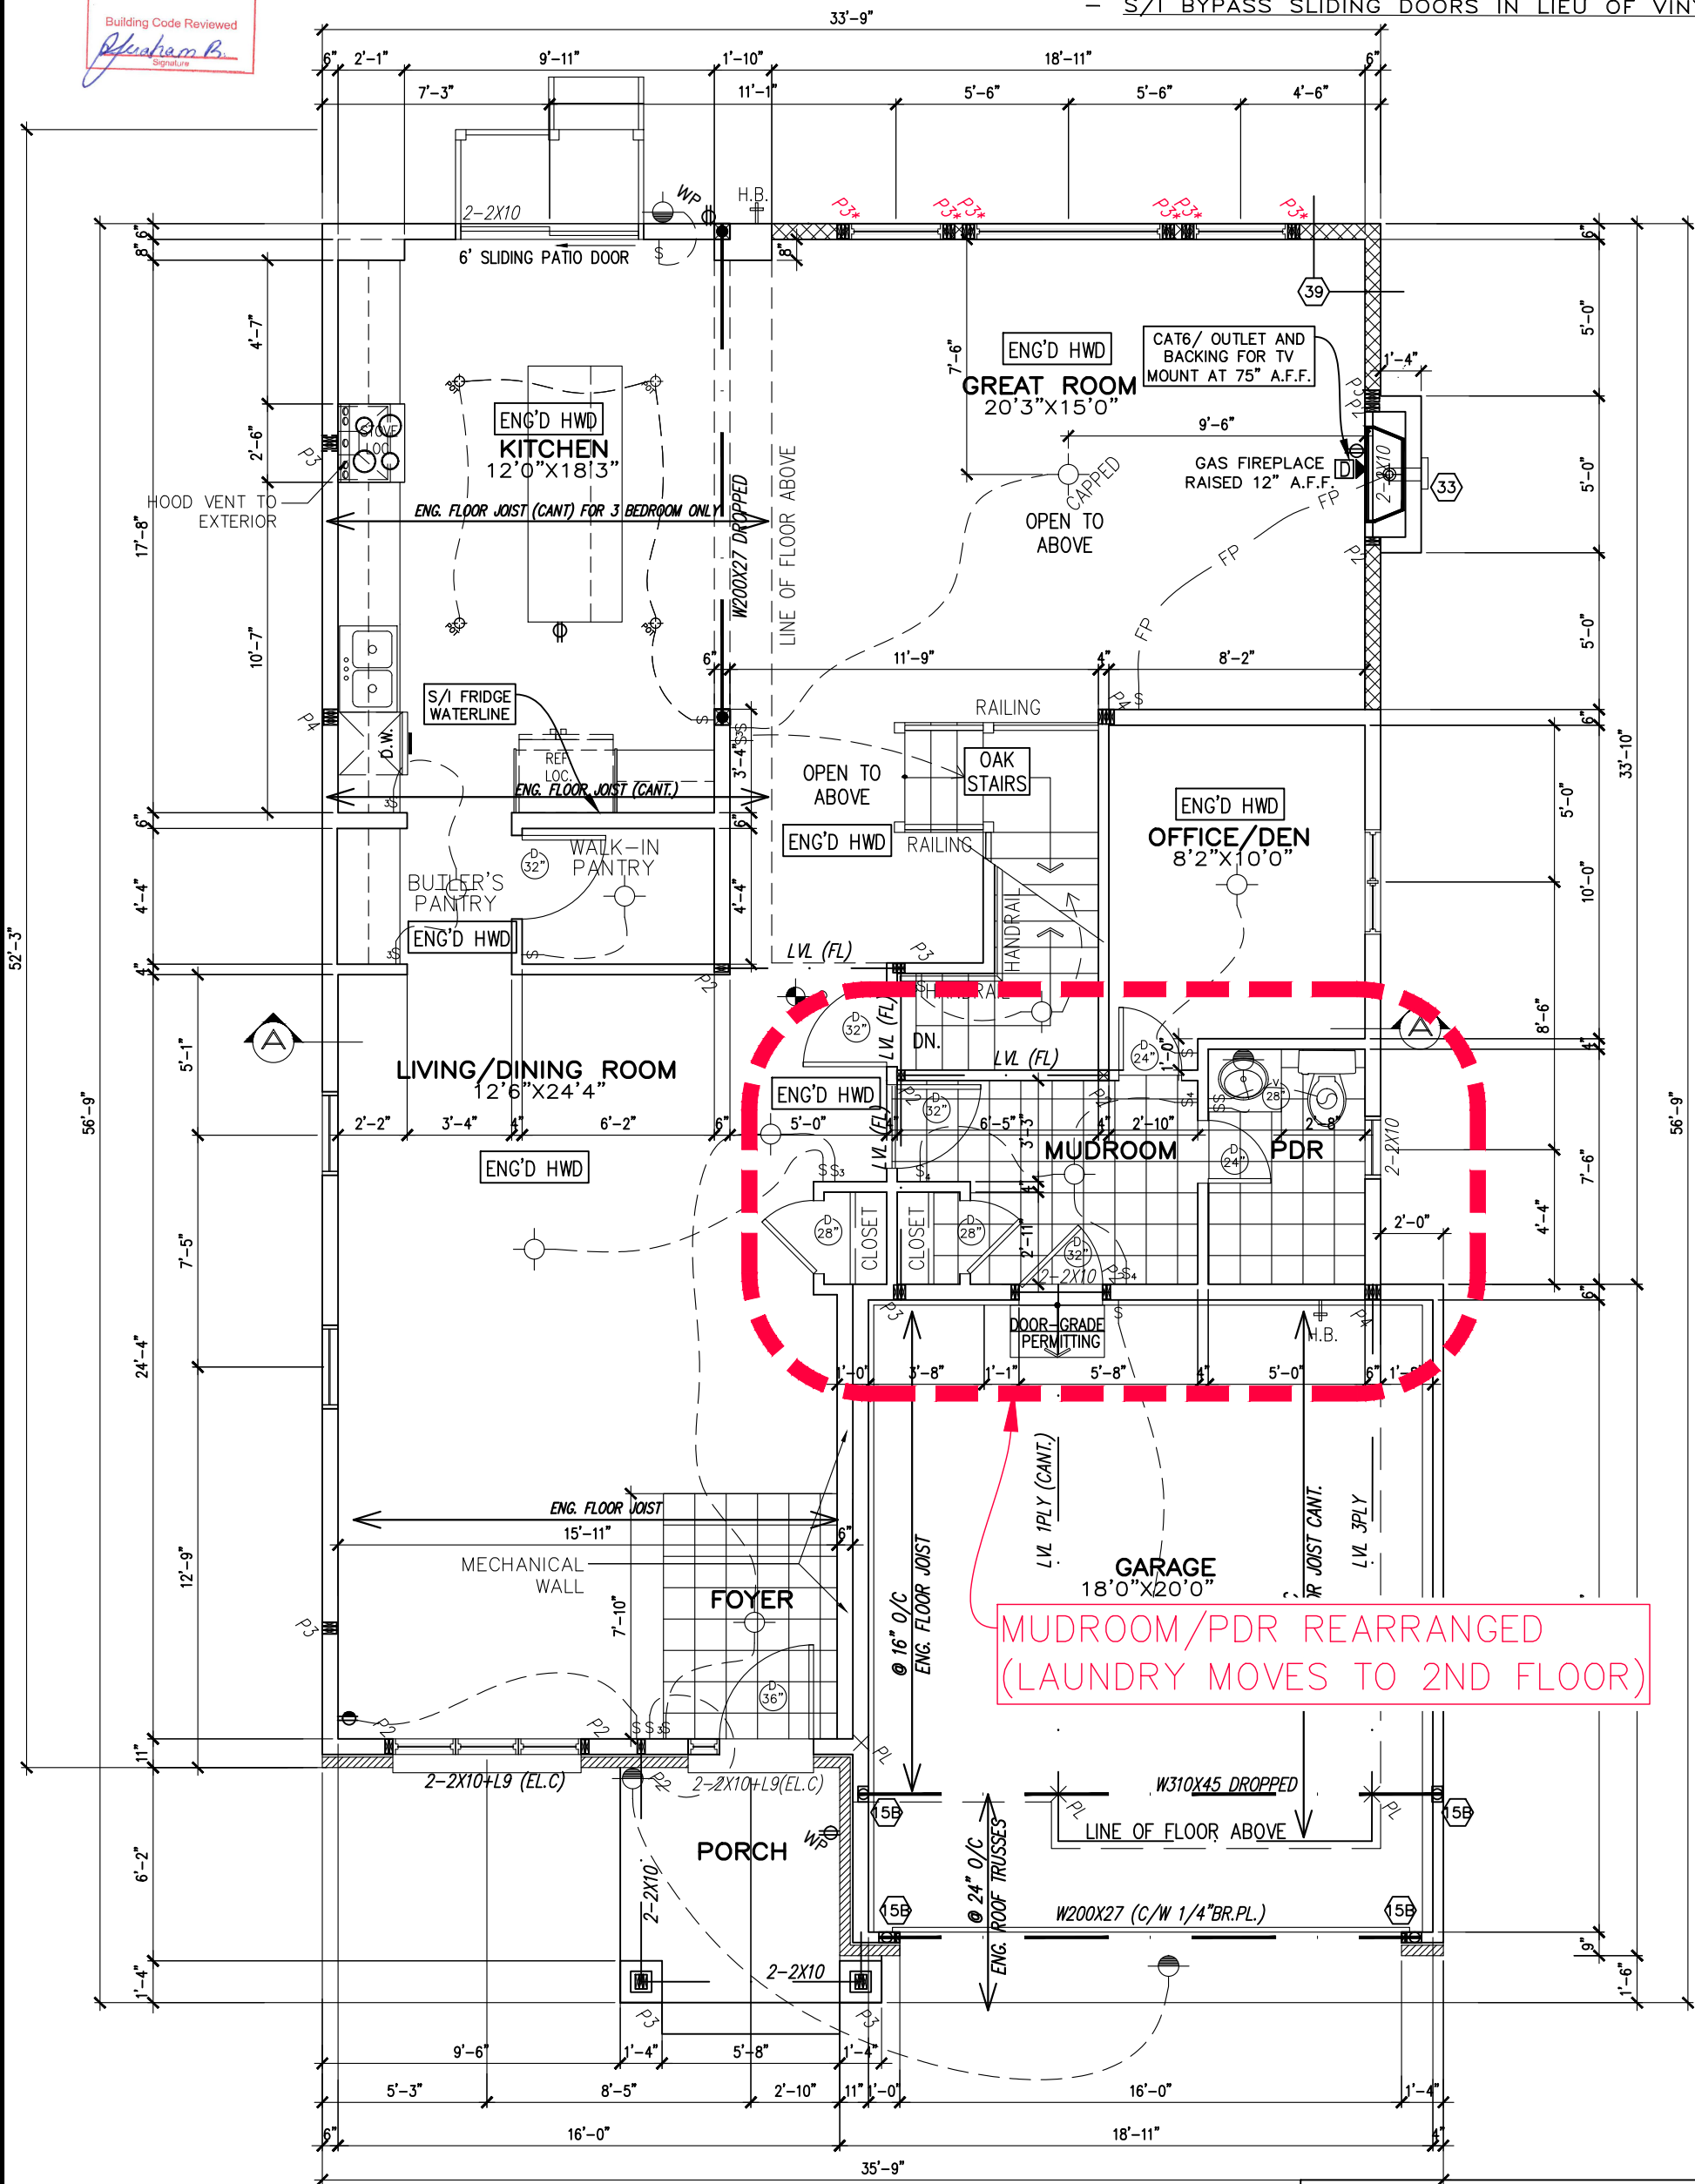

GROUND FLOOR PLAN C

1310 SF

NOTE:
ALL LVL'S SUPPORTING FLOOR LOADS ARE FLUSH,
UNLESS NOTED OTHERWISE AND TO BE SPECIFIED
BY THE FLOOR TRUSS MANUFACTURER, SEE
MANUF. LAYOUT.

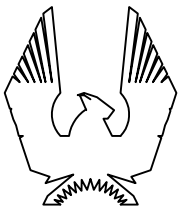

PHOENIX HOMES

BELFAST C - 2022

SITE: PATHWAYS

LOT NUMBER:


CIVIC ADDRESS:
619 MIIKANA ROAD

347

7	BEP BLACKLINES - REVISION 3	AUG 31-2023	SP
6	BEP BLACKLINES - REVISION 2	AUG 22-2023	SP
5	BEP BLACKLINES - REVISED	AUG 21-2023	SP
4	APPOINTMENT BLACKLINES	MAY 24-2023	SP
3	KITCHEN LIGHT UPDATE	OCT 24-2022	SP
2	STRUCTURAL REVIEW	JUN 1-2022	SP
No.	Description	Date	By
REVISIONS			

footprint:	50-22-1C
drawn by:	SP
date:	NOV/21
scale:	3/16"=1'-0"
sheet no:	3c
D.C.L. - A-10	11


- FLAT CEILINGS THROUGHOUT - NO STIPPLE
- S/I BYPASS SLIDING DOORS IN LIEU OF VINYL

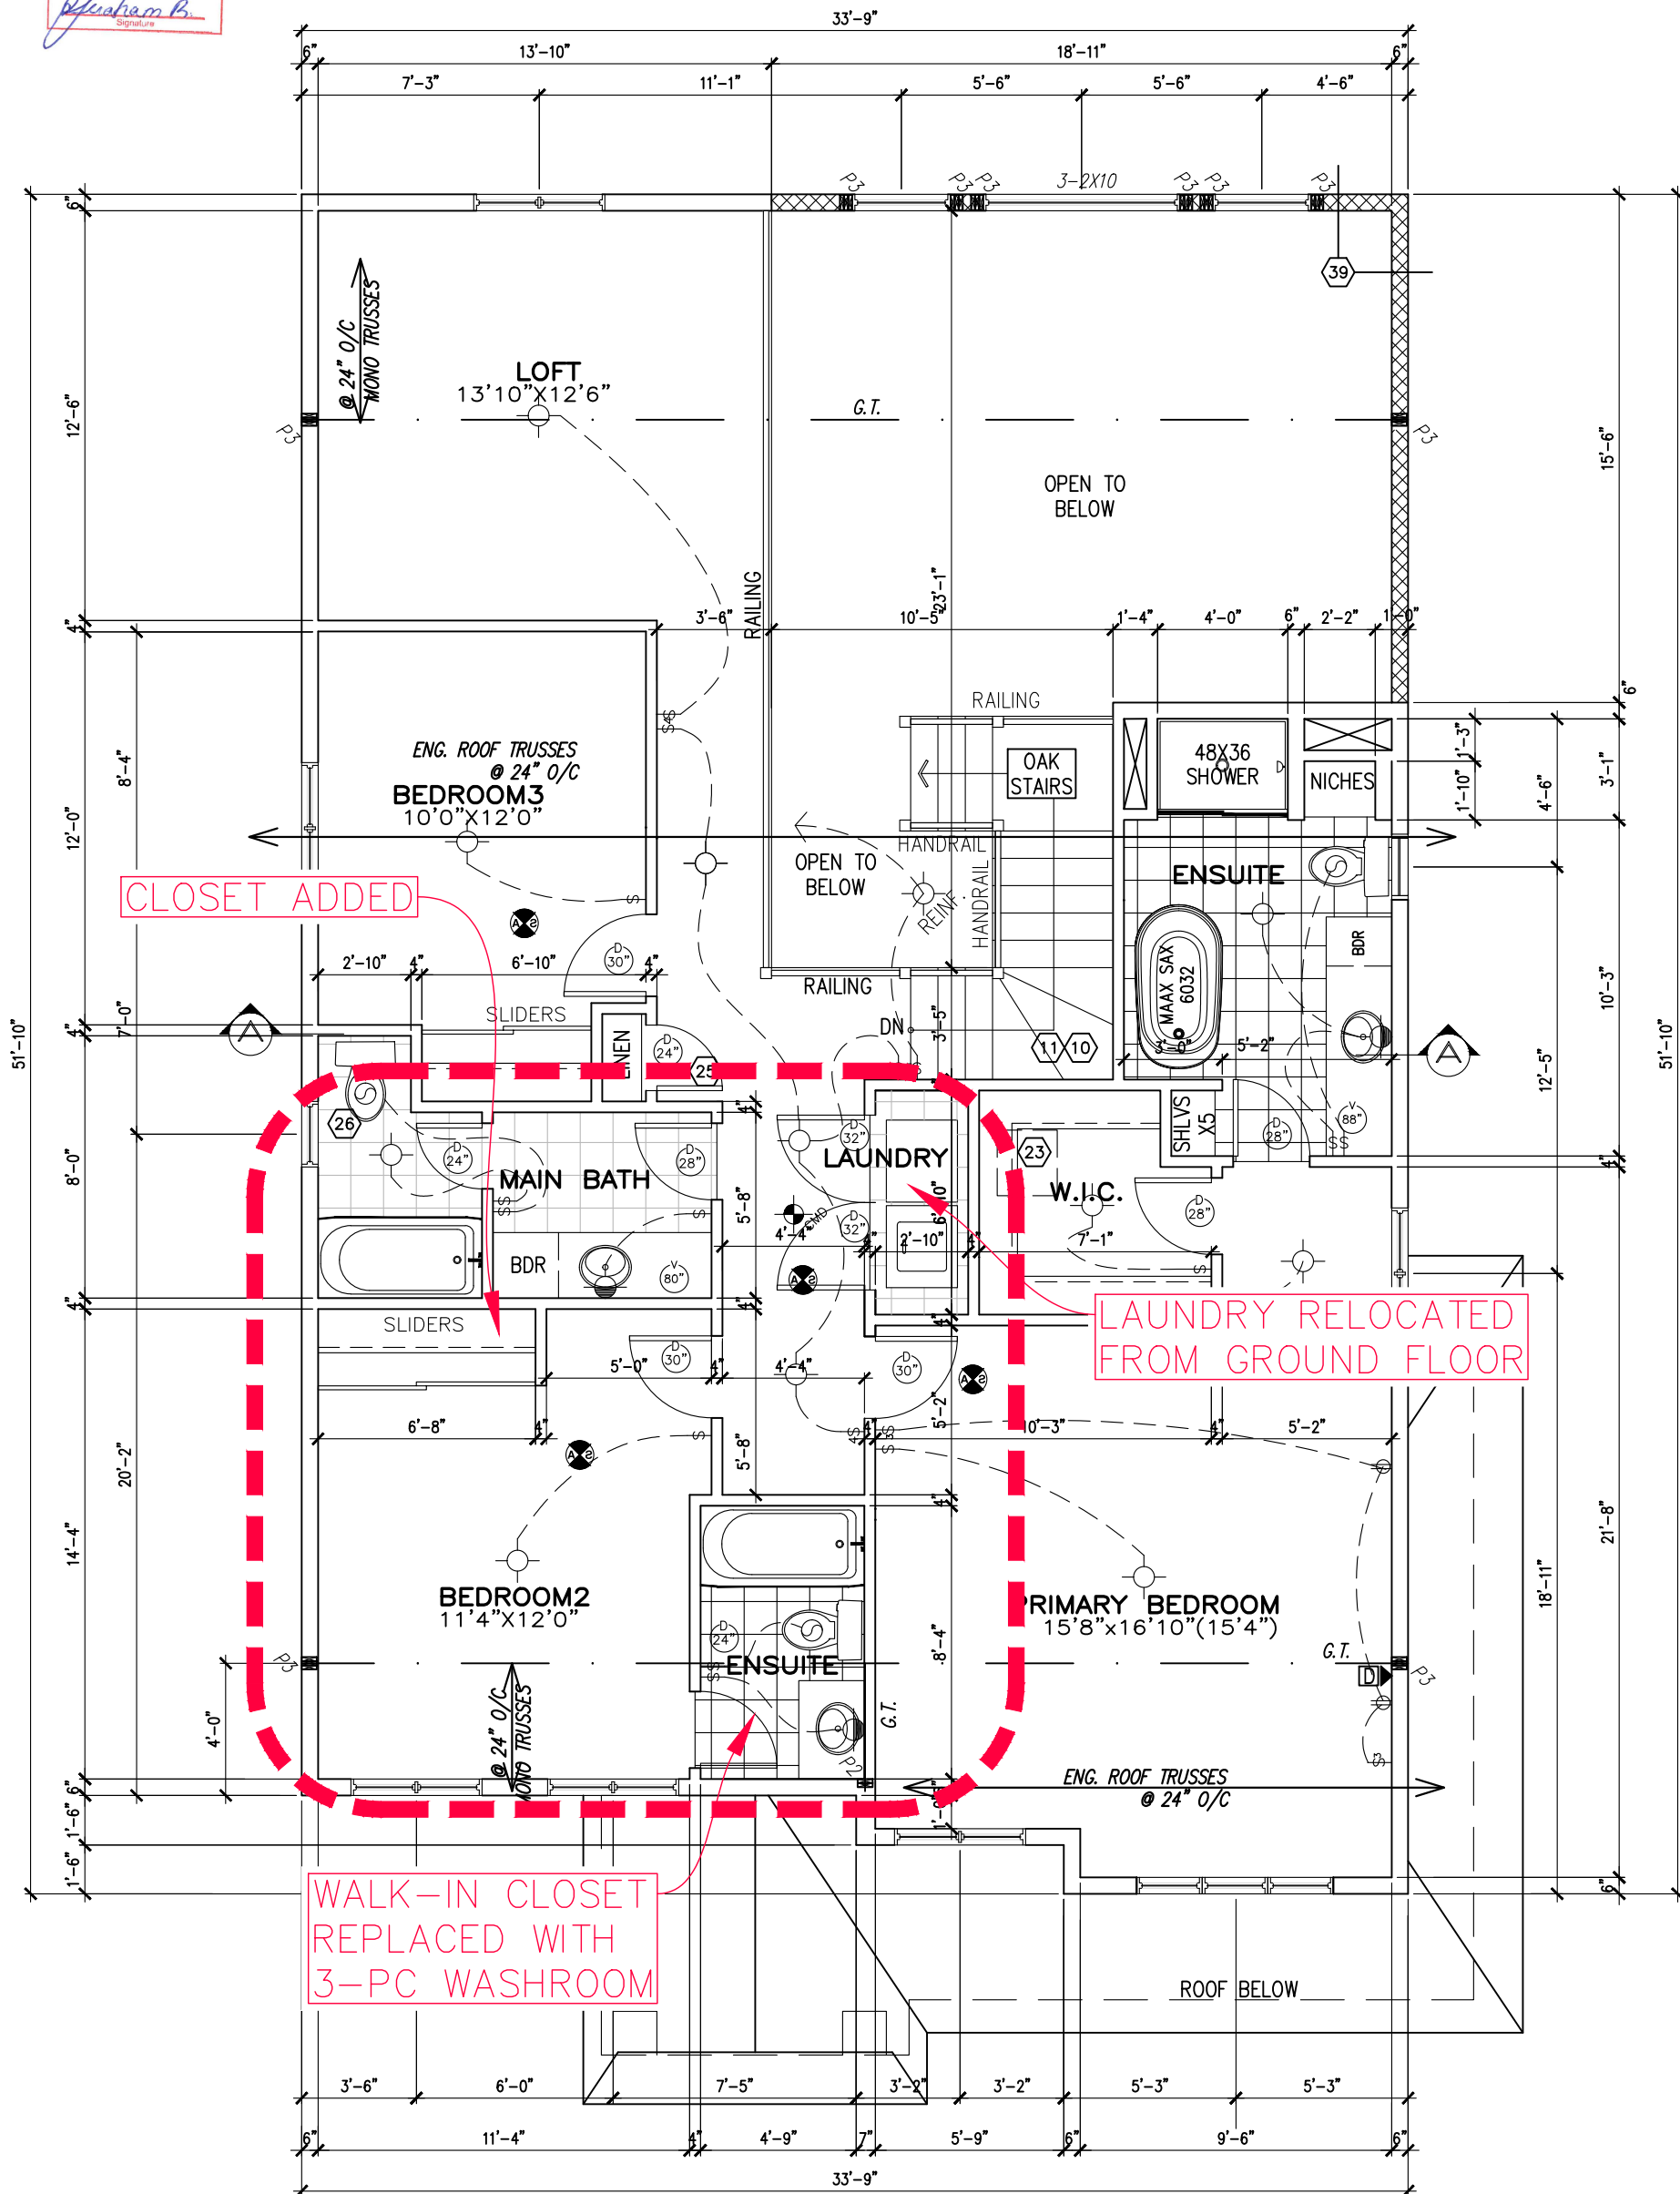

SECOND FLOOR PLAN C (3 BEDROOM)

1255 SF

NOTE:
ALL LVL'S SUPPORTING FLOOR LOADS ARE FLUSH,
UNLESS NOTED OTHERWISE AND TO BE SPECIFIED
BY THE FLOOR TRUSS MANUFACTURER, SEE
MANUF. LAYOUT.

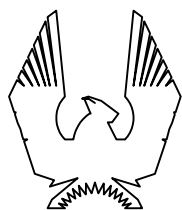

PHOENIX HOMES

BELFAST C - 2022

SITE: PATHWAYS

LOT NUMBER:

CIVIC ADDRESS:
619 MIIKANA ROAD

347

7	BEP BLACKLINES - REVISION 3	AUG 31-2023	SP
6	BEP BLACKLINES - REVISION 2	AUG 22-2023	SP
5	BEP BLACKLINES - REVISED	AUG 21-2023	SP
4	APPOINTMENT BLACKLINES	MAY 24-2023	SP
3	KITCHEN LIGHT UPDATE	OCT 24-2022	SP
2	STRUCTURAL REVIEW	JUN 1-2022	SP
No.	Description	Date	By
REVISIONS			

footprint:	50-22-1C
drawn by:	SP
date:	NOV/21
scale:	3/16"=1'-0"
sheet no:	4c
D.C.L. - A-10	11
4C 3BED	